


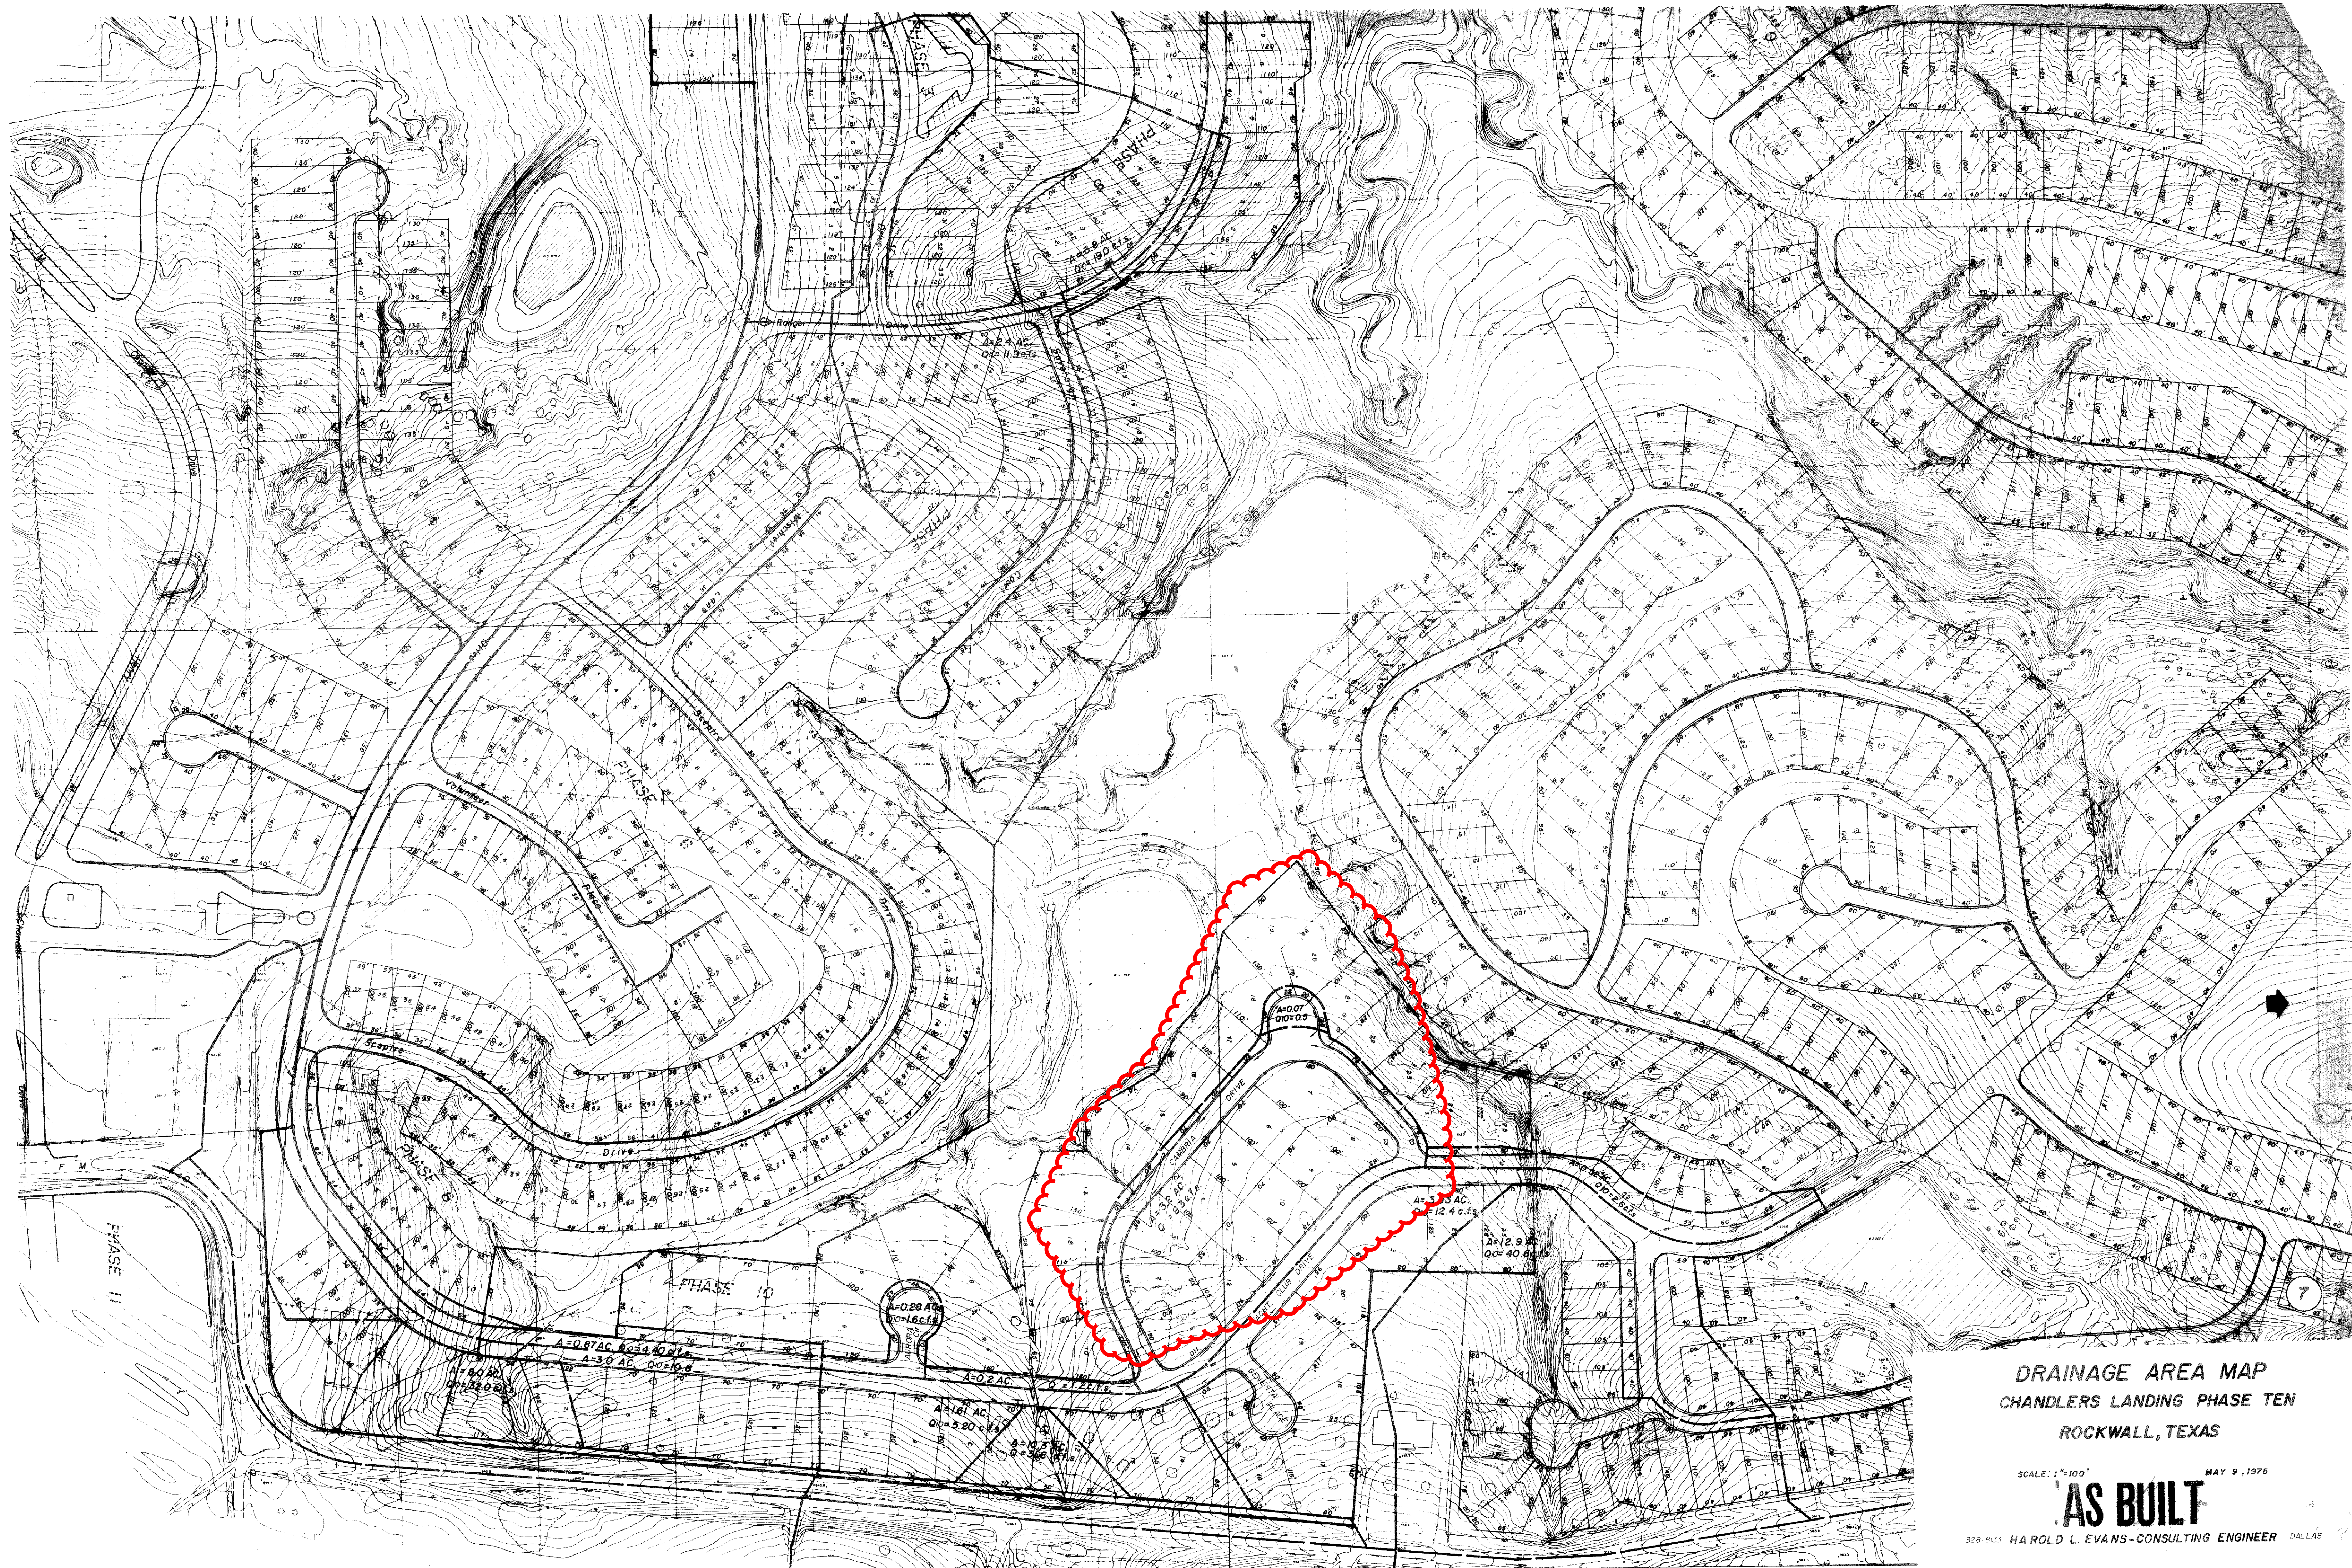

DRAINAGE AREA MAP
CHANDLER'S LANDING PHASE TEN
ROCKWALL, TEXAS

SCALE: 1"=100' MAY 9, 1975

AS BUILT

328-8133 HAROLD L. EVANS-CONSULTING ENGINEER DALLAS