
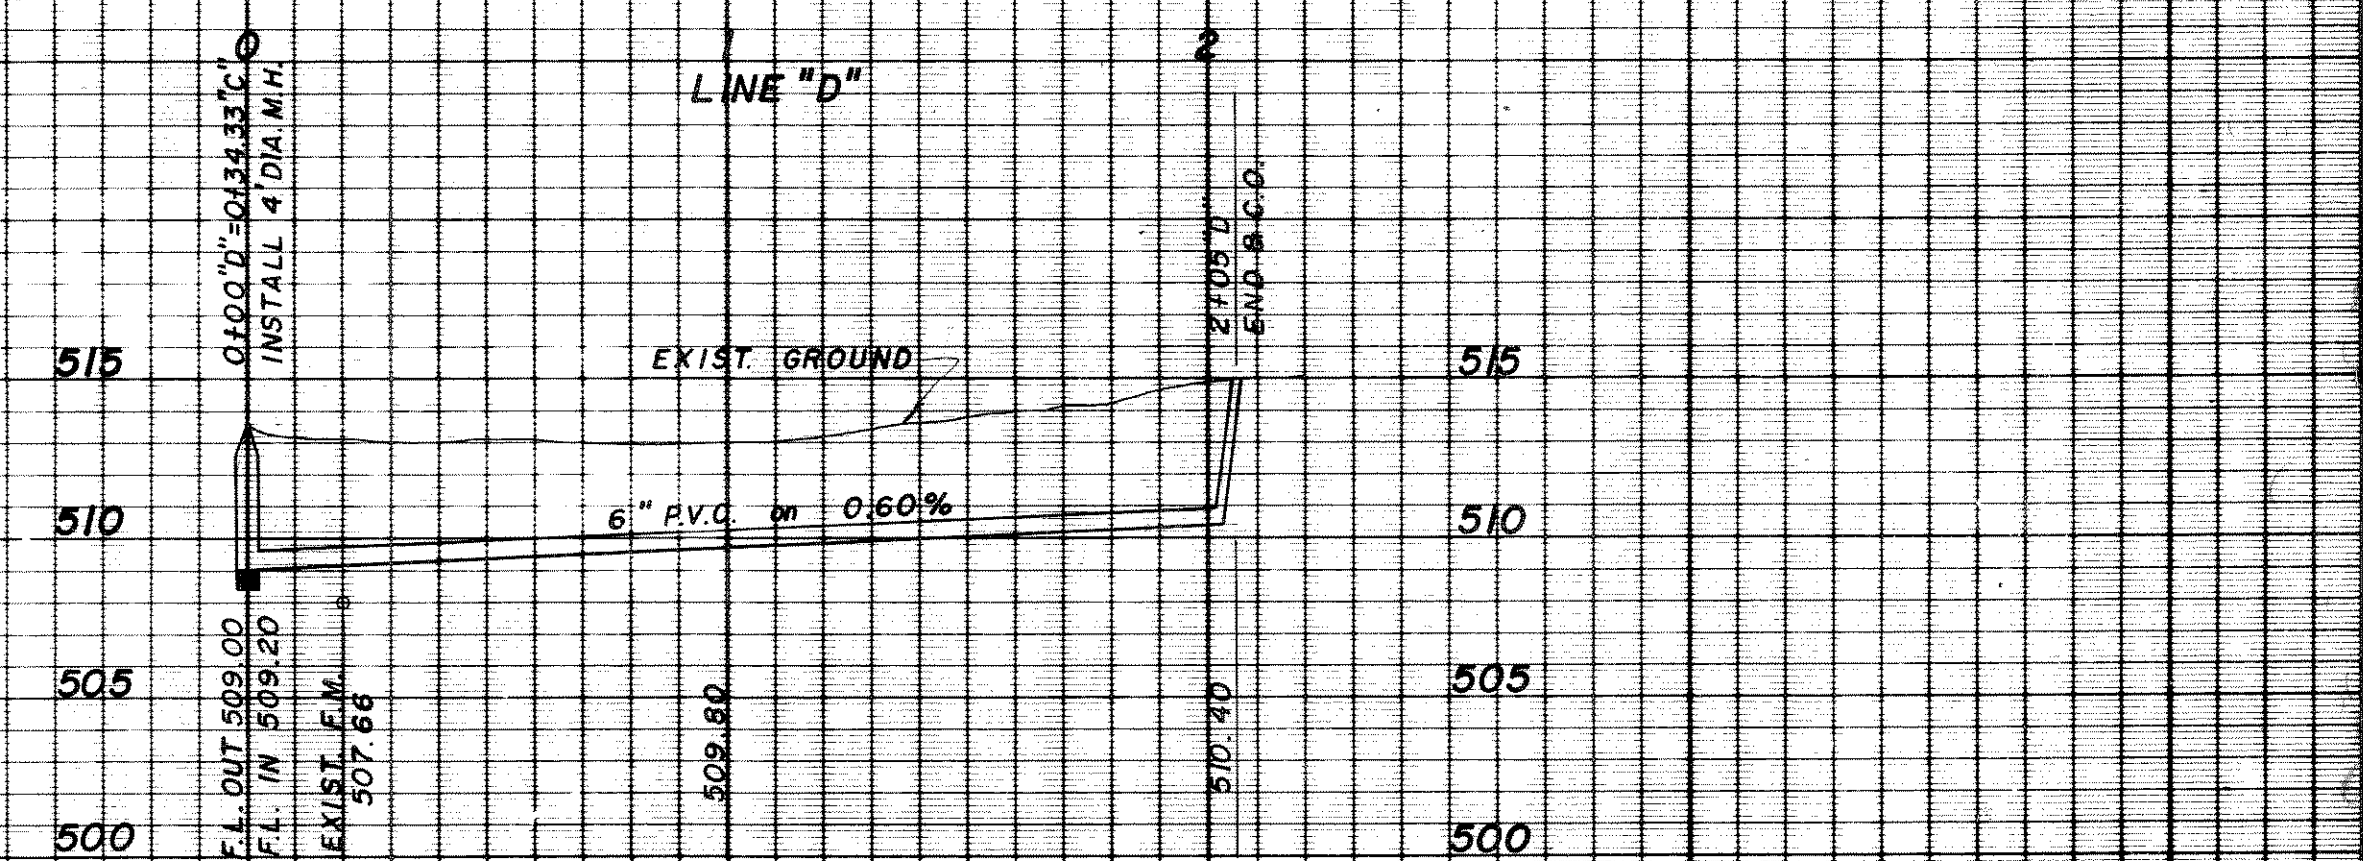
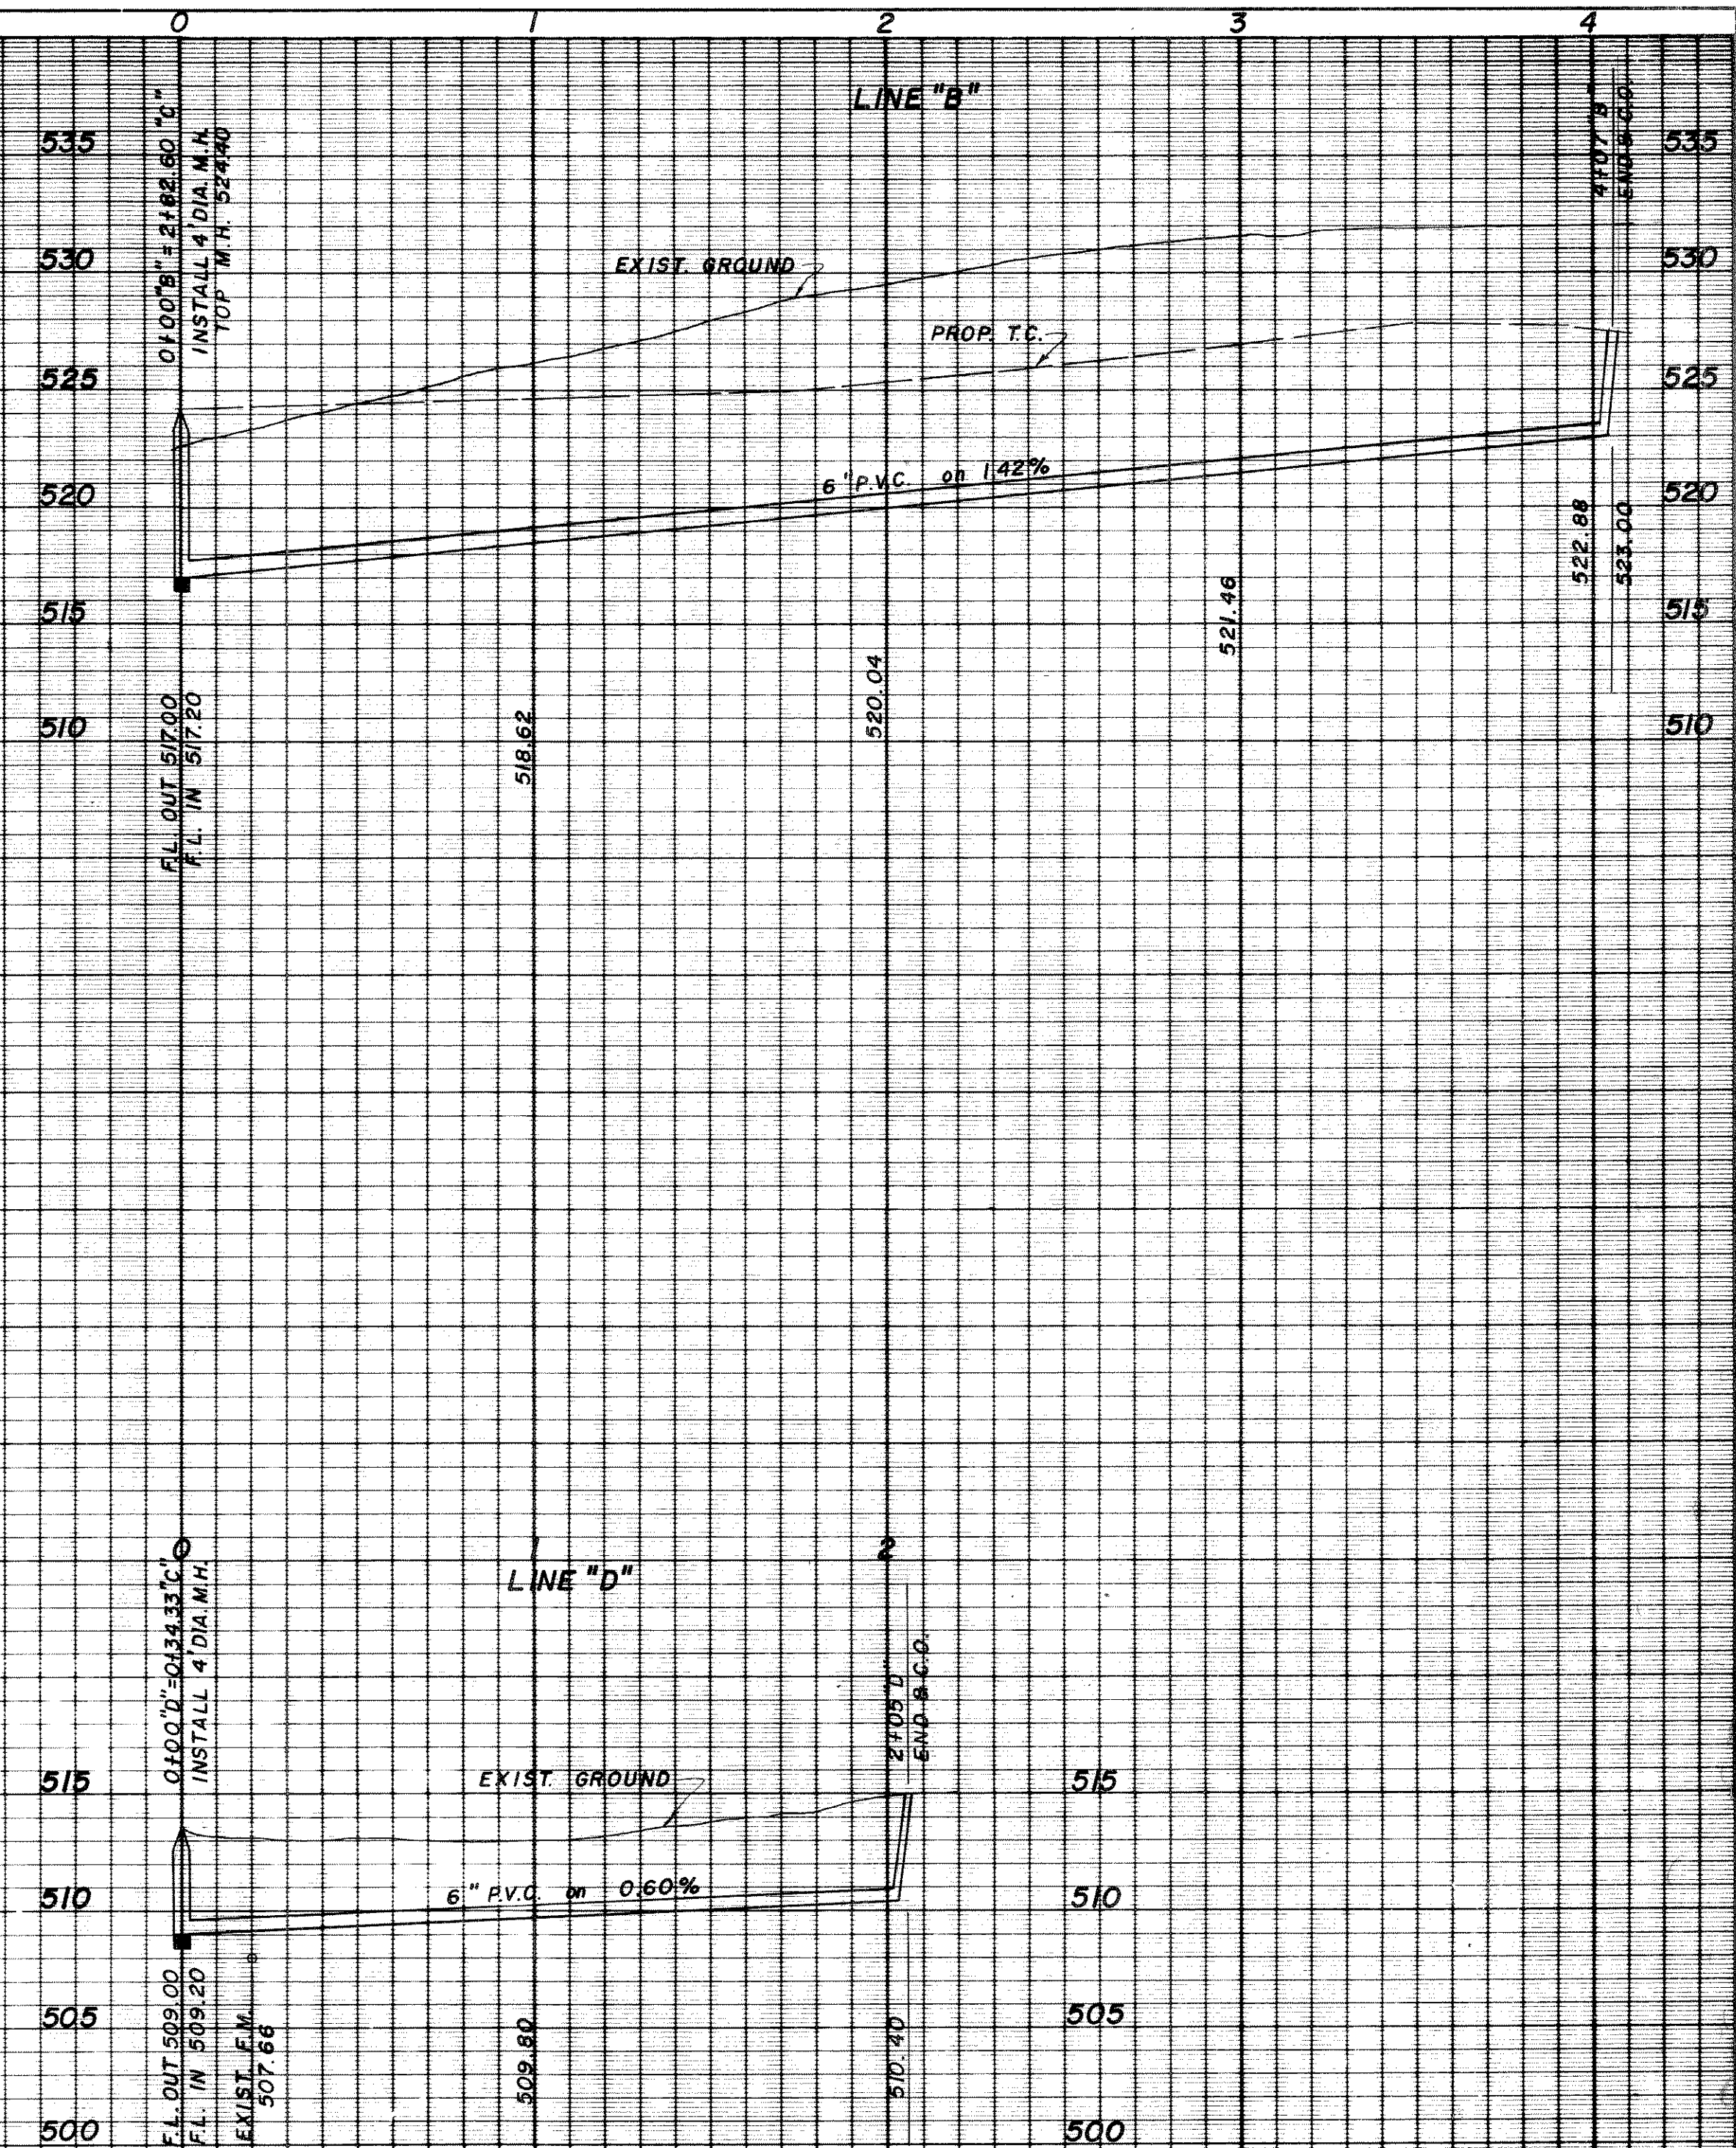
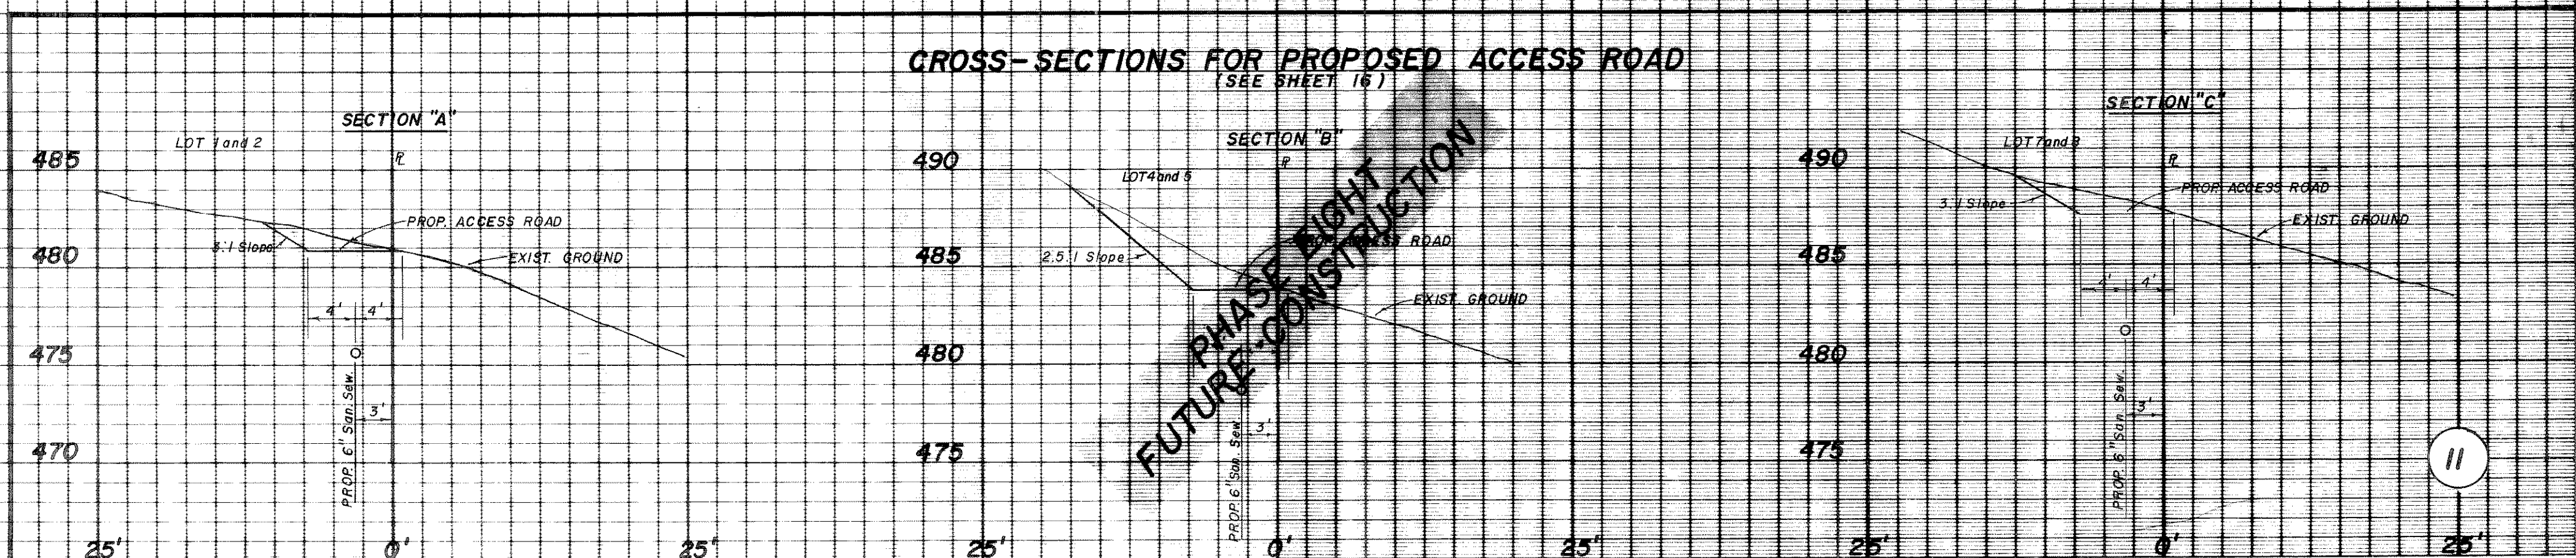


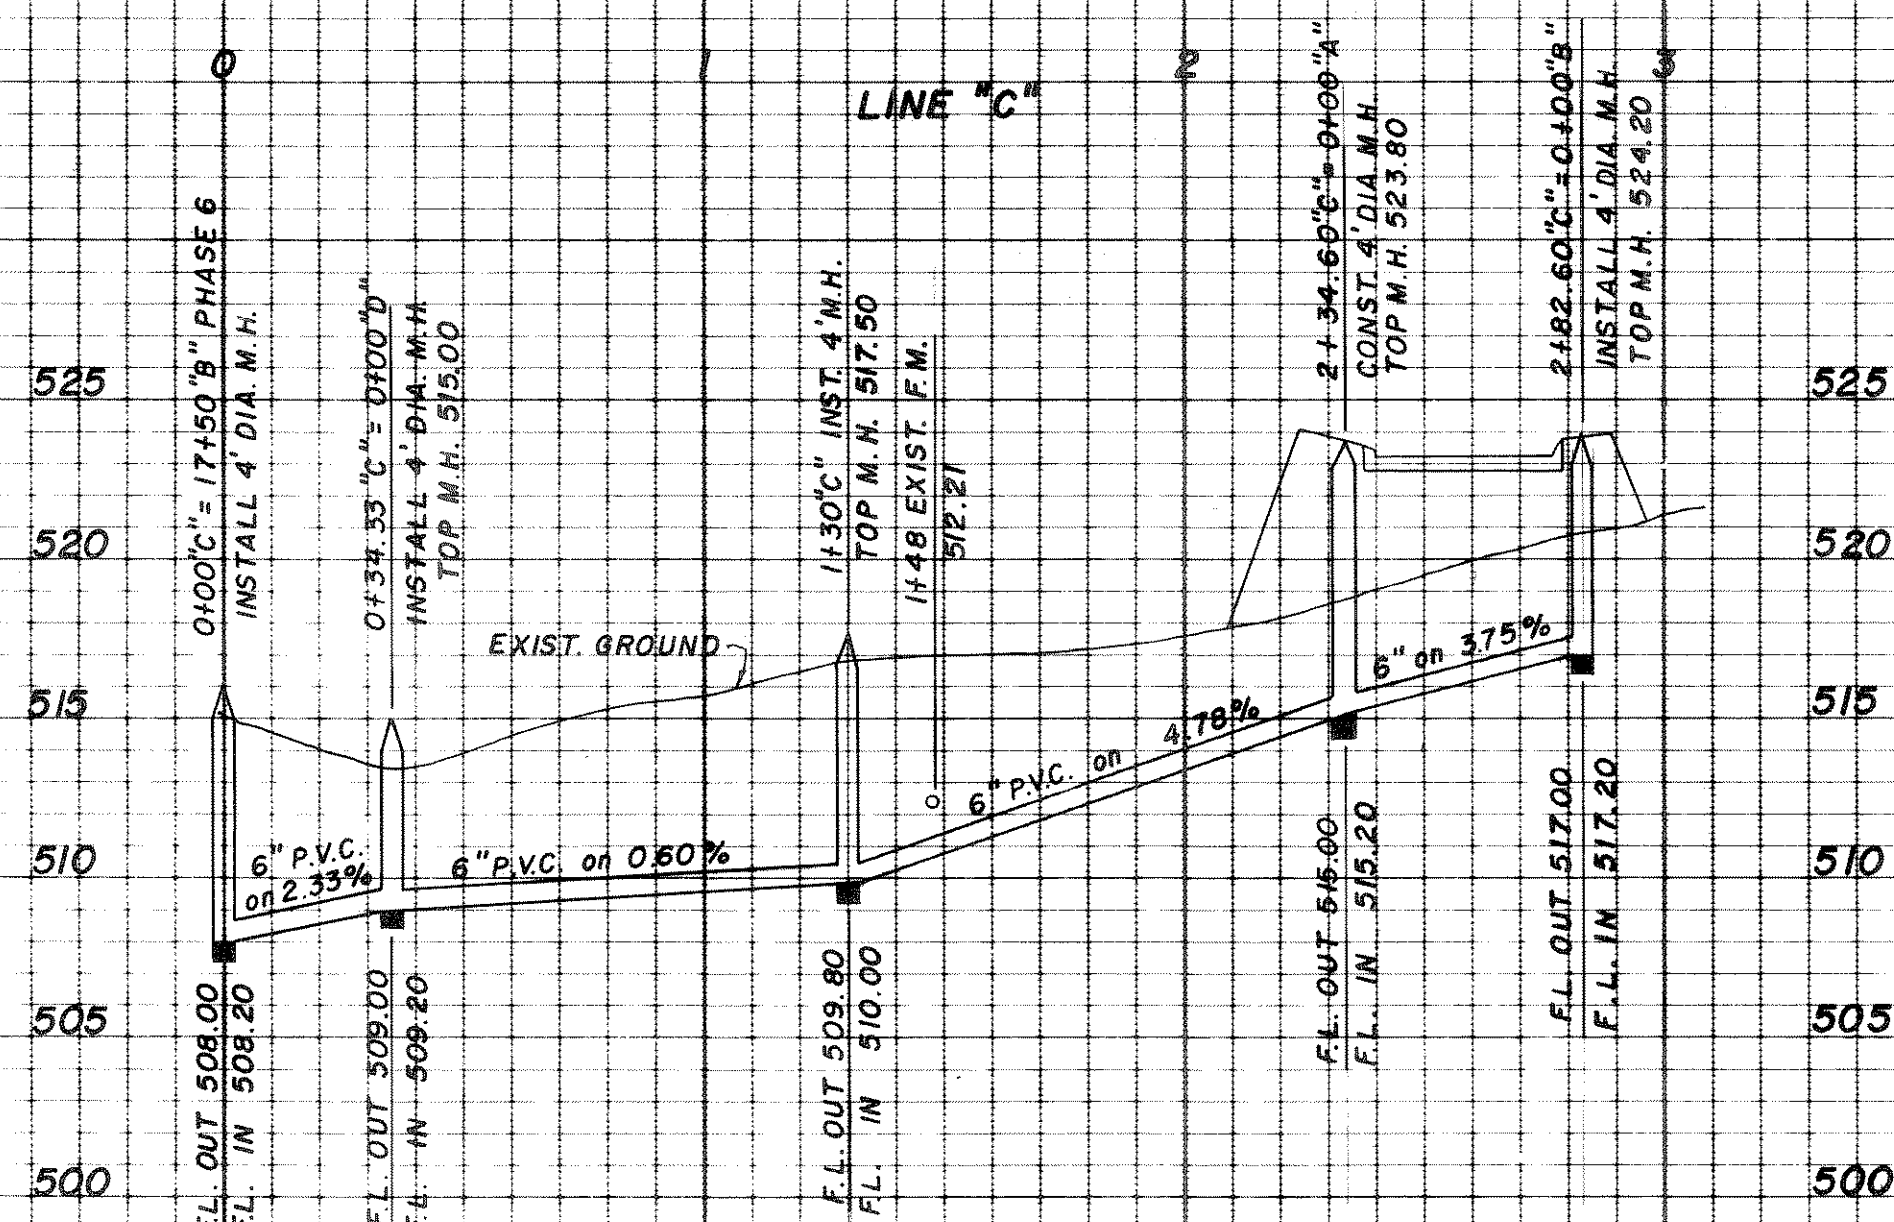

CHANDLERS LANDING PHASE TEN						
PROPOSED SANITARY SEWER						
LINES "B" "C" "D"						
ROCKWALL, TEXAS						
DESIGNED BY HAROLD EVANS - CONSULTING ENGINEER						
DESIGN	DRAWN	DATE	SCALE	NOTES	FILE	NO.
J. T. S.	Danny O.	7-23-75	1"=40' H. 1"=6' V.			72122

AS BUILT

REVISED 12-21-77