


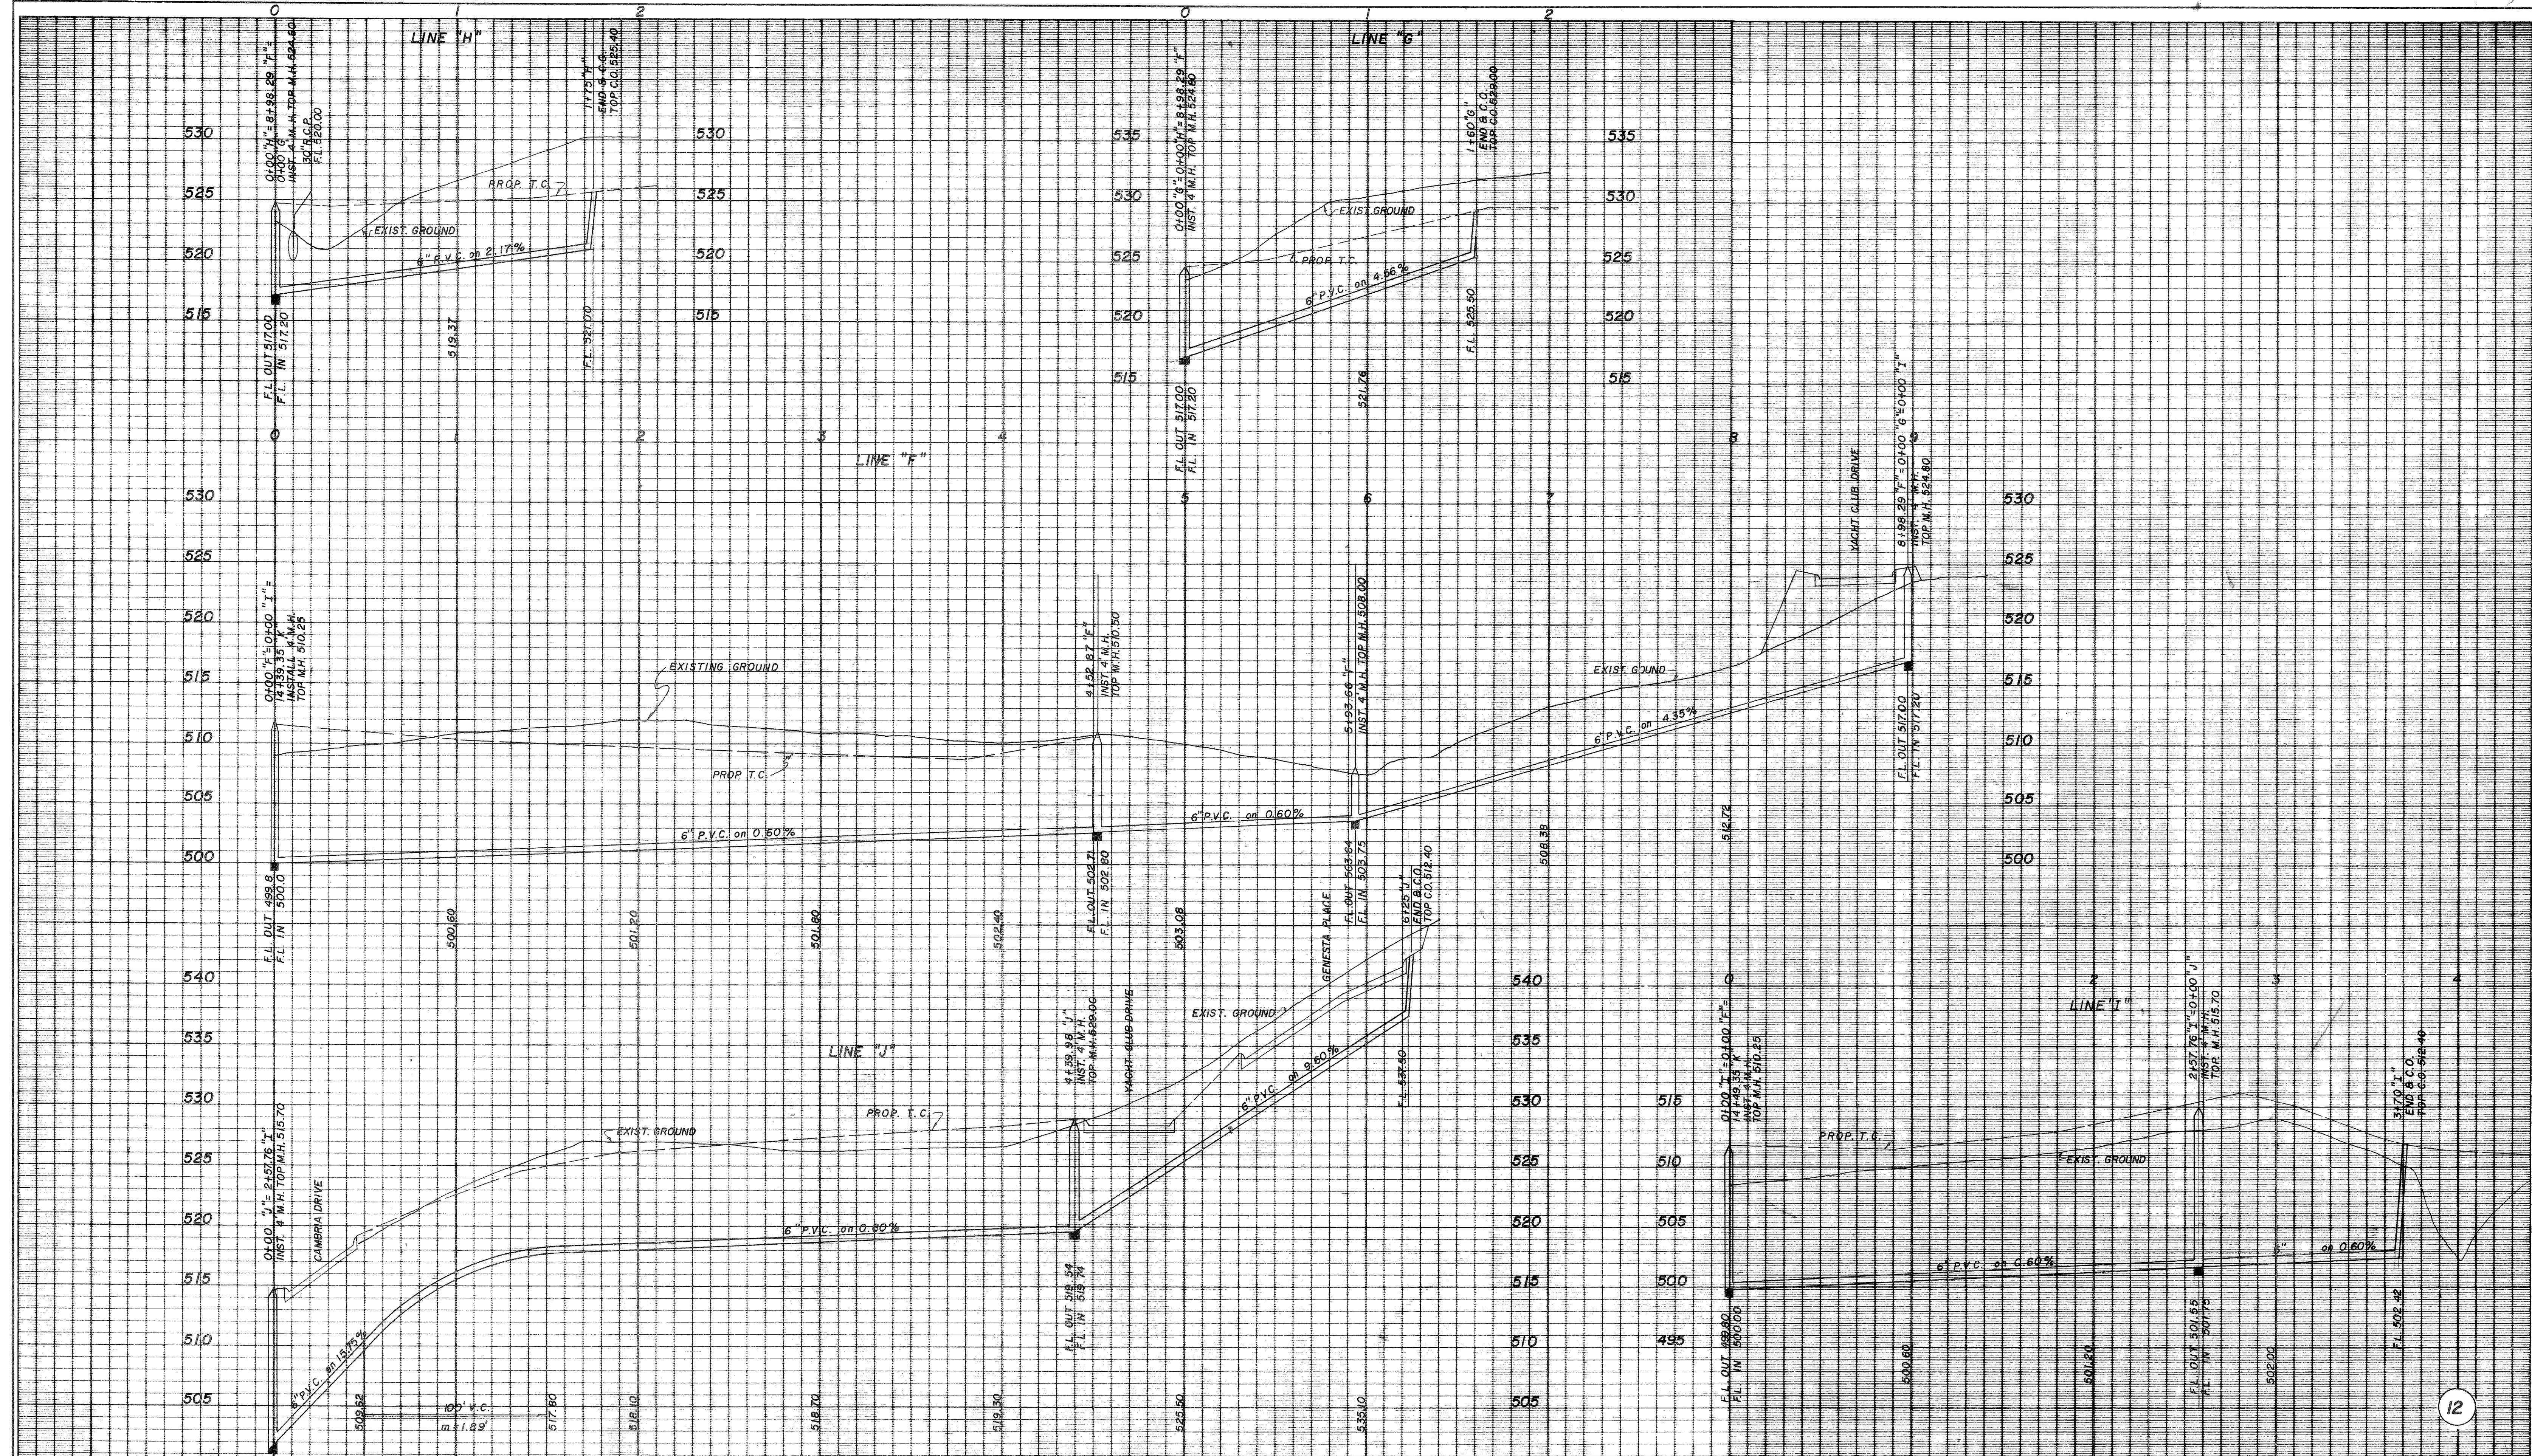

AS BUILT

CHANDLERS LANDING PHASE TEN						
PROPOSED SANITARY SEWER						
LINES "F" "G" "H" "I" "J"						
ROCKWALL, TEXAS						
DESIGNED BY: HAROLD EVANS - CONSULTING ENGINEER DALLAS						
DESIGN	DRAWN	DATE	SCALE	NOTES	FILE	NO.
J.T.S.	Danny O.	5-1-75	1"=40' H. 1"=6' V.			72122

REVISED 12-21-77