


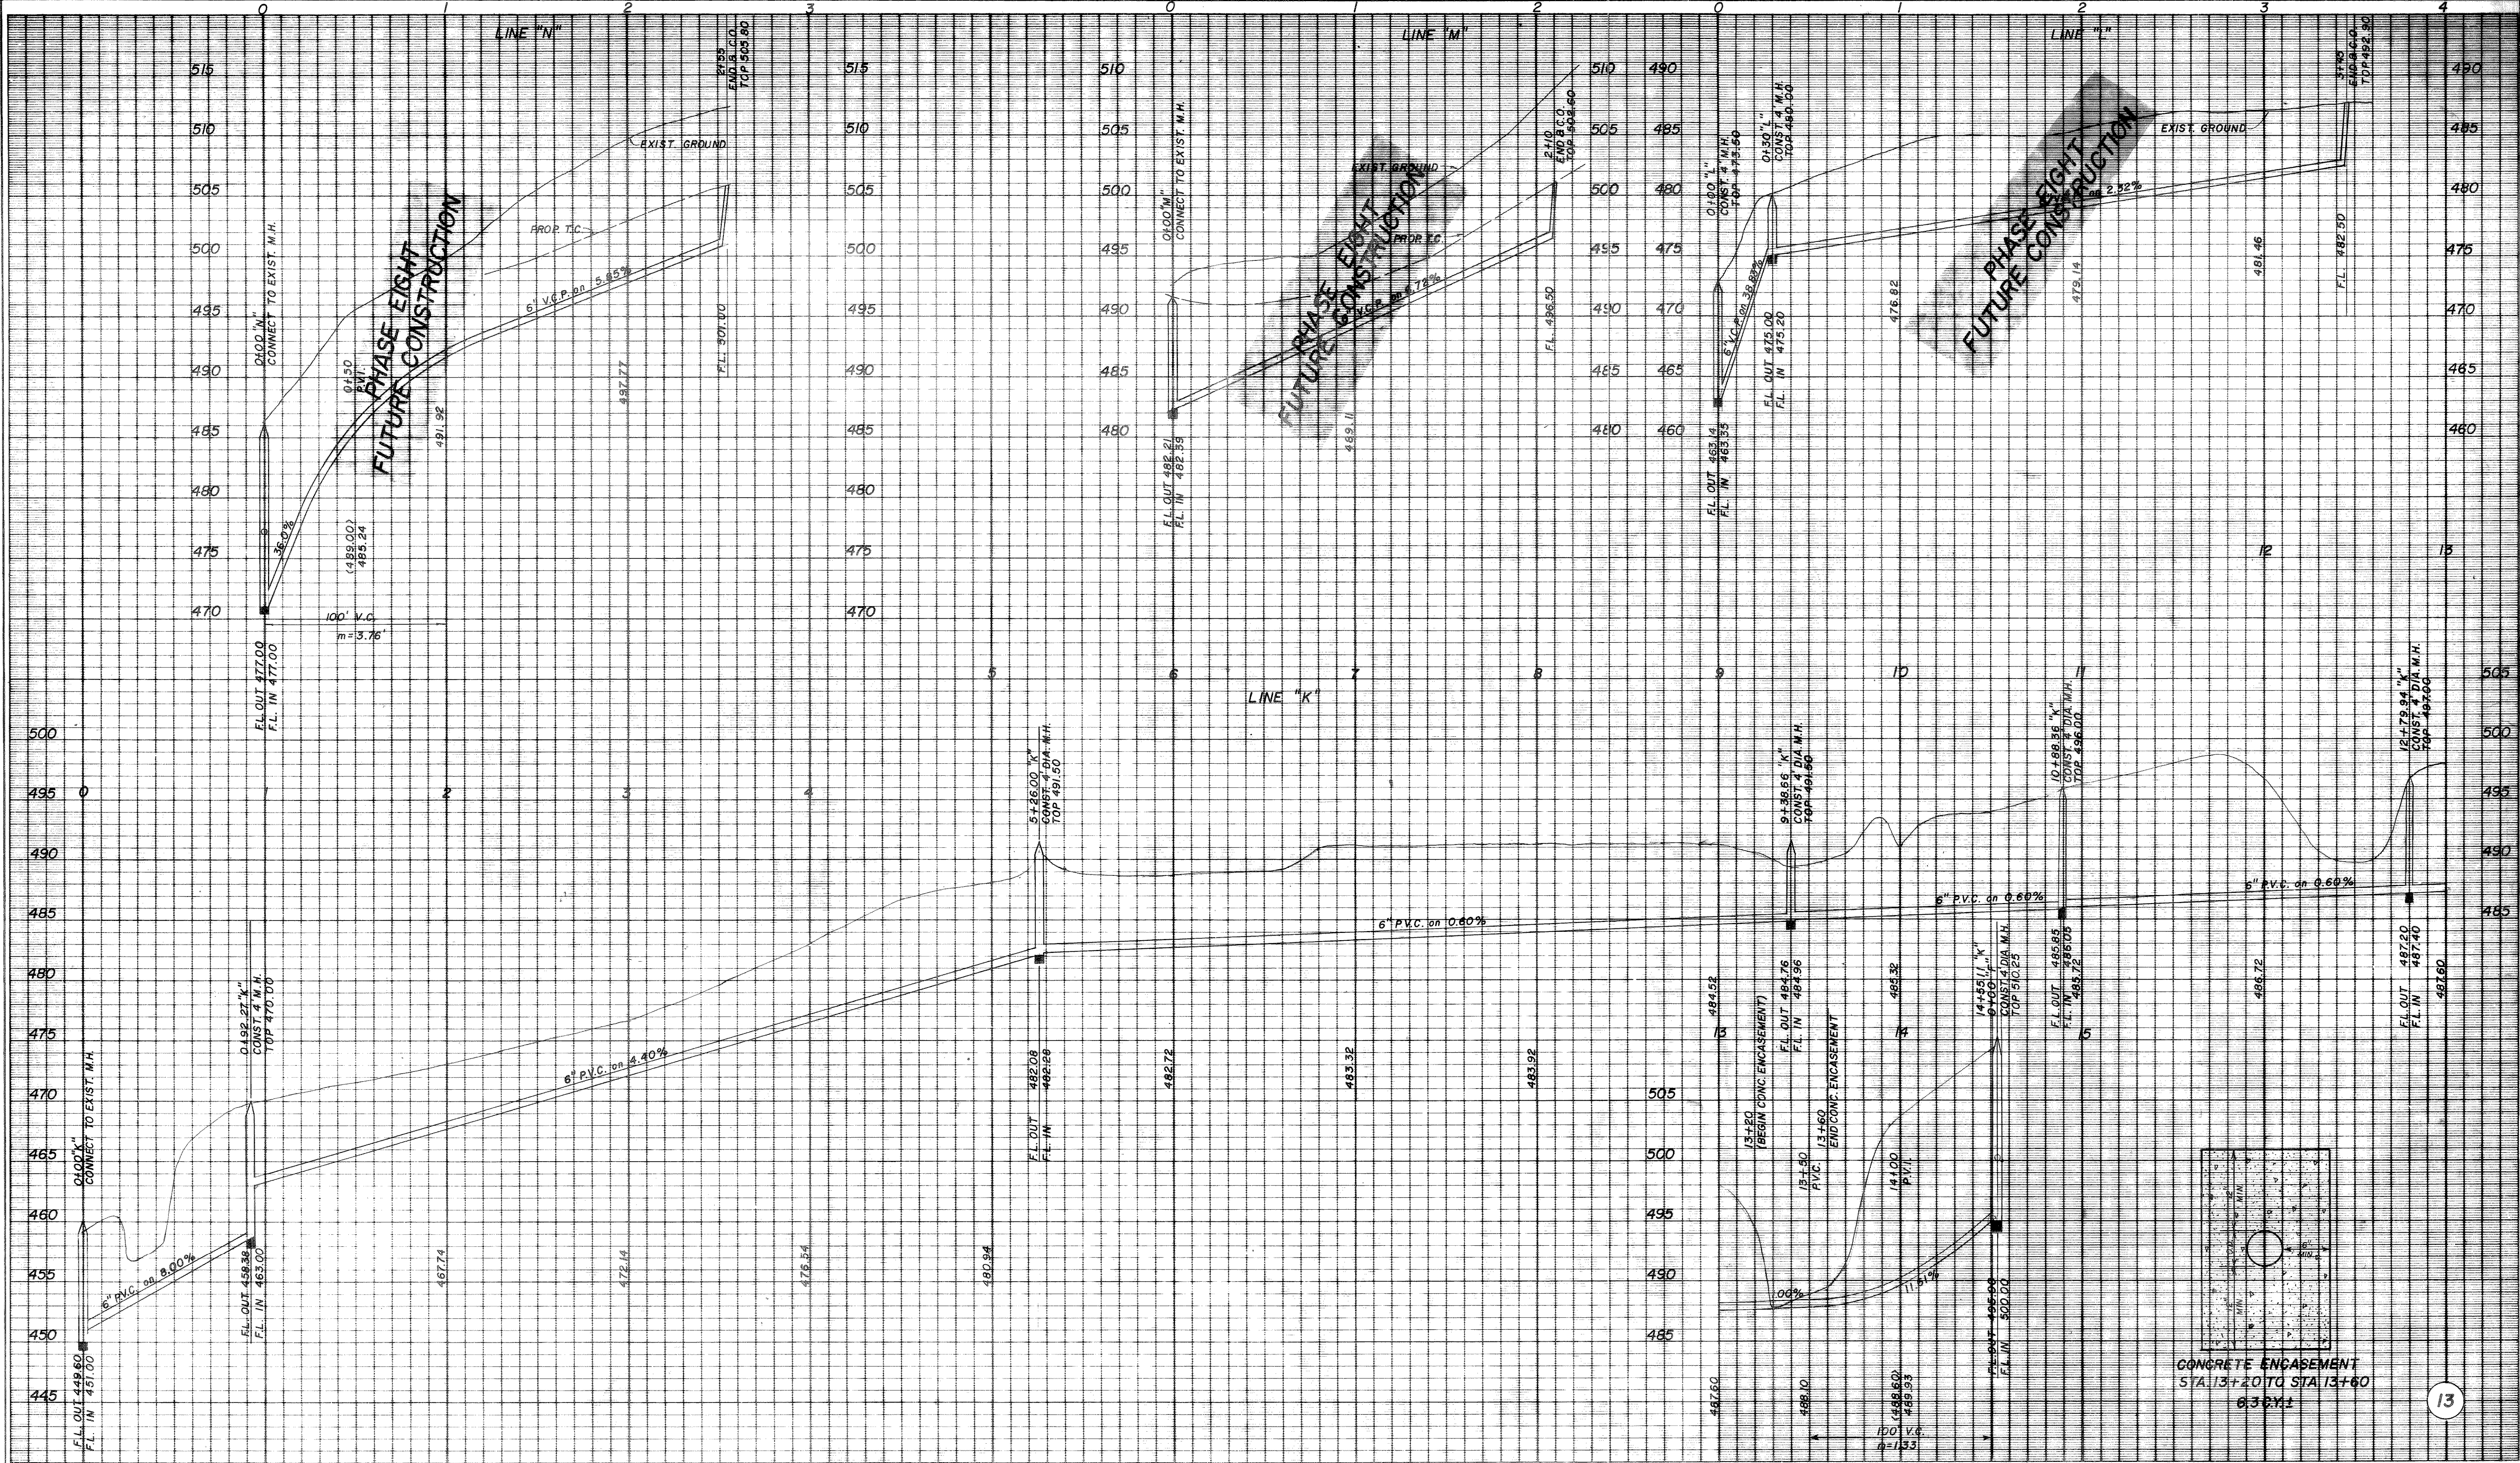

AS BUILT

| CHANDLER'S LANDING PHASE 8&10             |          |        |                           |       |      |       |
|-------------------------------------------|----------|--------|---------------------------|-------|------|-------|
| PROPOSED SANITARY SEWER                   |          |        |                           |       |      |       |
| LINES "K" "L" "M" "N"                     |          |        |                           |       |      |       |
| ROCKWALL, TEXAS                           |          |        |                           |       |      |       |
| HAROLD EVANS - CONSULTING ENGINEER DALLAS |          |        |                           |       |      |       |
| DESIGN                                    | DRAWN    | DATE   | SCALE                     | NOTES | FILE | NO.   |
| J.T.S.                                    | Danny O. | 5-1-75 | 1" = 40' H.<br>1" = 6' V. |       |      | 72122 |

REVISED: 12-21-77