



PROFILE	SURVIVED.....	BY.....	DATE.....
	PLOTTED.....		
	GRADES CHECKED.....		
	B. M.'s NOTED.....		
NOTE BOOK			

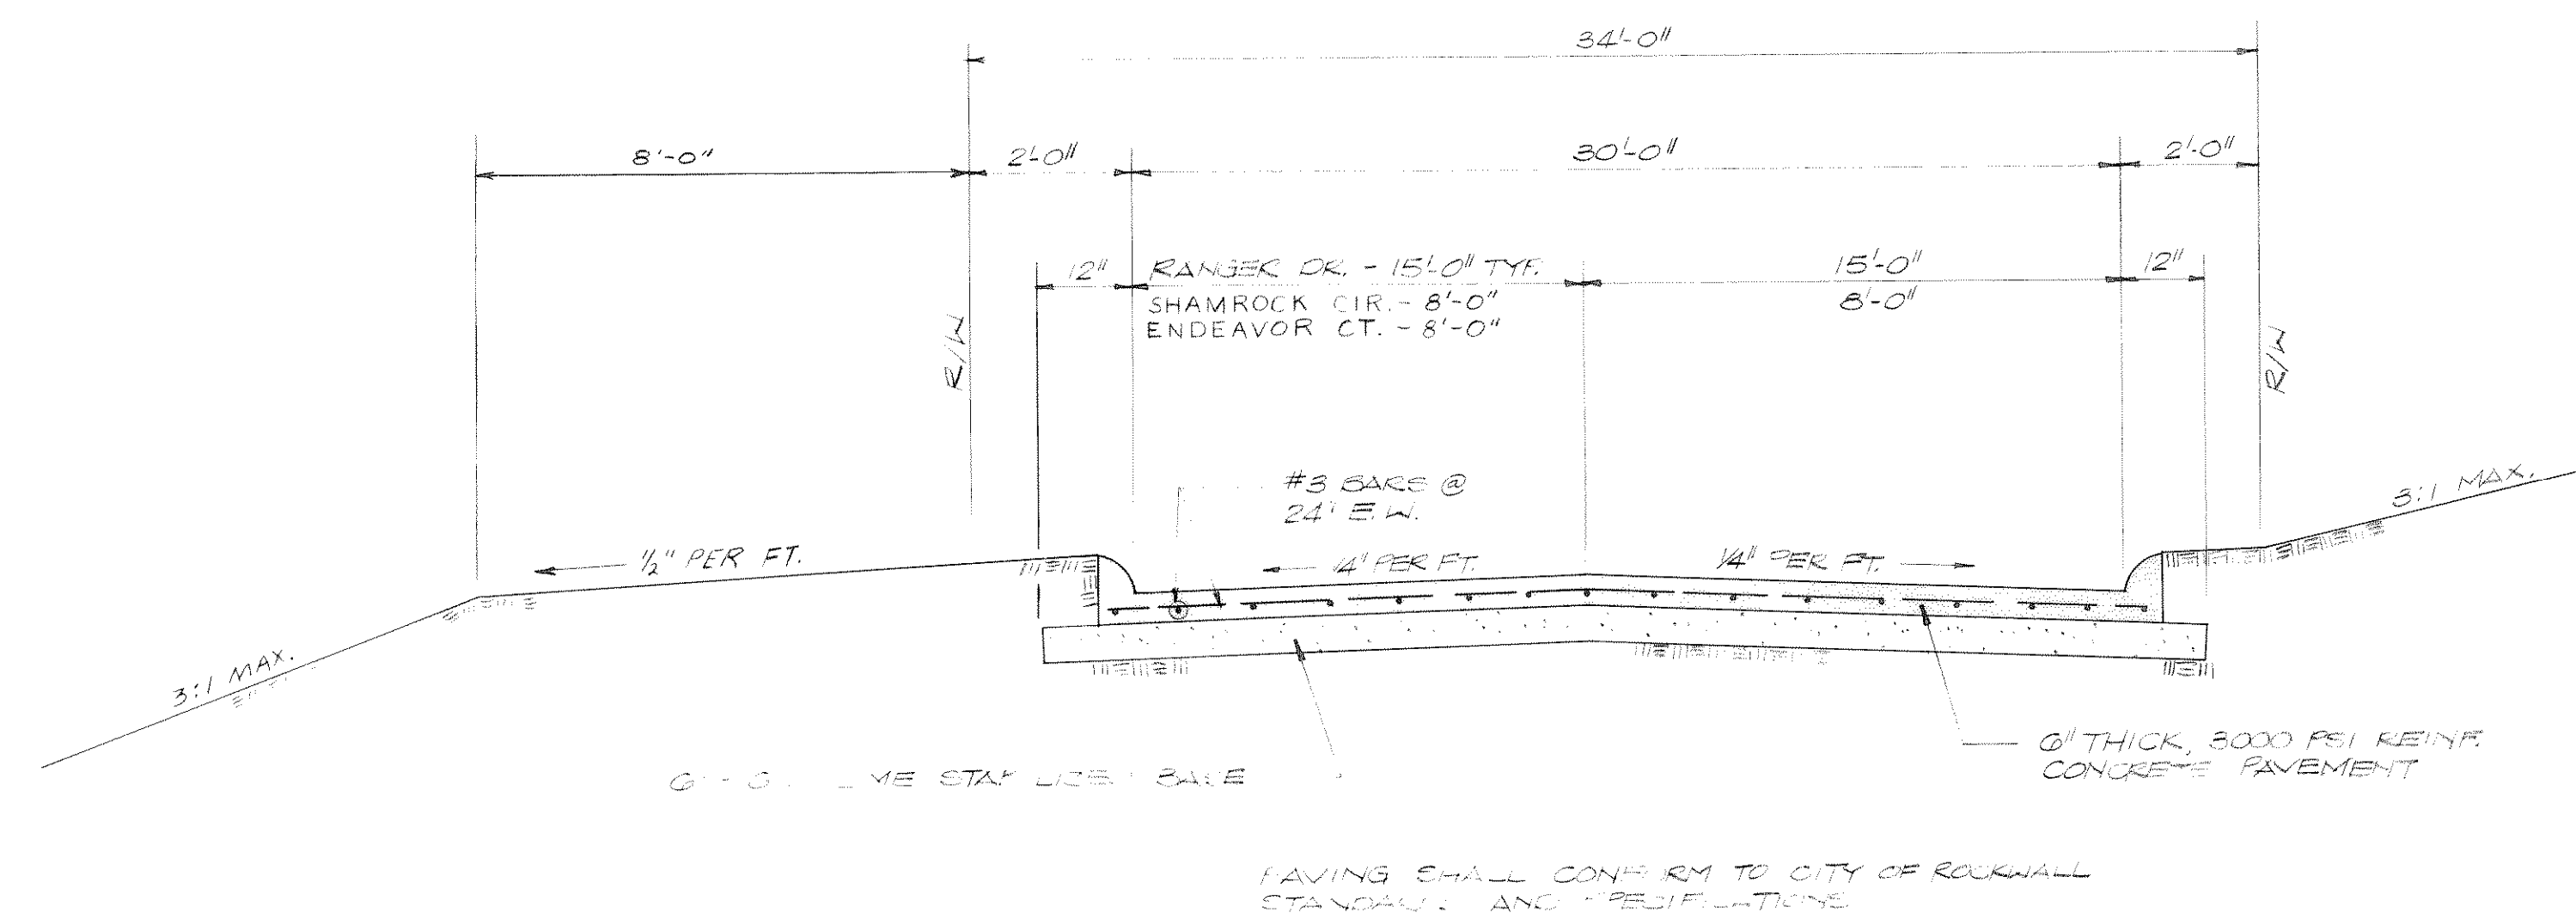

RANGER DRIVE

TYPICAL CONCRETE PAVING SECTION

SCALE: M.T.S.

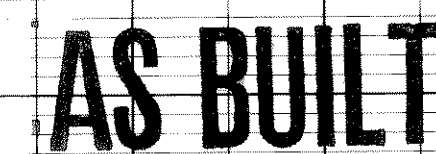

CHANDLERS LANDING
ROCKWALL, TEXAS
STORM DRAINAGE PLANS
PHASE FOURTEEN
POE & ASSOCIATES OF TEXAS, INC.

DESIGN	DRAWN	DATE	SCALE	NOTES	FILE	NO.
R.T.G.	R.T.G.	10-11-83	As Noted		6011-5	5 of 9