


CURVE DATA					SANITARY SEWER	
NO.	Δ	R	T	L		
1	17° 52' 18"	100.00'	15.72'	31.19'		
2	25° 27' 42"	100.00'	22.59'	44.44'		
3	16° 36' 36"	100.00'	14.60'	28.99'		
4	8° 02' 04"	100.00'	7.02'	14.02'		
5	22° 01' 15"	154.19'	30.00'	59.26'		
6	33° 13' 27"	90.00'	26.85'	52.19'		
7	65° 34' 40"	100.00'	64.42'	114.45'		
8	76° 53' 16"	30.00'	23.82'	40.26'		
9	45° 45' 38"	100.00'	42.20'	79.87'		
10	33° 15' 54"	75.00'	22.38'	43.50'		
11	90° 00' 00"	50.00'	50.00'	78.54'		
12	66° 34' 05"	50.23'	32.97'	58.36'		
13	28° 22' 25"	100.00'	23.43'	46.03'		
14	52° 23' 21"	75.00'	36.90'	68.58'		
15	43° 23' 09"	215.07'	85.56'	162.86'		
16	13° 46' 50"	291.04'	35.17'	70.00'		
17	67° 52' 50"	135.24'	91.02'	160.22'		
18	26° 20' 57"	135.24'	31.66'	62.19'		
19	29° 30' 50"	252.37'	66.48'	130.00'		
20	17° 26' 53"	252.37'	38.80'	77.00'		
21	9° 35' 34"	424.15'	35.59'	71.01'		

Existing

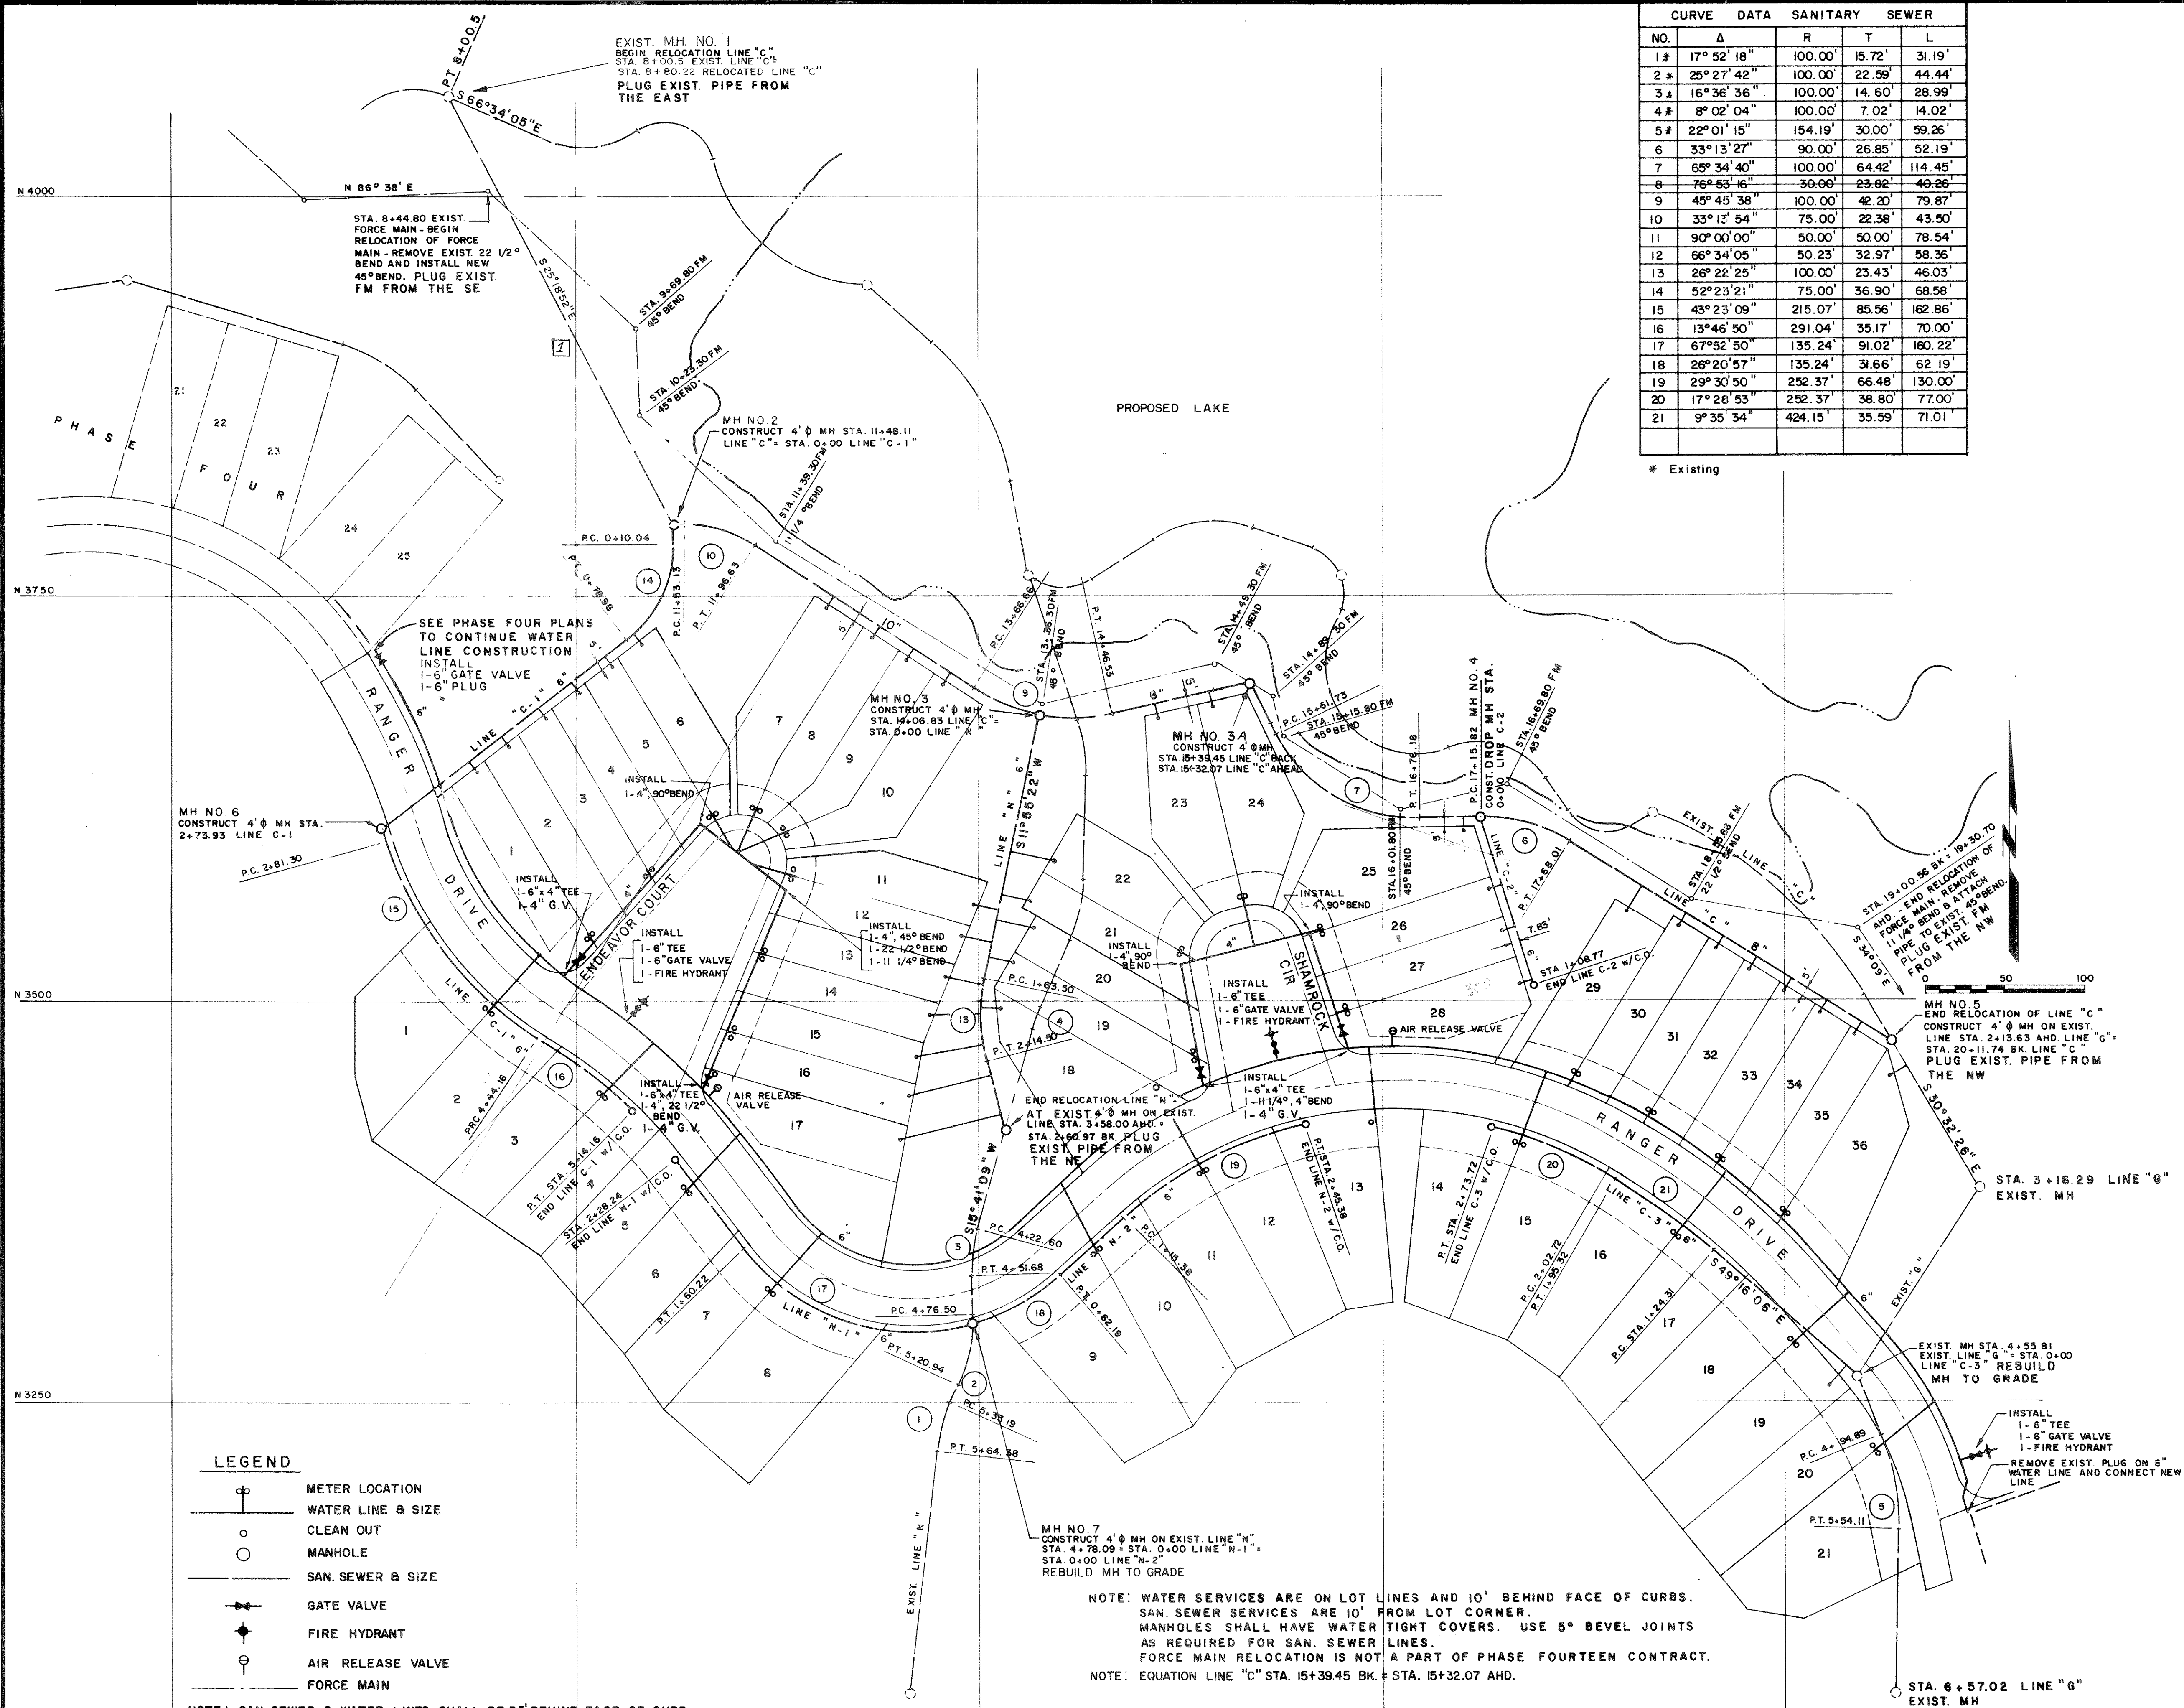

LEGEND

- METER LOCATION
- WATER LINE & SIZE
- CLEAN OUT
- MANHOLE
- SAN. SEWER & SIZE
- GATE VALVE
- FIRE HYDRANT
- AIR RELEASE VALVE
- FORCE MAIN

NOTE: SAN. SEWER & WATER LINES SHALL BE 35' BEHIND FACE OF CURB
UNLESS OTHERWISE NOTED. INSTALLATION SHALL BE IN ACCORDANCE
WITH ROCKWALL CITY STANDARDS AND SPECIFICATIONS.

NOTE: WATER SERVICES ARE ON LOT LINES AND 10' BEHIND FACE OF CURBS.
SAN. SEWER SERVICES ARE 10' FROM LOT CORNER.
MANHOLES SHALL HAVE WATER TIGHT COVERS. USE 5° BEVEL JOINTS
AS REQUIRED FOR SAN. SEWER LINES.
FORCE MAIN RELOCATION IS NOT A PART OF PHASE FOURTEEN CONTRACT.

NOTE: EQUATION LINE "C" STA. 15+39.45 BK. STA. 15+32.07 AHD.

AS BUILT

REVISION:

[1] - CHANGED SEWER 4-26-84
D.E.W.

CHANDLERS LANDING						
ROCKWALL, TEXAS						
PROPOSED WATER & SAN. SEWER PLANS						
PHASE FOURTEEN						
POE & ASSOCIATES OF TEXAS, INC.						
DESIGN	DRAWN	DATE	SCALE	NOTES	FILE	NO.
R.T.G.	A.E.L.	10-11-83	AS NOTED		6011-5	6 of 9

Chandler's Landing, Inc. REVISED 3-21-84 R.T.G. 72122