


FINAL SURVEY	SURVEYED	DATE	BY
NO.	PLOTTED		
	NOTE BOOK		
	AREA		
	CHECKED		

ORIGINAL SURVEY	SURVEYED	DATE	BY
NO.	PLOTTED		
	NOTE BOOK		
	AREA		
	CHECKED		

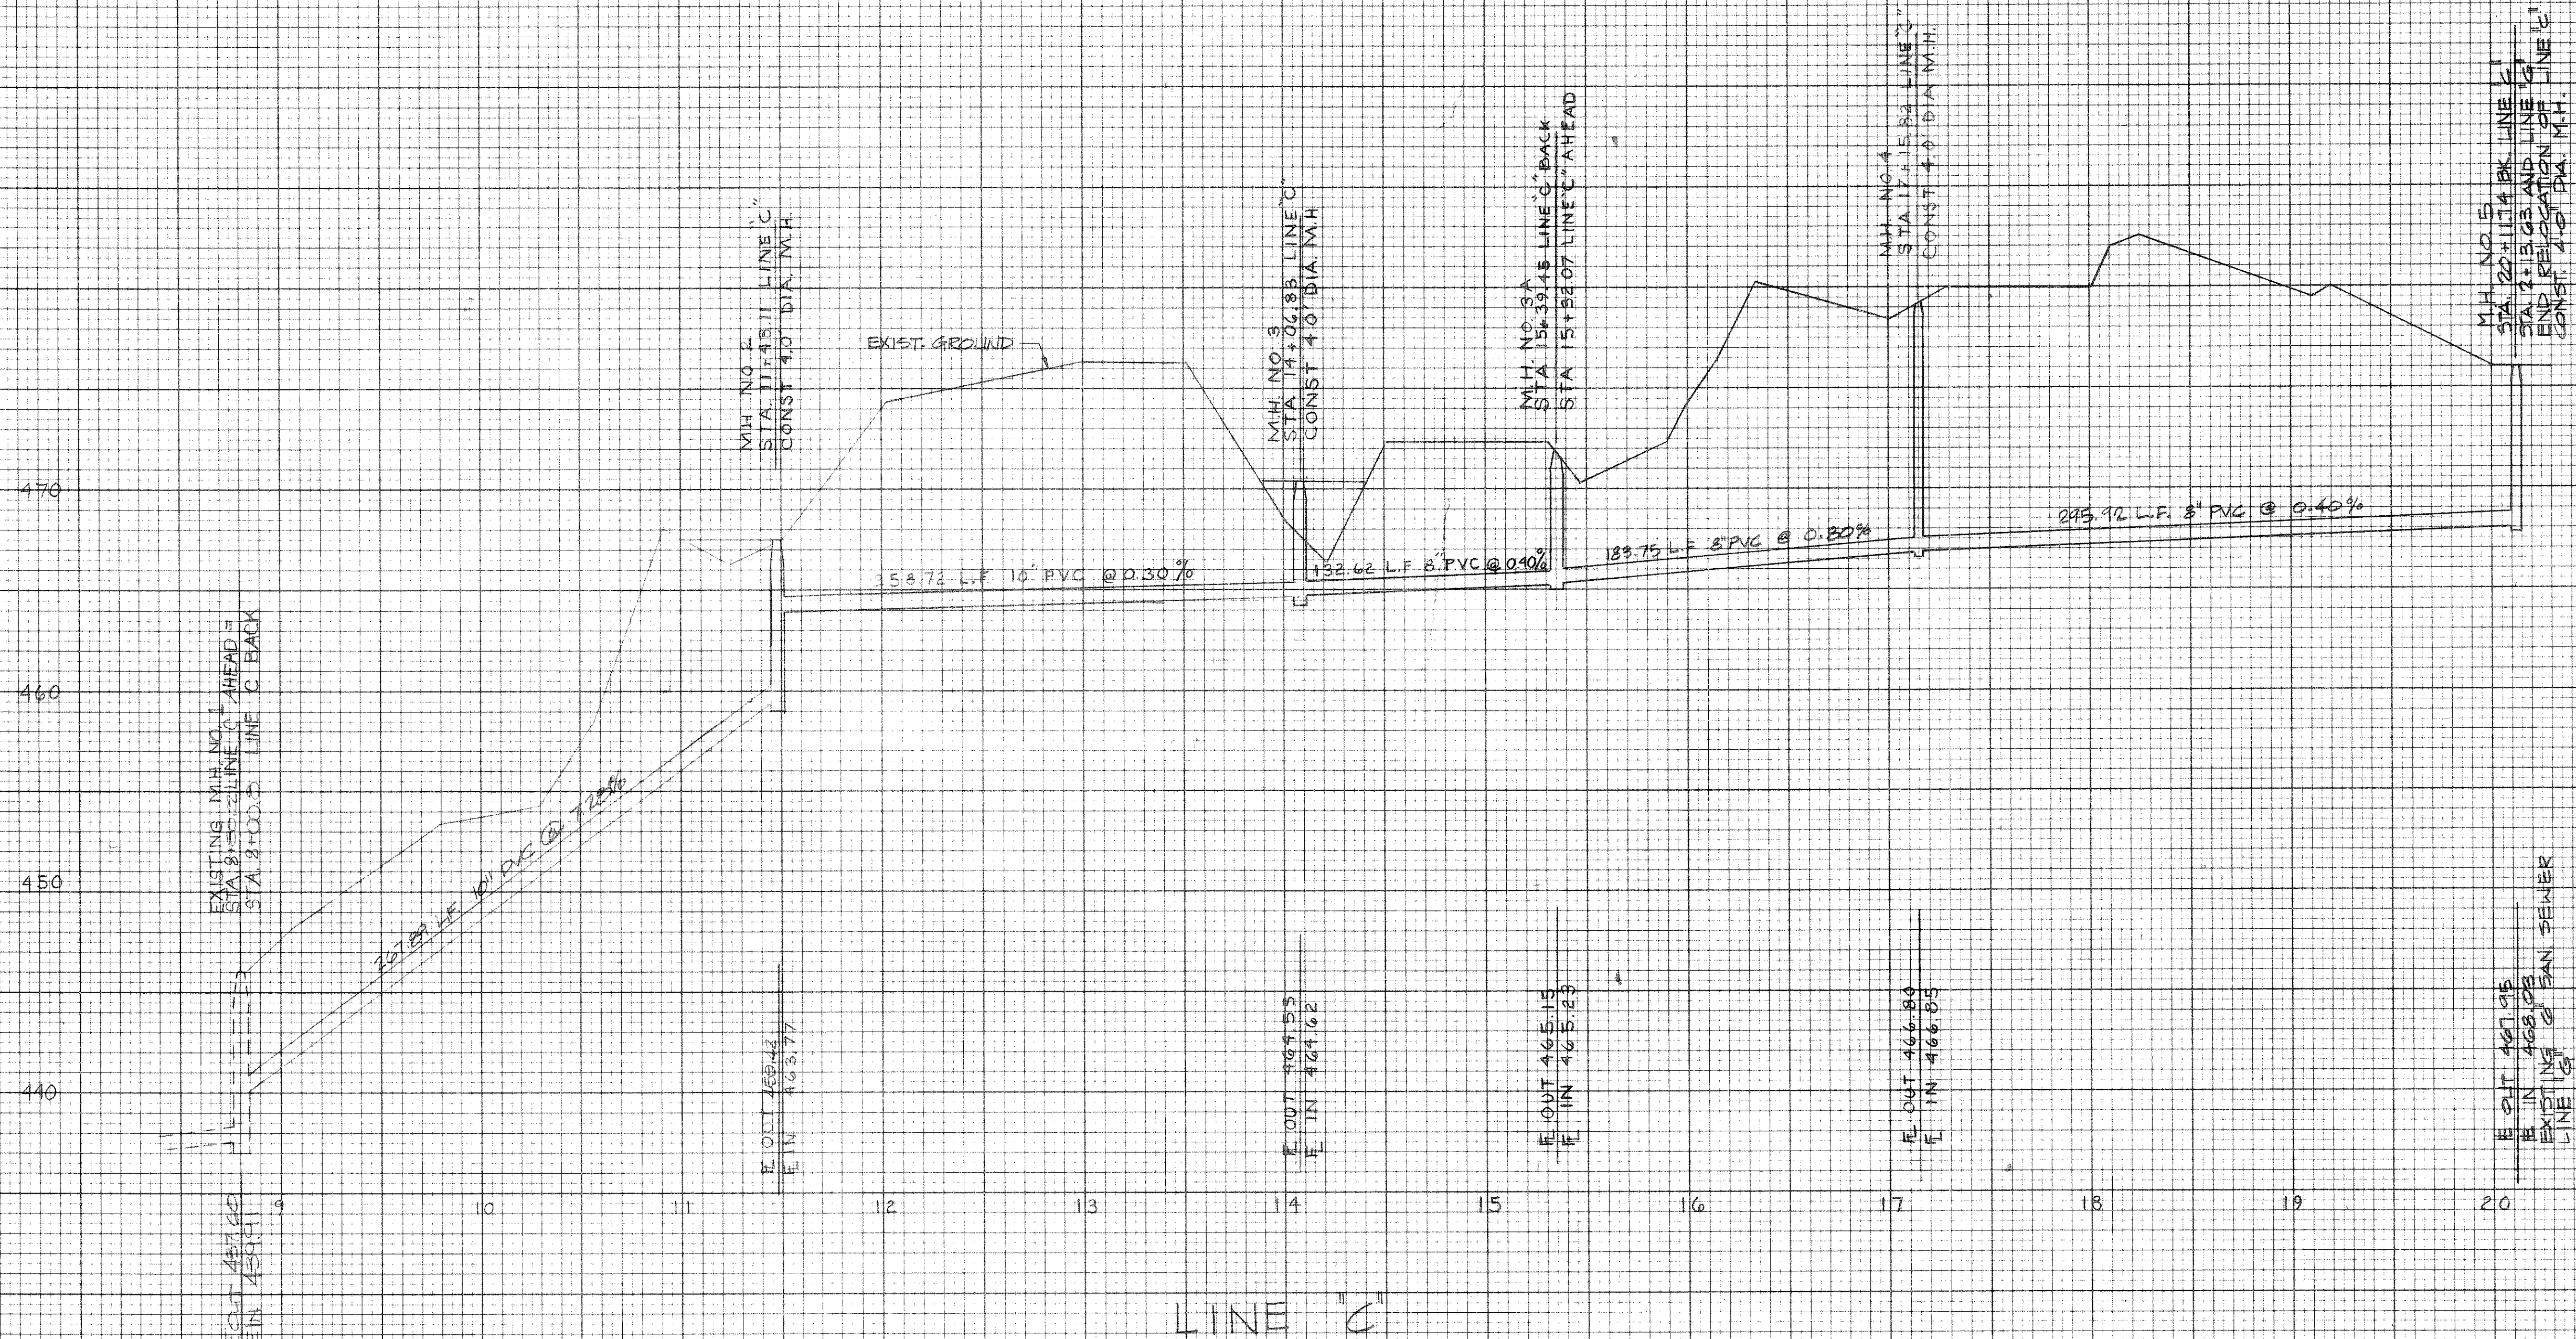

480
470
460
450

AS BUILT

CHANDLERS LANDING						
ROCKWALL, TEXAS						
SANITARY SEWER PROFILE						
PHASE FOURTEEN						
POE & ASSOCIATES OF TEXAS, INC.						
DESIGN	DRAWN	DATE	SCALE	NOTES	FILE	NO.
R.T.G.	M.A.L.	10-11-83	1"=5' Vert. 1"=50' Hor.	Revised 4-16-84	6011-5	7 of 9