
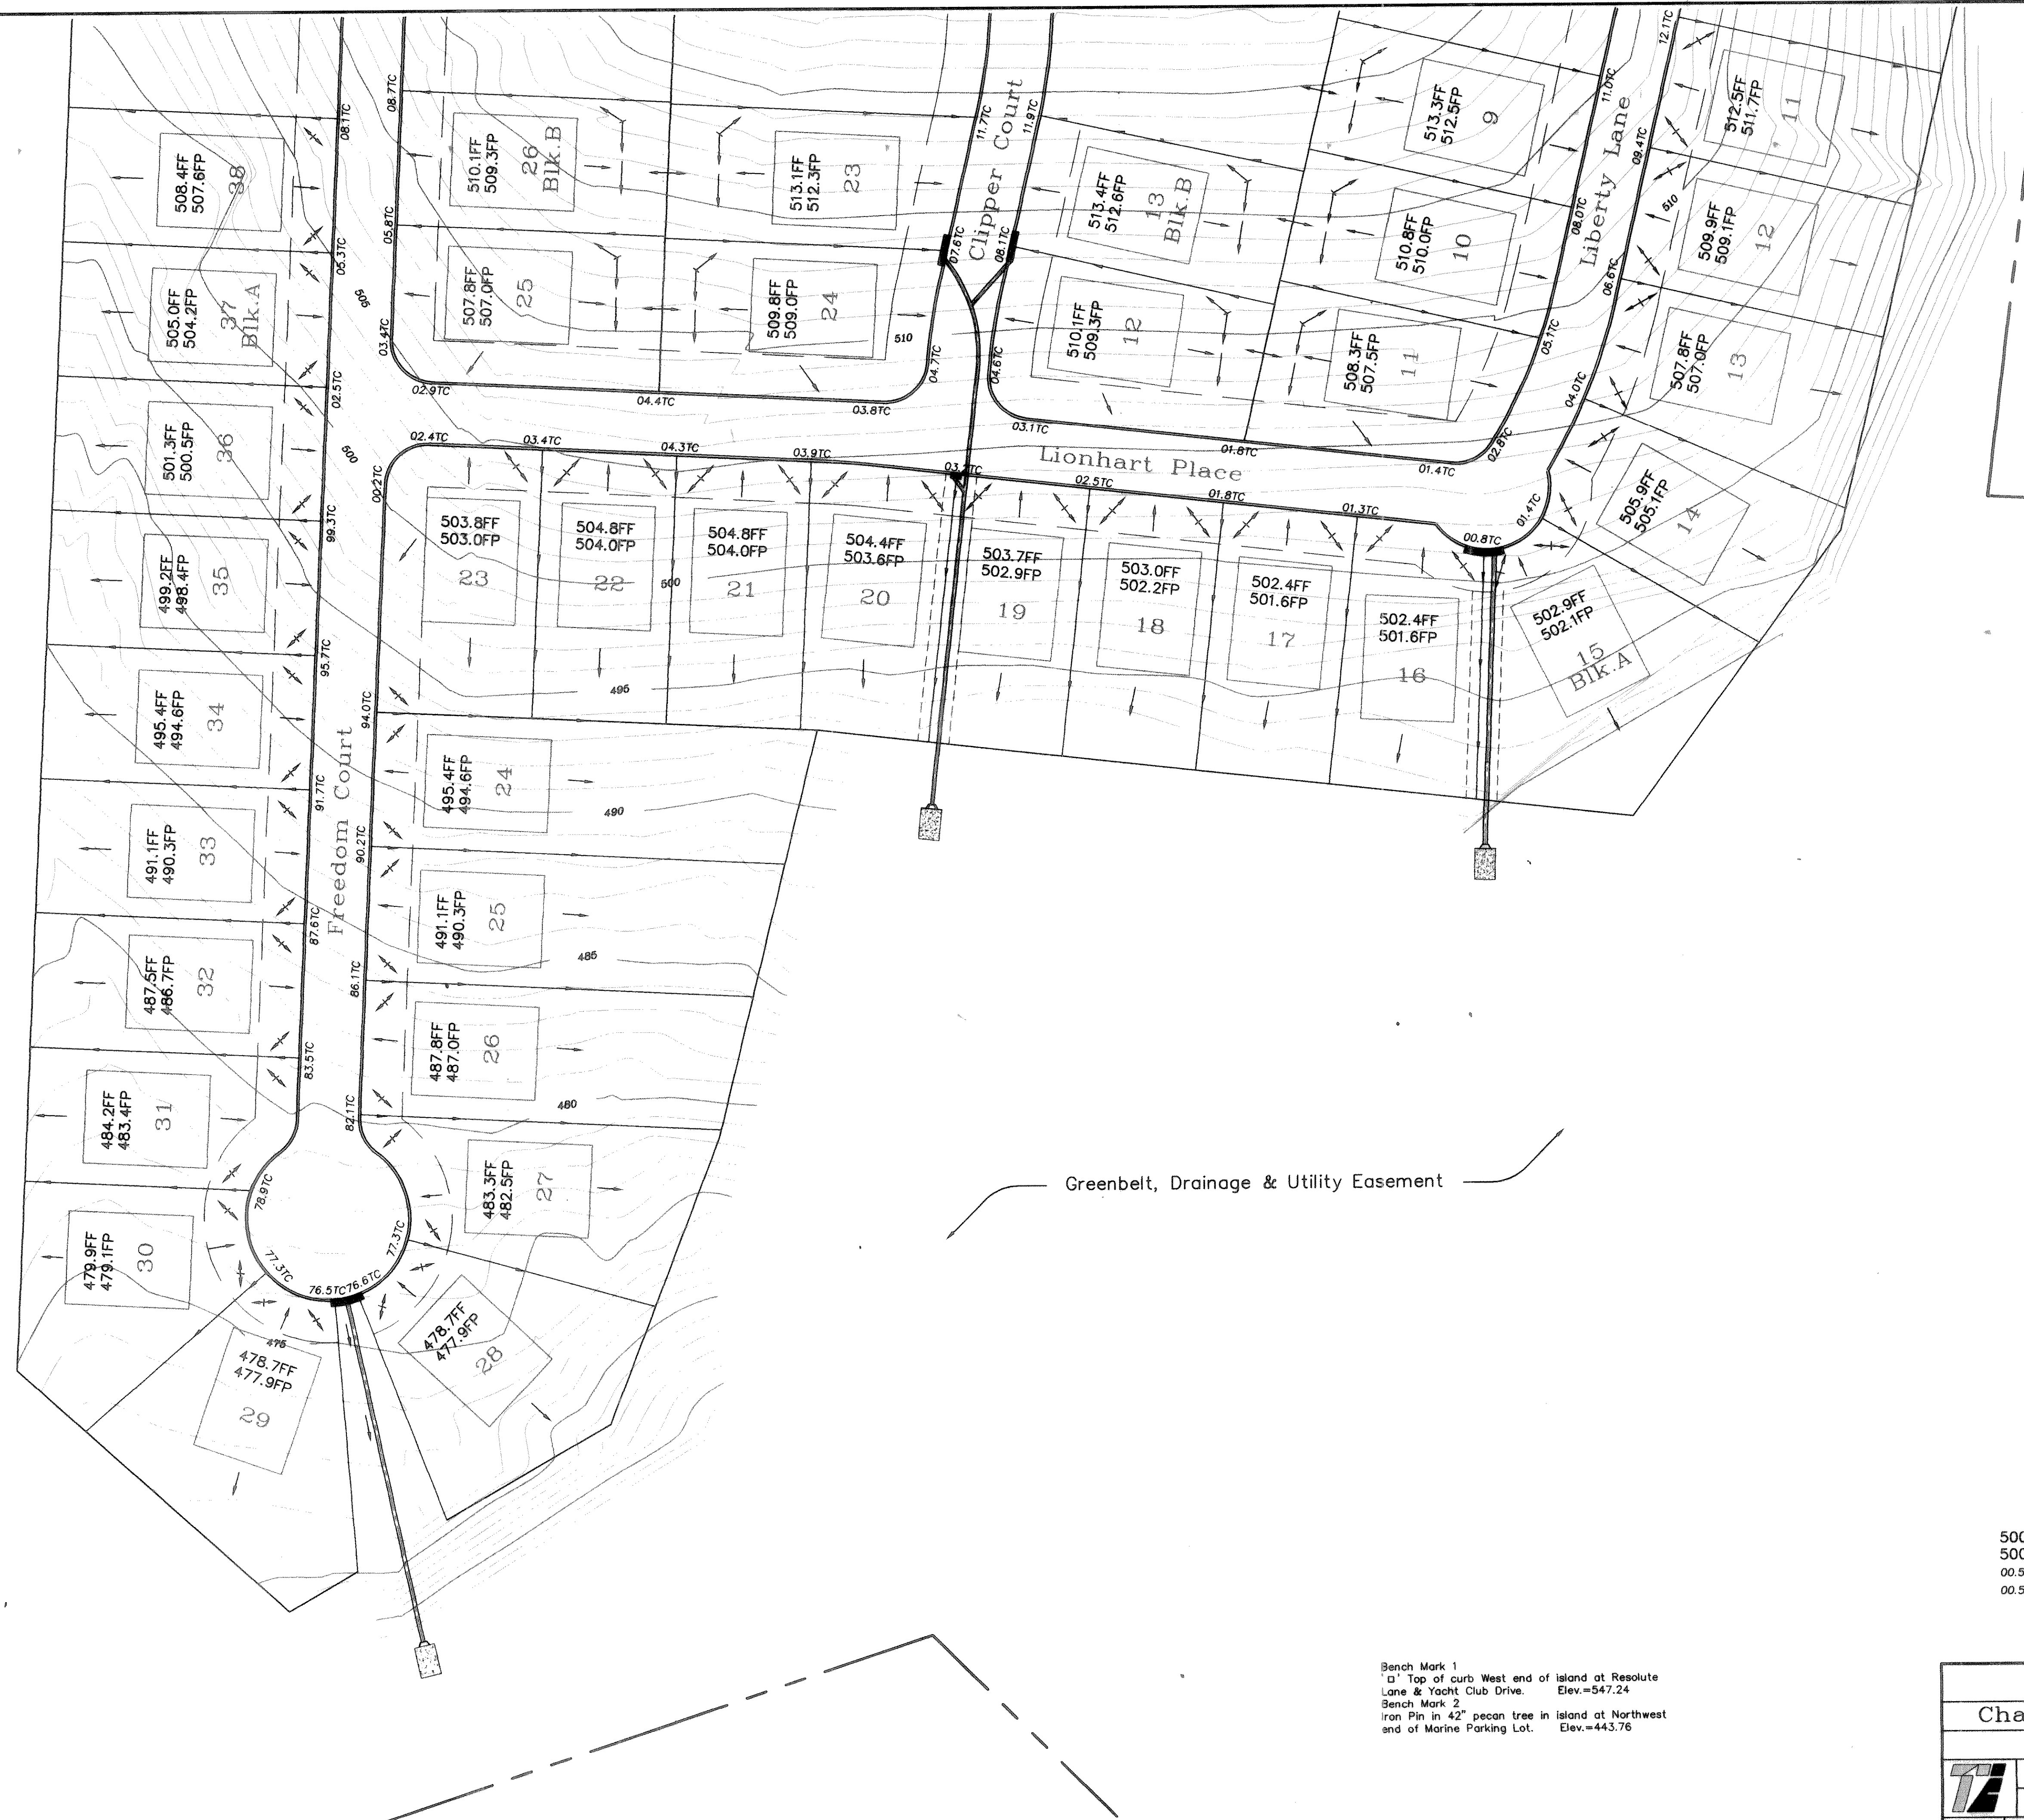


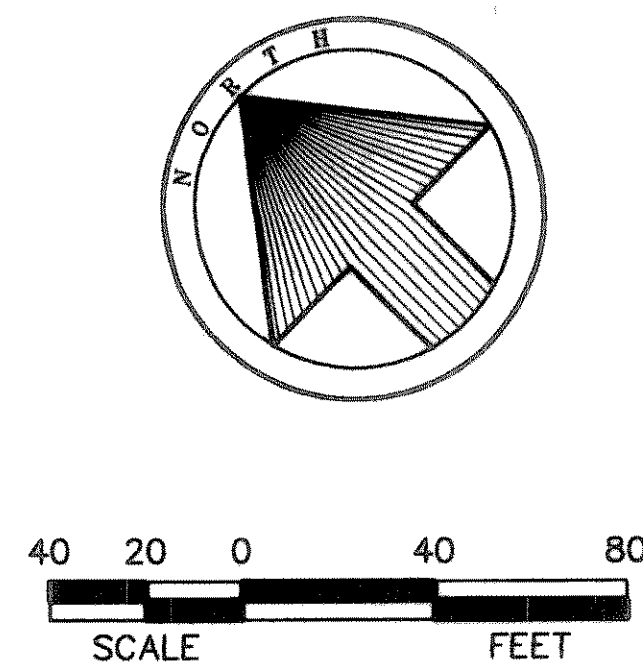

Bench Mark 1
 "a" Top of curb West end of island at Resolute
 Lane & Yacht Club Drive. Elev.=547.24
 Bench Mark 2
 Iron Pin in 42" pecan tree in island at Northwest
 end of Marine Parking Lot. Elev.=443.76

- Legend**
- 500.0FF = Prop. Finished Floor Elev.
 - 500.0FP = Prop. Finished Pad Elev.
 - 00.5TC = Top Of Curb Elev.
 - 00.5F = Finished Grade Elev.

LOT GRADING PLAN						
Chandlers Landing Phase 15						
City Of Rockwall, Texas						
TIPTON ENGINEERING, INC.						
6330 Belt Line Rd. ~ Suite C ~ Garland, Texas 75043						
DESIGN	DRAWN	DATE	SCALE	NOTES	FILE	NO.
T.E. Inc.	T.E. Inc.	7/94	1"=40'		4005	17