
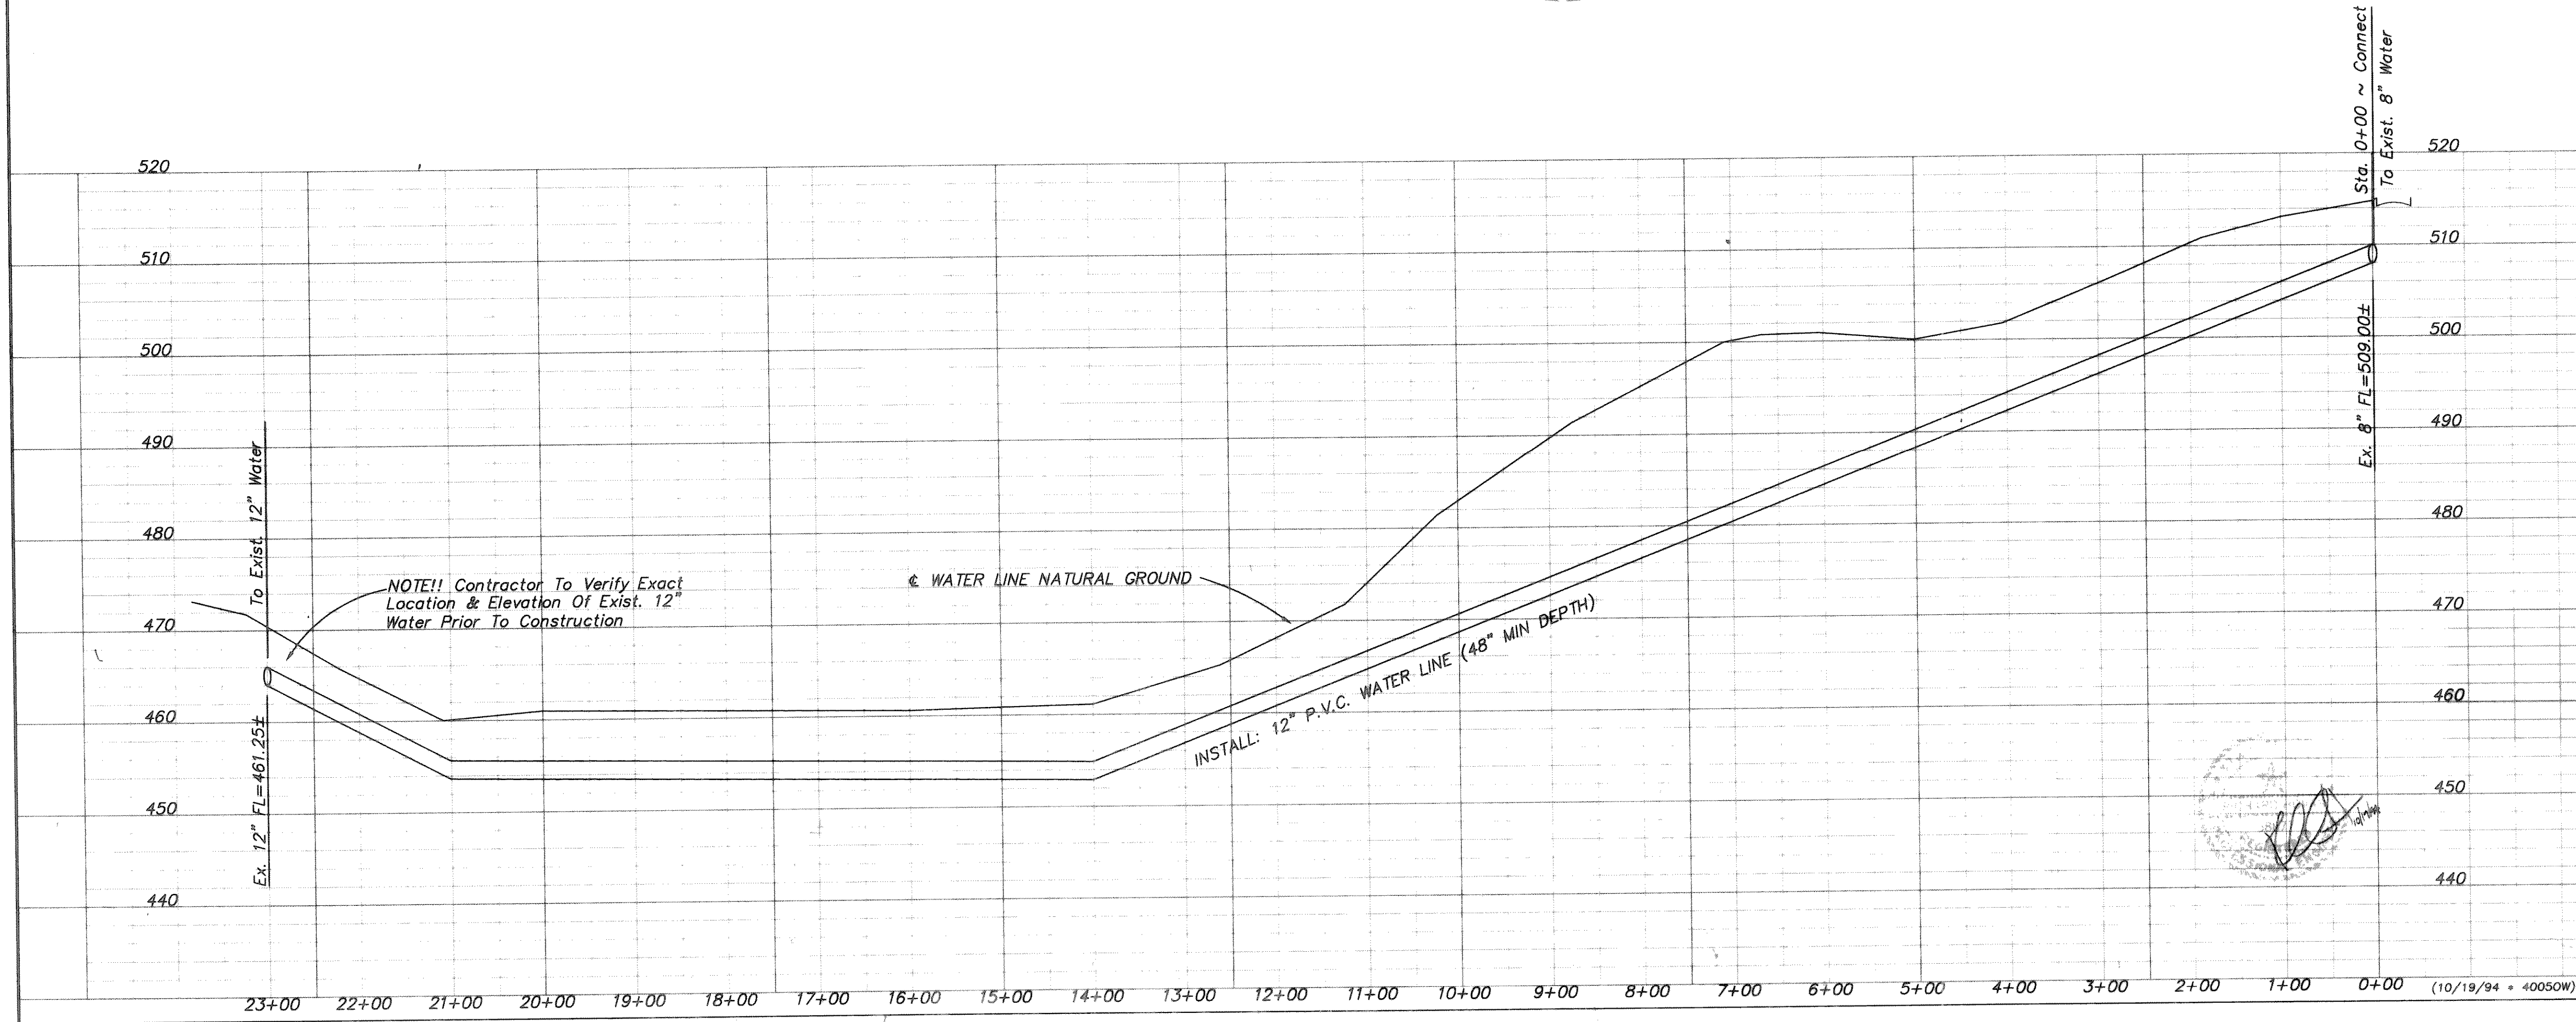
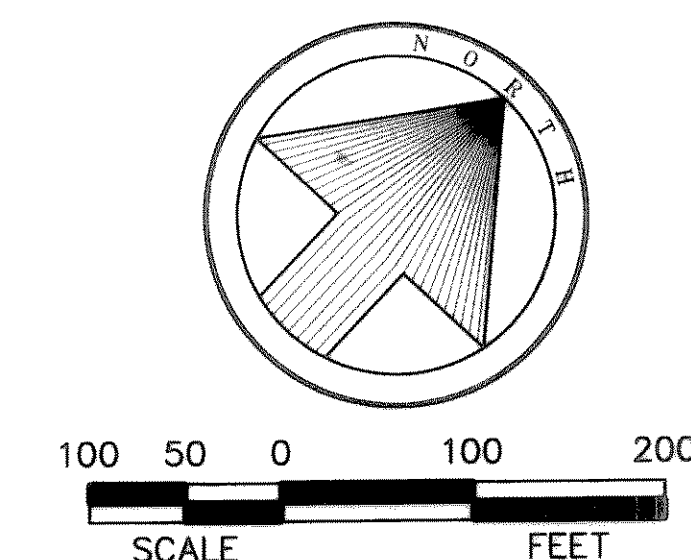


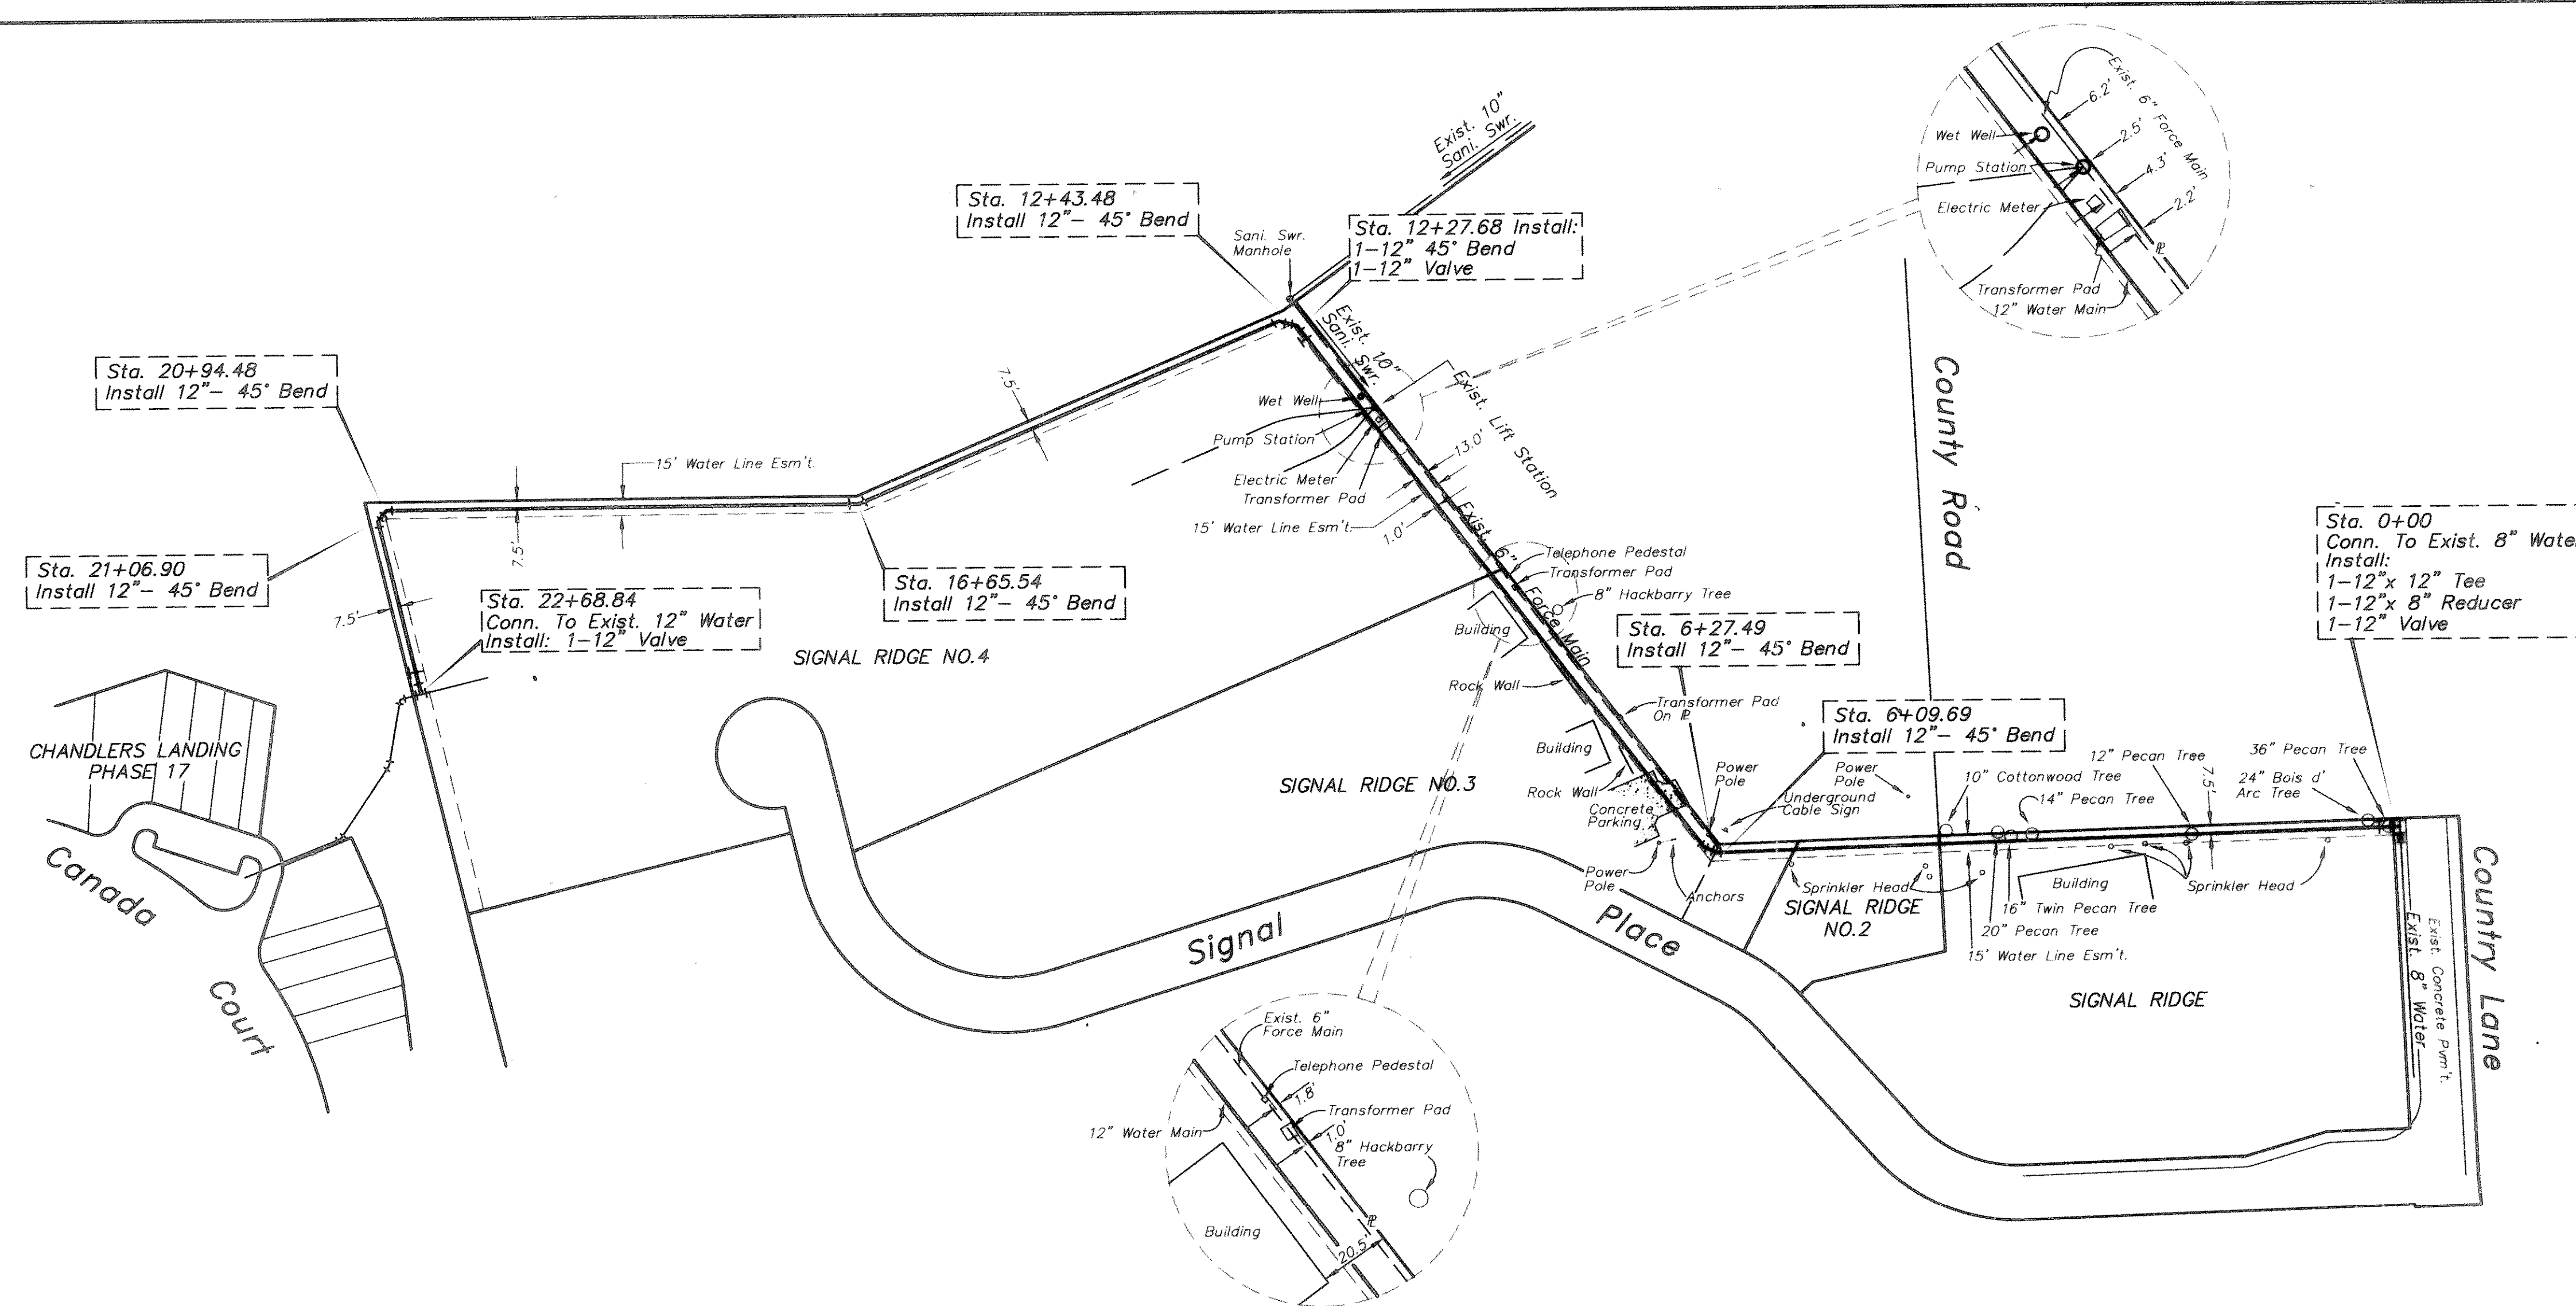

AS BUILT PLANS
11/15/95

The alignment and grade were set on the ground for construction per the plans. The engineer did not verify alignment or grades after construction. We are not aware of any changes or revisions to these plans during construction except as noted.

OFFSITE 12" WATER LINE CHANDLERS LANDING						
City Of Rockwall, Rockwall County, Texas						
TIPTON ENGINEERING, INC.						
6330 Belt Line Rd. ~ Suite C ~ Garland, Texas 75043						
DESIGN	DRAWN	DATE	SCALE	NOTES	FILE	NO.
T.E. inc.	T.E. inc.	08/94	H:1" = 100' V:1" = 10'		4005	1