


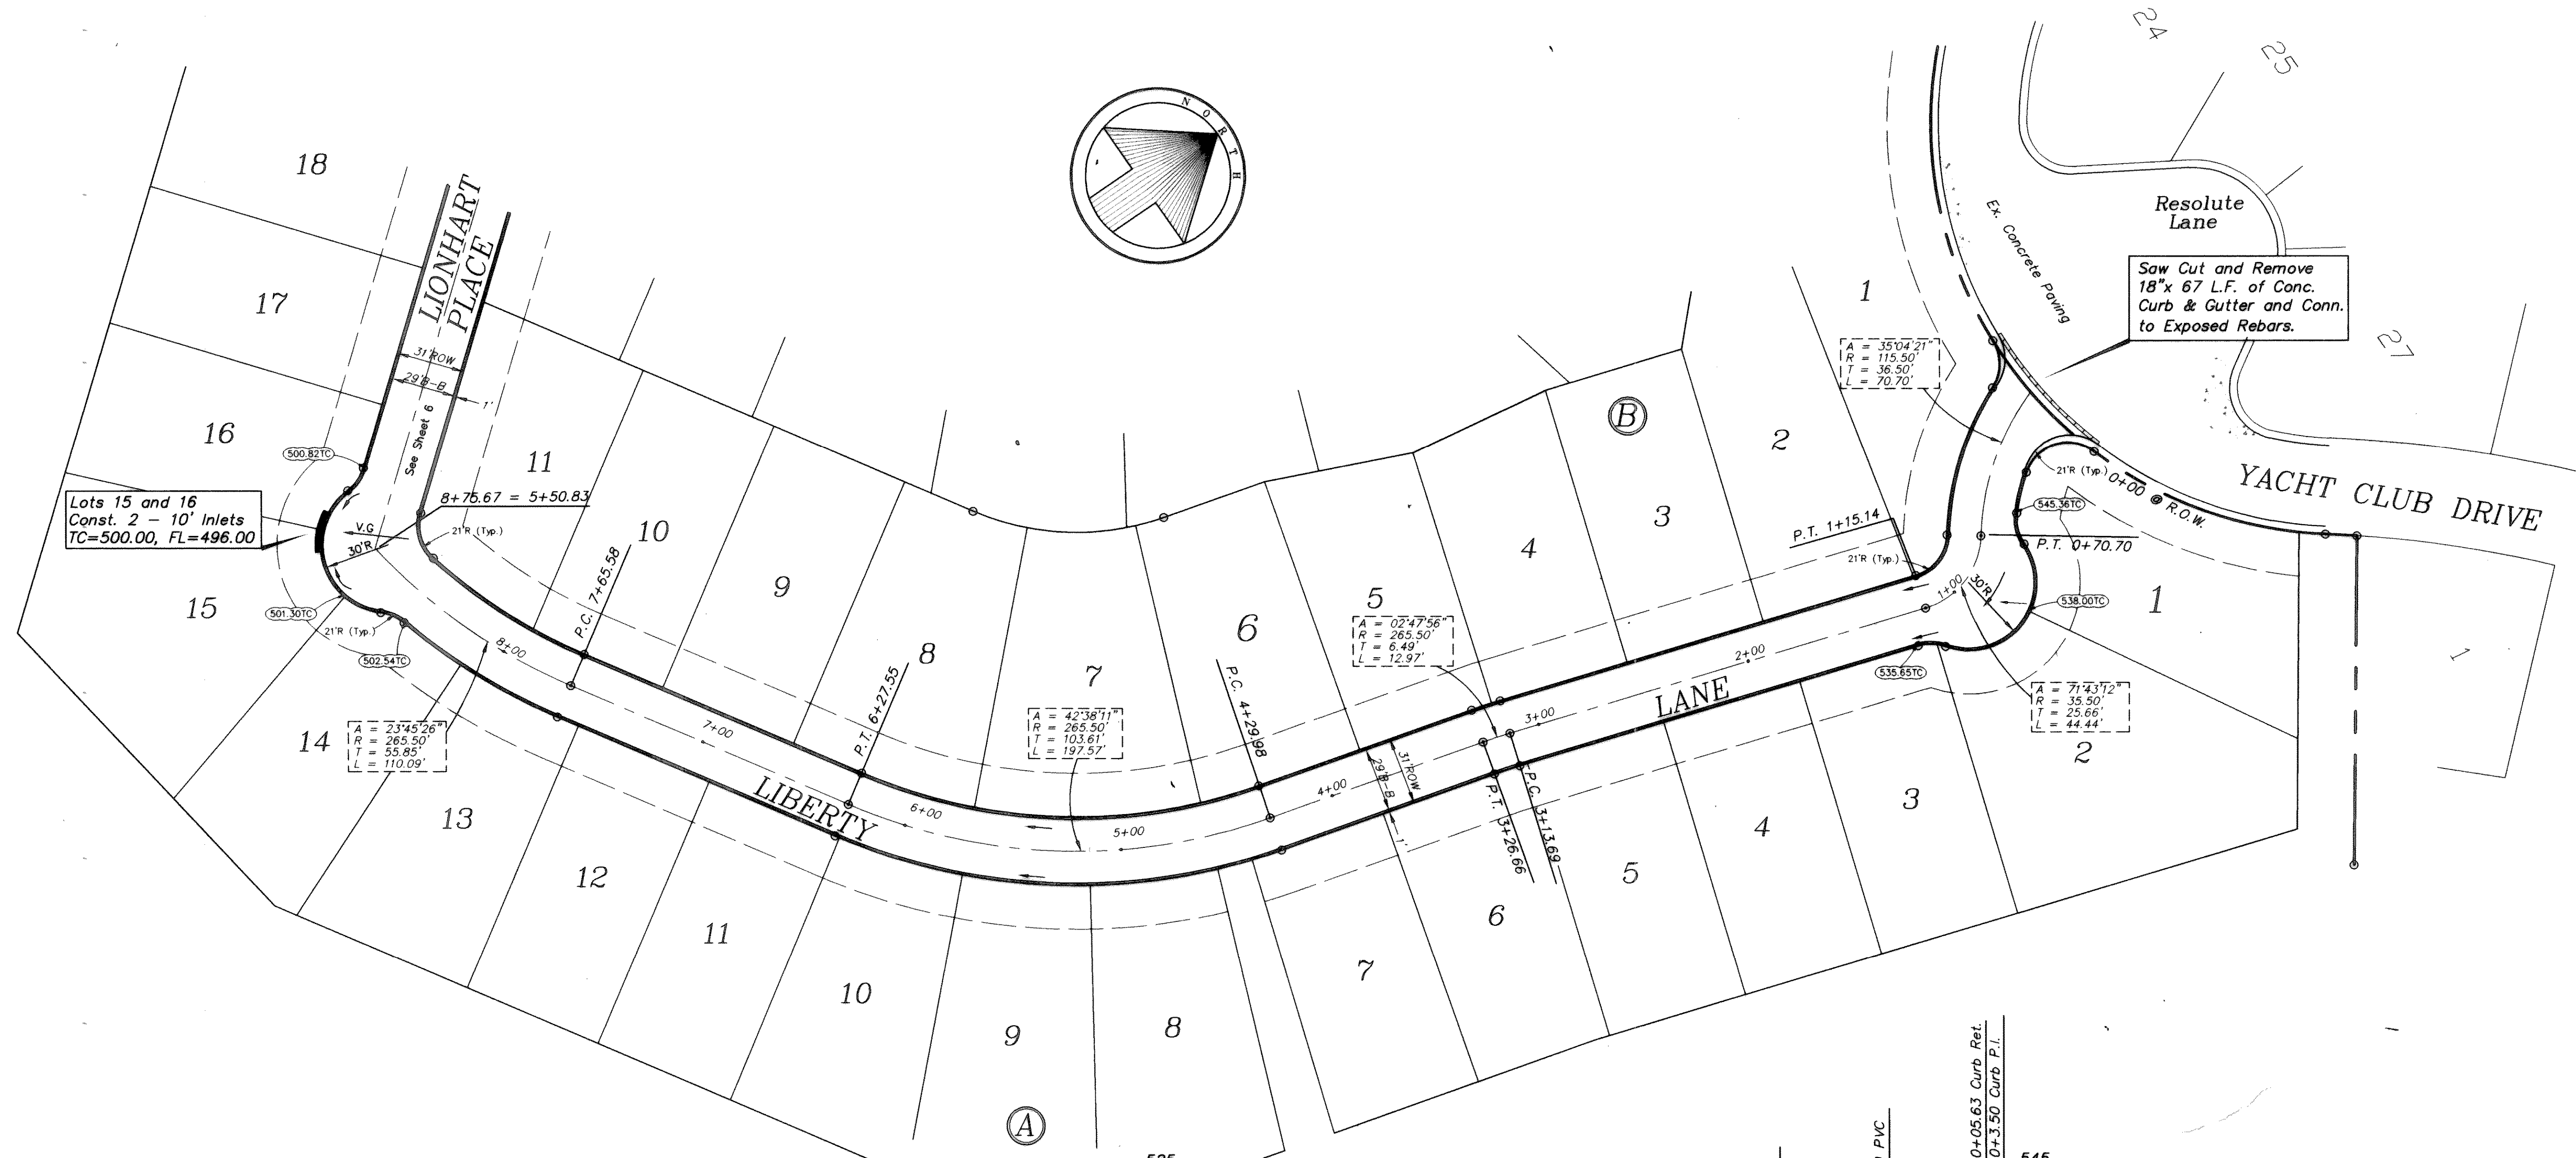

Saw Cut and Remove
18"x 67 L.F. of Conc.
Curb & Gutter and Conn.
to Exposed Rebars.

Lots 15 and 16
Const. 2 - 10' Inlets
TC=500.00, FL=496.00

YACHT CLUB DRIVE

AS BUILT PLANS 11/15/95

The alignment and grade were set on the ground for construction per the plans. The engineer did not verify alignment or grades after construction. We are not aware of any changes or revisions to these plans during construction except as noted.

Liberty Lane

PAVING PLAN


CHANDLERS LANDING PHASE 15

City Of Rockwall, Rockwall County, Texas

TIPTON ENGINEERING, INC.

6330 Belt Line Rd. ~ Suite C ~ Garland, Texas 75043

DESIGN	DRAWN	DATE	SCALE	NOTES	FILE	NO.
T.E. inc.	T.E. inc.	07/94	H:1"=40' V:1"=5'		4005	7

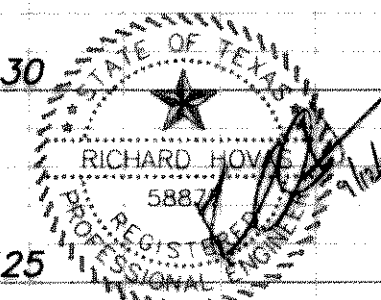

The seal appearing on this document was authorized by Richard J. Tipton, P.E. 5887.

9-7-94 * 4005P3