
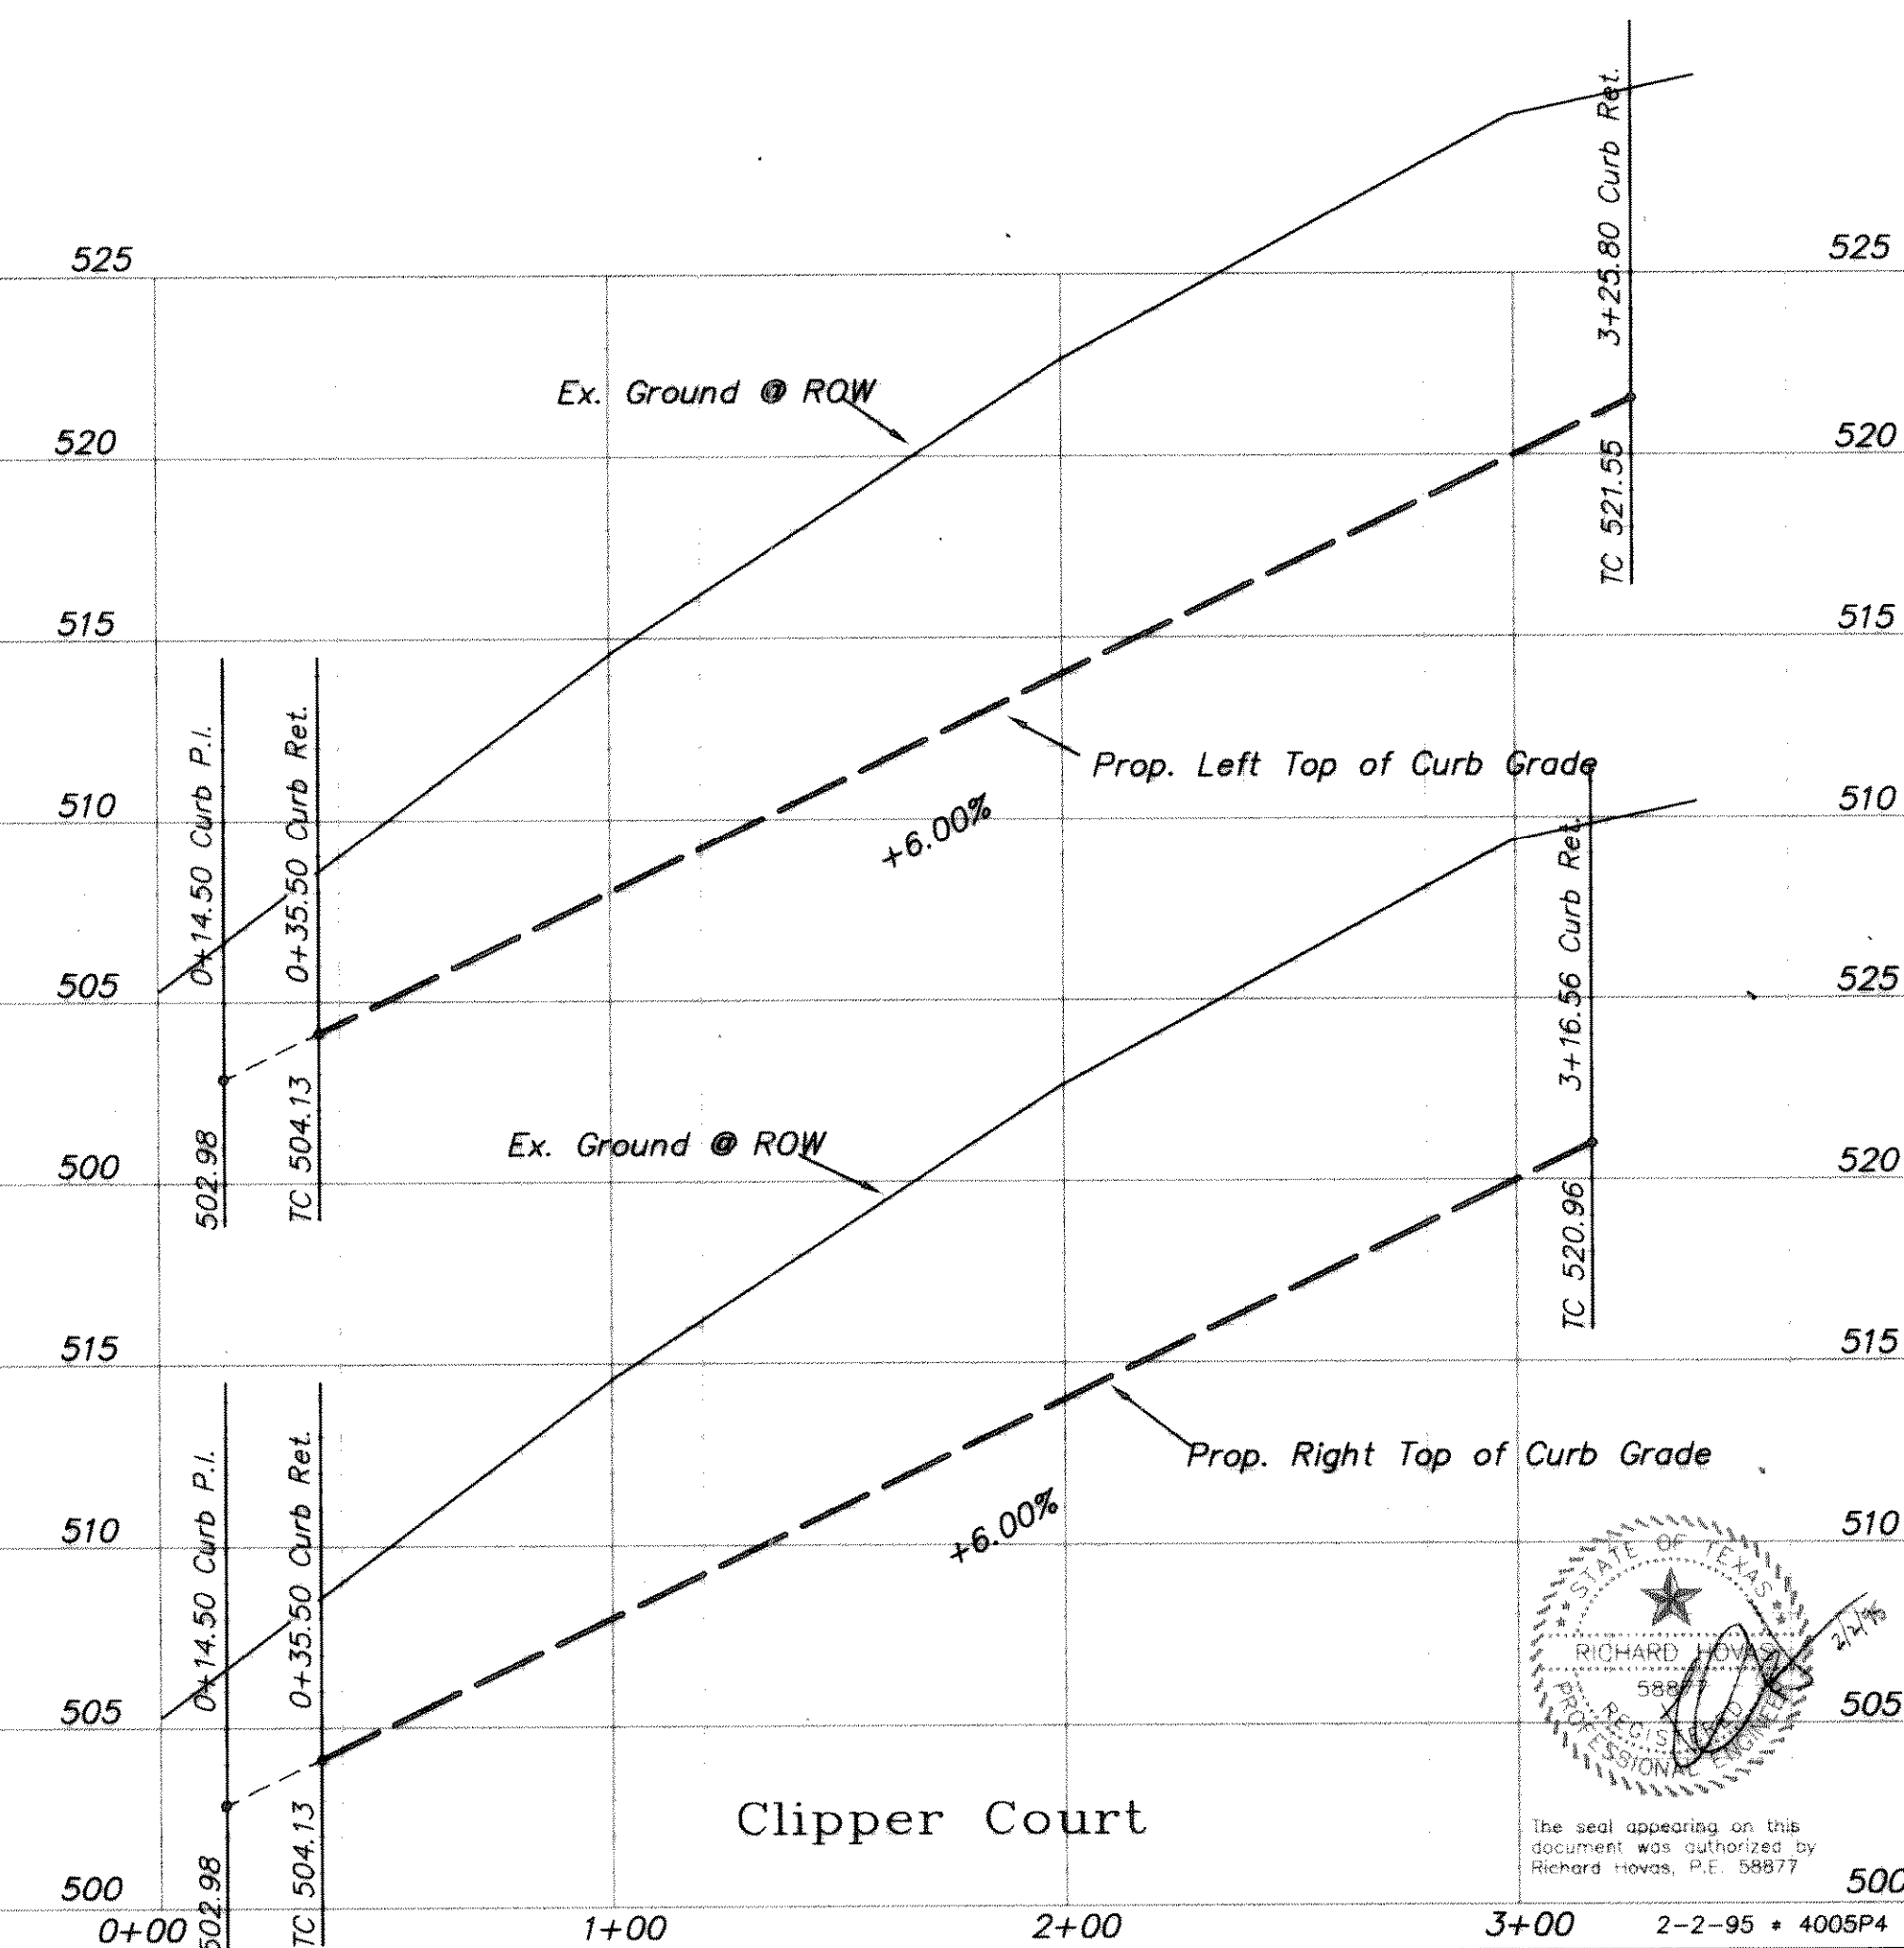


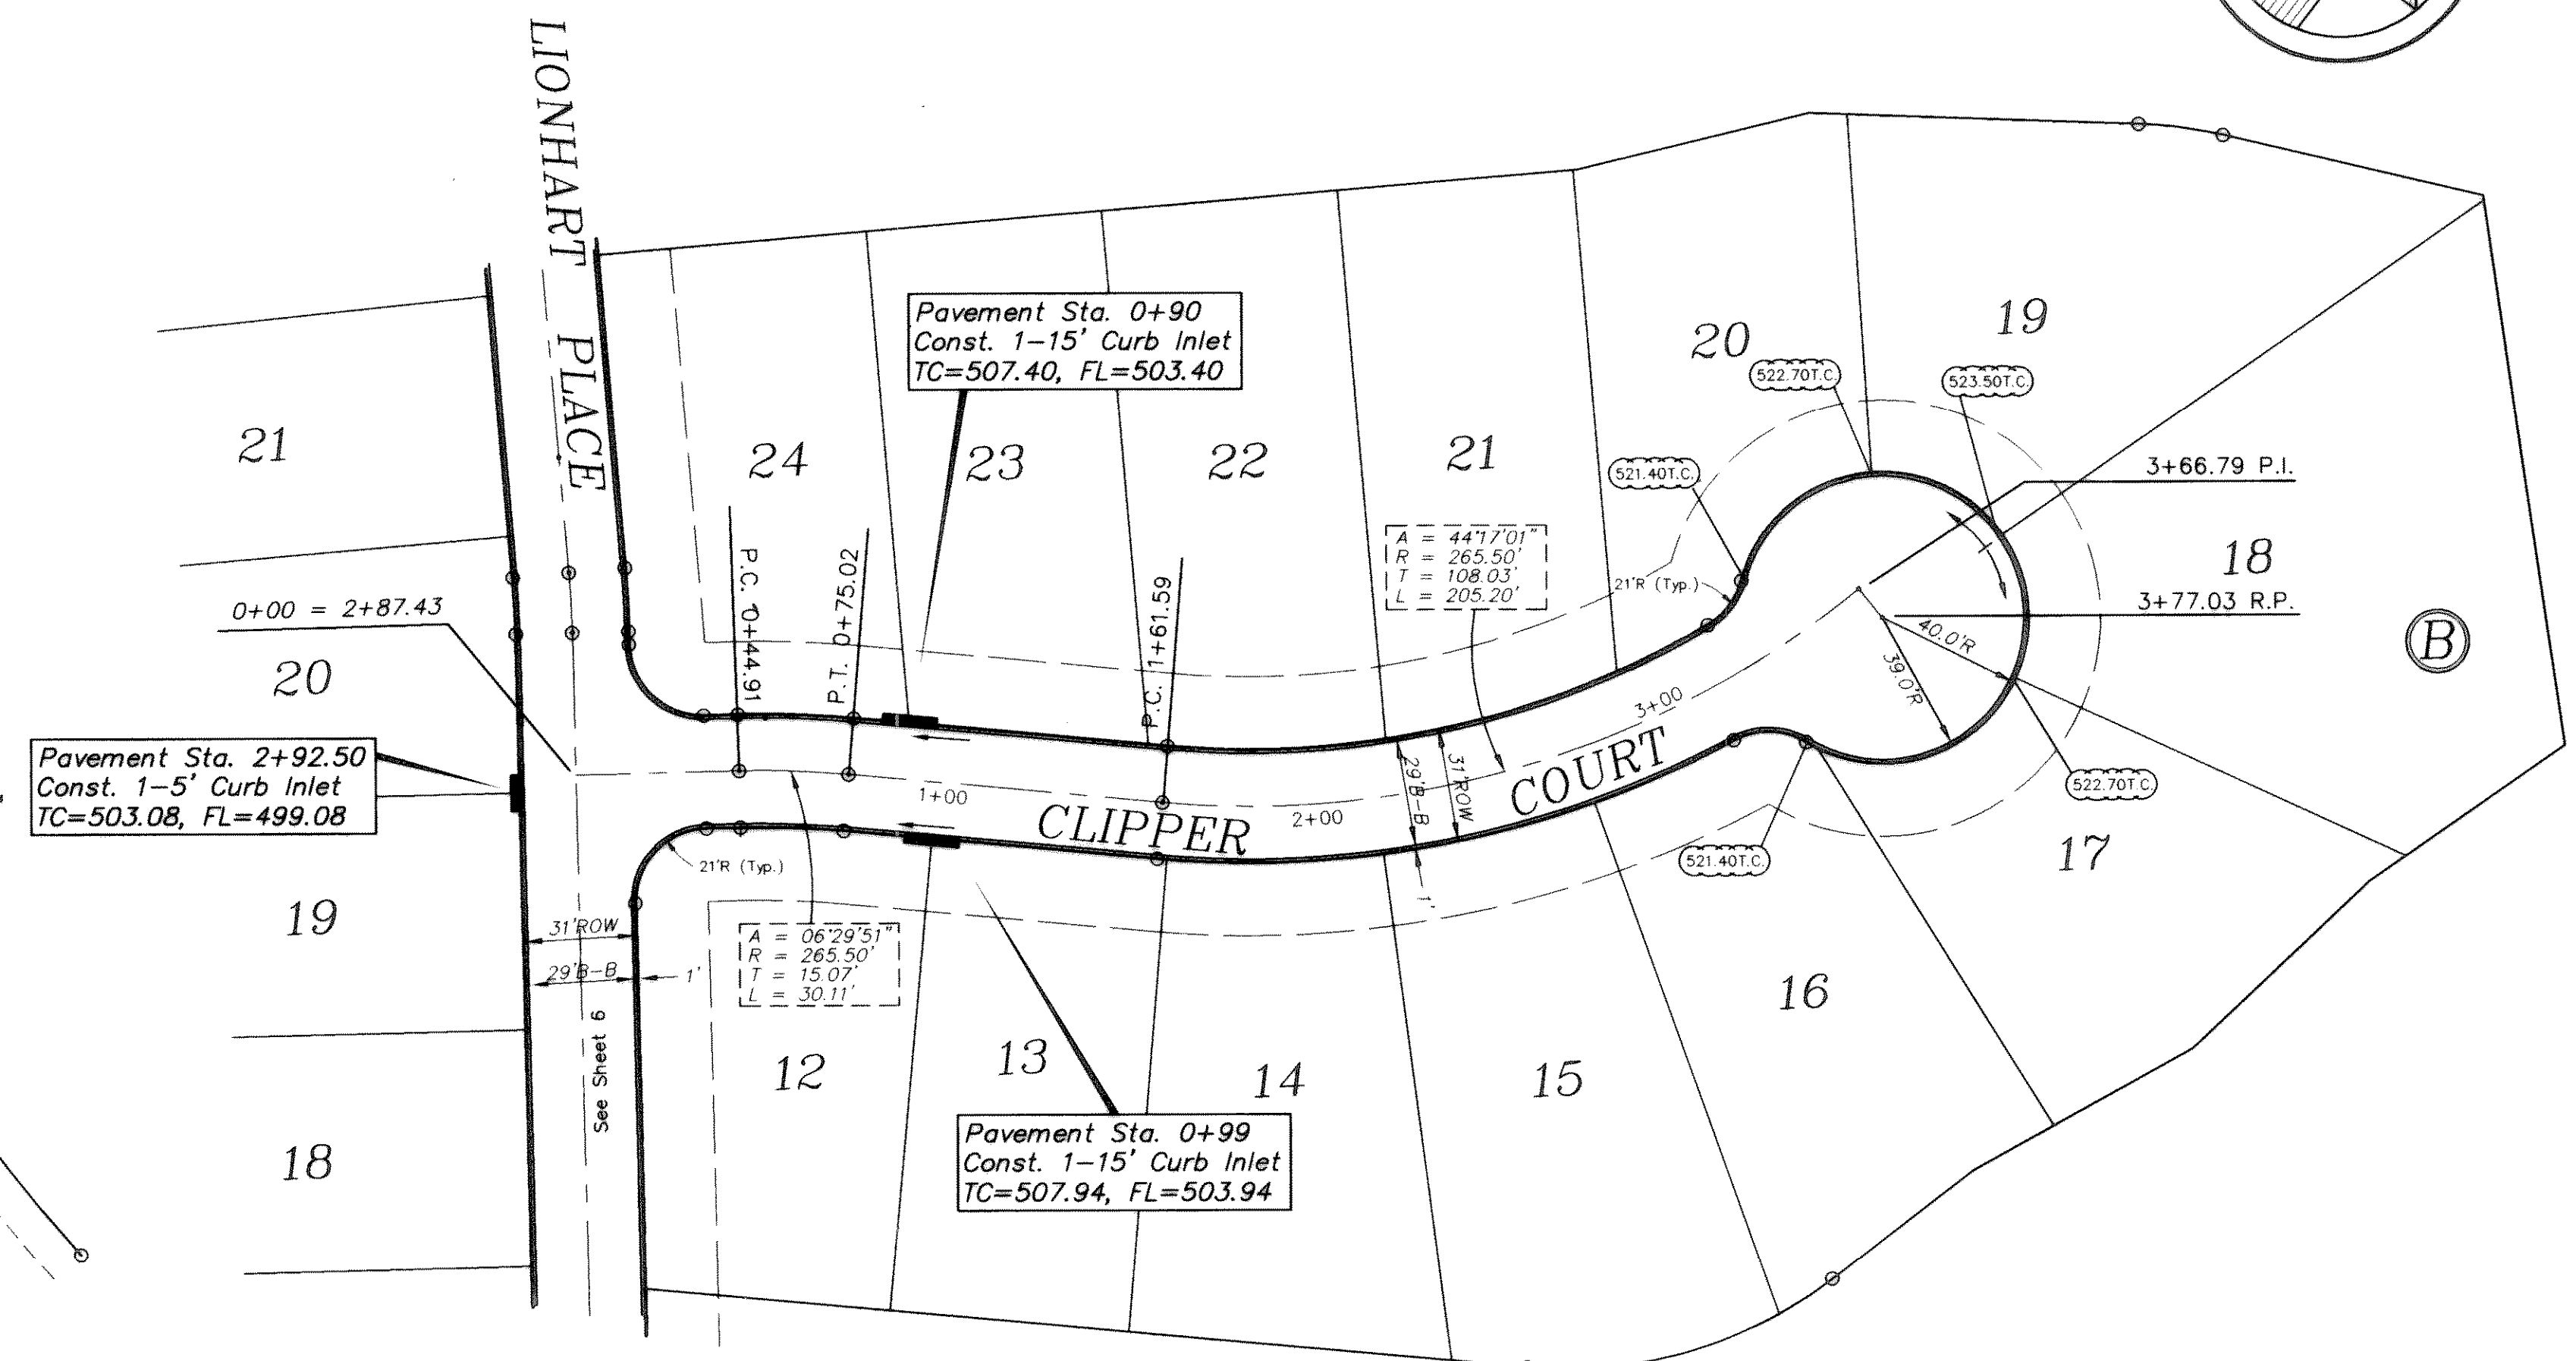

DESIGN	DRAWN	DATE	SCALE	NOTES	FILE	NO.
T.E. inc.	T.E. inc.	08/94	H: 1" = 40' V: 1" = 5'		4005	8