


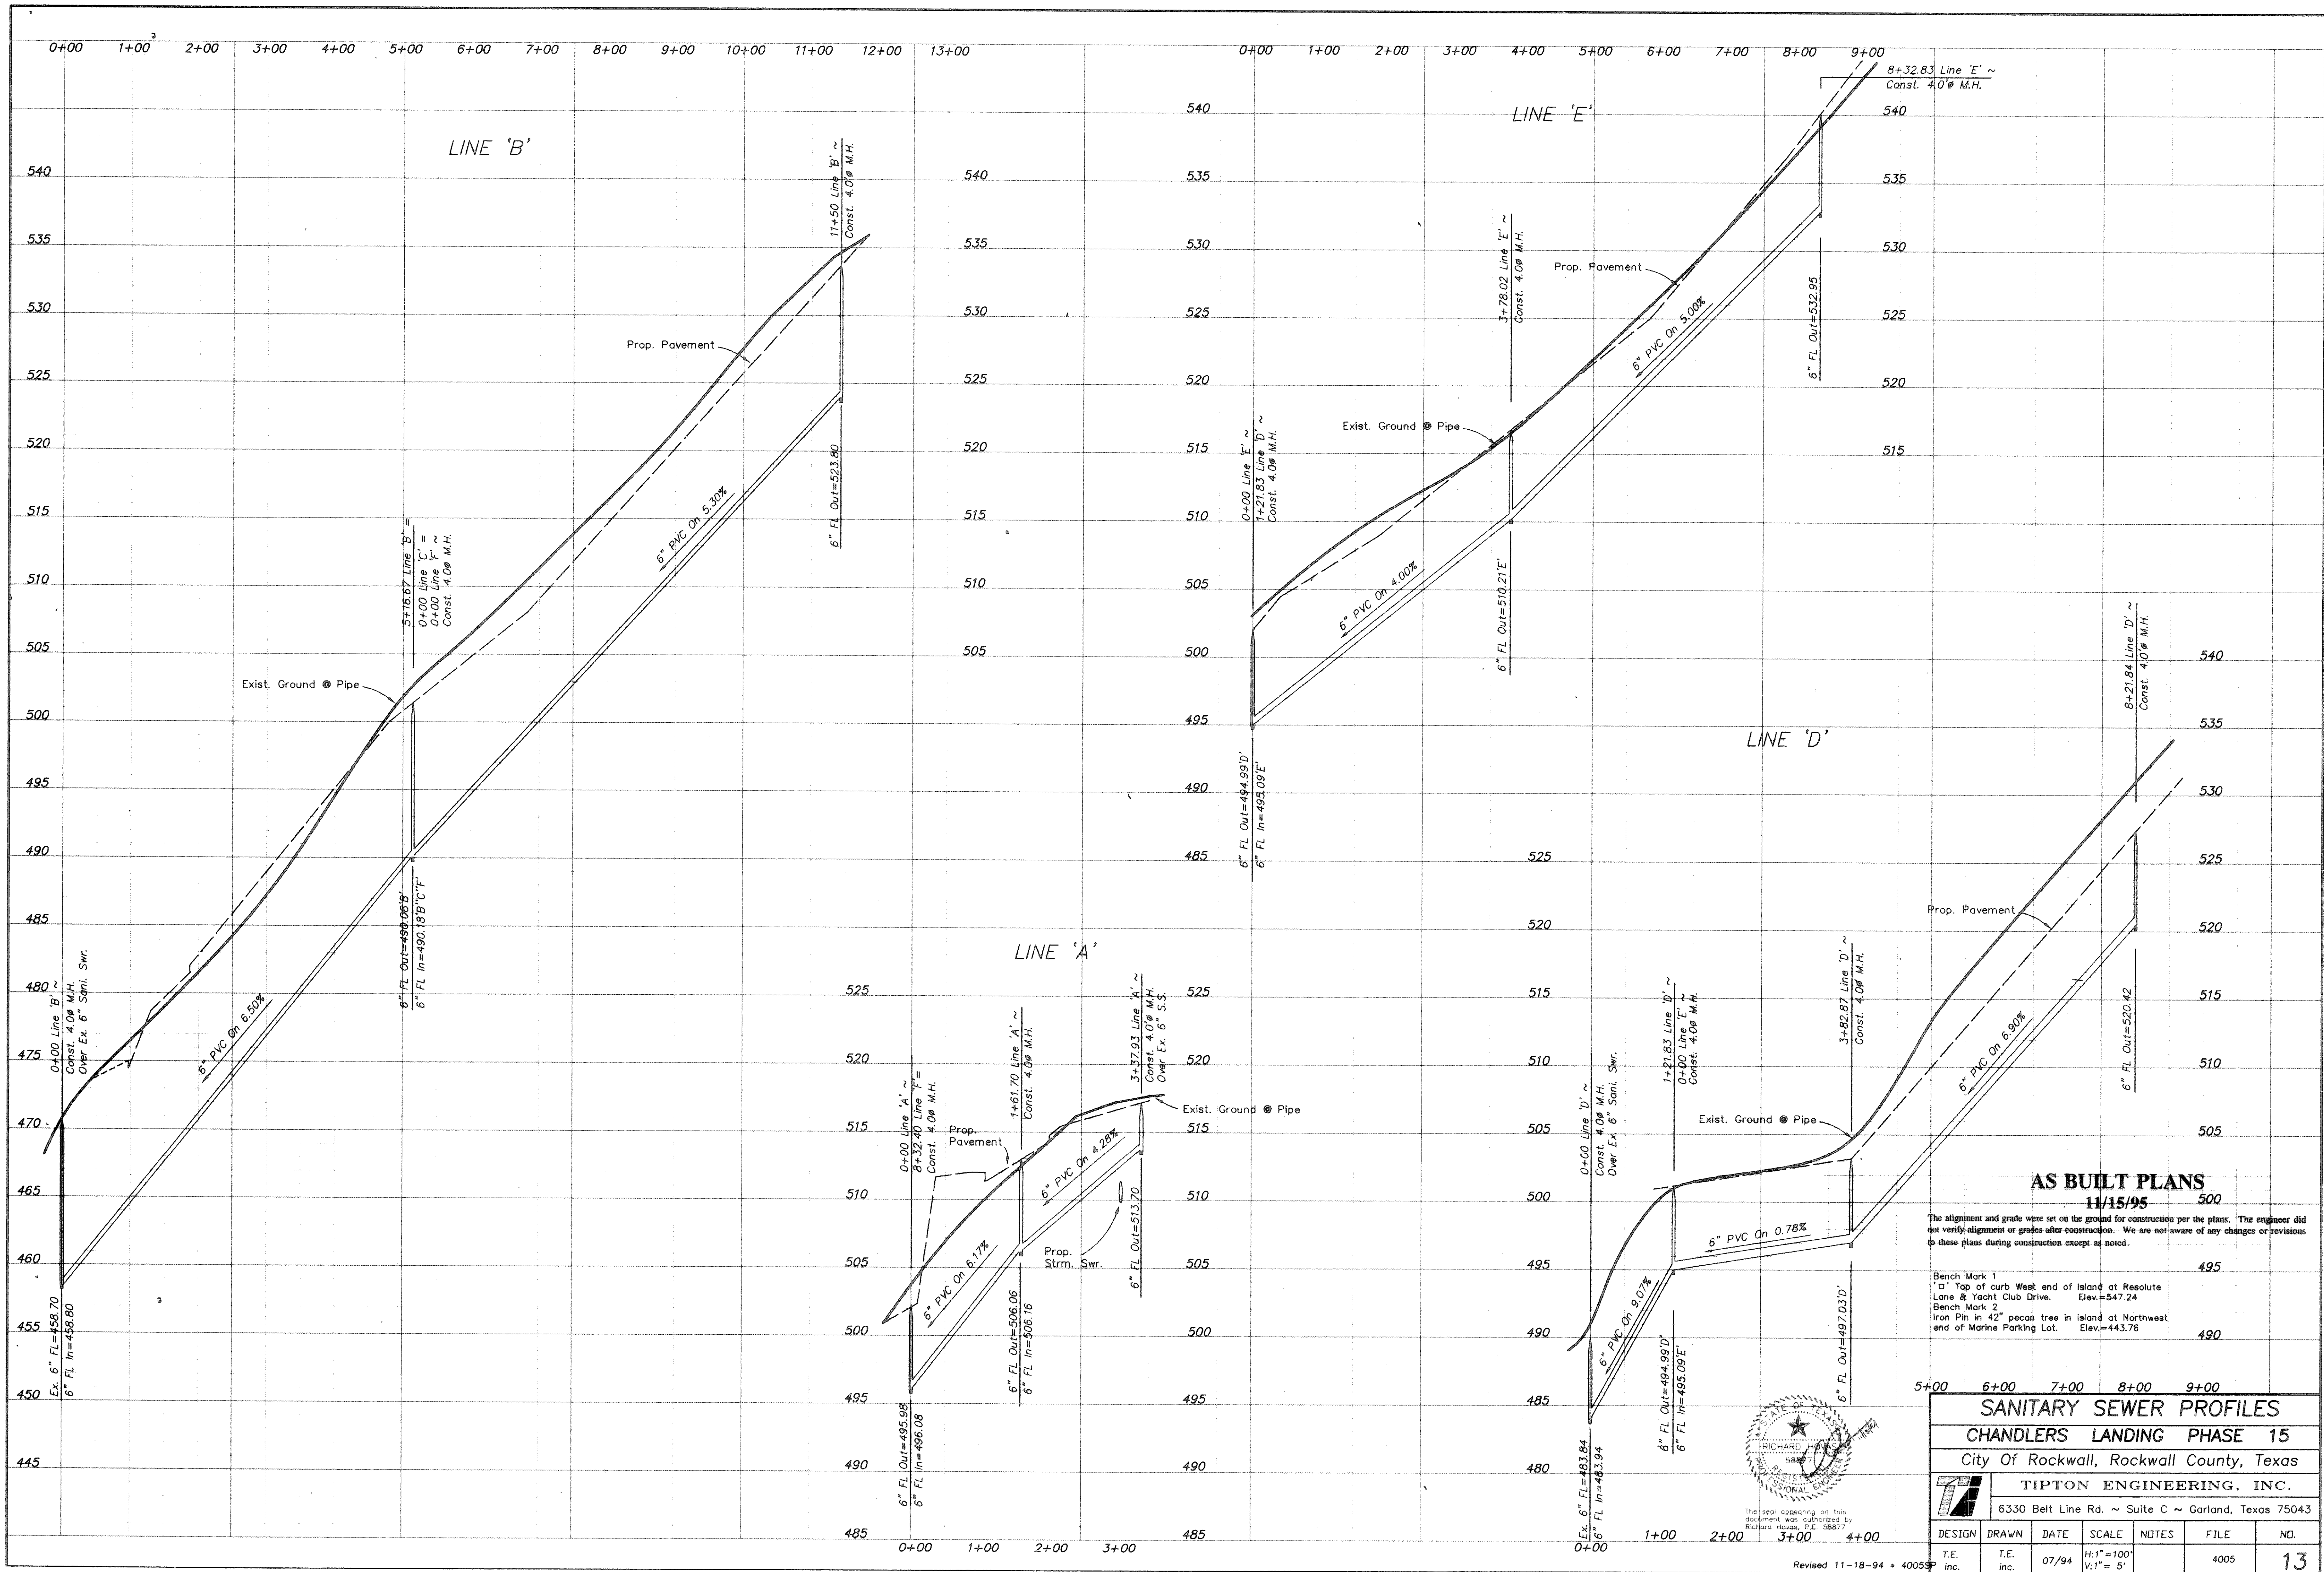

AS BUILT PLANS
11/15/95

The alignment and grade were set on the ground for construction per the plans. The engineer did not verify alignment or grades after construction. We are not aware of any changes or revisions to these plans during construction except as noted.

Bench Mark 1
Top of curb West end of Island at Resolute Lane & Yacht Club Drive. Elev.=547.24
Bench Mark 2
Iron Pin in 42" pecan tree in island at Northwest end of Marine Parking Lot. Elev.=443.76

SANITARY SEWER PROFILES
CHANDLERS LANDING PHASE 15
City Of Rockwall, Rockwall County, Texas

TIPTON ENGINEERING, INC.
6330 Belt Line Rd. ~ Suite C ~ Garland, Texas 75043

DESIGN	DRAWN	DATE	SCALE	NOTES	FILE	NO.
T.E.	T.E.	07/94	H:1"=100' V:1"= 5'		4005	13

Revised 11-18-94 * 4005SP