

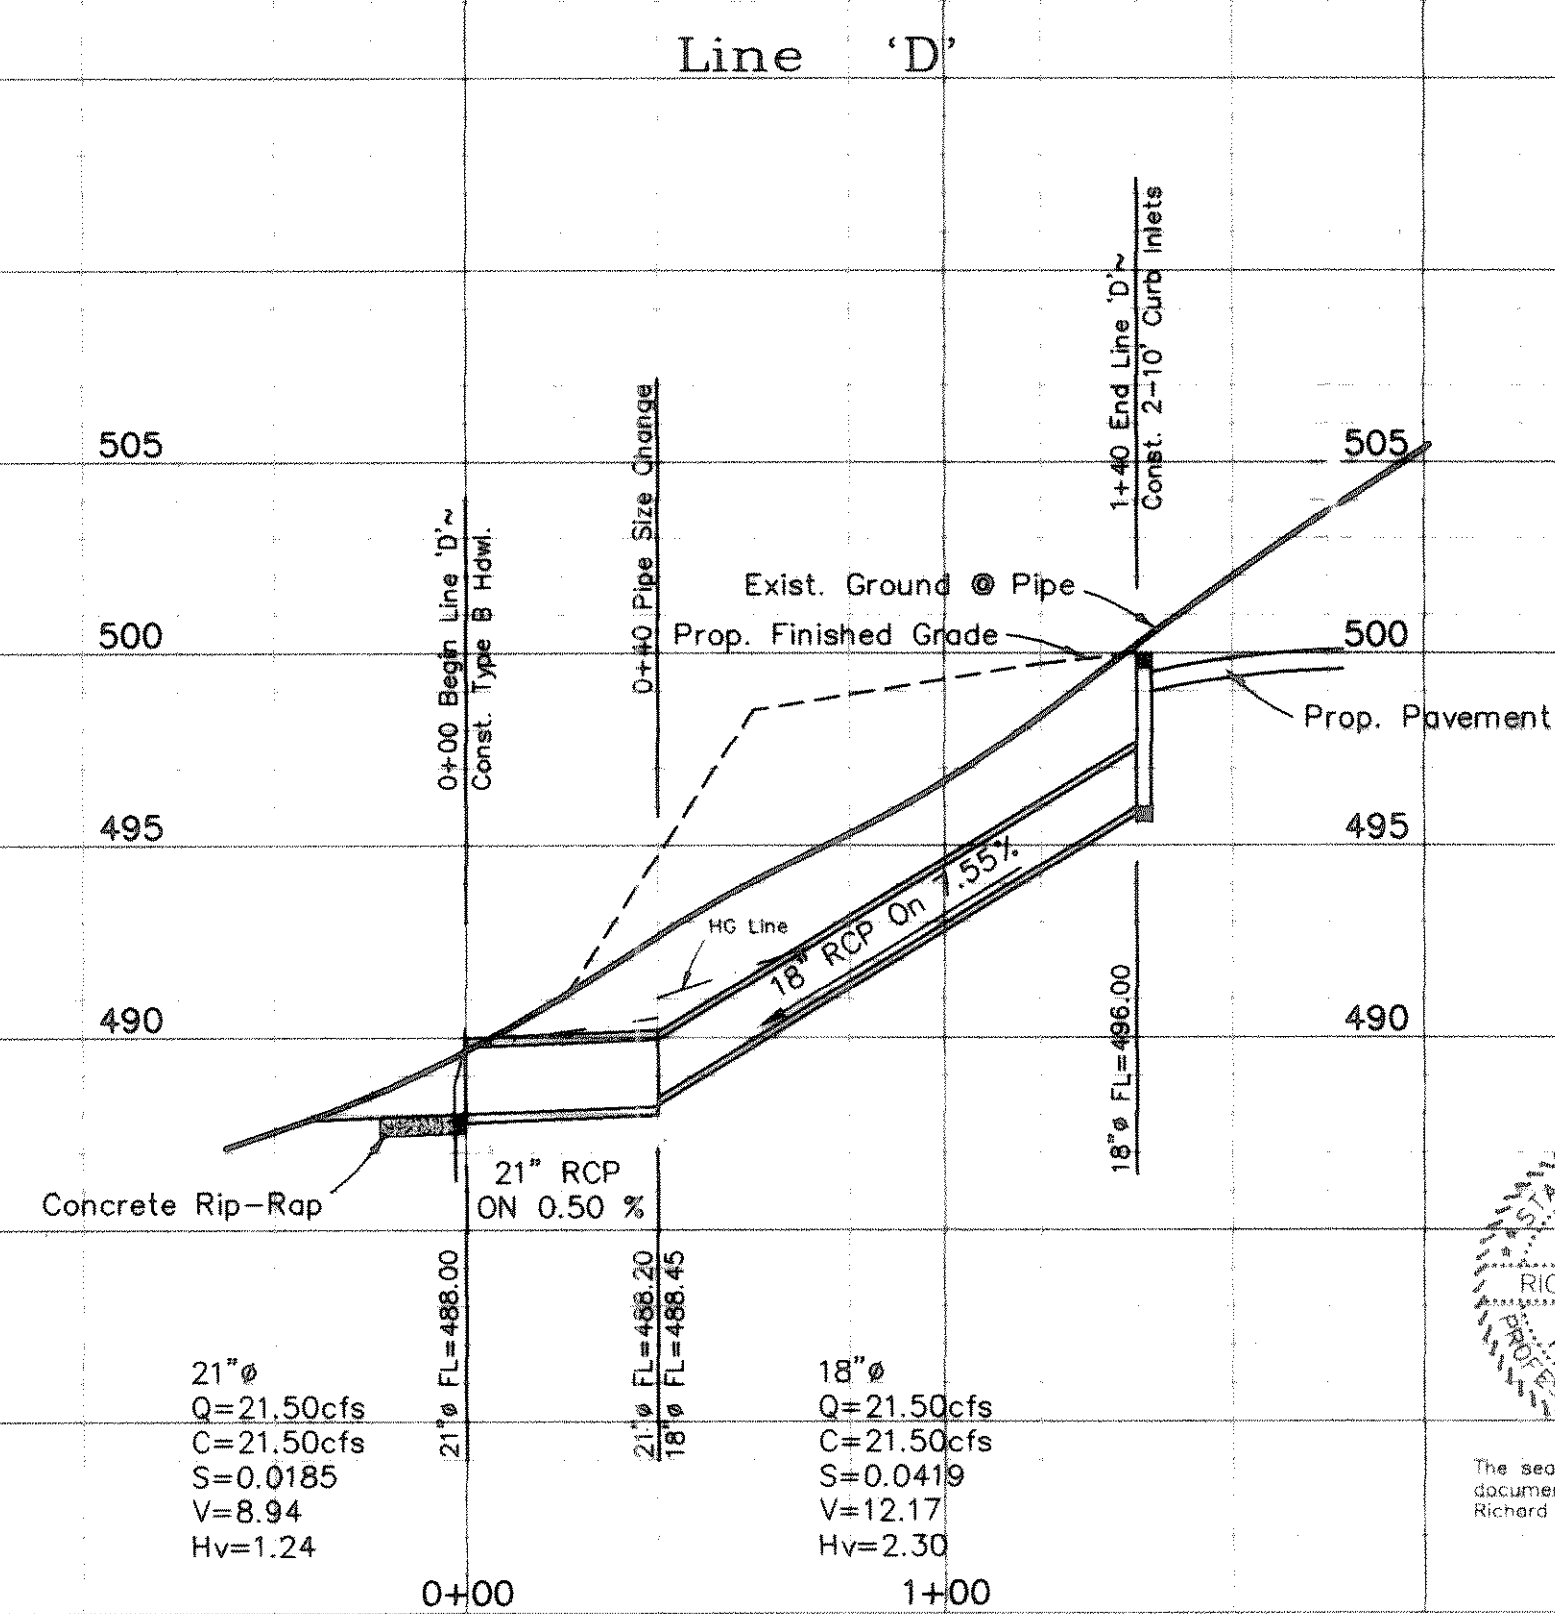
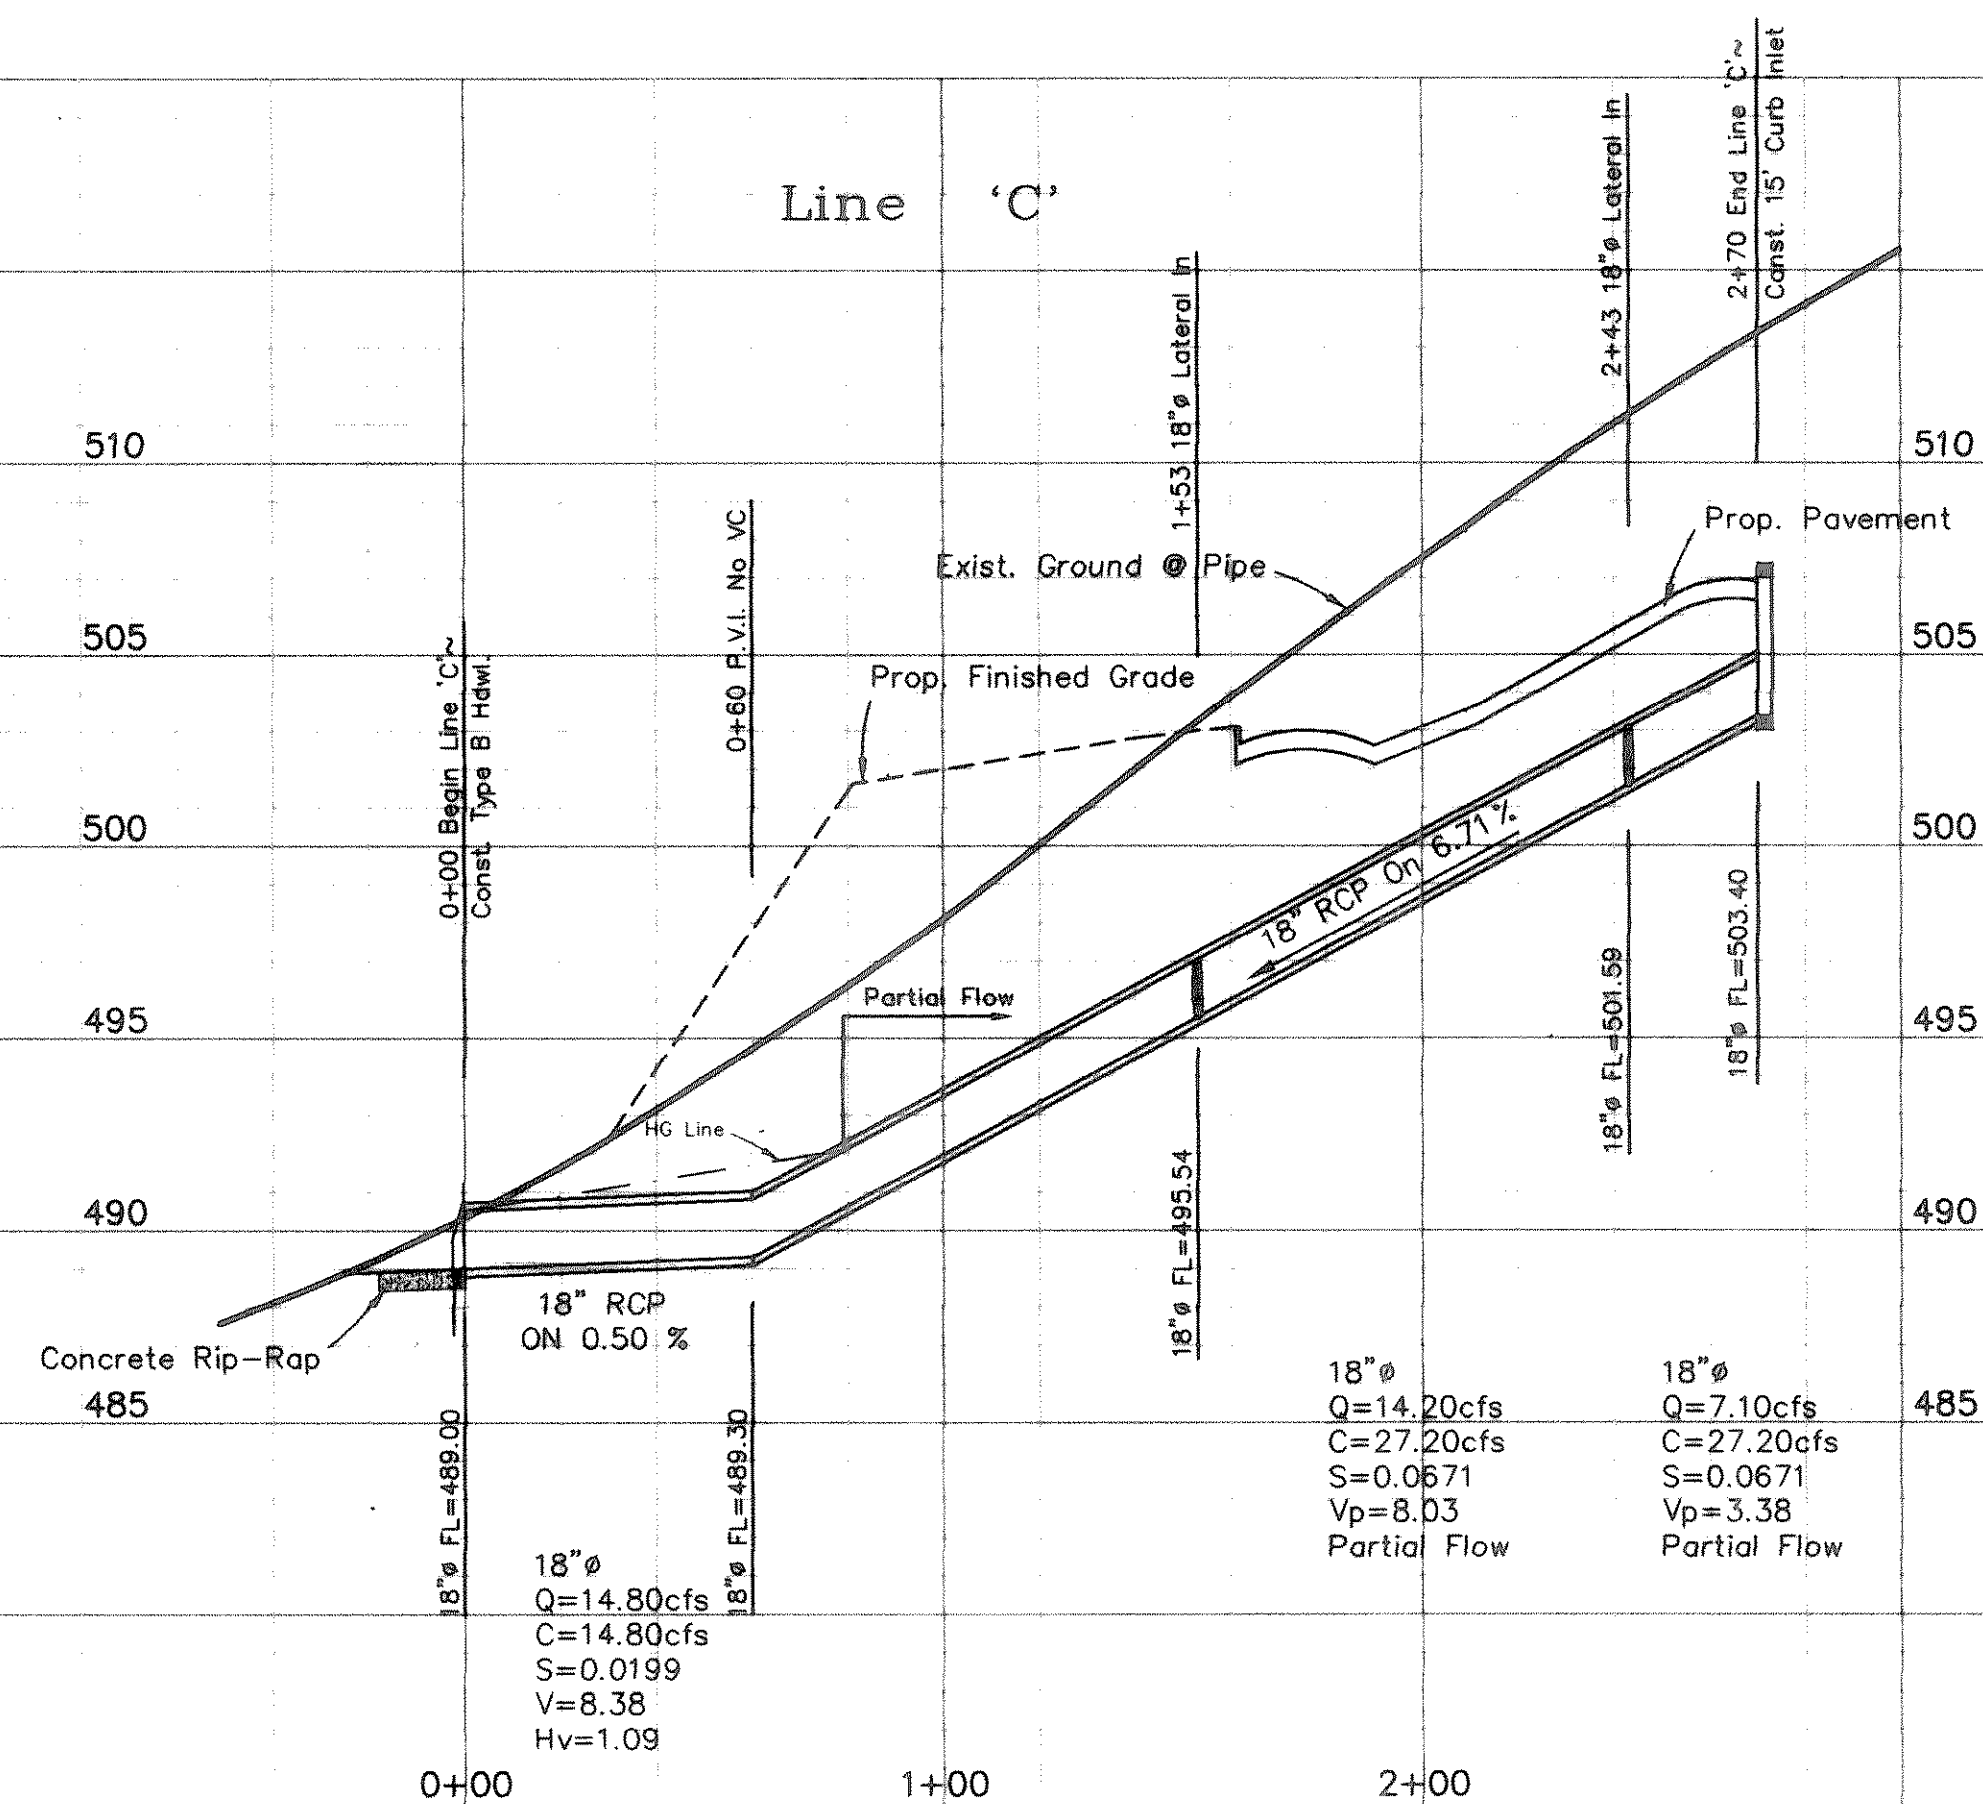
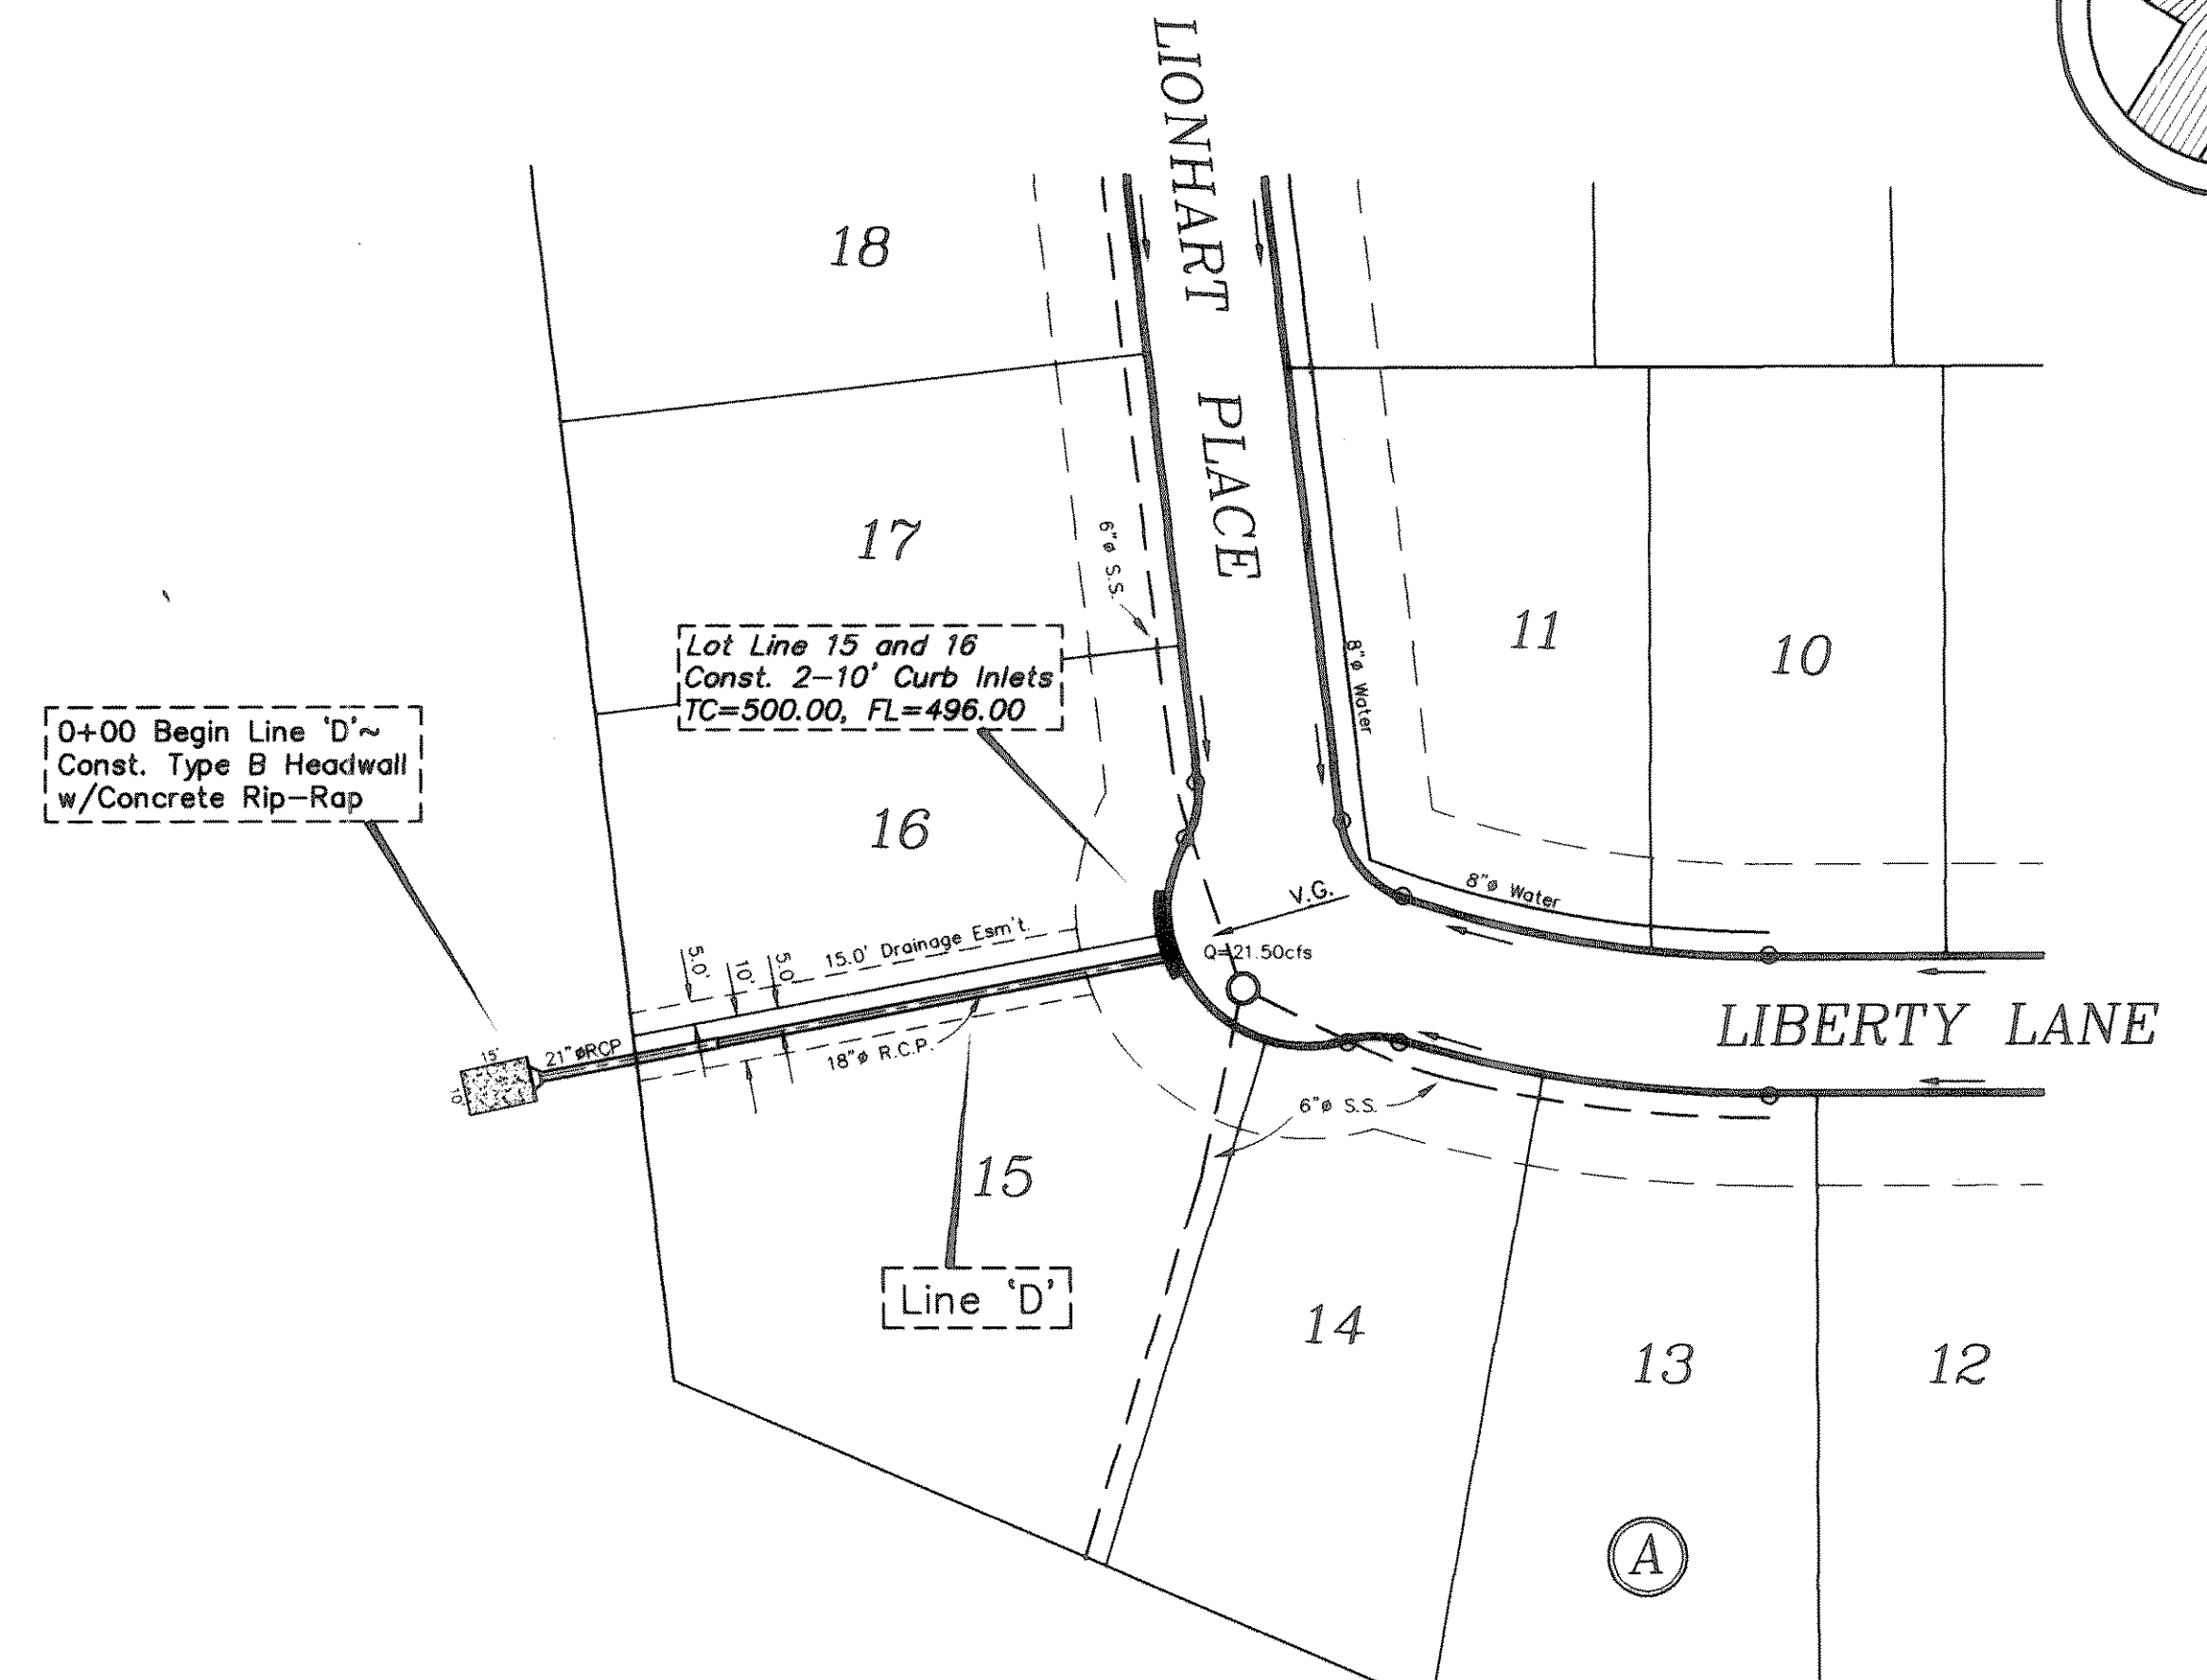
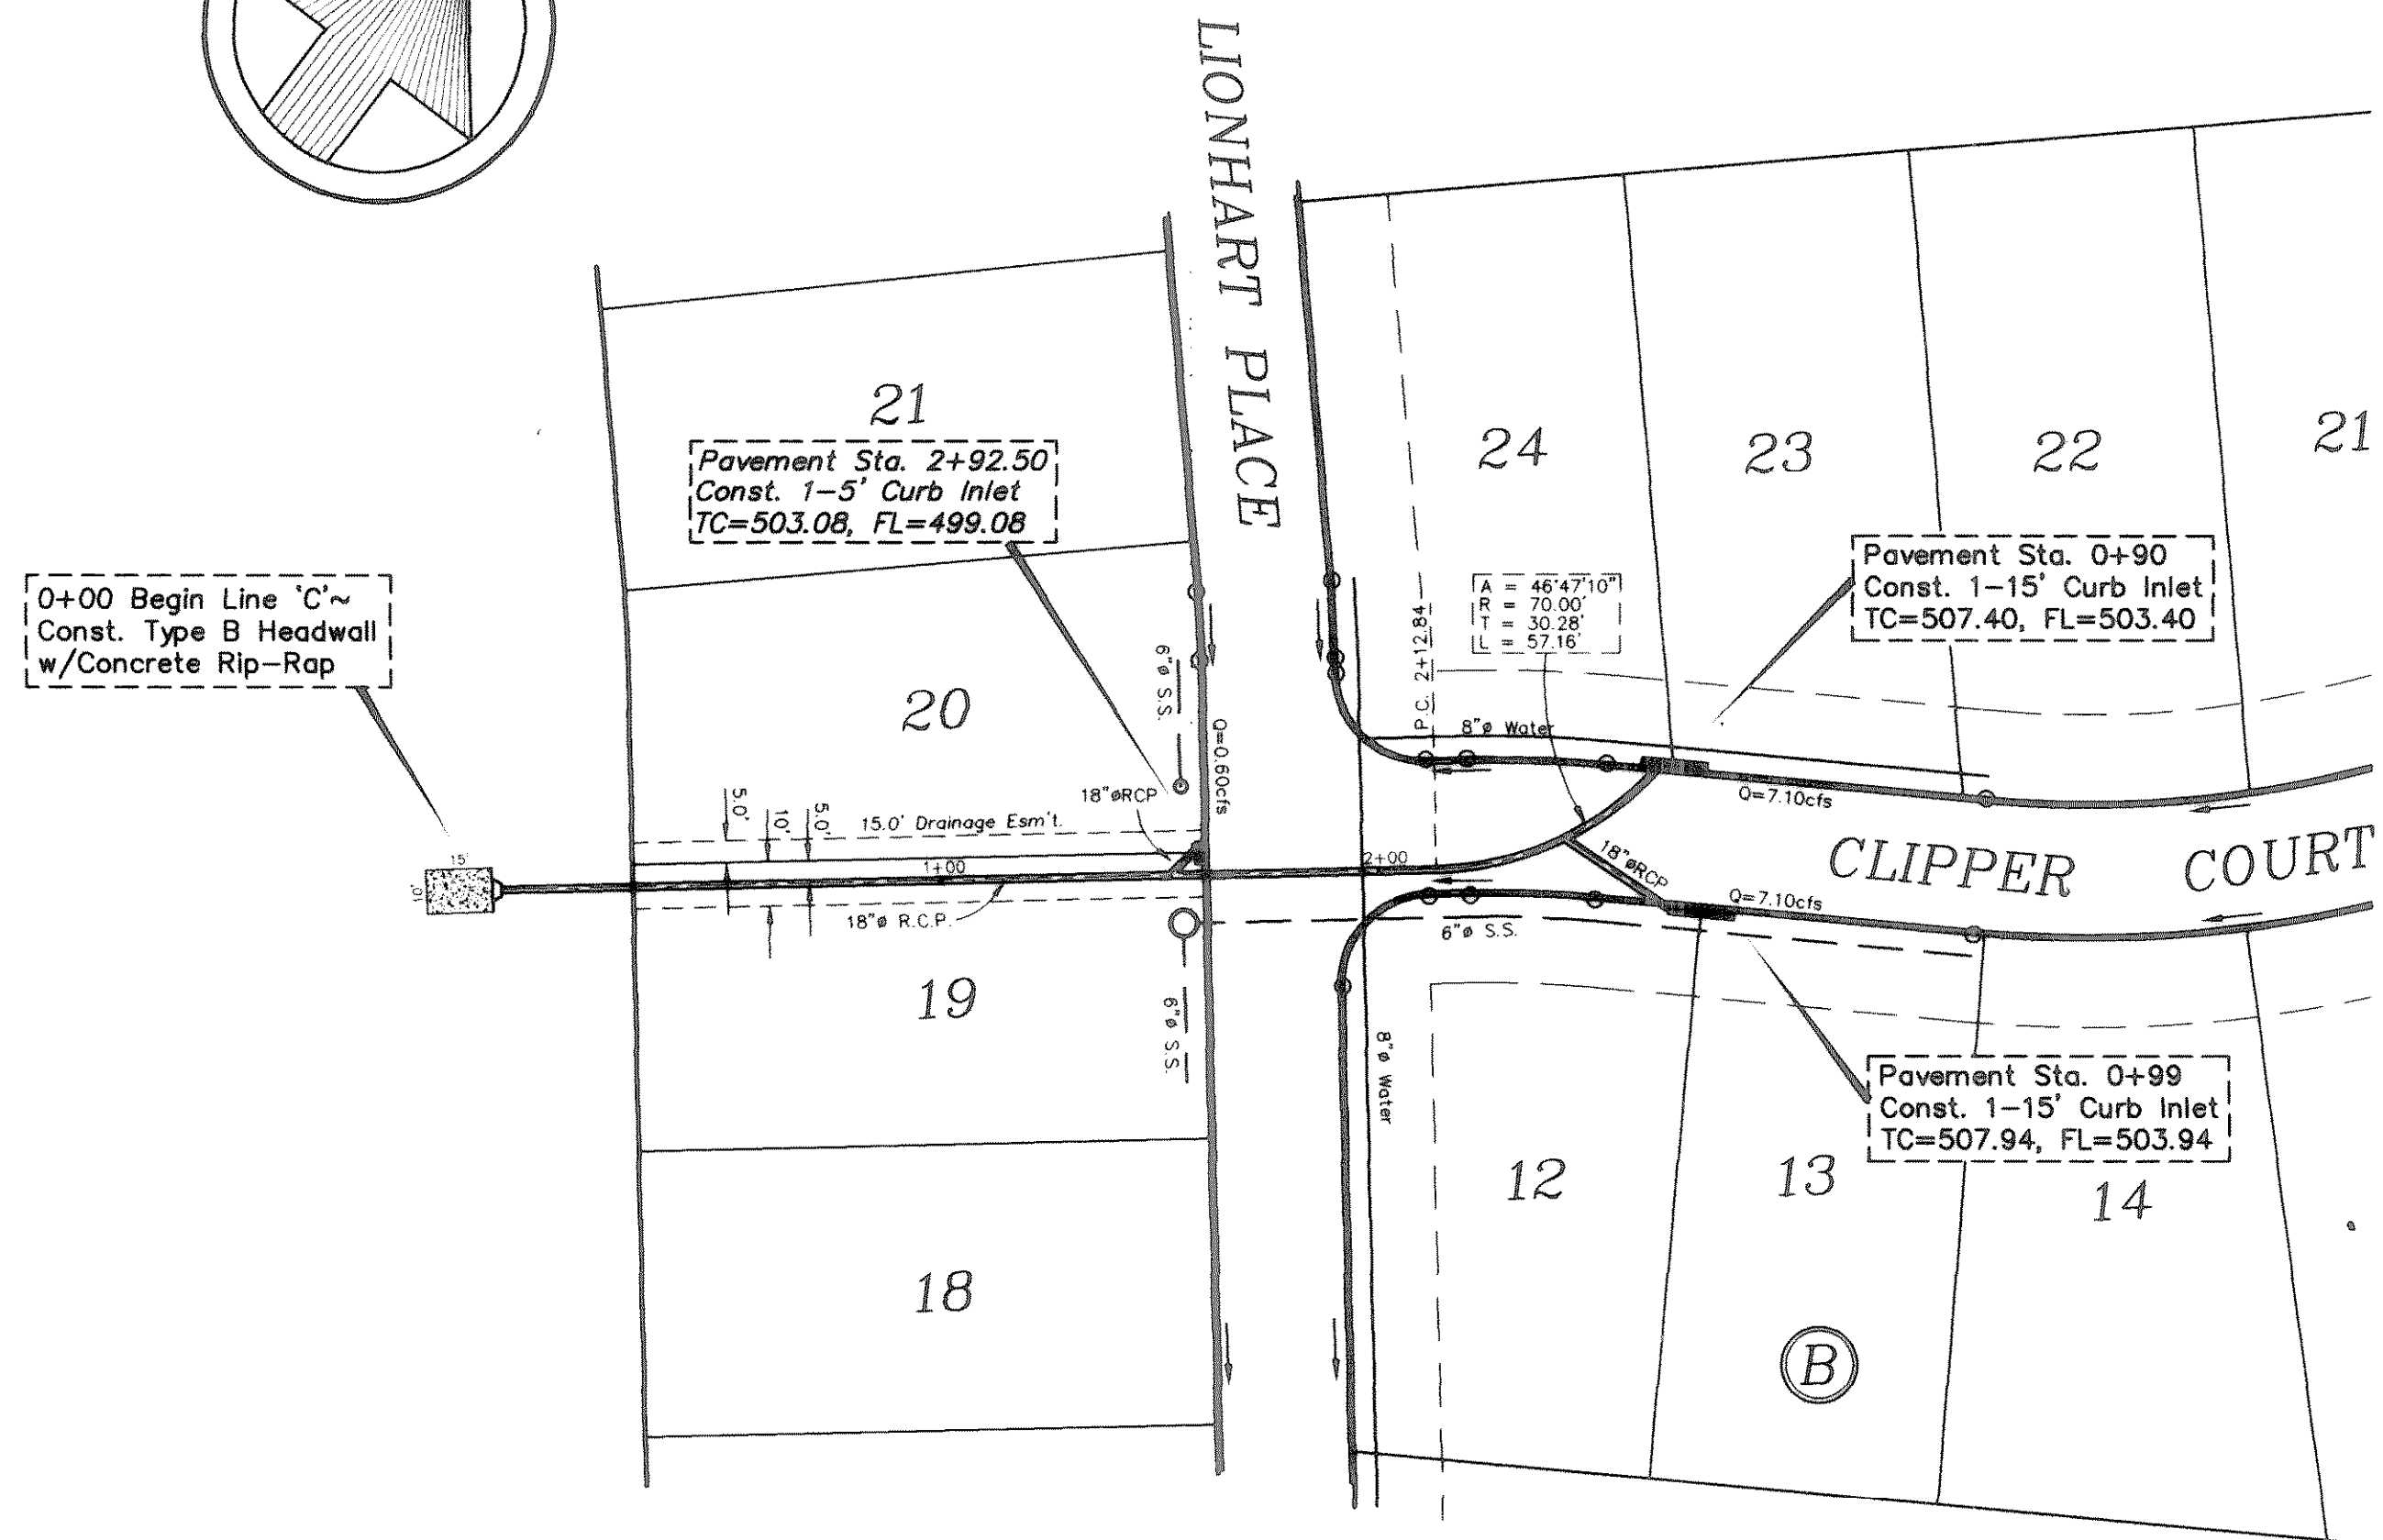
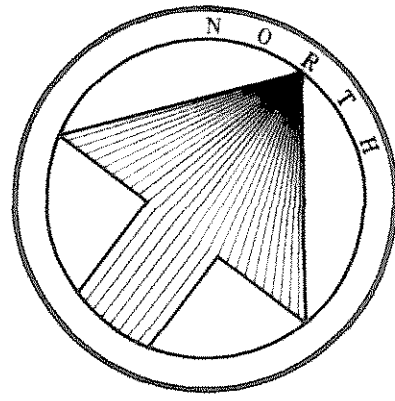


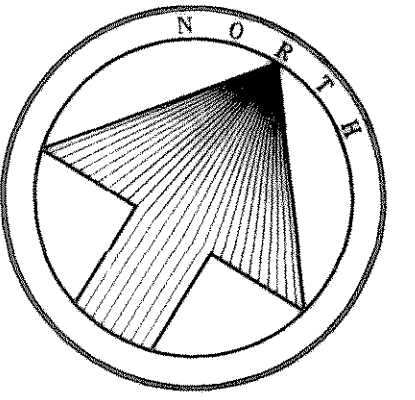

Bench Mark 1  
"a" Top of curb West end of island at Resolute  
Lane & Yacht Club Drive. Elev.=547.24  
Bench Mark 2  
Iron Pin in 42" pecan tree in island at Northwest  
end of Marine Parking Lot. Elev.=443.76

### AS BUILT PLANS 11/15/95

The alignment and grade were set on the ground for construction per the plans. The engineer did not verify alignment of grades after construction. We are not aware of any changes or revisions to these plans during construction except as noted.

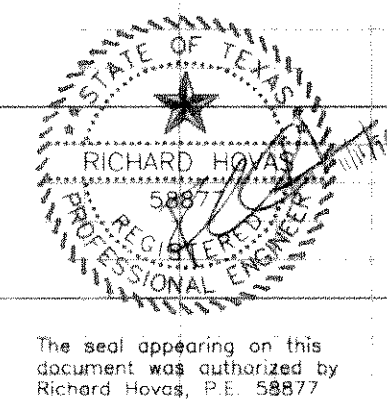

| STORM SEWER PLAN                                    |              |       |                     |       |      |     |
|-----------------------------------------------------|--------------|-------|---------------------|-------|------|-----|
| CHANDLERS LANDING PHASE 15                          |              |       |                     |       |      |     |
| City Of Rockwall, Rockwall County, Texas            |              |       |                     |       |      |     |
| TIPTON ENGINEERING, INC.                            |              |       |                     |       |      |     |
| 6330 Belt Line Rd. ~ Suite C ~ Garland, Texas 75043 |              |       |                     |       |      |     |
| DESIGN                                              | DRAWN        | DATE  | SCALE               | NOTES | FILE | NO. |
| T.E.<br>Inc.                                        | T.E.<br>Inc. | 07/94 | H:1"=40'<br>V:1"=5' |       | 4005 | 11  |