
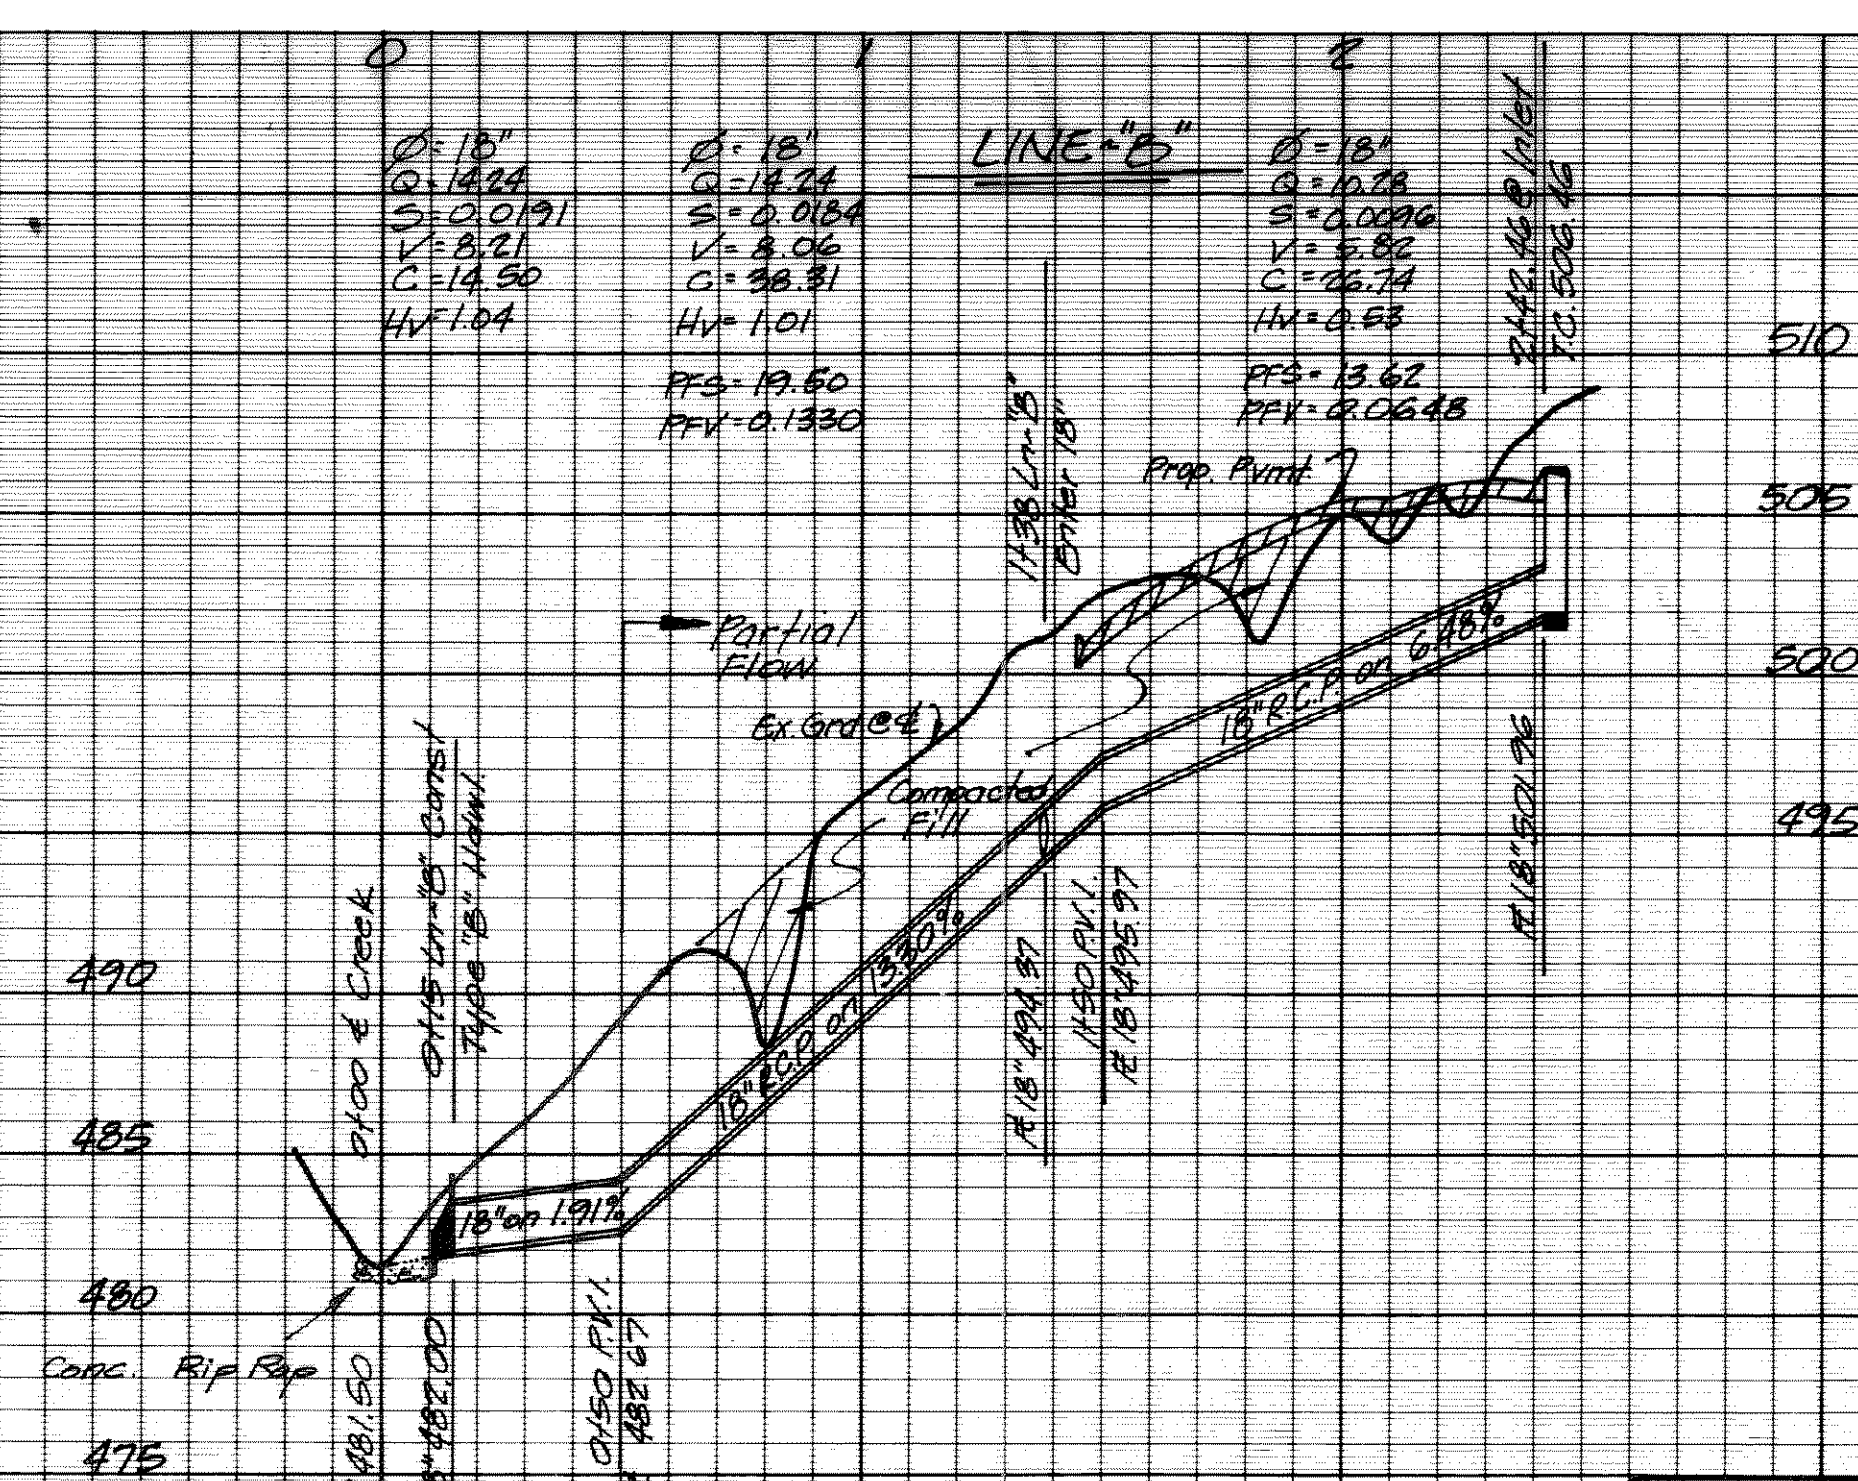


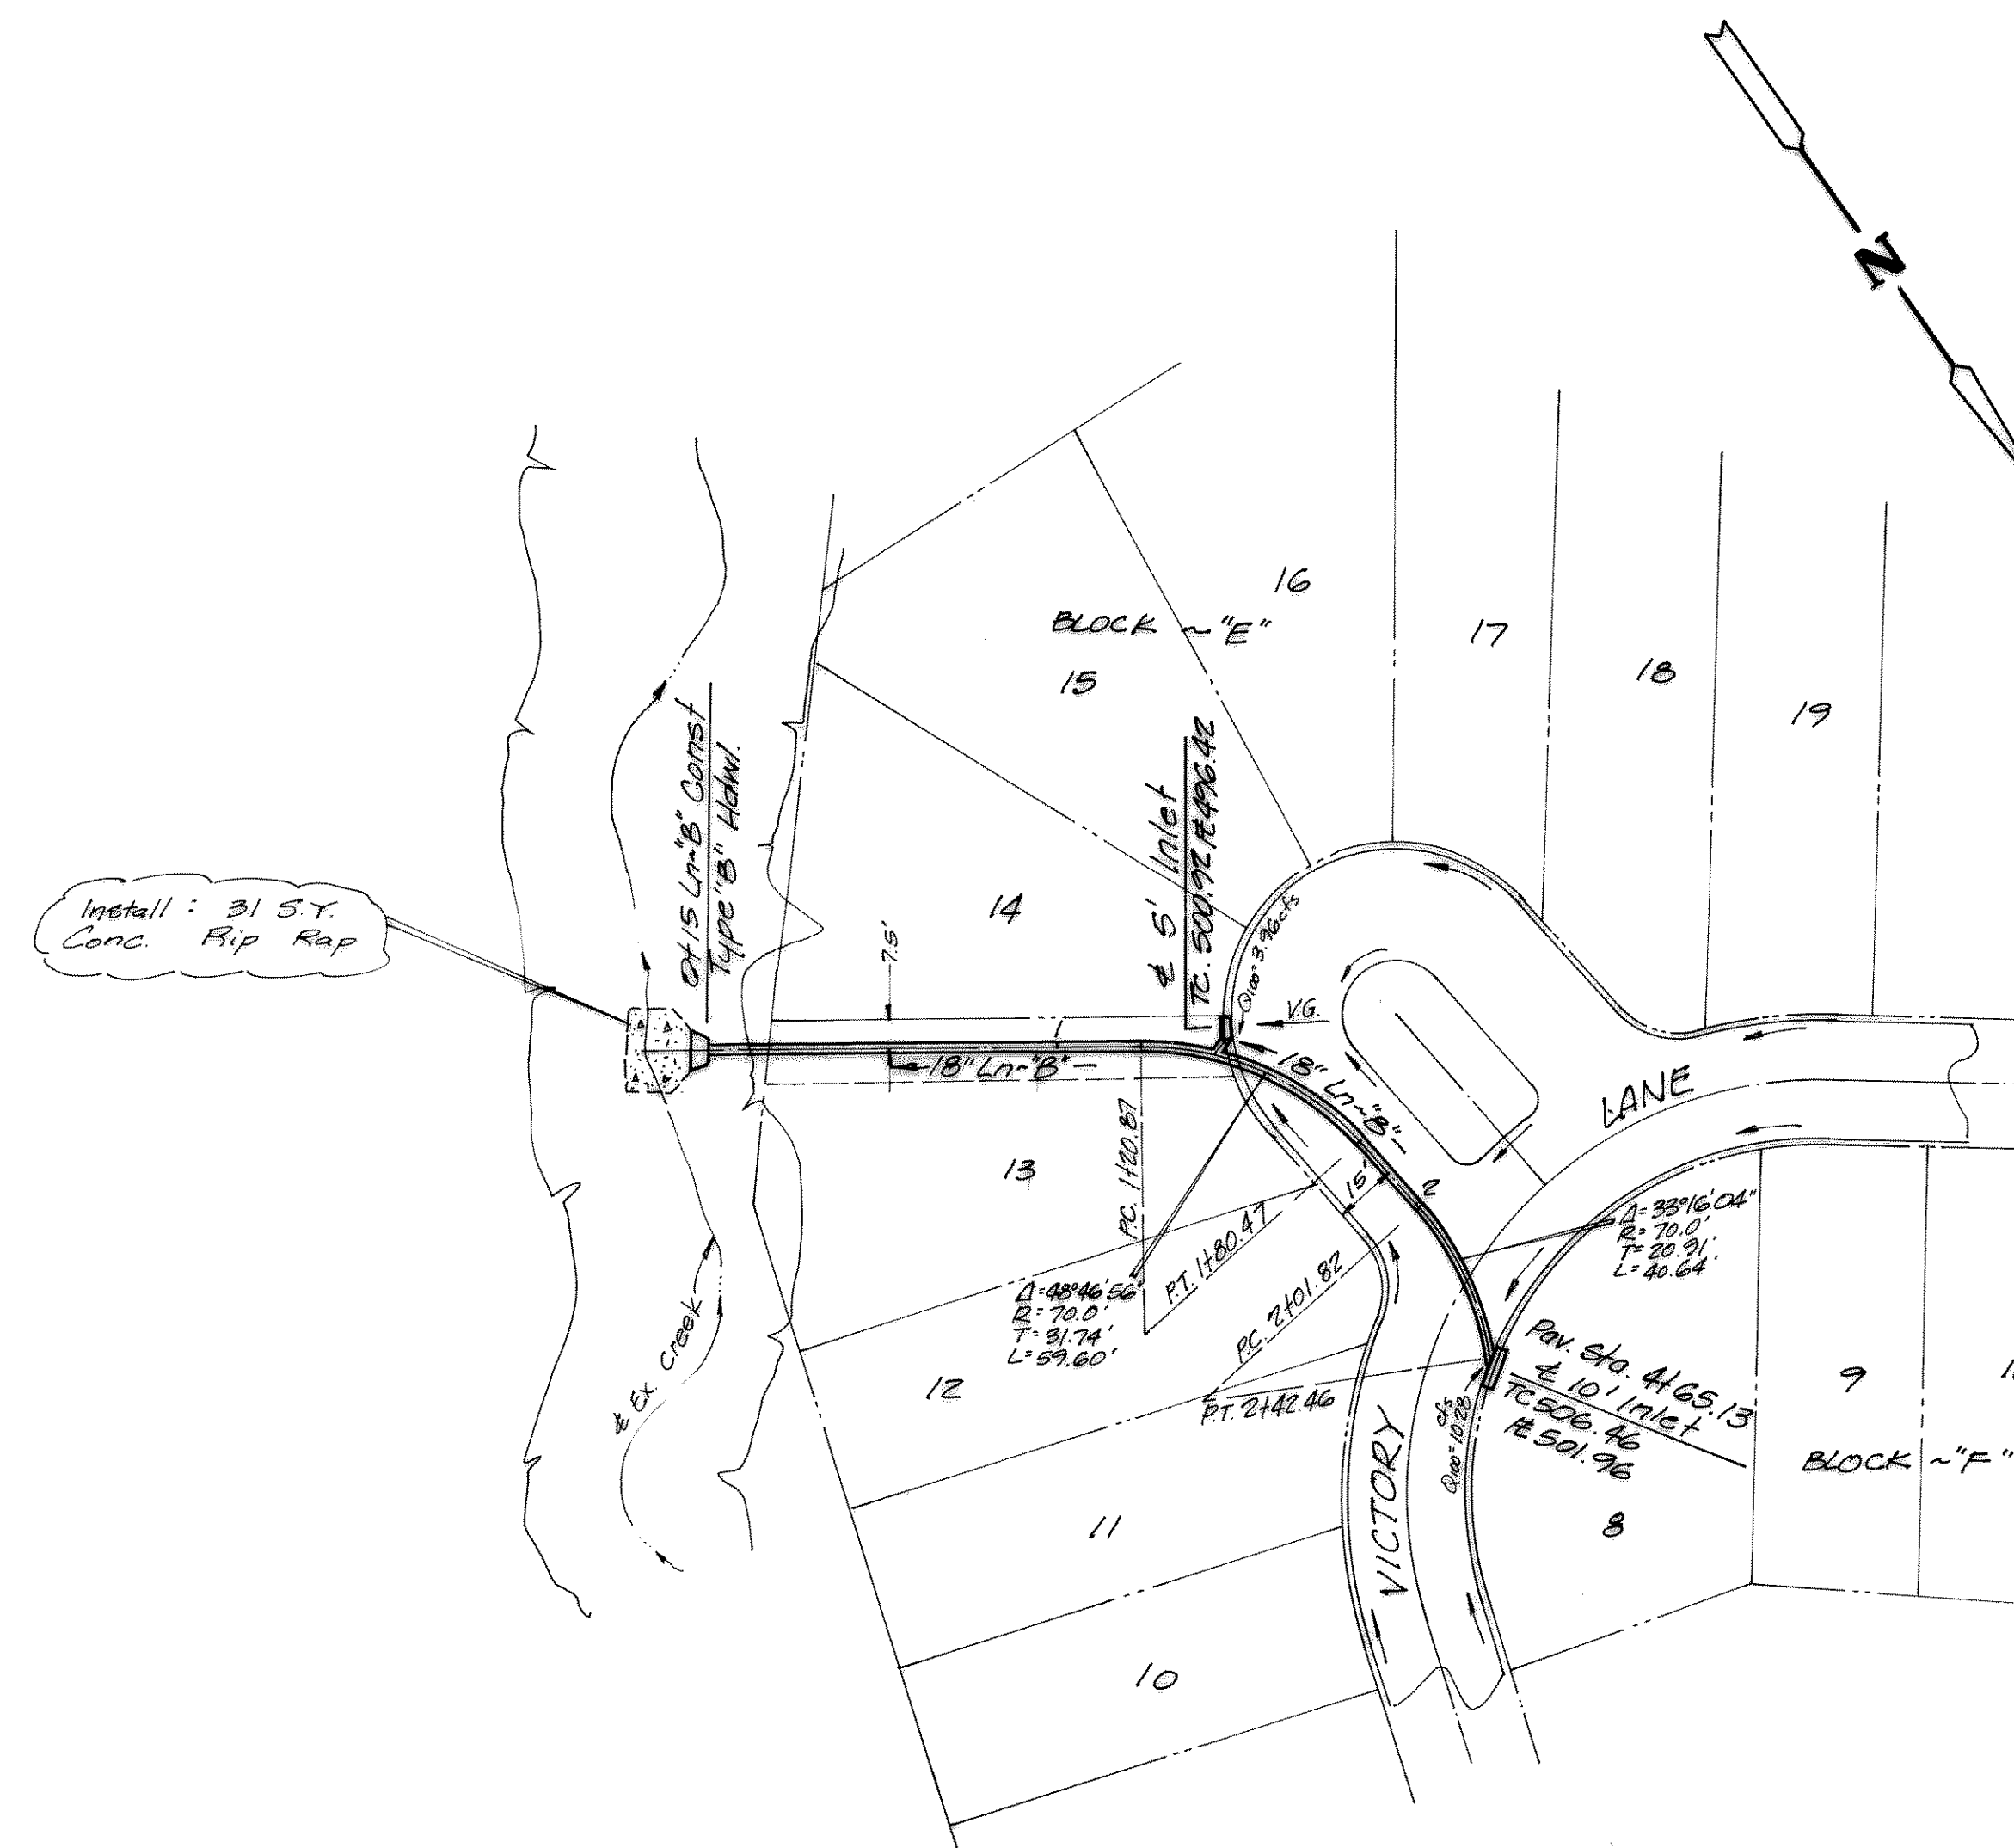

STORM SEWER PLAN

CHANDLERS LANDING PHASE SIXTEEN

CITY OF ROCKWALL

ROCKWALL COUNTY, TEXAS