
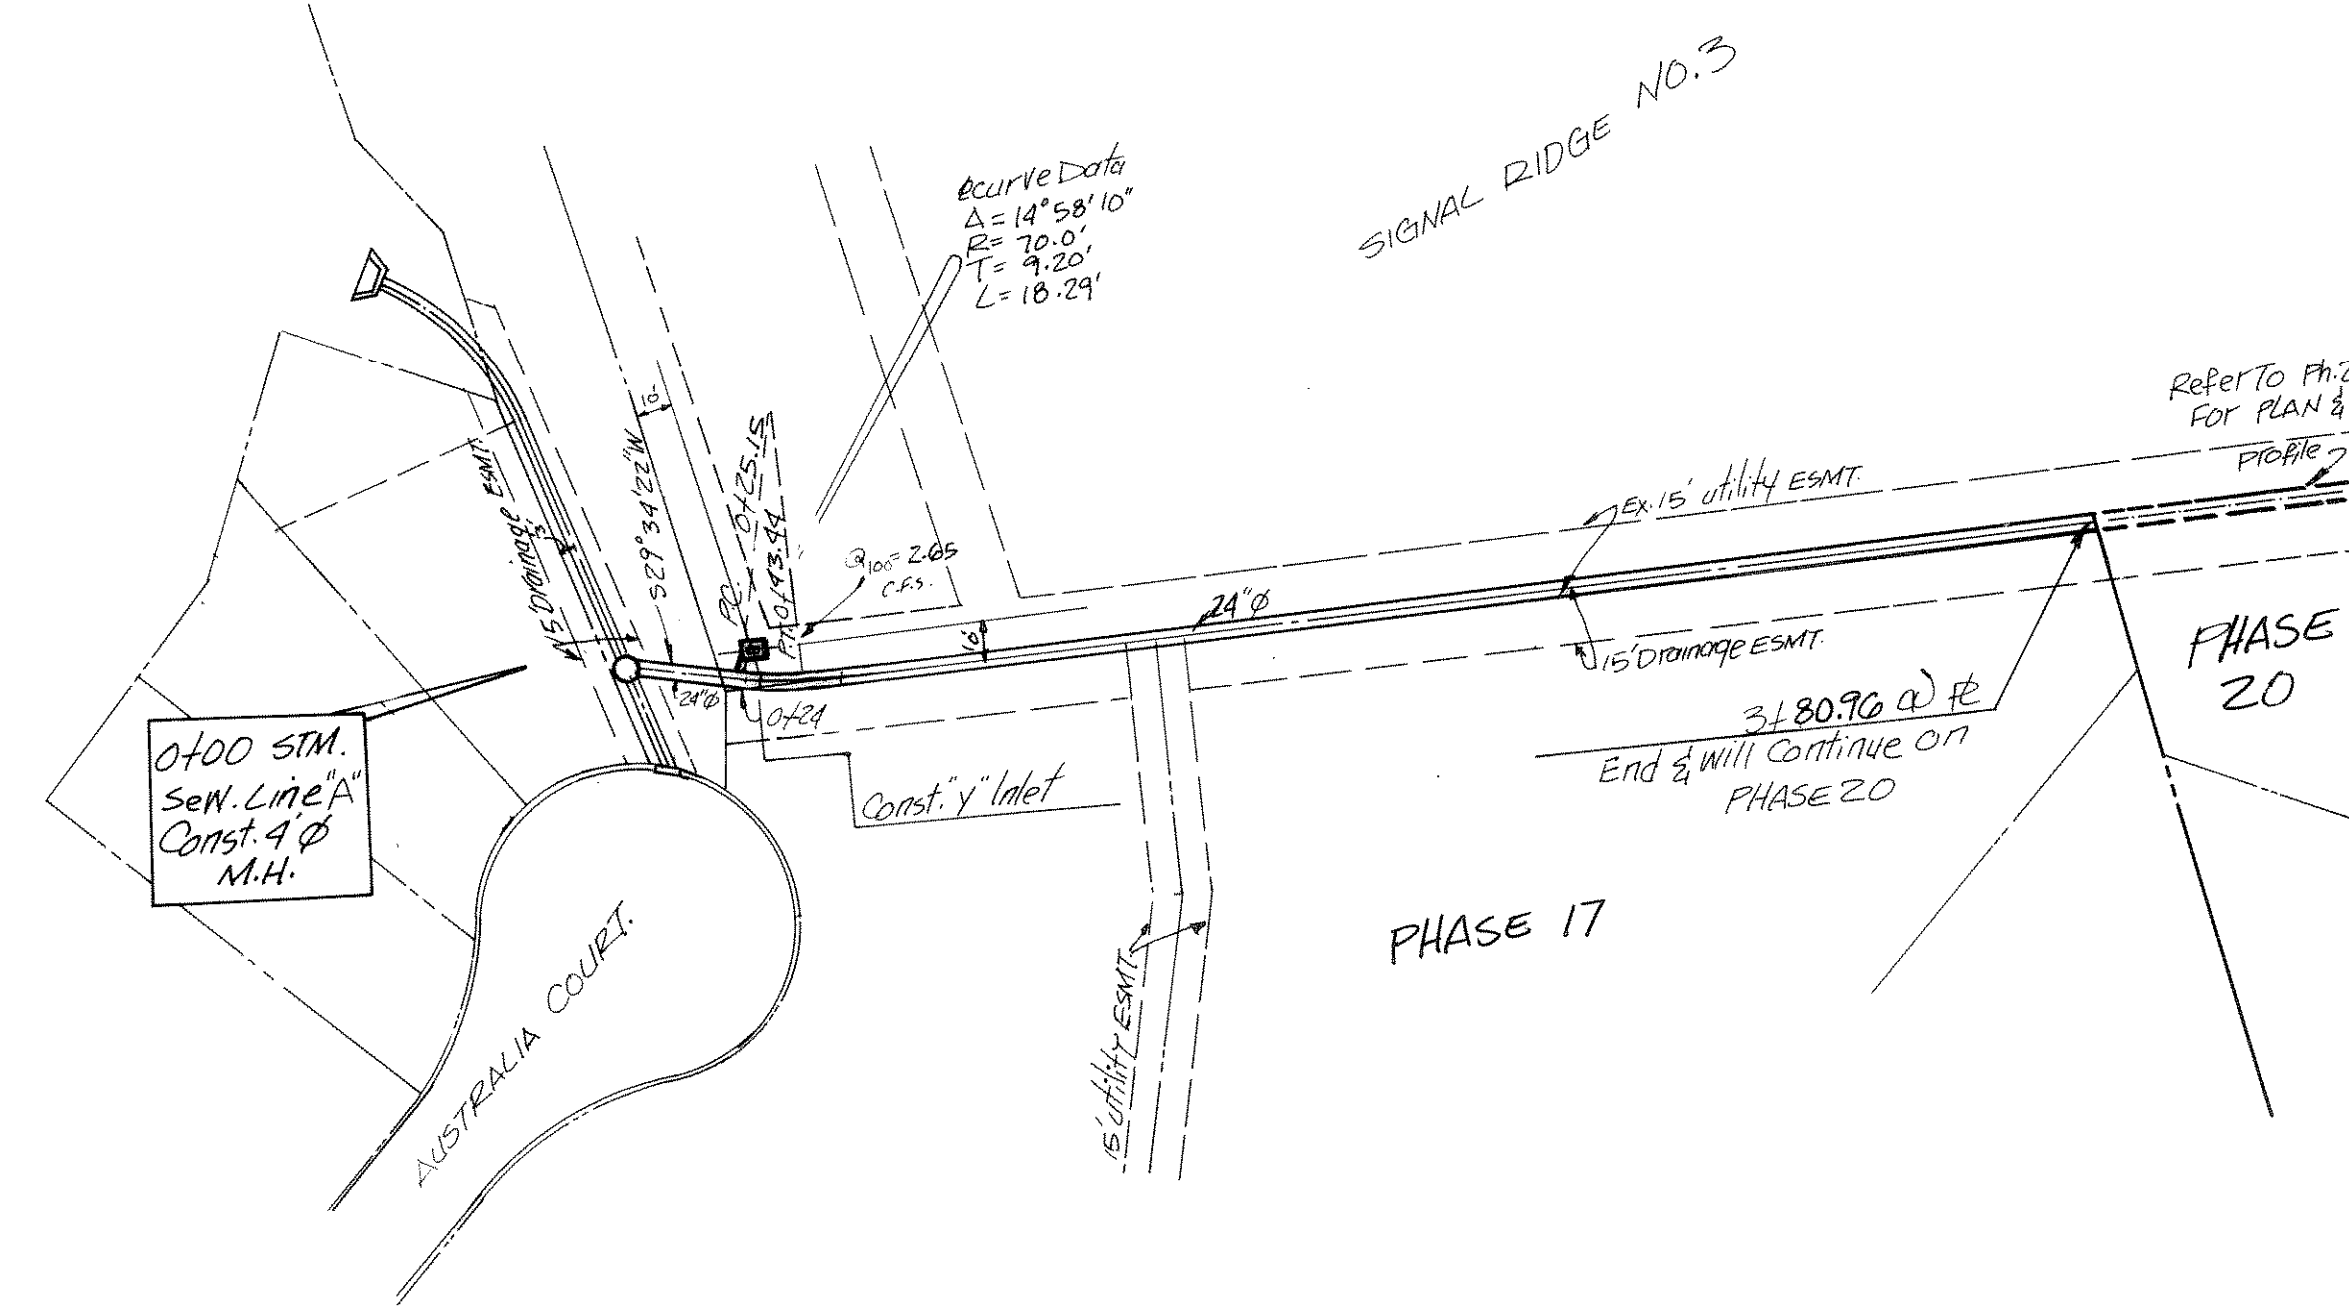



MATCH LINE @ P.T. 44+100.17

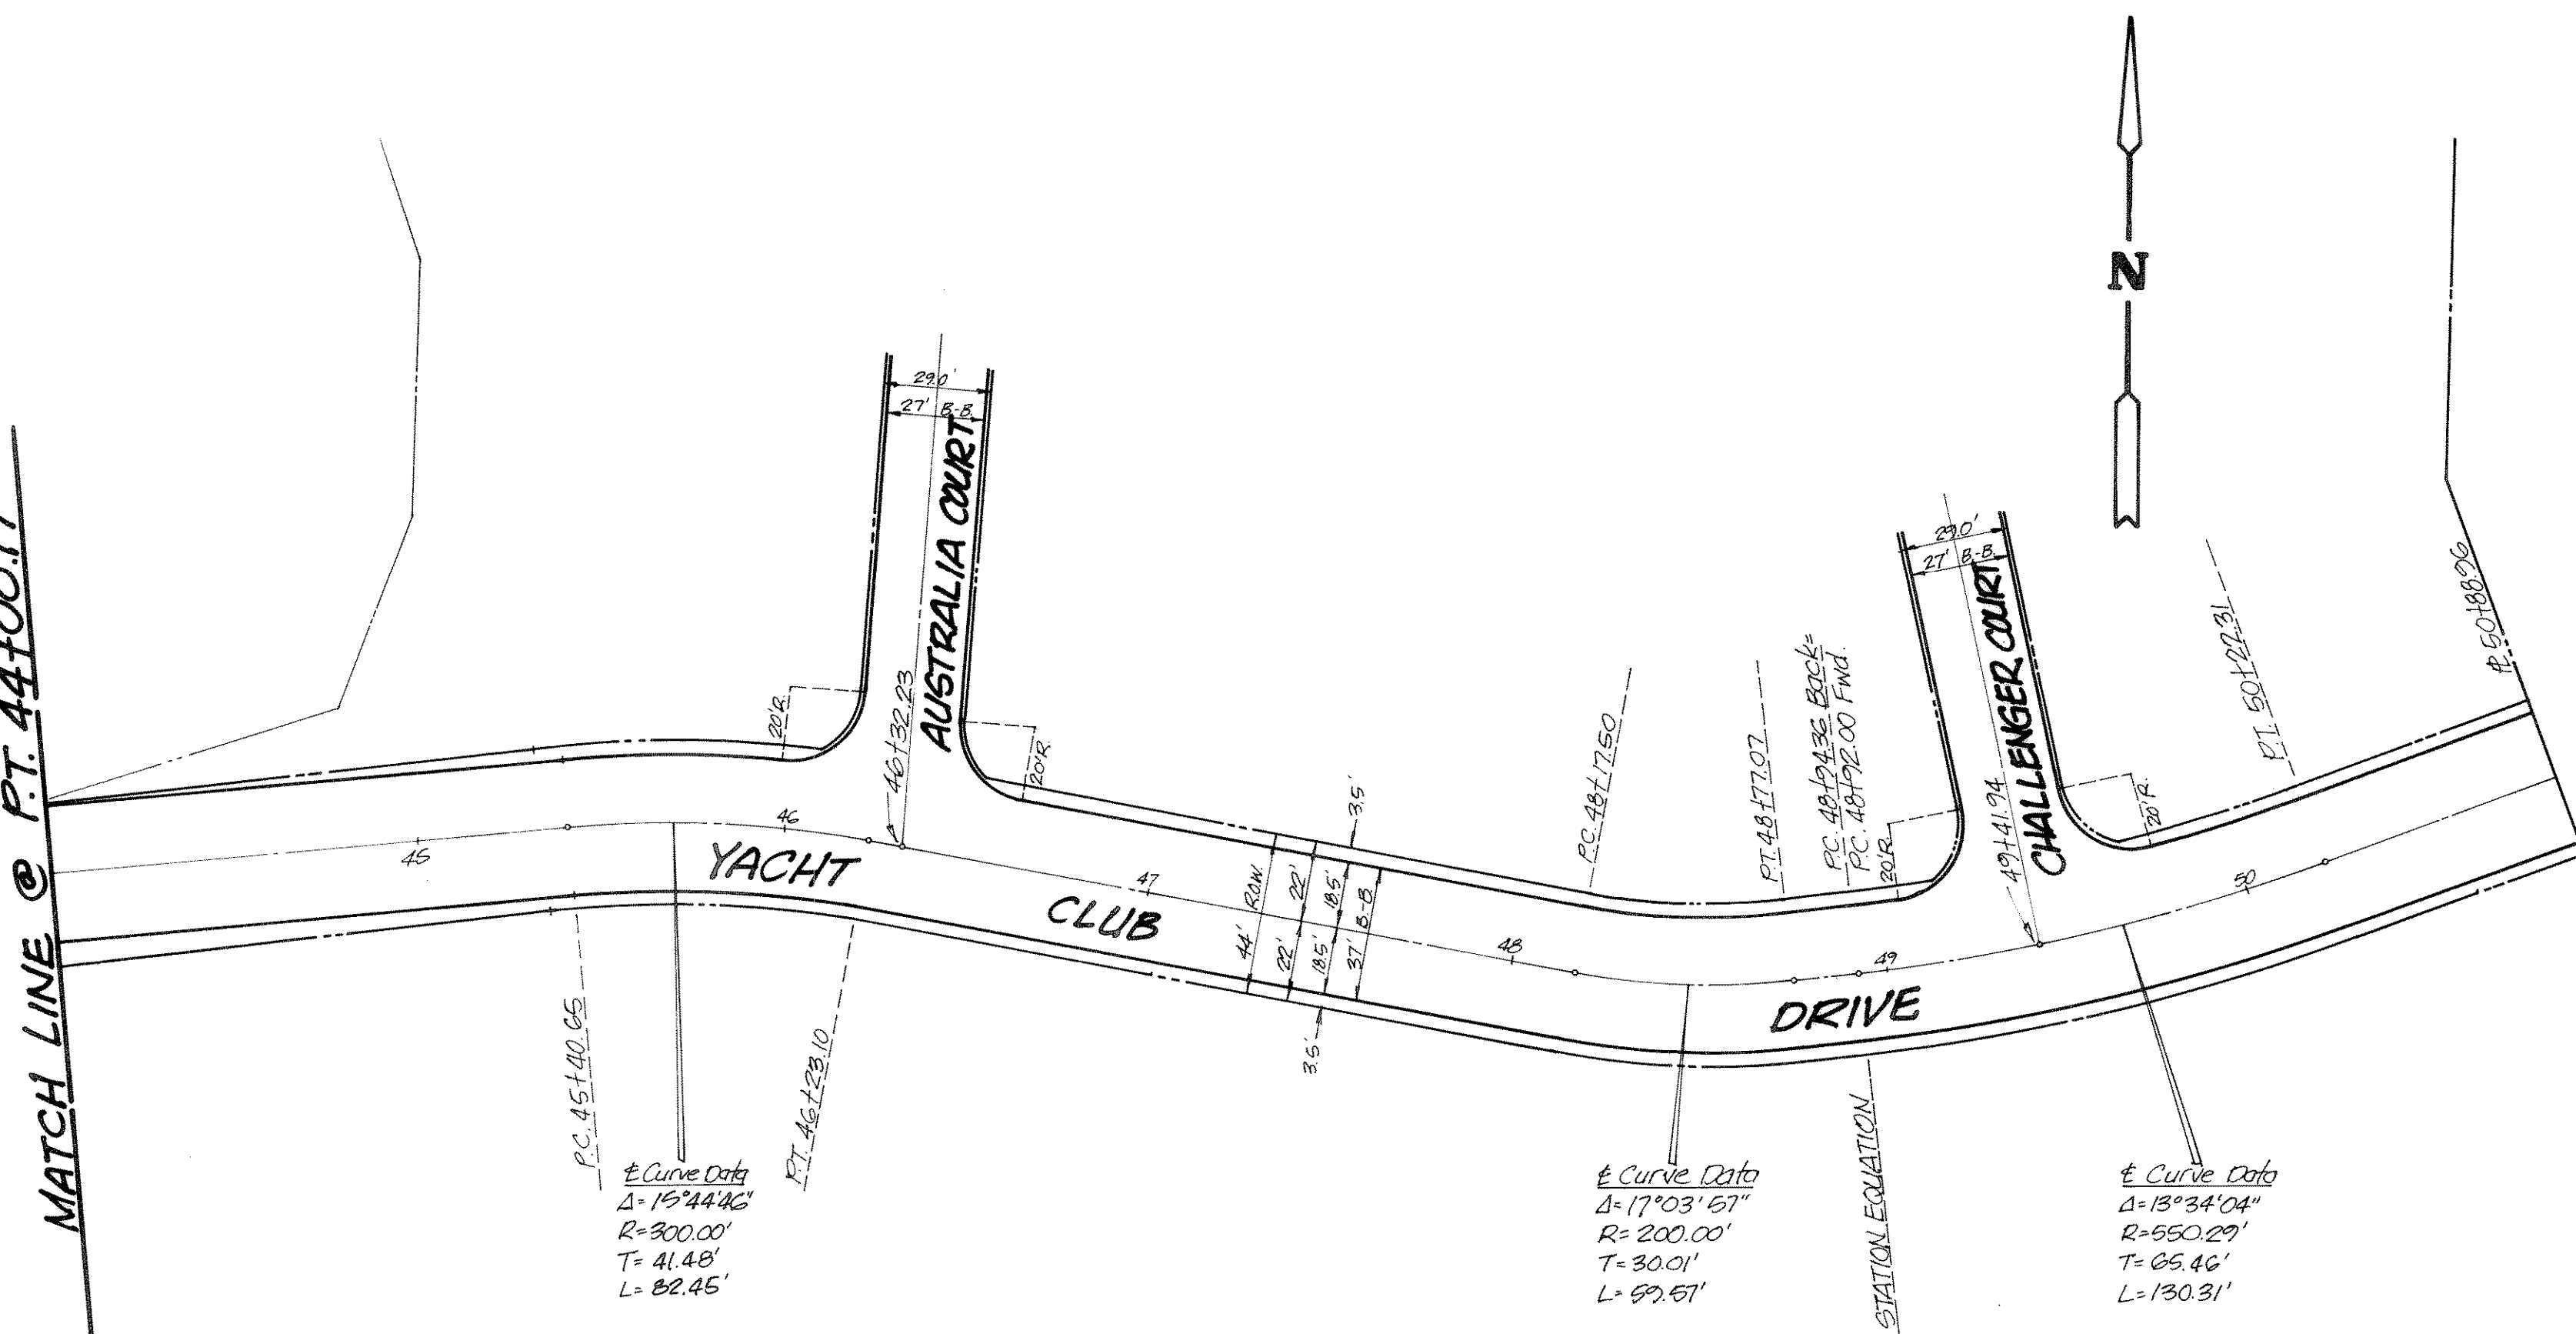

Scale: 1" = 50' H.
1" = 6' V.

Scale: 1" = 40' H.
1" = 6' V.

MATCH LINE STA. 44+100.17

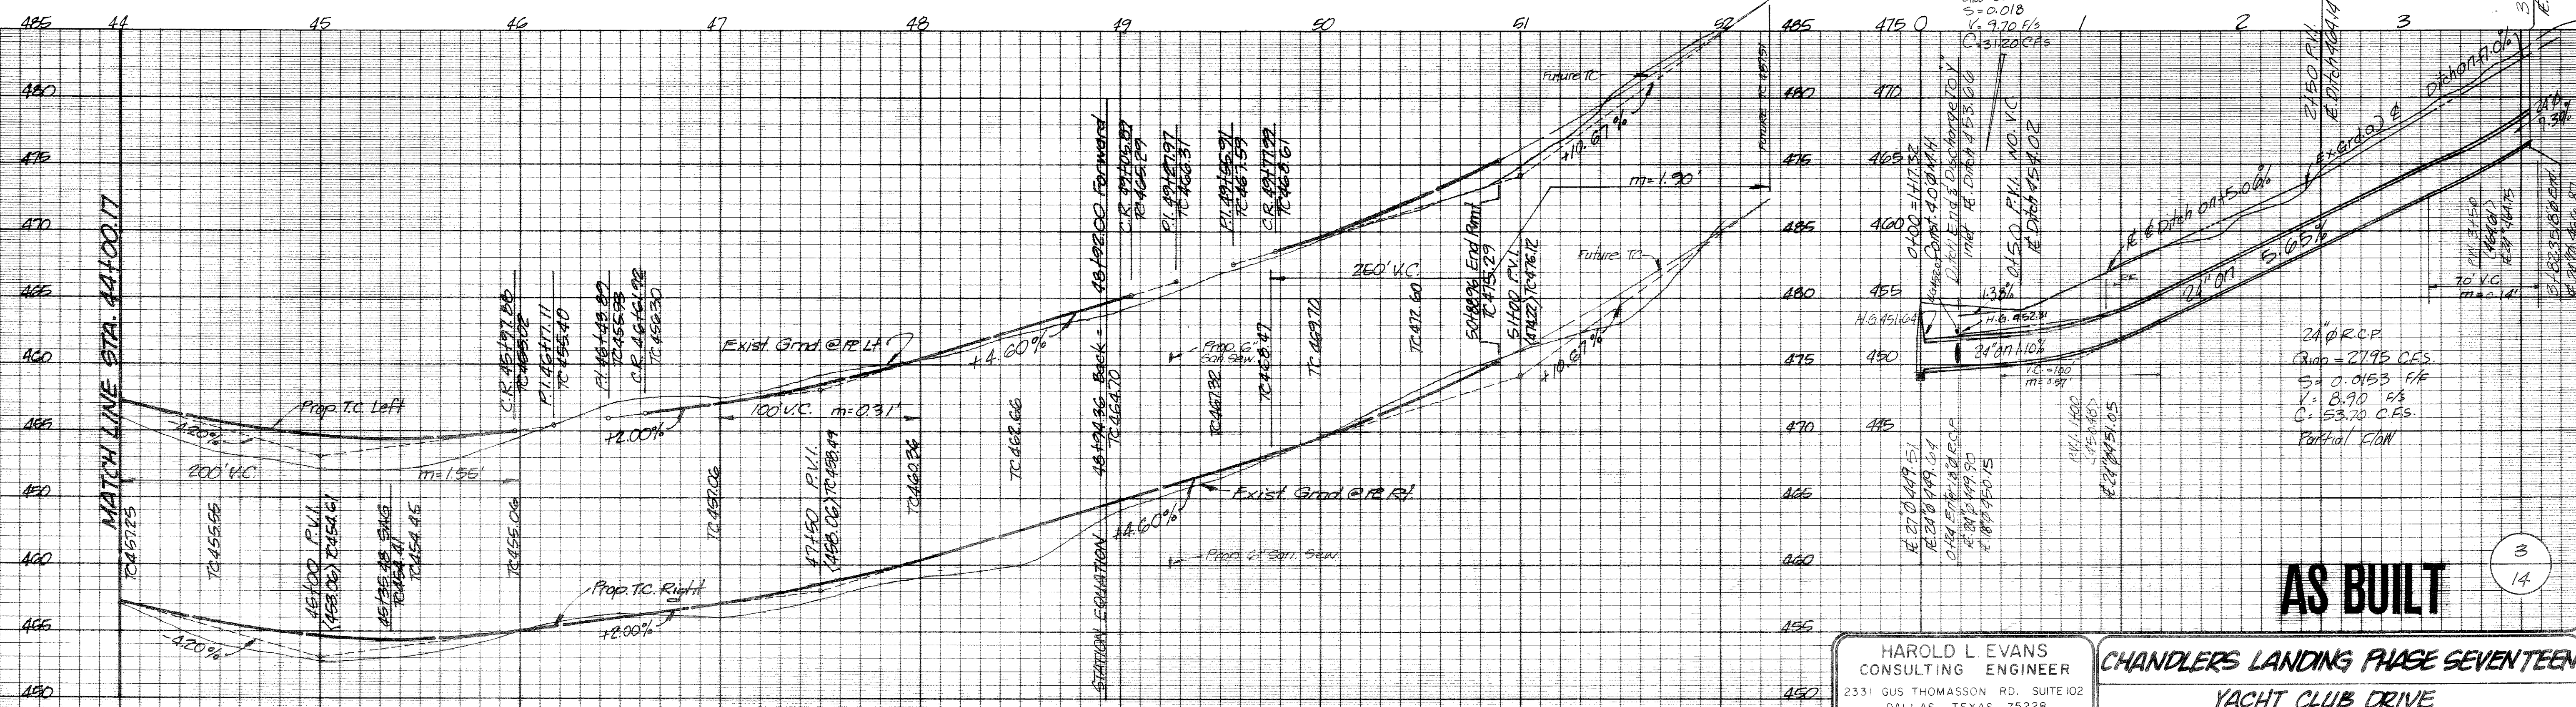

AS BUILT

HAROLD L EVANS
CONSULTING ENGINEER
2331 GUS THOMASSON RD. SUITE 102
DALLAS, TEXAS 75228
PHONE (214) 328-8133
SCALE DATE JOB NO.
AS NOTED 7-9-85 72/22

CHANDLERS LANDING PHASE SEVENTEEN
YACHT CLUB DRIVE
CITY OF ROCKWALL
ROCKWALL COUNTY, TEXAS

REV 8-15-86 YACHT CLUB GRADES, 8-22-86