




AS BUILT

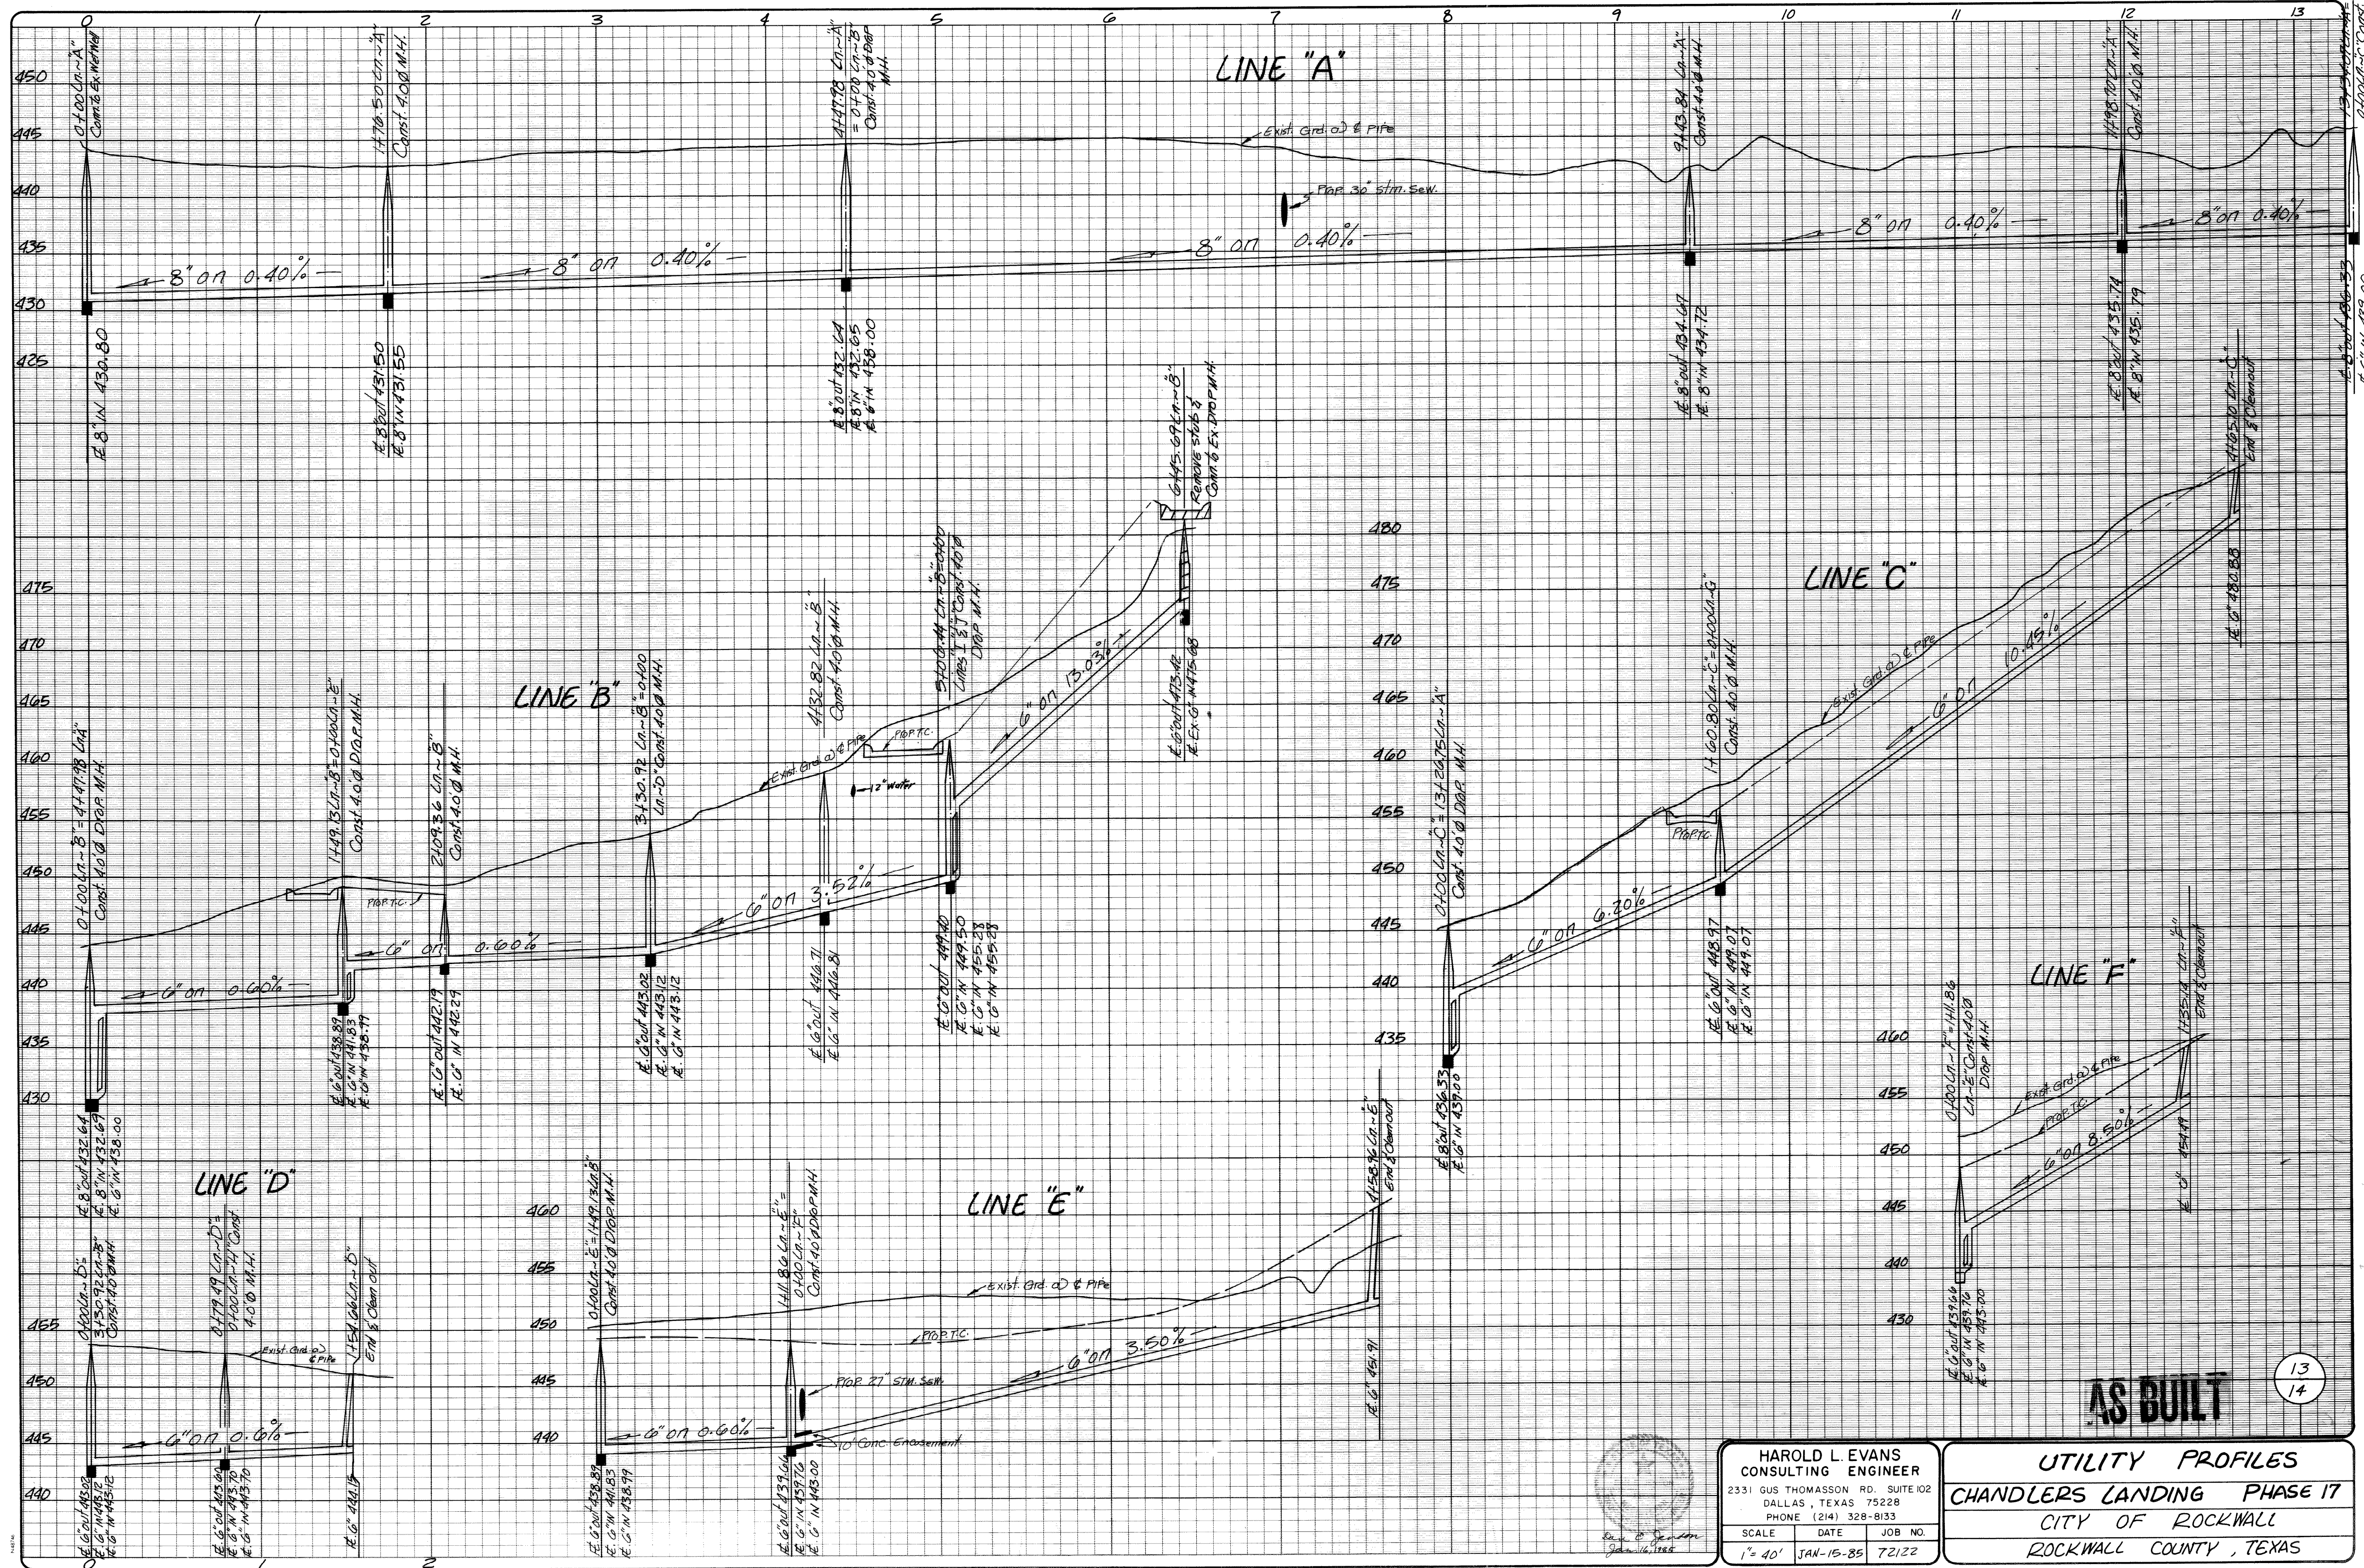

HAROLD L. EVANS CONSULTING ENGINEER		
2331 GUS THOMASSON RD. SUITE 102 DALLAS, TEXAS 75228 PHONE (214) 328-8133		
SCALE	DATE	JOB NO.
1" = 40'	JAN-15-85	72122

UTILITY PROFILES
CHANDLERS LANDING PHASE 17
CITY OF ROCKWALL
ROCKWALL COUNTY, TEXAS

Rev. 3/12/85