
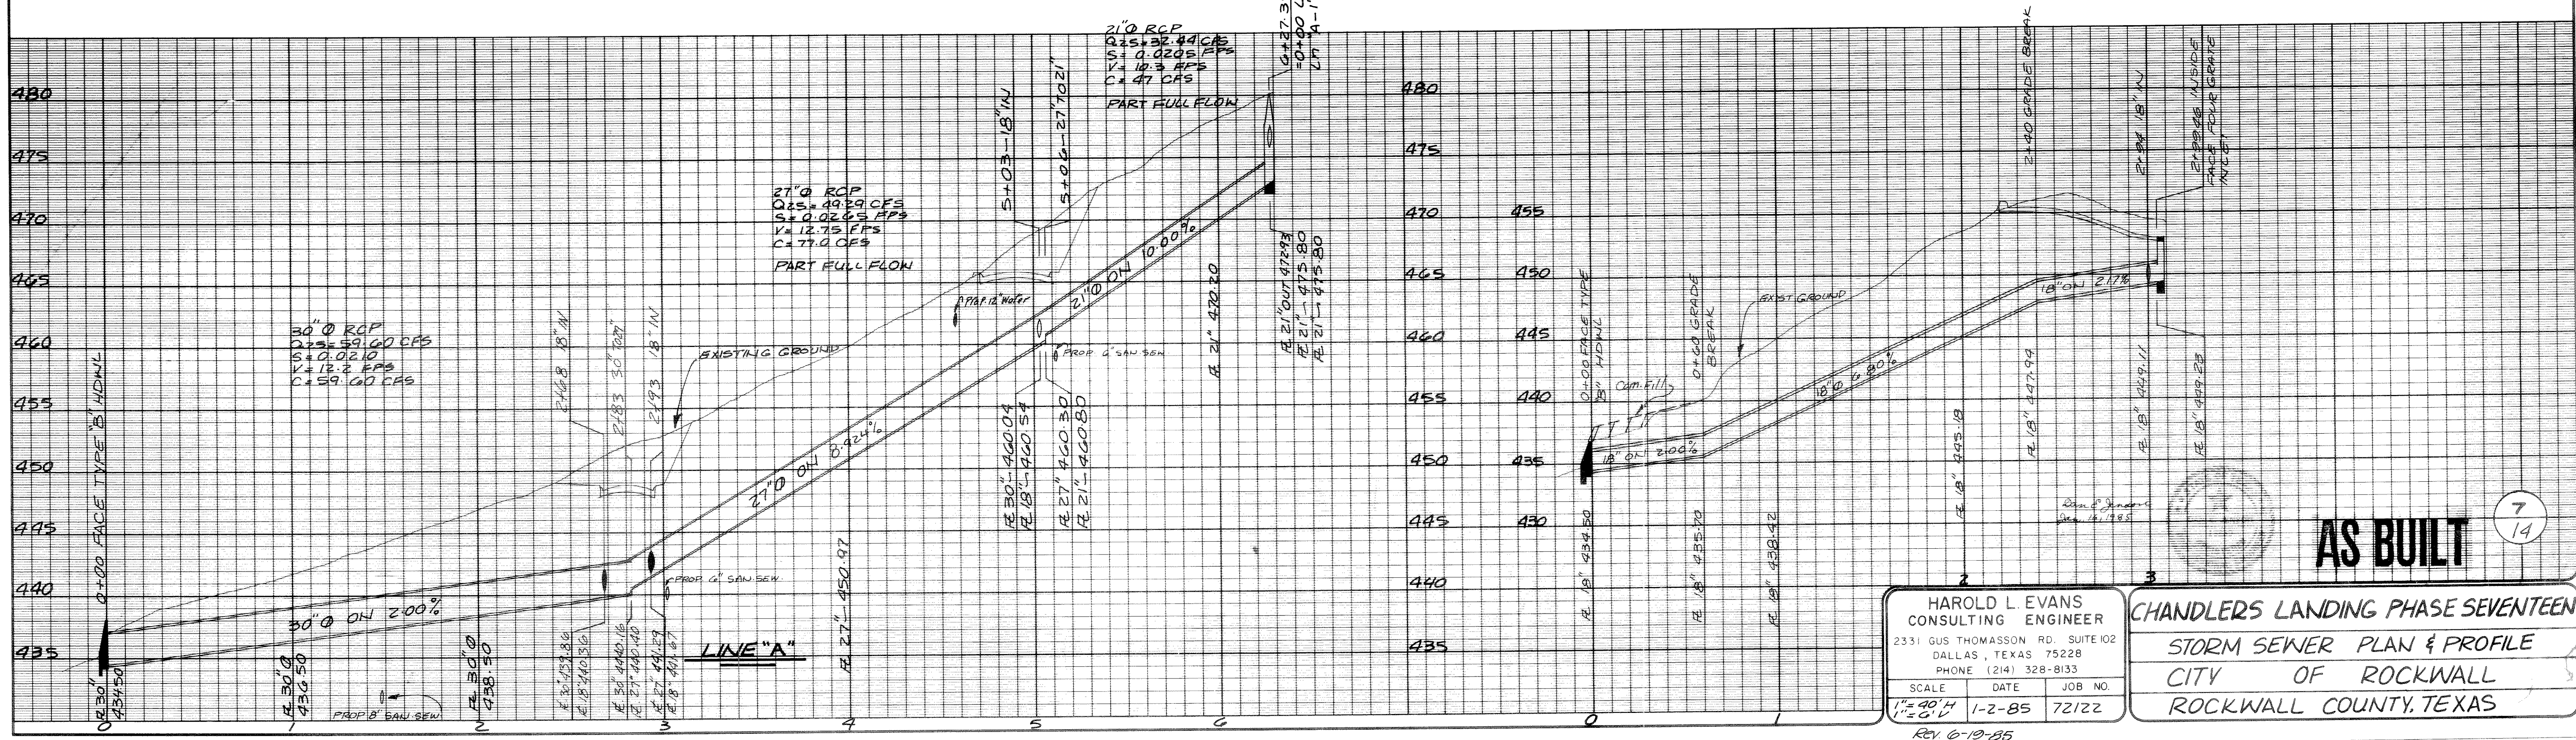
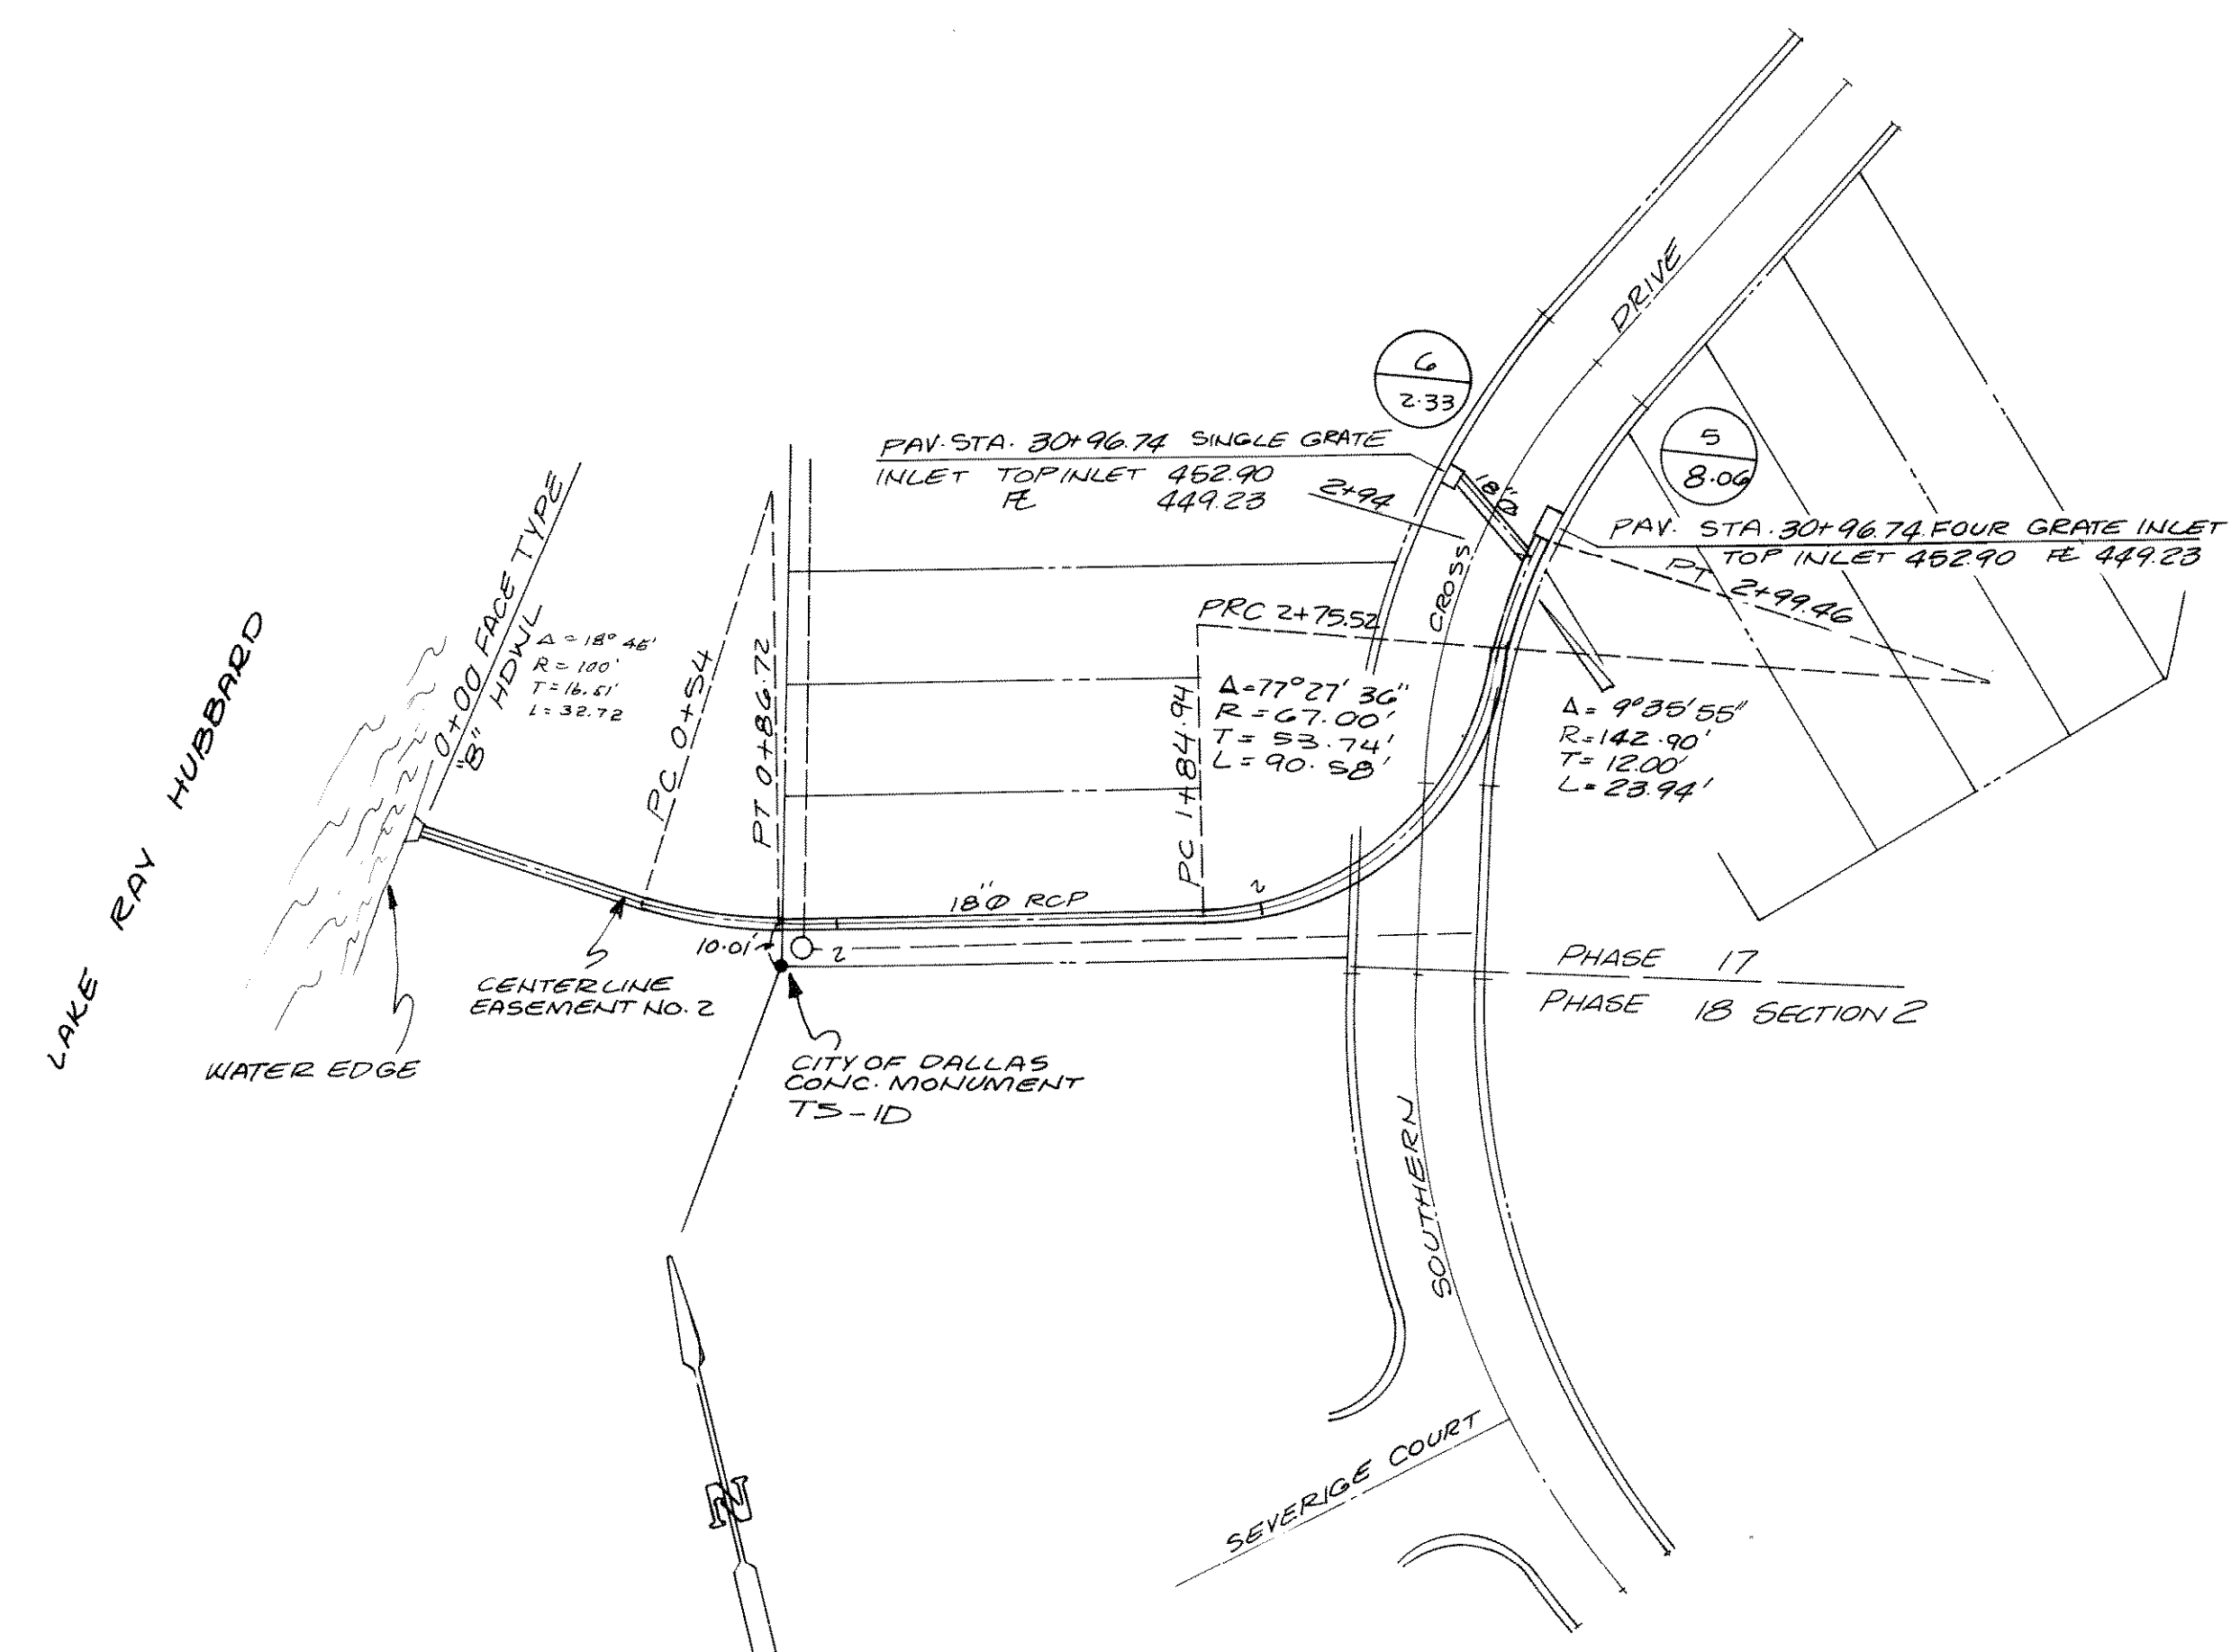


BY <u>D.E.S.</u> CITY OF ROCKWALL, TEXAS																		SHEET _____ OF _____	
DATE <u>12-26-99</u> =																		STREET _____	
CKD. _____ n = <u>0.016</u>																		MAJOR WATERSHED _____	
DATE _____																		JOB OR FILE NO. _____	
INLET																			
TYPE & NO.	STATION	D.A. NO.	Q _P C.F.S.	CARRY-OVER FLOW Q C.F.S.	TOTAL FLOW Q ₀ C.F.S.	Z	Z/N	S ₀ FT/FT	Y ₀ FT.	PONDED WIDTH	Q ₀ L ₀ S/L ₀ C.F.S. FT.	L ₀ FT.	L ₀ FT.	Q ₀ L ₀ C.F.S. FT.	Q ₀ L ₀ C.F.S. FT.	CARRY-OVER FLOW Q C.F.S.	REMARKS		
1	2	3	4	5	6	7	8	9	10	11	12	13	14	15	16	17	18		
20	38+20																		
	YACHT CLUB																		
	FOUR GRADE CANADA CREEK																		
	5+28.13-1	3	14.85	0	14.85	36	2250	0.0375	0.34	12.96	0.95	17.73	200	113	1.0	14.85	0		
	FOUR GRADE CANADA CREEK																		
	5+28.13-1	3	9.06	0	9.06	28	1750	0	0.50	14.0'	-	-	-	-	-	9.06	0		
	FOUR GRADE CANADA CREEK																		
	5+28.13-1	4	1.25	0	1.25	28	1750	0	0.20	5.60'	-	-	-	-	-	1.25	0		
	FOUR GRADE SOUTHERN CROSS																		
	5+28.13-1	5	10.79	0	10.79	28	1750	0	0.50	14.0'	-	-	-	-	-	10.79	0		
	FOUR GRADE SOUTHERN CROSS																		
	5+28.13-1	6	3.12	0	3.12	28	1750	0	0.27	11.90'	-	-	-	-	-	3.12	0		

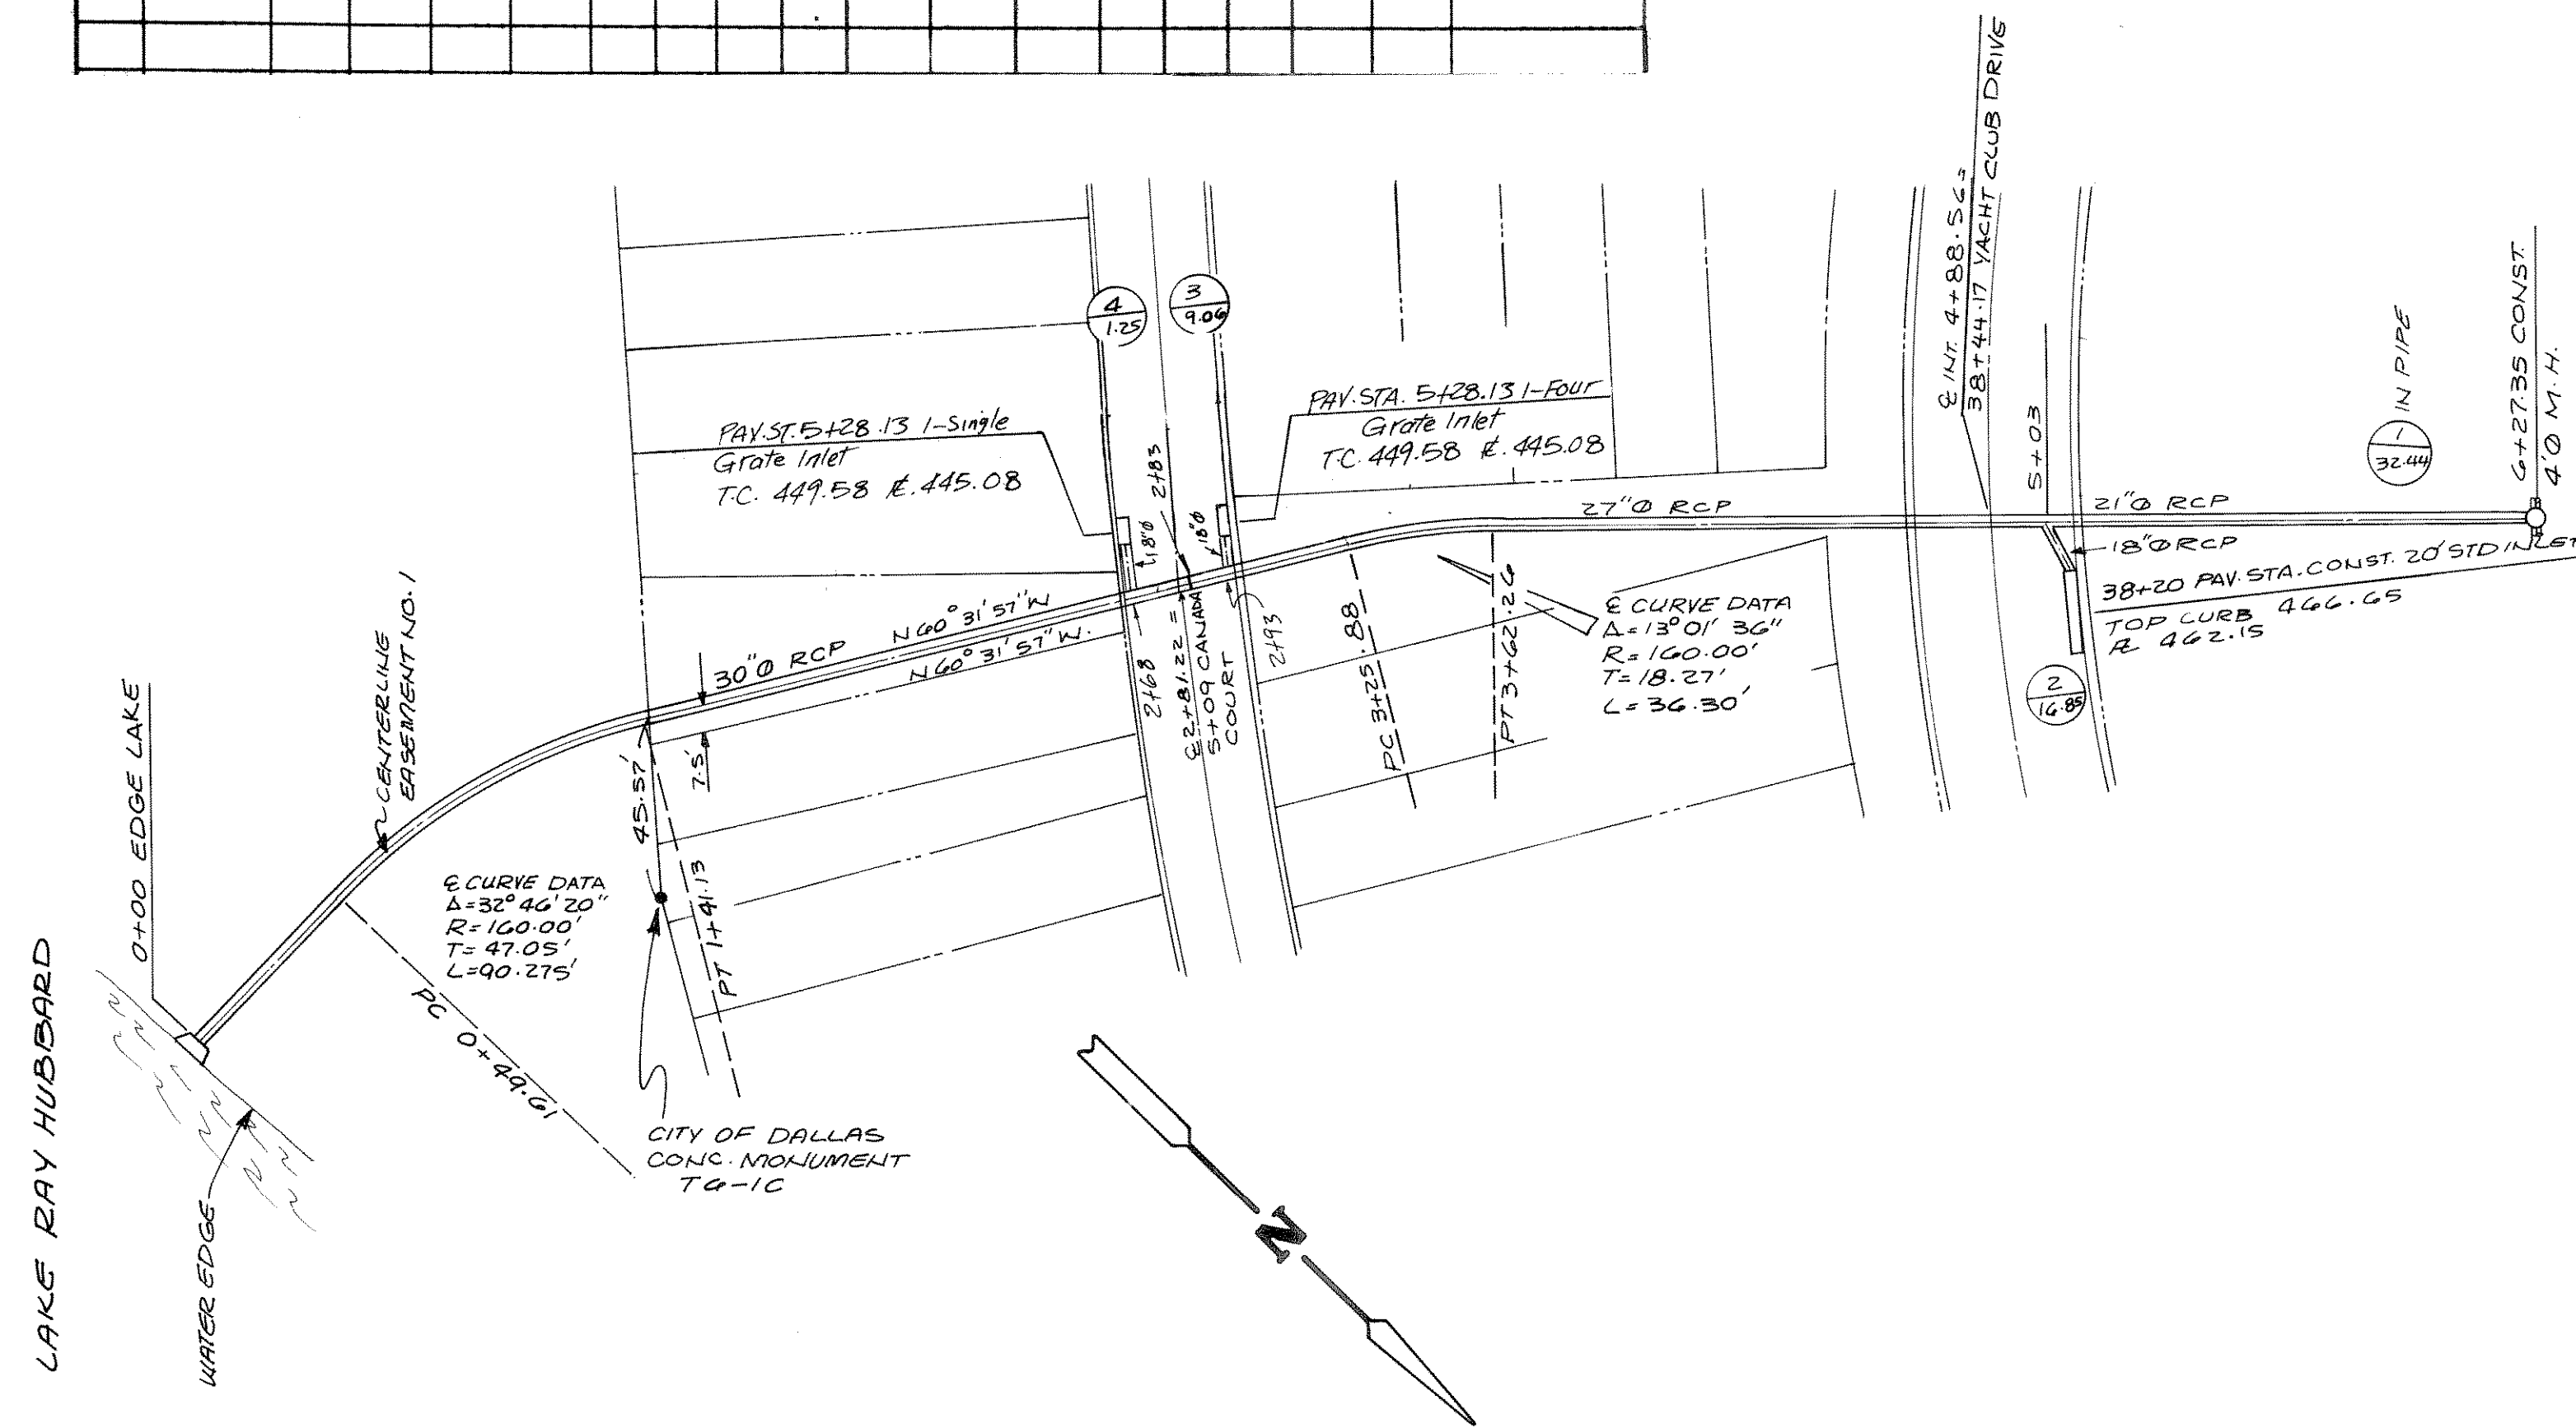

HAROLD L. EVANS
CONSULTING ENGINEER
2331 GUS THOMASSON RD. SUITE 102
DALLAS, TEXAS 75228
PHONE (214) 328-8133

SCALE: 1"=40' H, 1"=60' V
DATE: 1-2-85
JOB NO.: 72122

AS BUILT

CHANDLERS LANDING PHASE SEVENTEEN

STORM SEWER PLAN & PROFILE

CITY OF ROCKWALL

ROCKWALL COUNTY, TEXAS

REV 6-19-85