


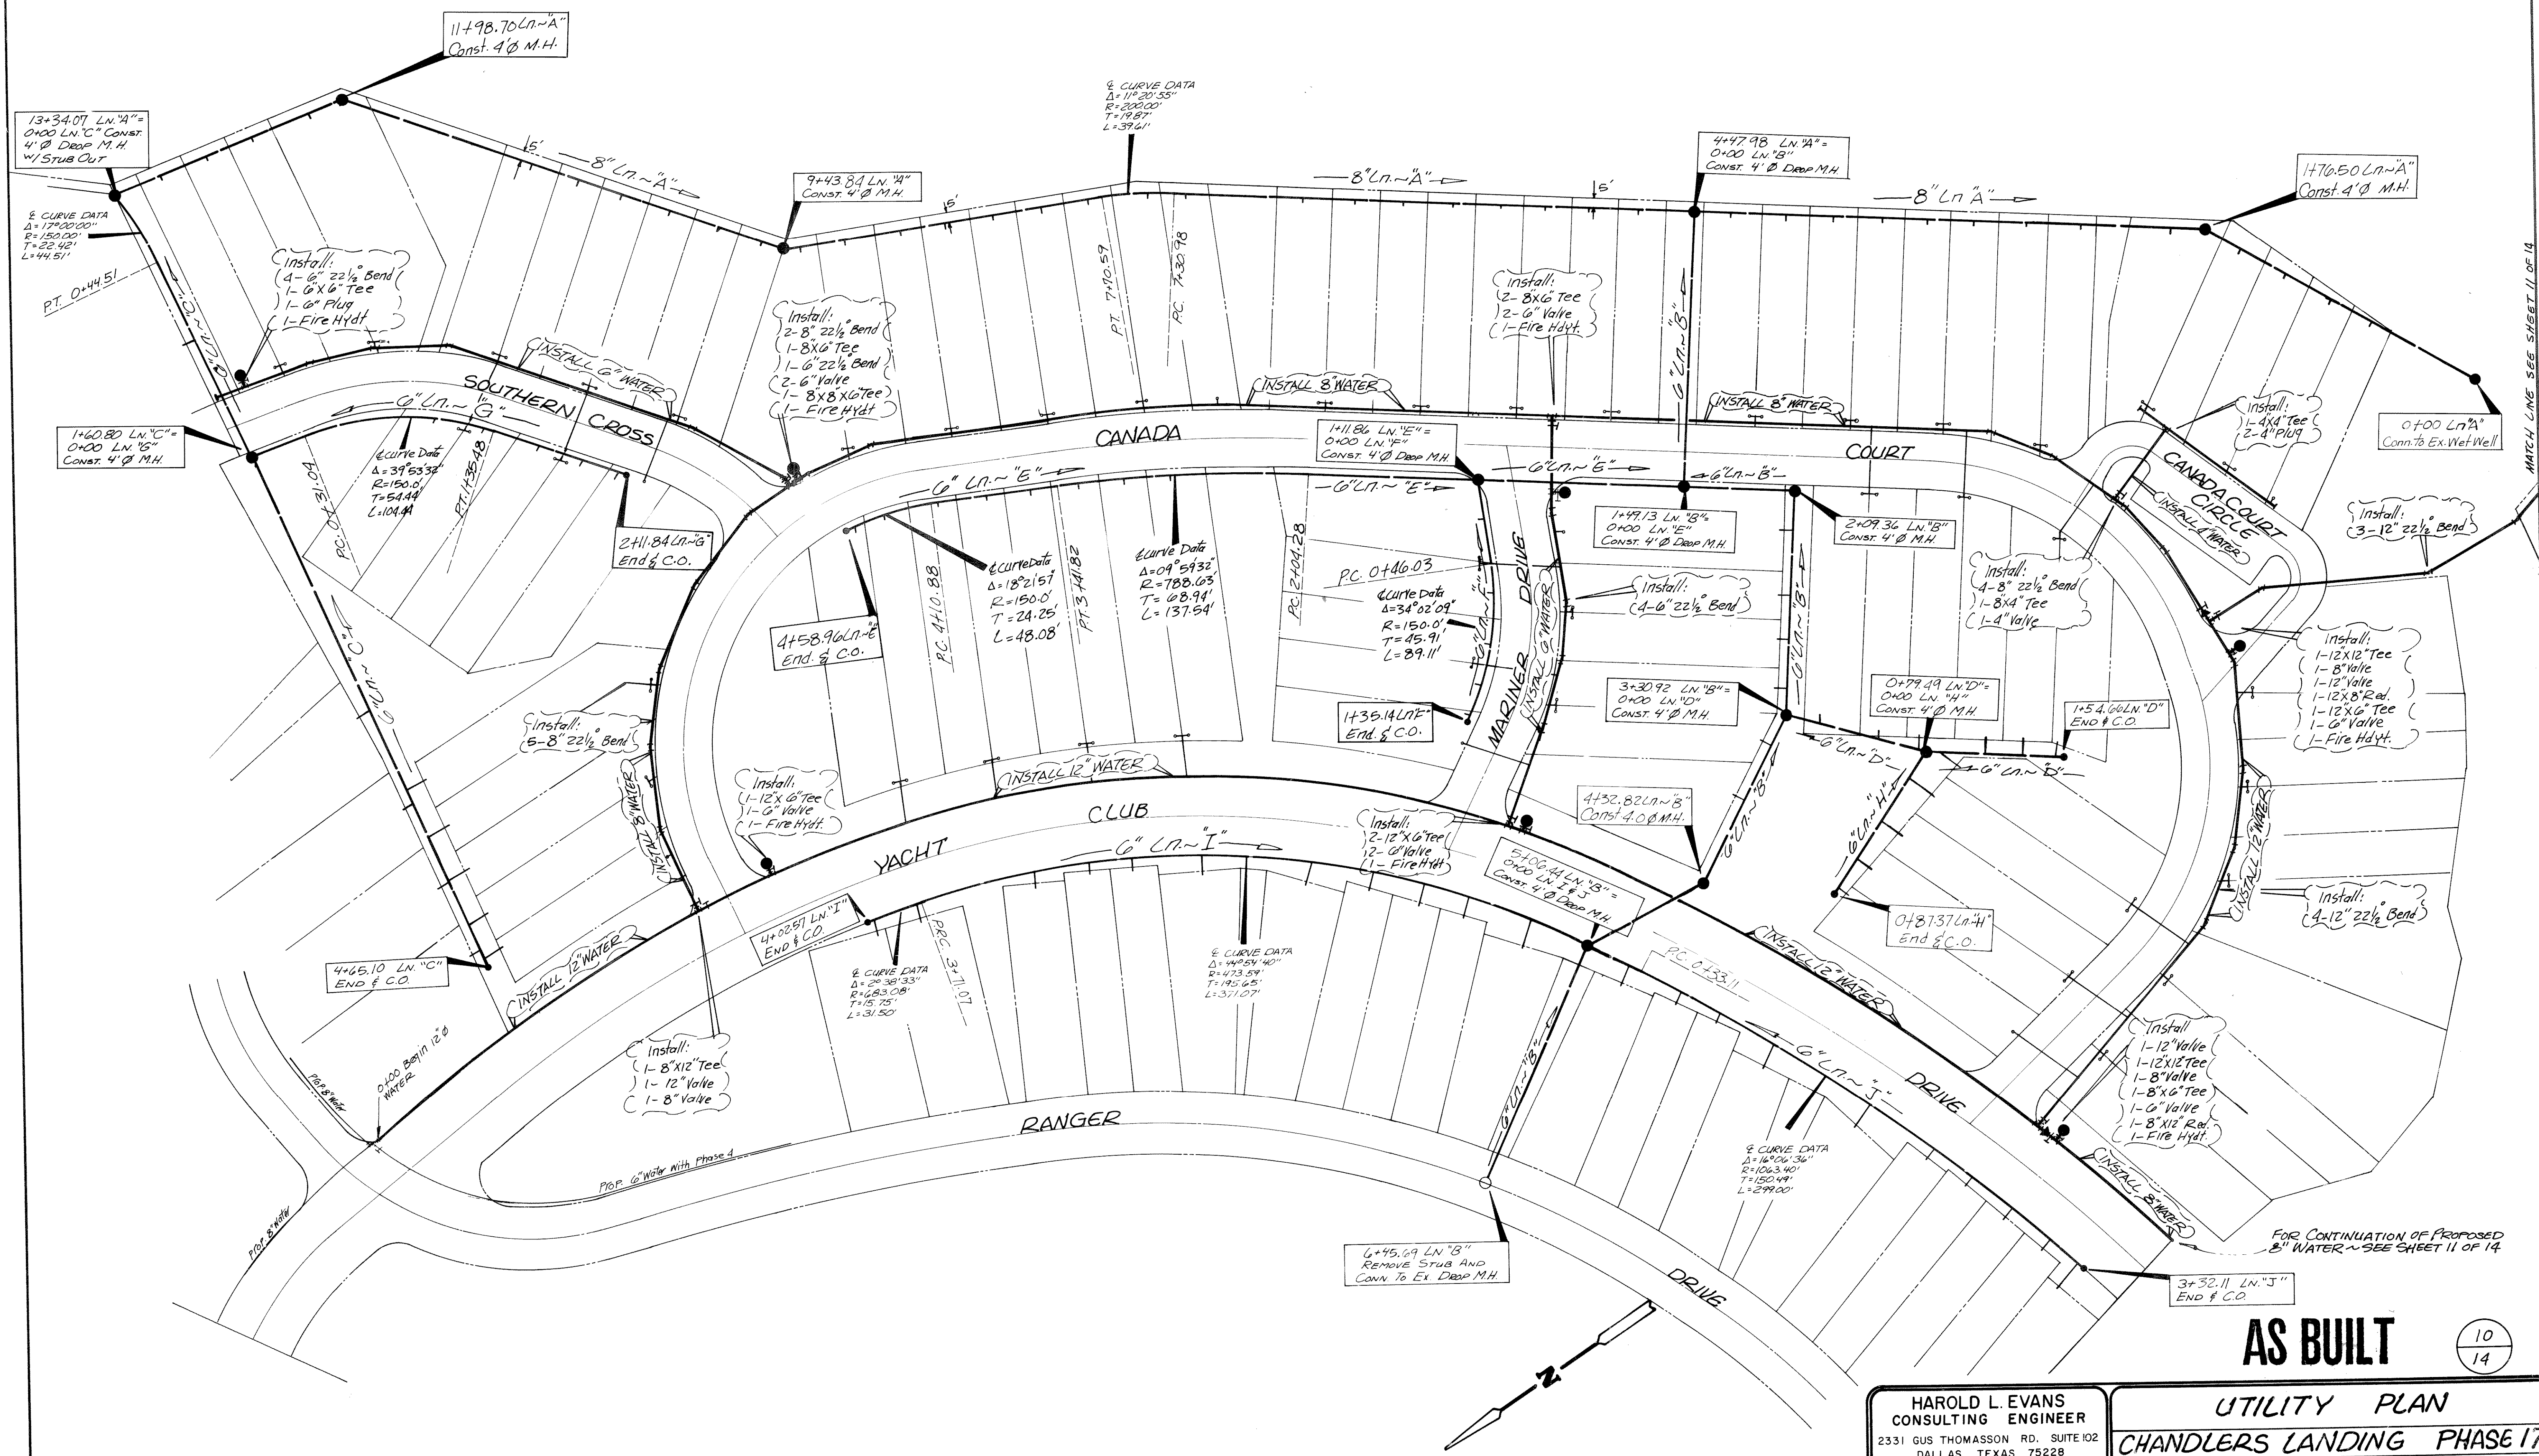

MATCH LINE SEE SHEET 11 OF 14