


0400 COURAGEOUS DRIVE =
33174.50 Yacht Club Drive



"X" cut at centerline intersection of Yacht Club Drive and Entrepid Circle
Elev. 502.53

"Square" cut on top of grate inlet halfway between Chandlers Landing Yacht Club and back-of-curb of island
Elev. 459.57

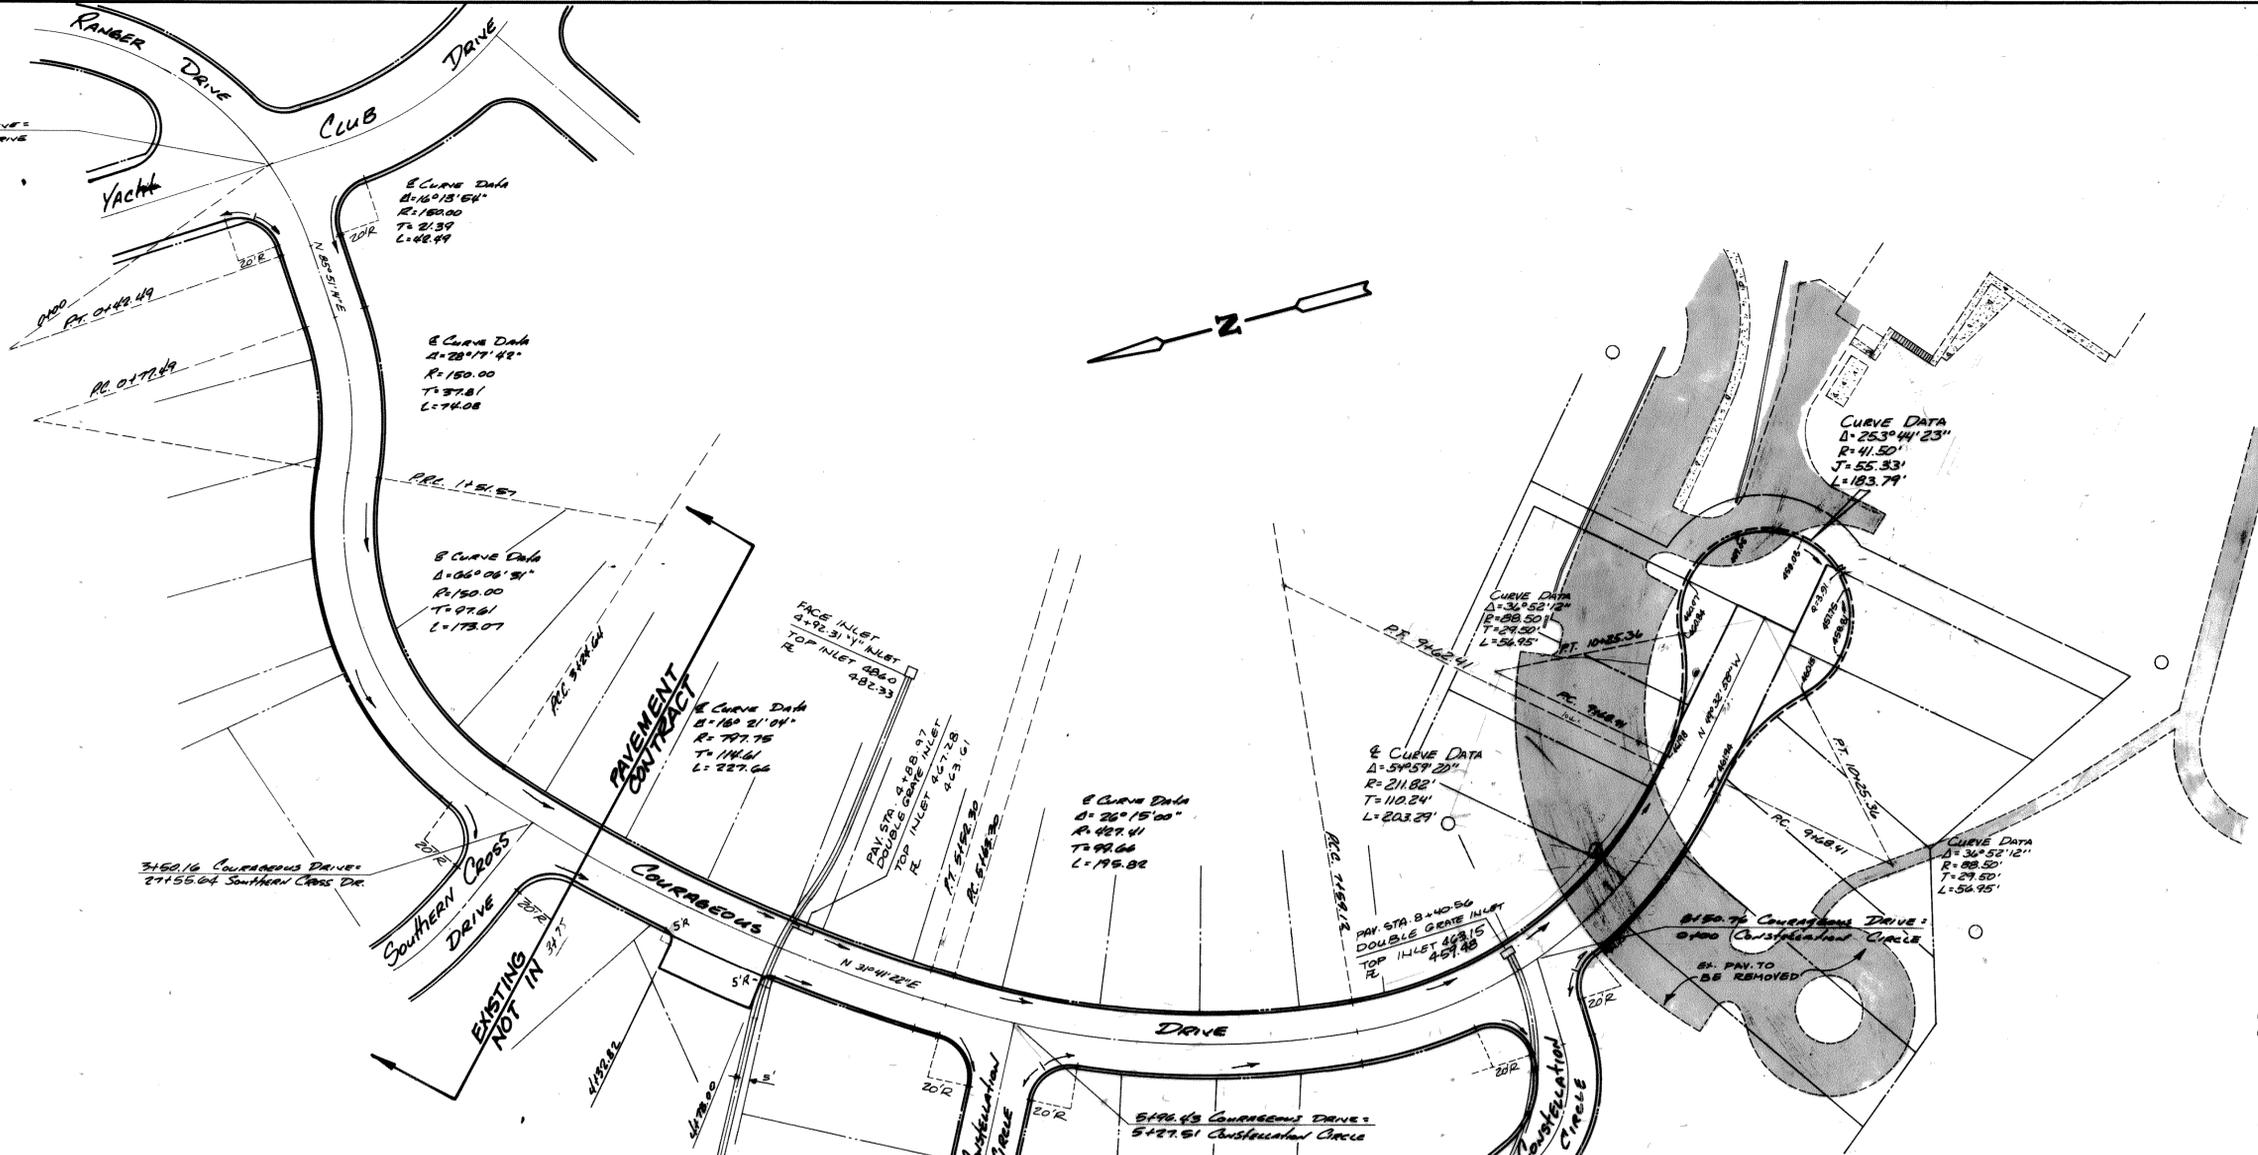