


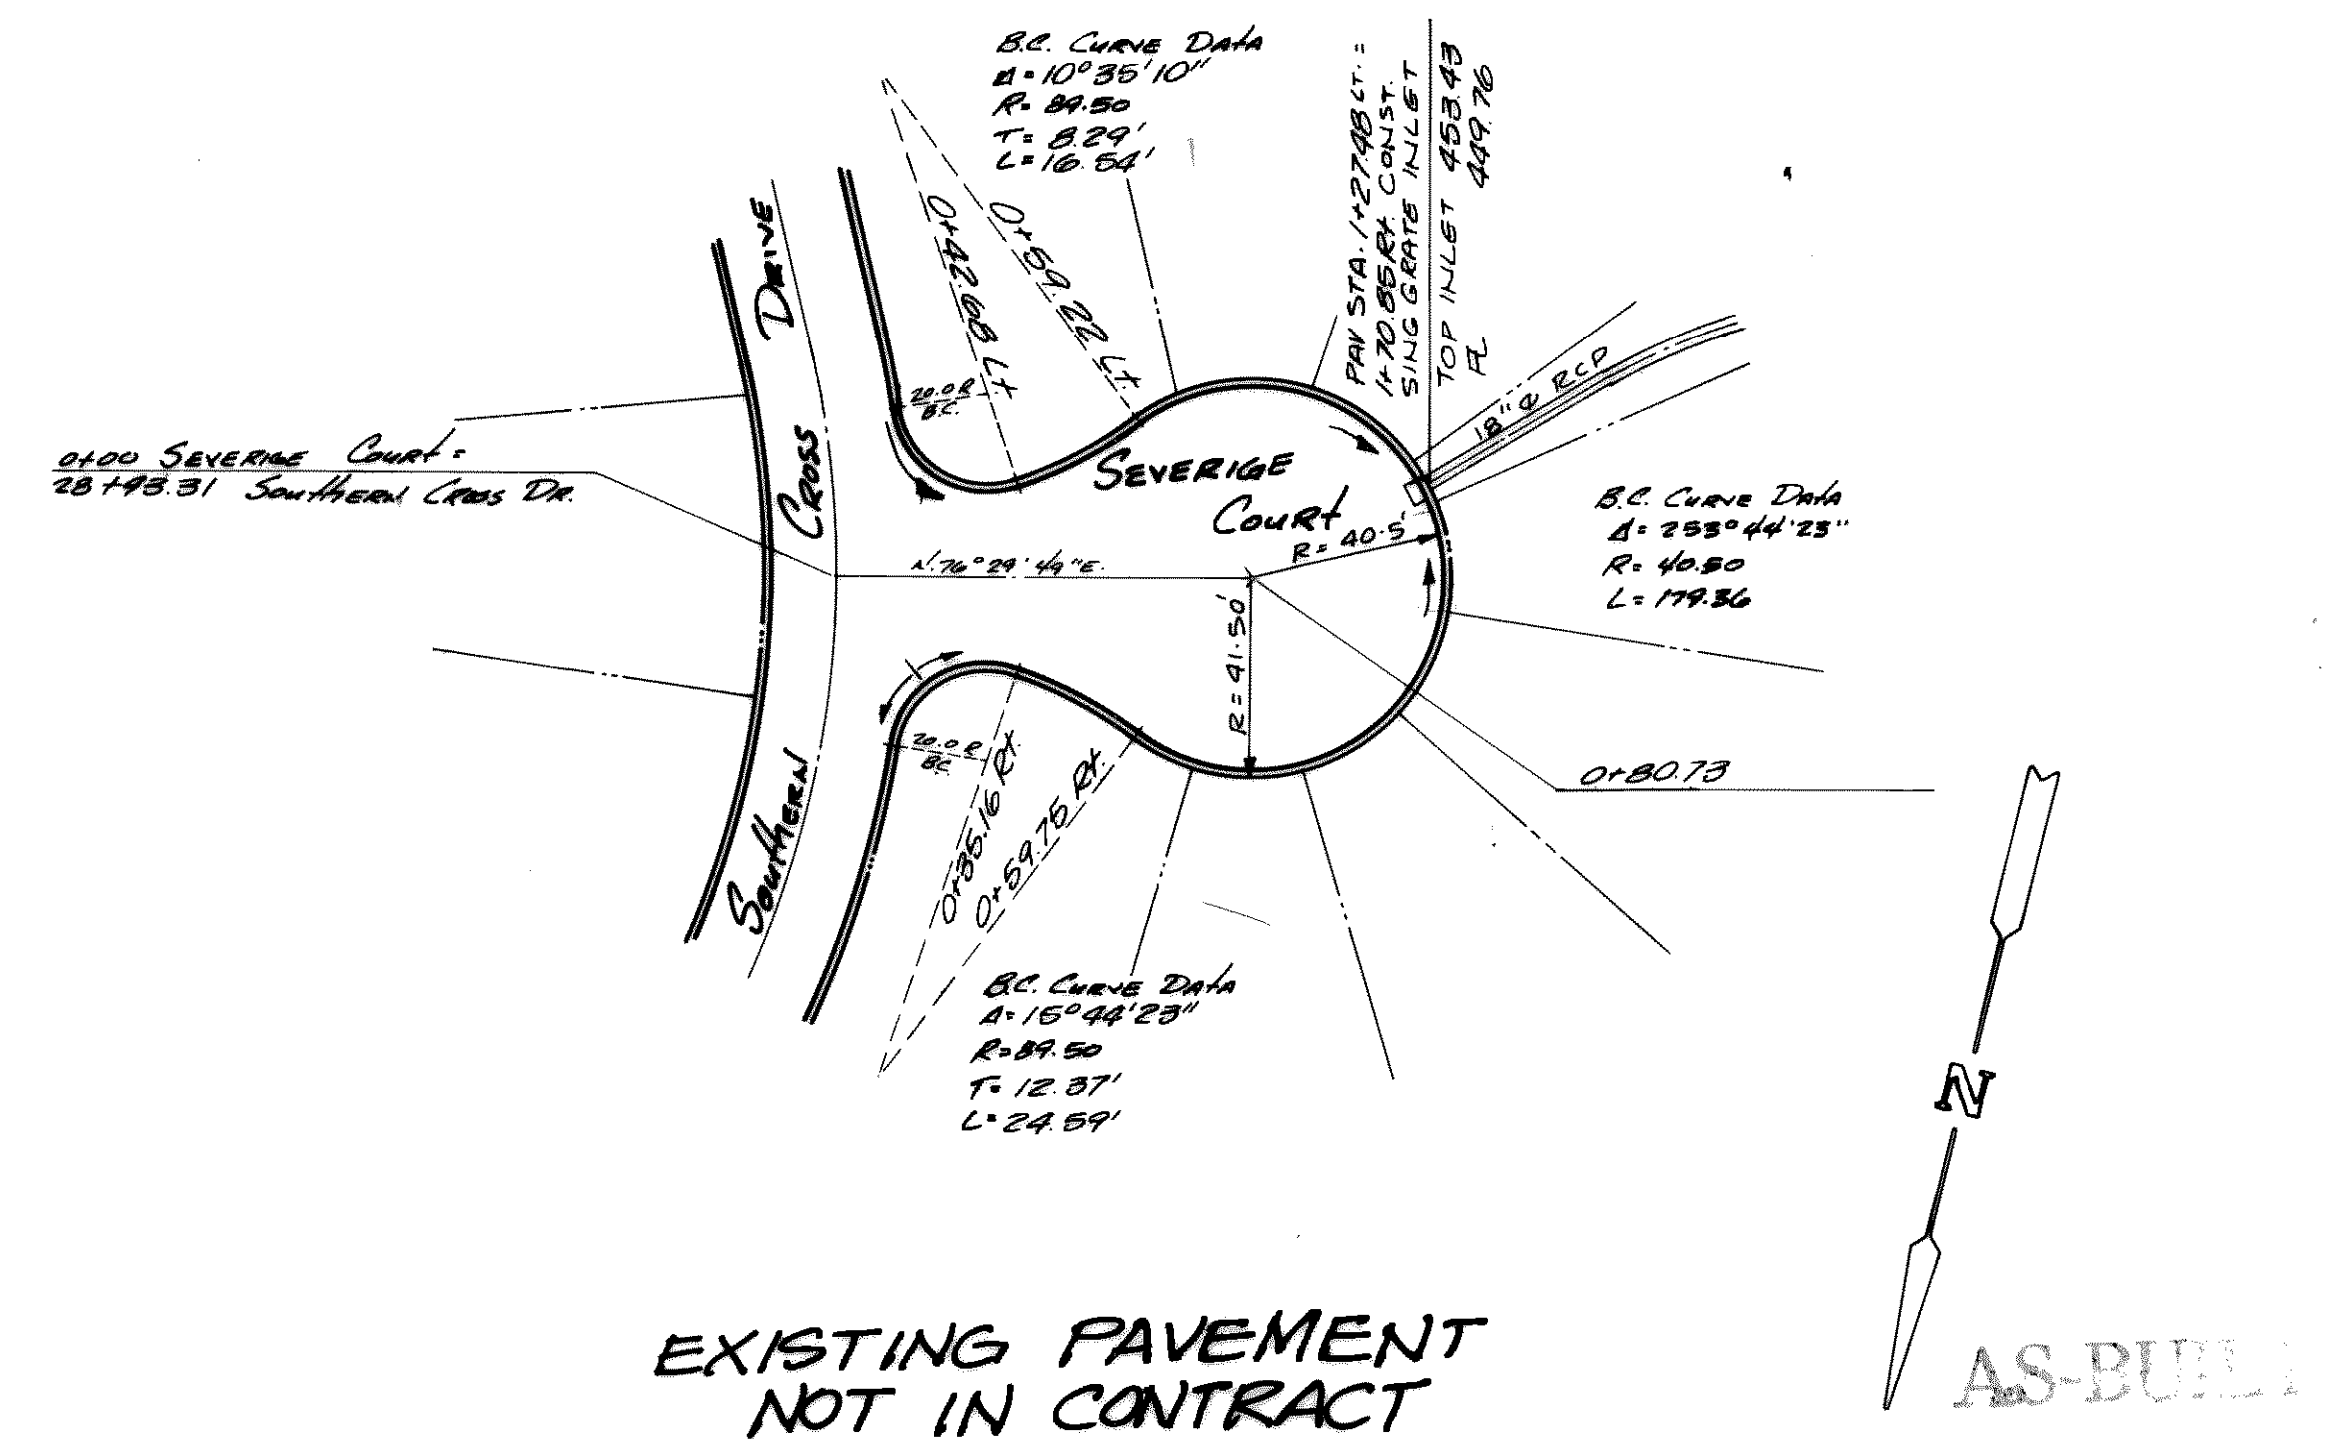


EXISTING PAVEMENT
NOT IN CONTRACT

SEVERIGE COURT

"X" cut at centerline intersection of Yacht Club Drive and Entrepid Circle
Elev. 502.53

"Square" cut on top of grate inlet halfway between Chandlers Landing Yacht Club and back-of-curb of island
Elev. 459.57

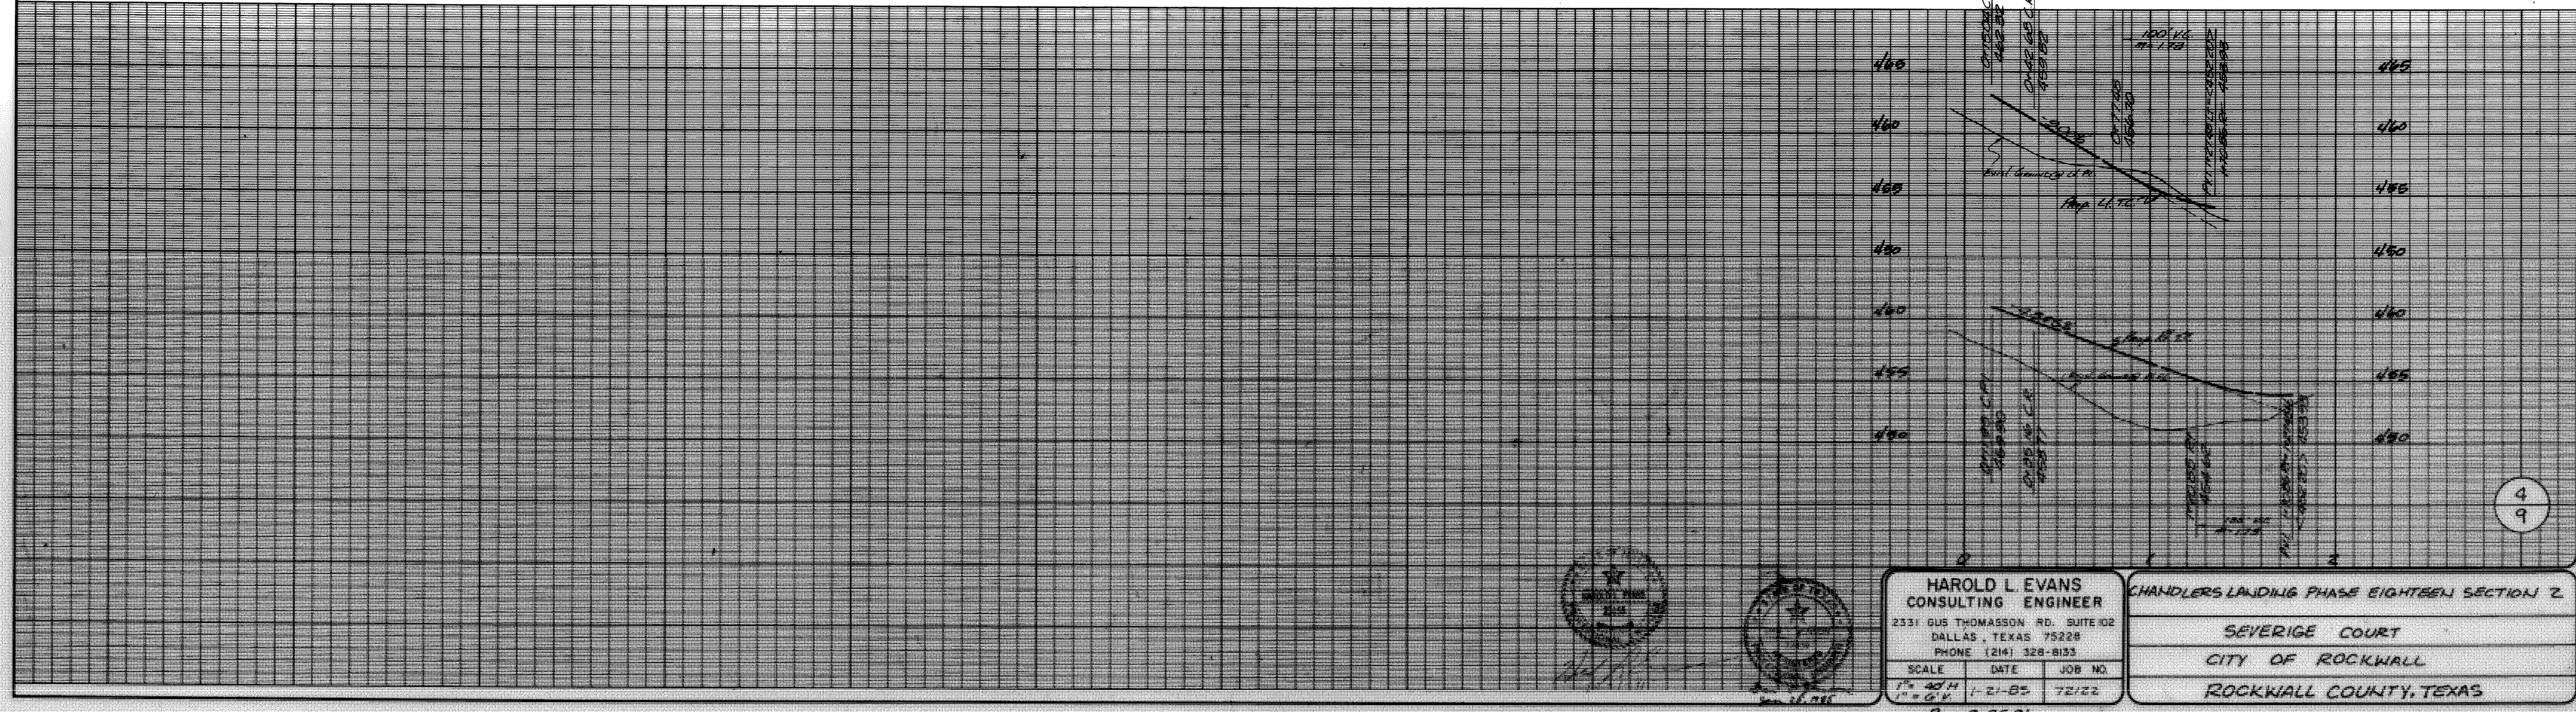

HAROLD L. EVANS CONSULTING ENGINEER 2331 SUS THOMASSON RD. SUITE 102 DALLAS, TEXAS 75228 PHONE (214) 328-8133			CHANDLERS LANDING PHASE EIGHTEEN SECTION 2 SEVERIGE COURT CITY OF ROCKWALL ROCKWALL COUNTY, TEXAS		
SCALE	DATE	JOB NO.	SCALE	DATE	JOB NO.
1" = 40' H 1" = 60' V	12-82	72/22	1" = 40' H 1" = 60' V	12-82	72/22

Rev 9-25-91