


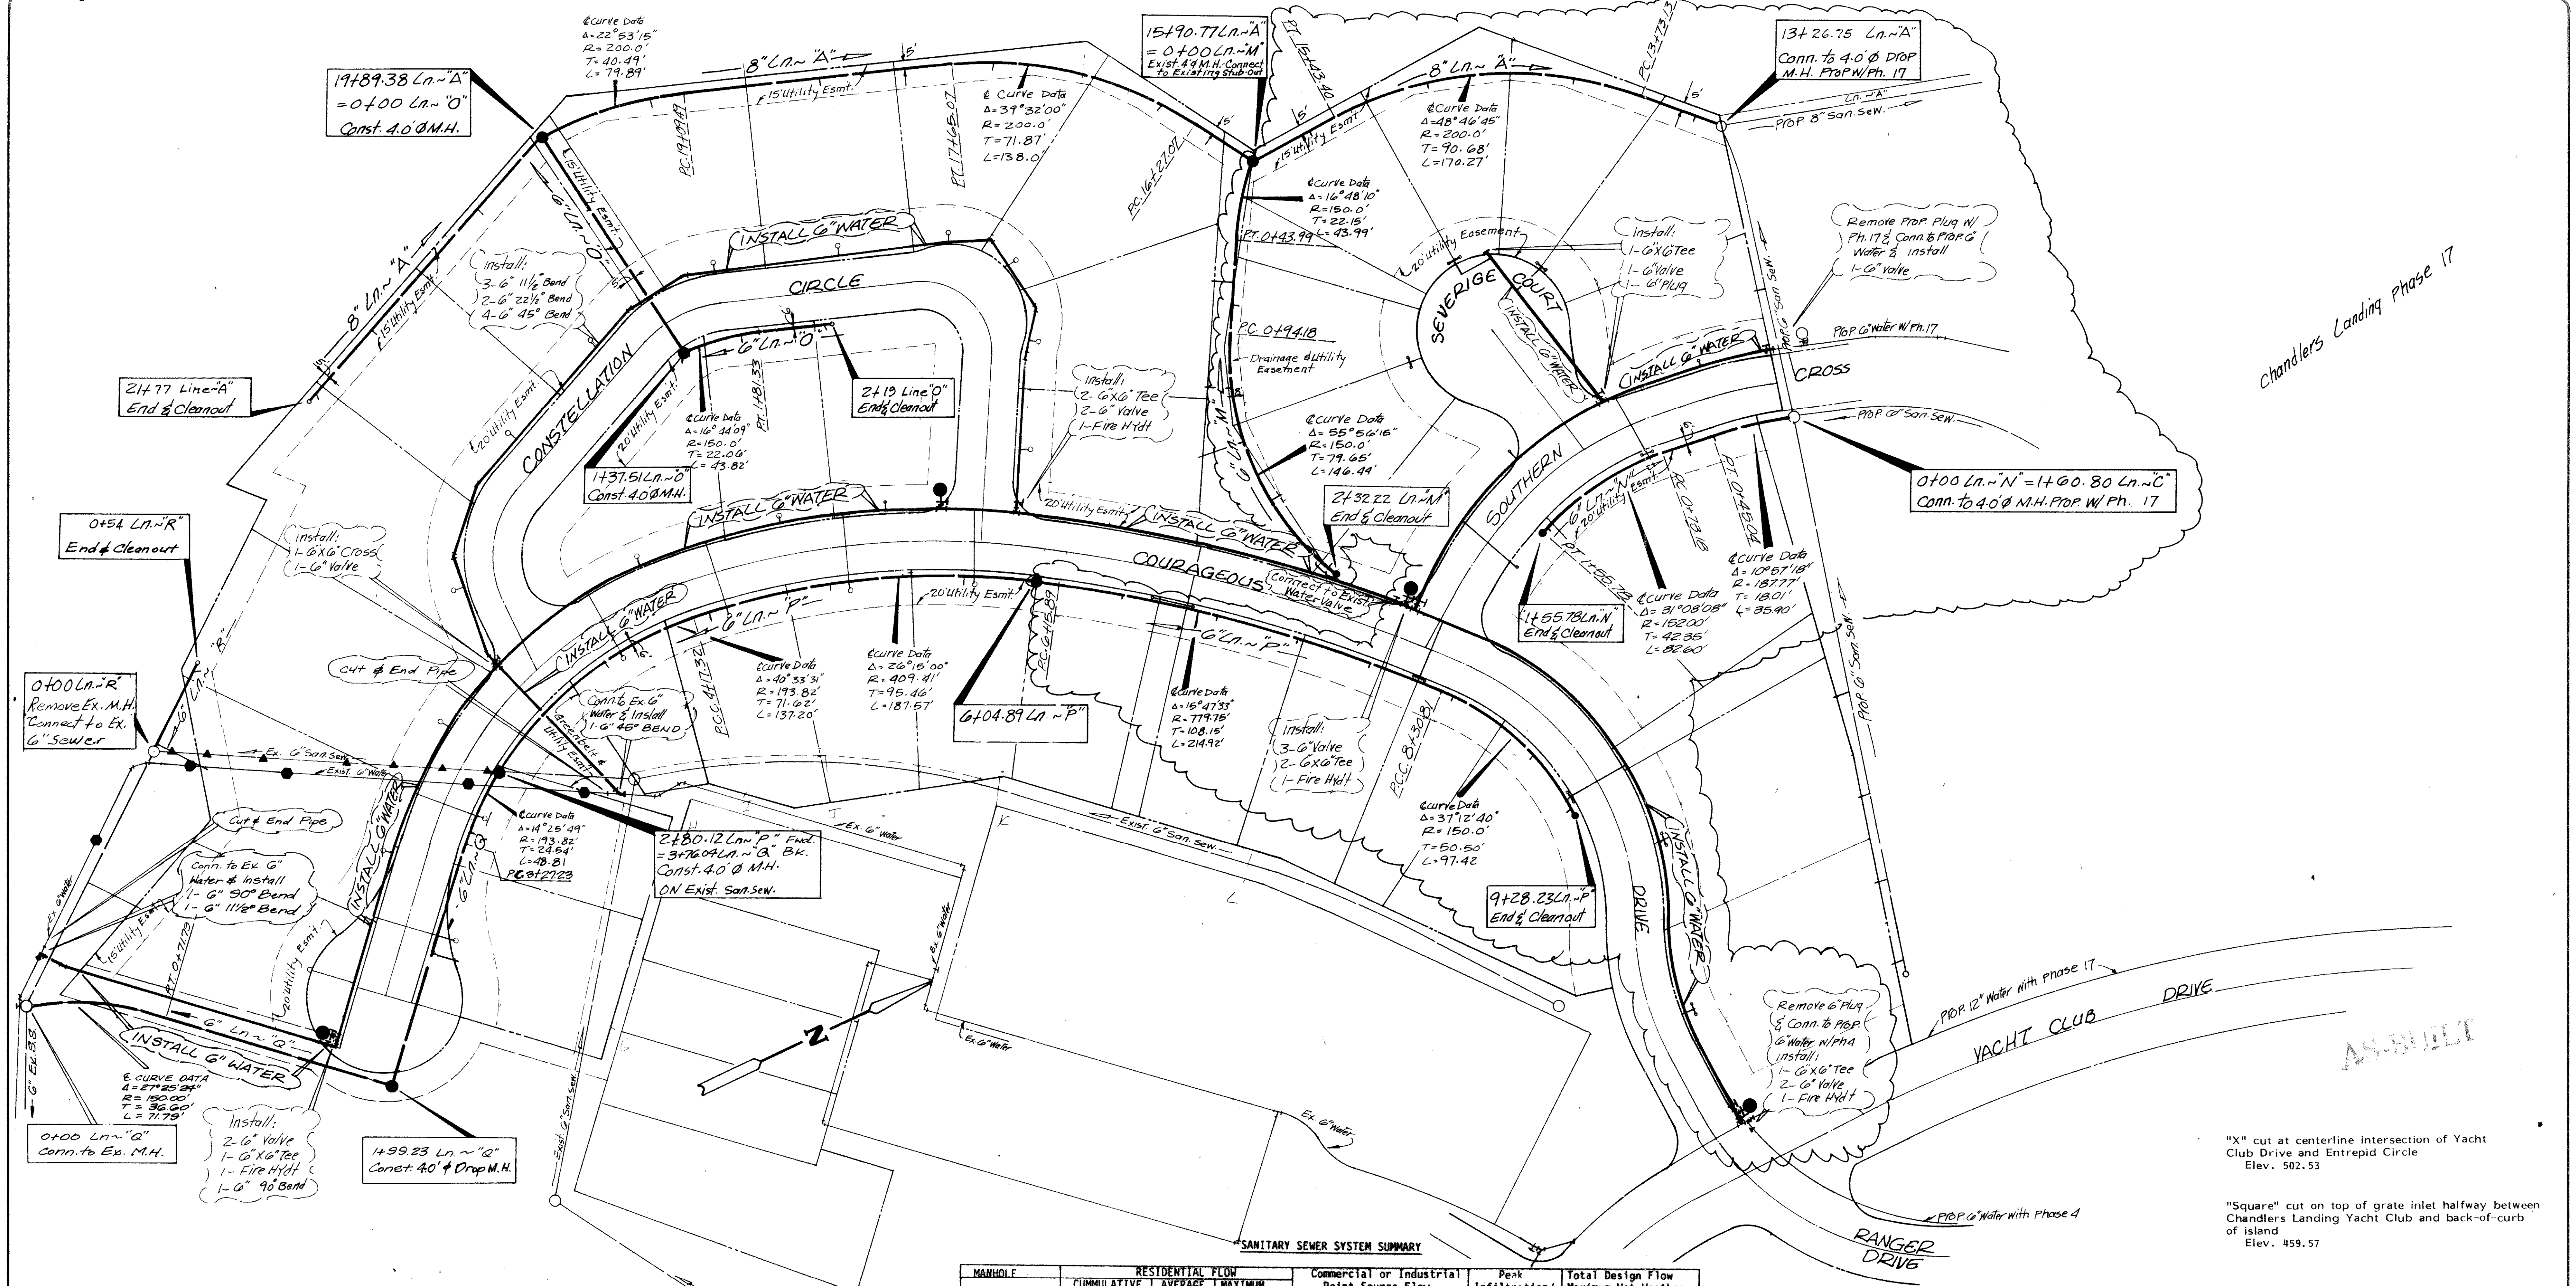

NOTE:
 ▲▲ Exist. San. Sew. Line will be ABANDON & Fill w/Conc. Under Future Const.
 ●● Exist. 6" Water Line will be ABANDON


NOTE:
 UTILITIES WITHIN CLOUD ARE
 EXISTING & NOT IN CONTRACT

AS BUILT

HAROLD L. EVANS
 CONSULTING ENGINEER
 2331 GUS THOMASSON RD. SUITE 102
 DALLAS, TEXAS 75228
 PHONE (214) 328-8133

SCALE 1"=40'
 DATE 1-25-85
 JOB NO. 72122

WATER & SANITARY SEWER
 CHANDLERS LANDING PH. 18 SECTION 2
 CITY OF ROCKWALL
 ROCKWALL COUNTY, TEXAS

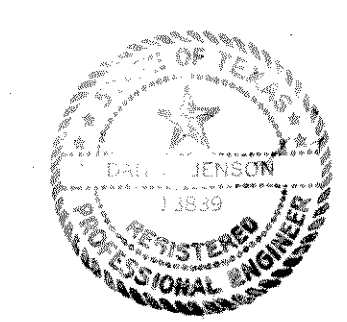

Don C. Jackson
 Jan. 25, 1985

REV: LINES "P, Q & R"
 11-10-86

Revised Lines "A", "M", "O", "R"
 & Revised lots & Services
 Chart 1-26-86

Rev. 3/12/85 Rev. 9-25-91