


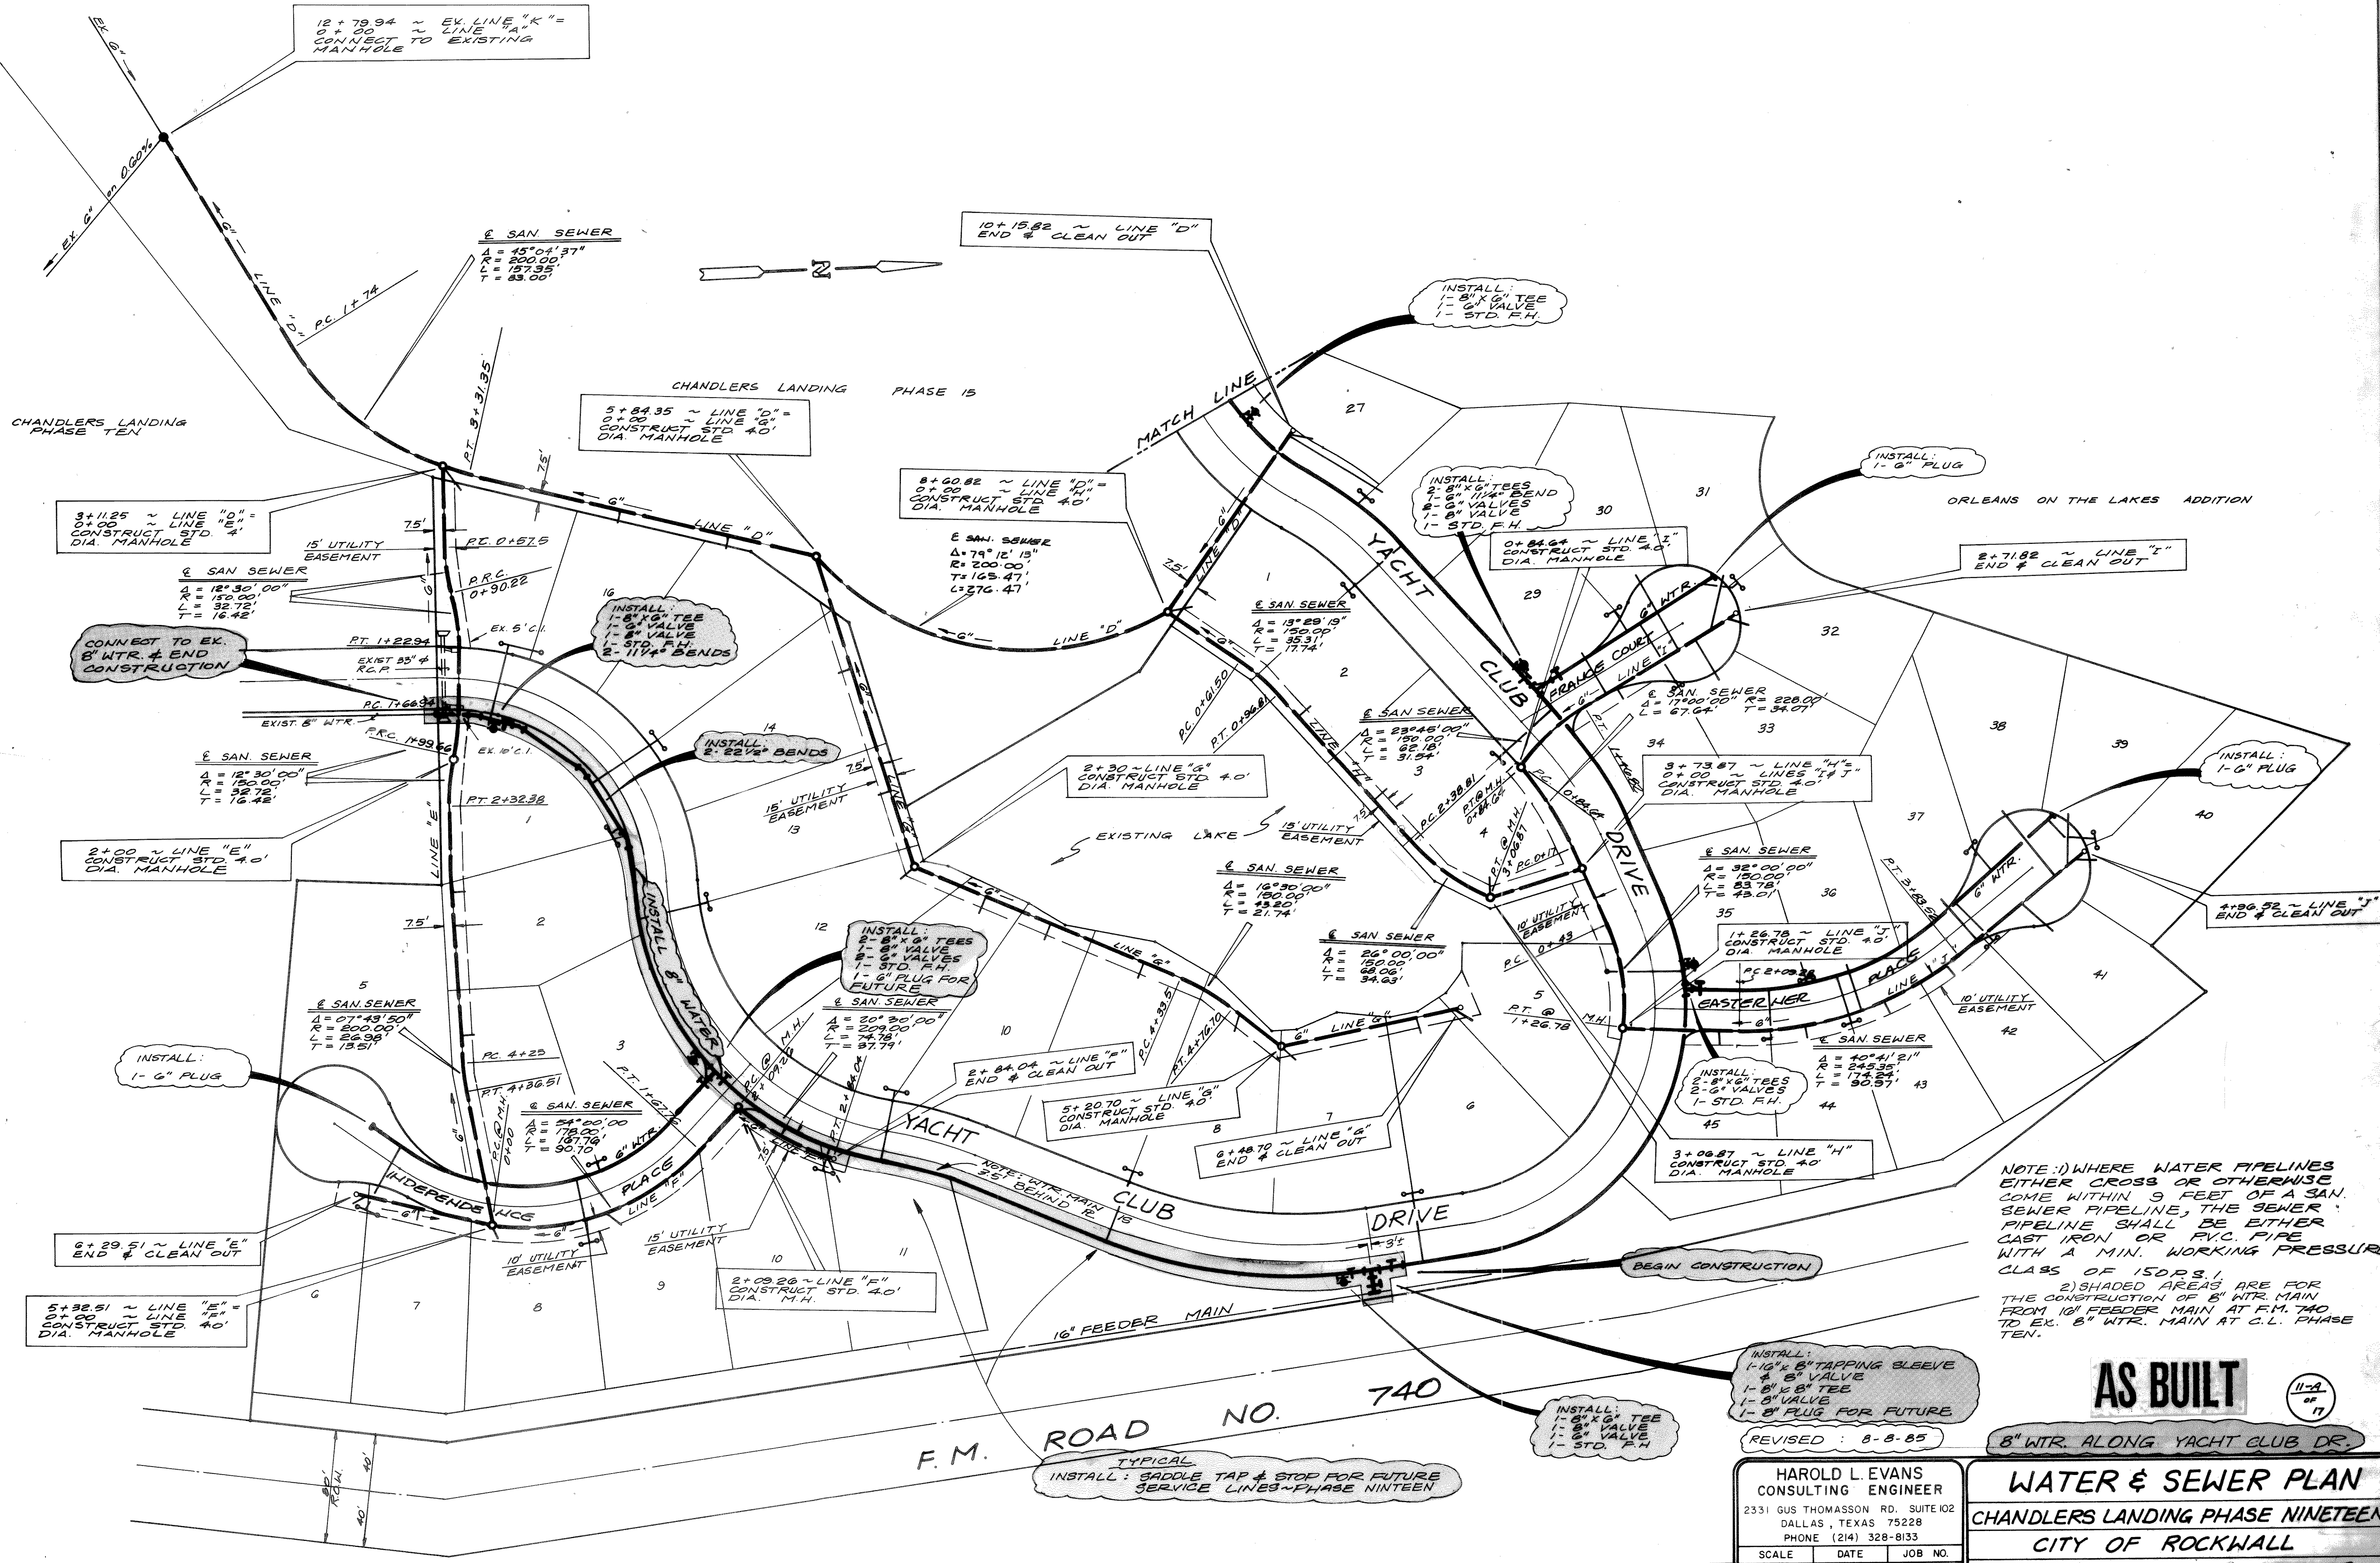

AS BUILT

WATER & SEWER PLAN
CHANDLER'S LANDING PHASE NINETEEN
CITY OF ROCKWALL
ROCKWALL COUNTY, TEXAS

HAROLD L. EVANS
CONSULTING ENGINEER
2331 GUS THOMASSON RD., SUITE 102
DALLAS, TEXAS 75228
PHONE (214) 328-8133

SCALE	DATE	JOB NO.
1"=50'	6-28-85	72122

REVISED FOR CONST. OF 8" WTR. MAIN 6-12-86

TYPICAL
INSTALL: GADGET TAP & STOP FOR FUTURE
SERVICE LINES- PHASE NINETEEN

INSTALL:
1- 10" x 8" TAPPING BLEED
& 8" VALVE
1- 8" x 8" TEE
1- 8" VALVE
1- 8" PLUG FOR FUTURE

REVISED: 8-8-85

8" WTR. ALONG YACHT CLUB DR.