
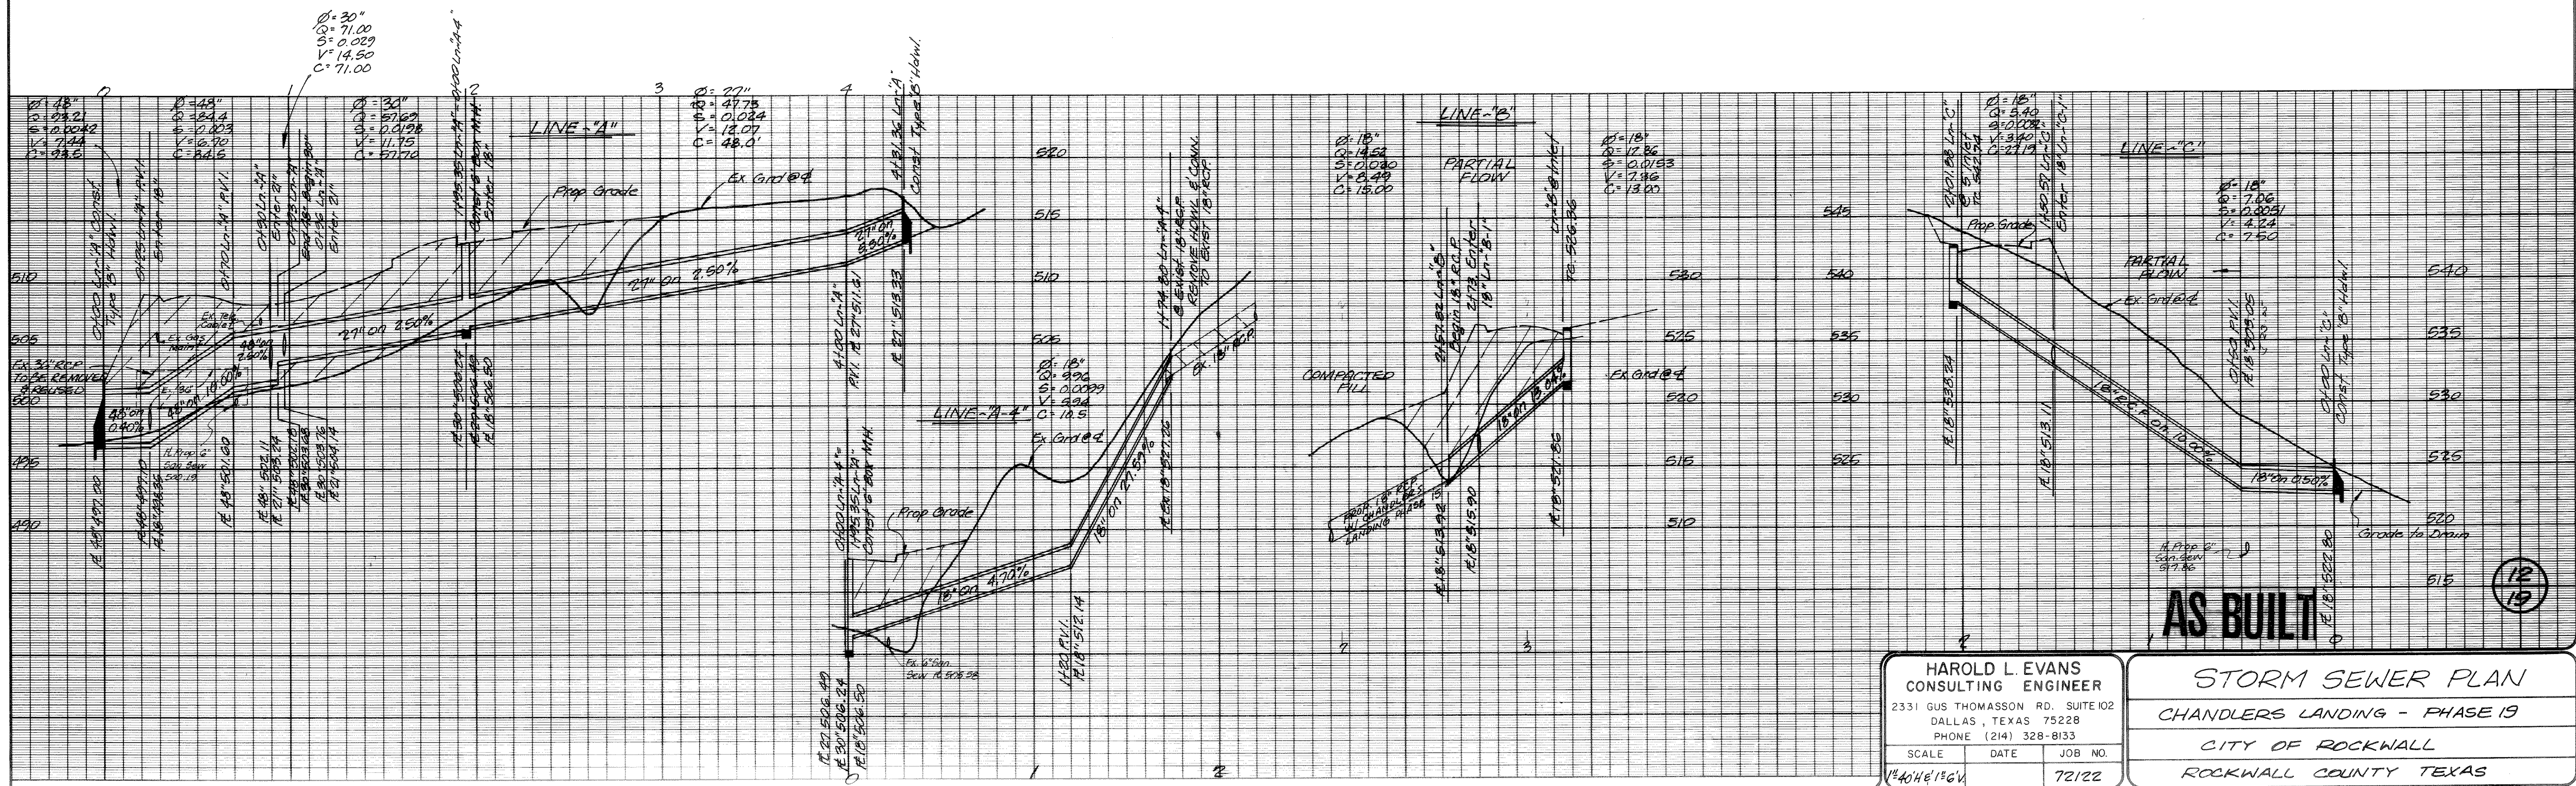
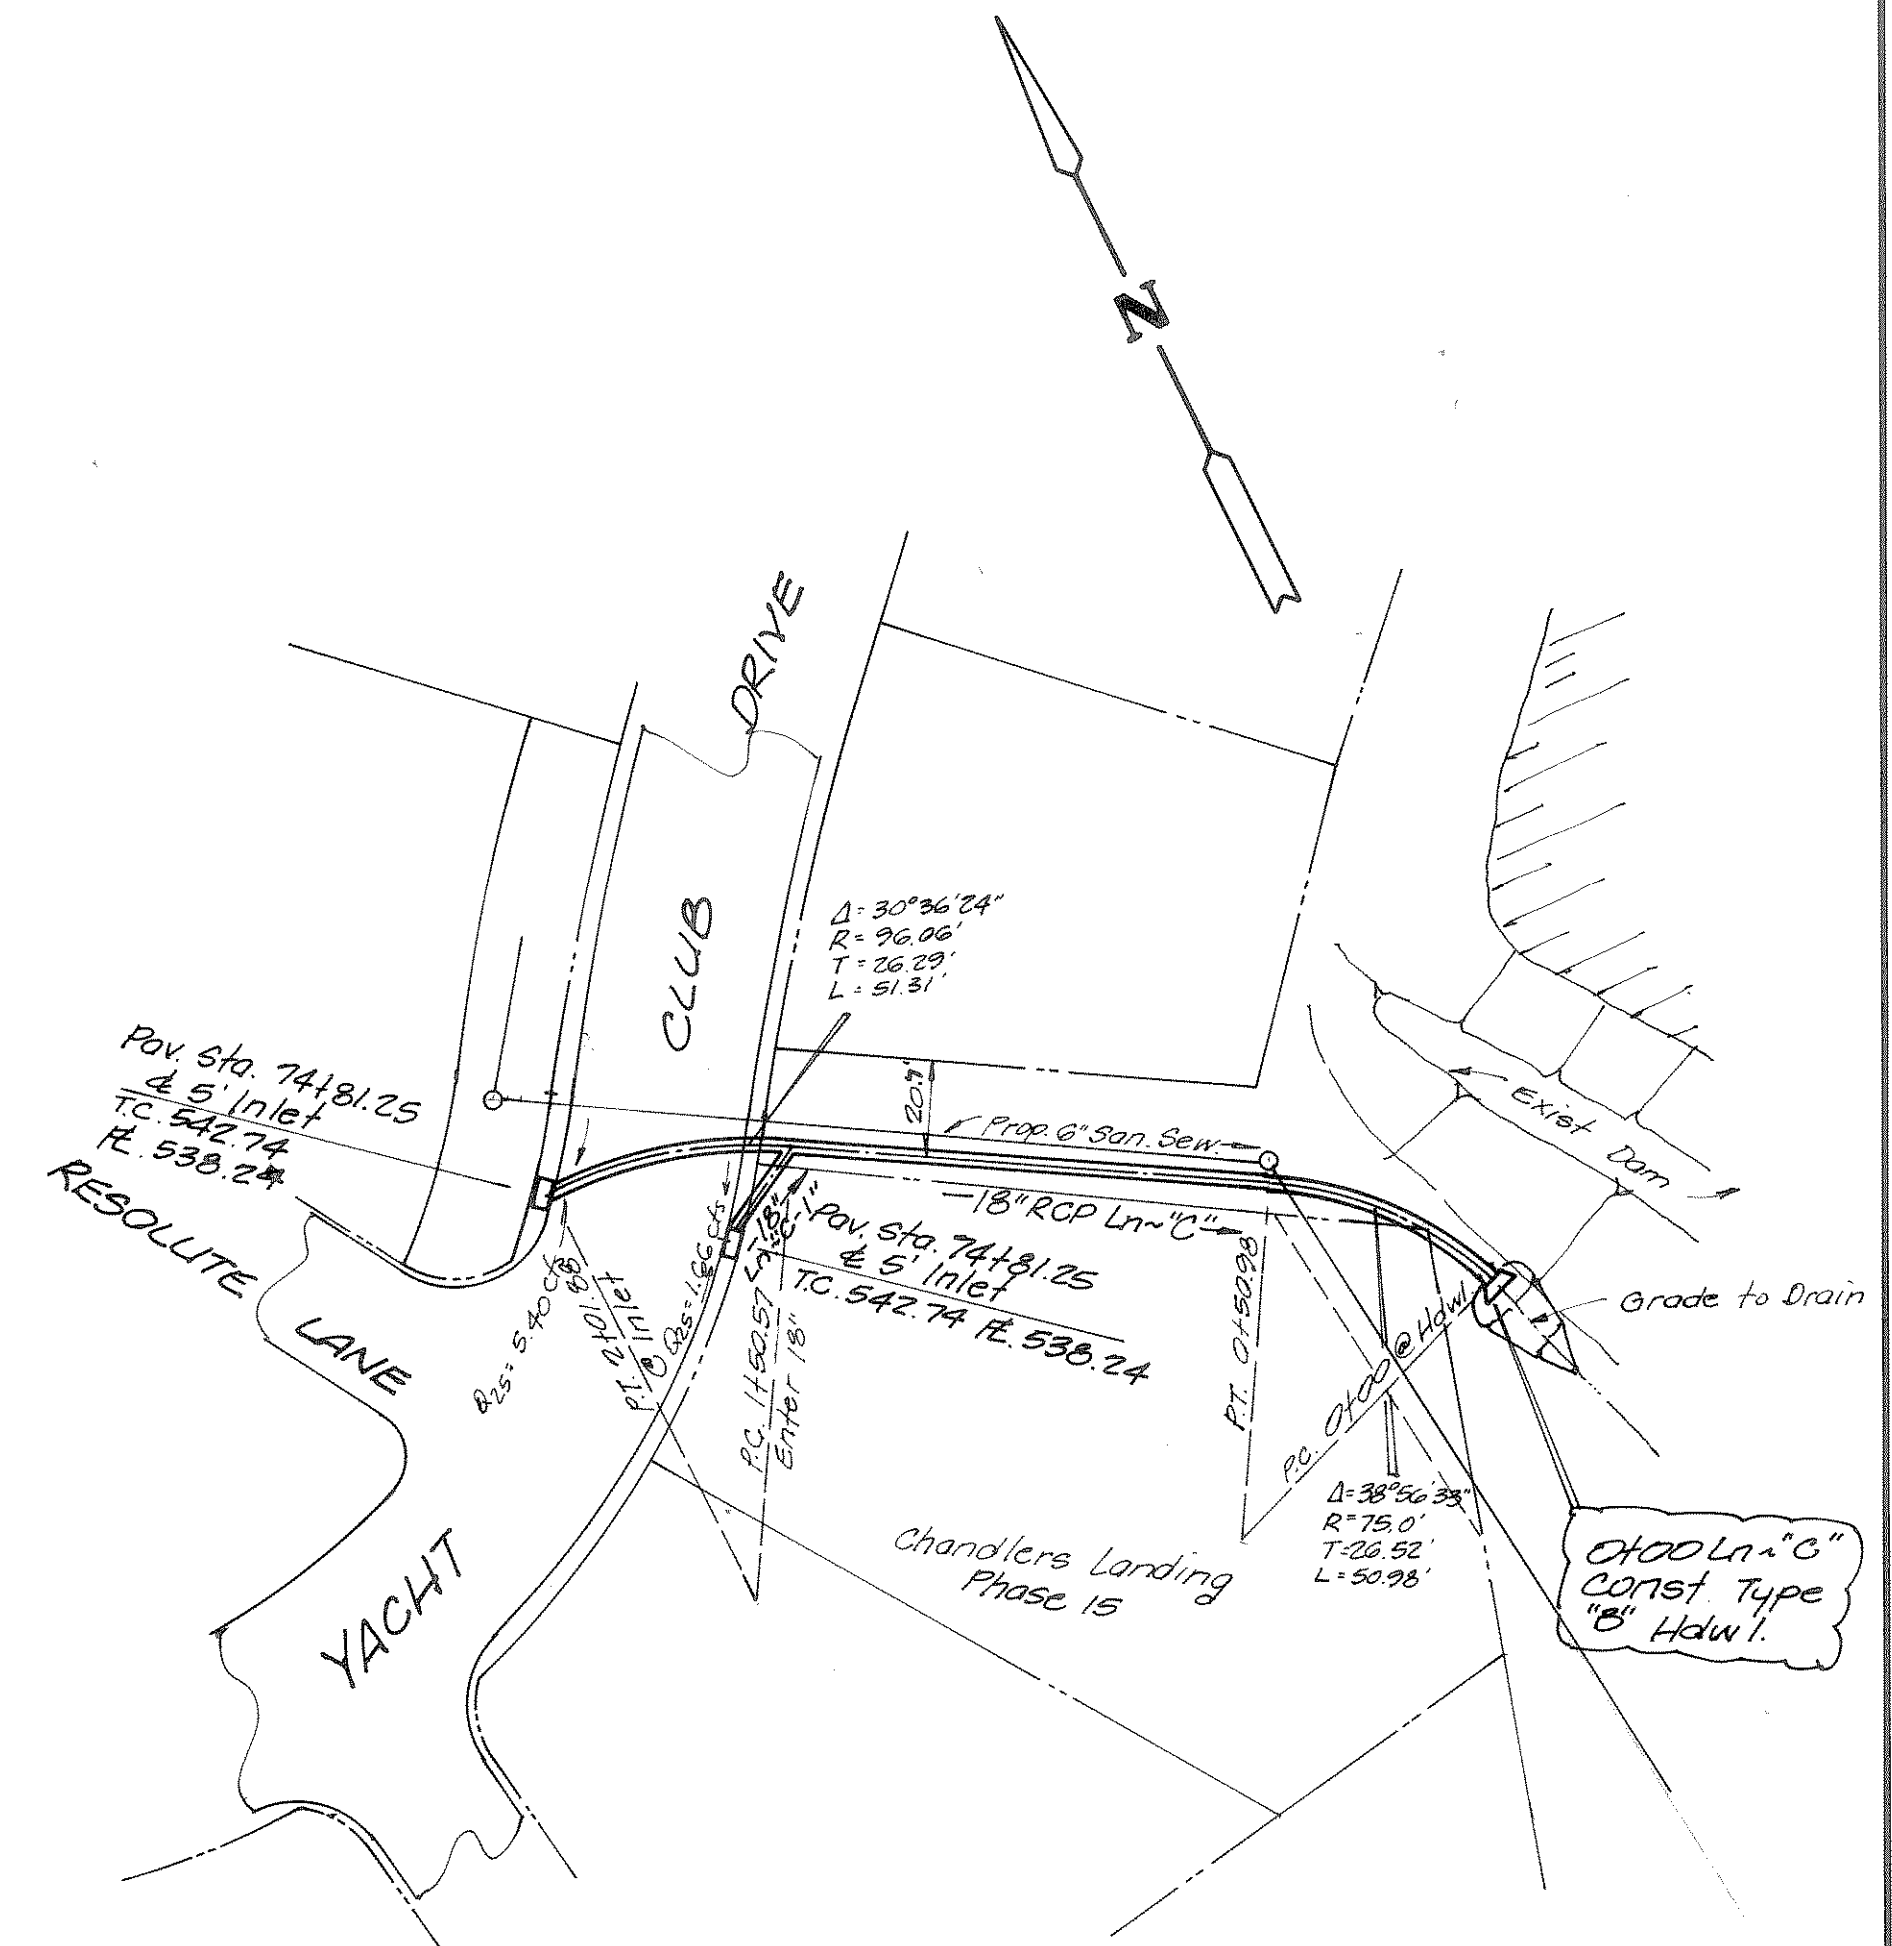
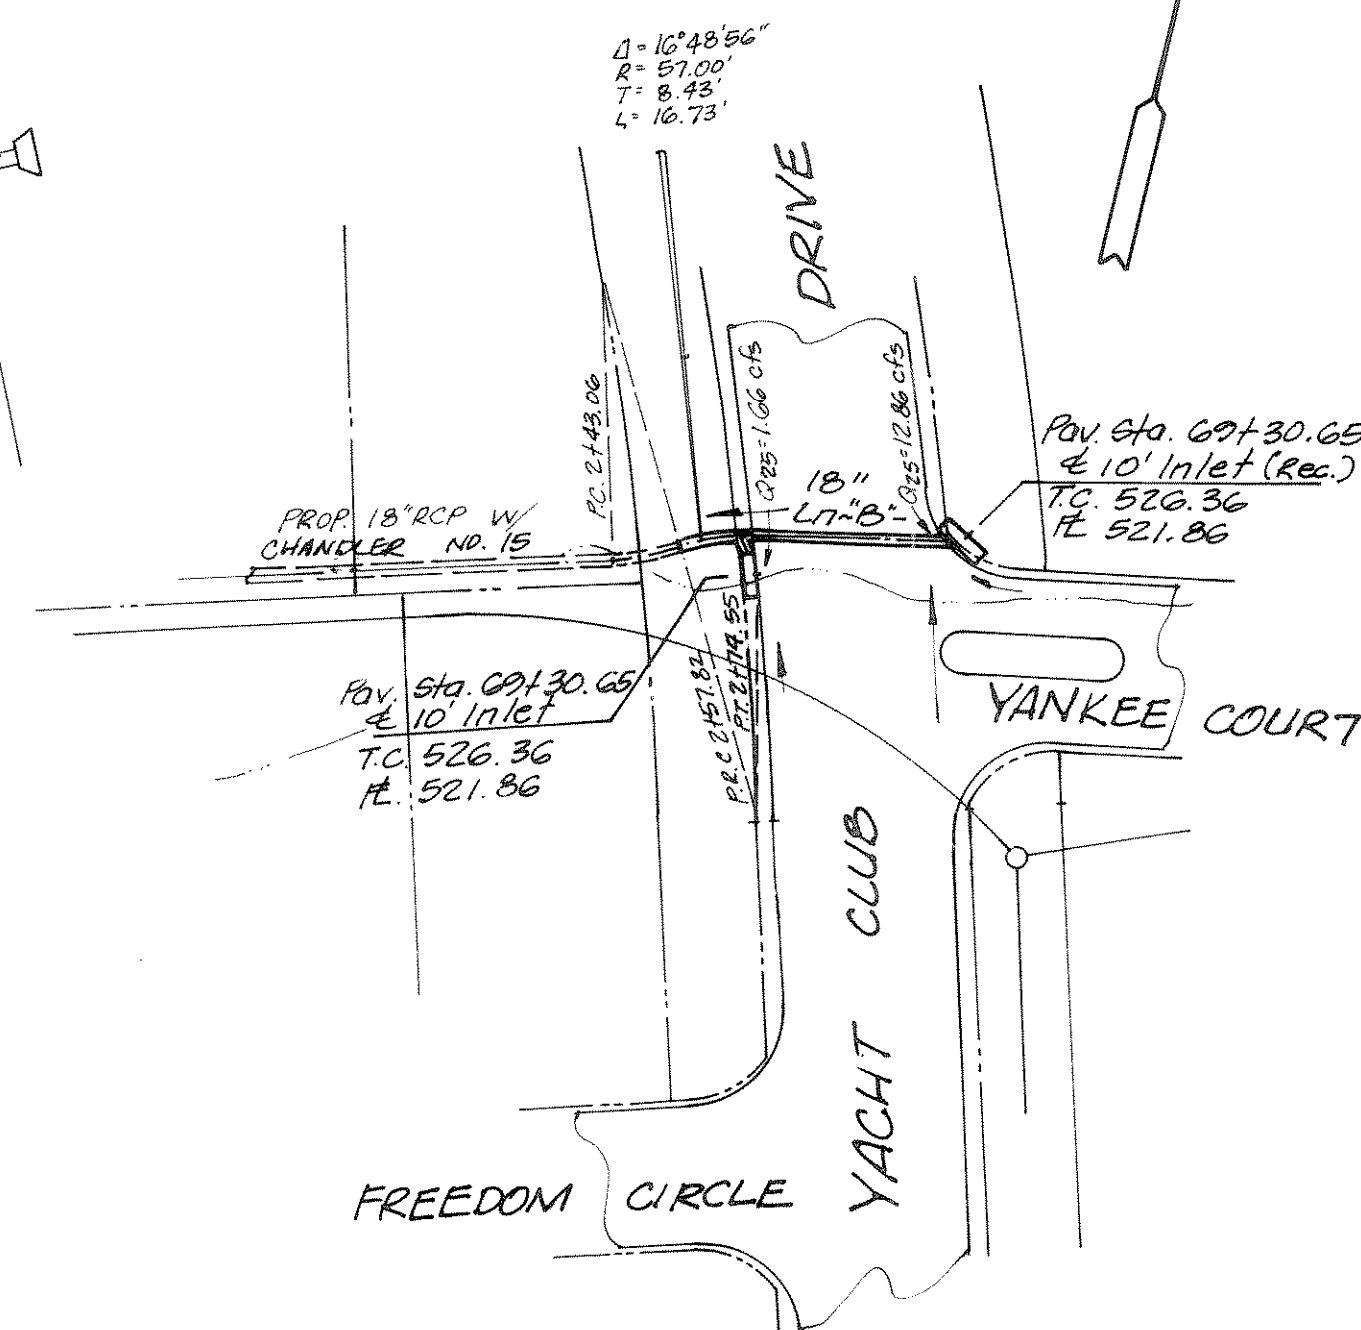


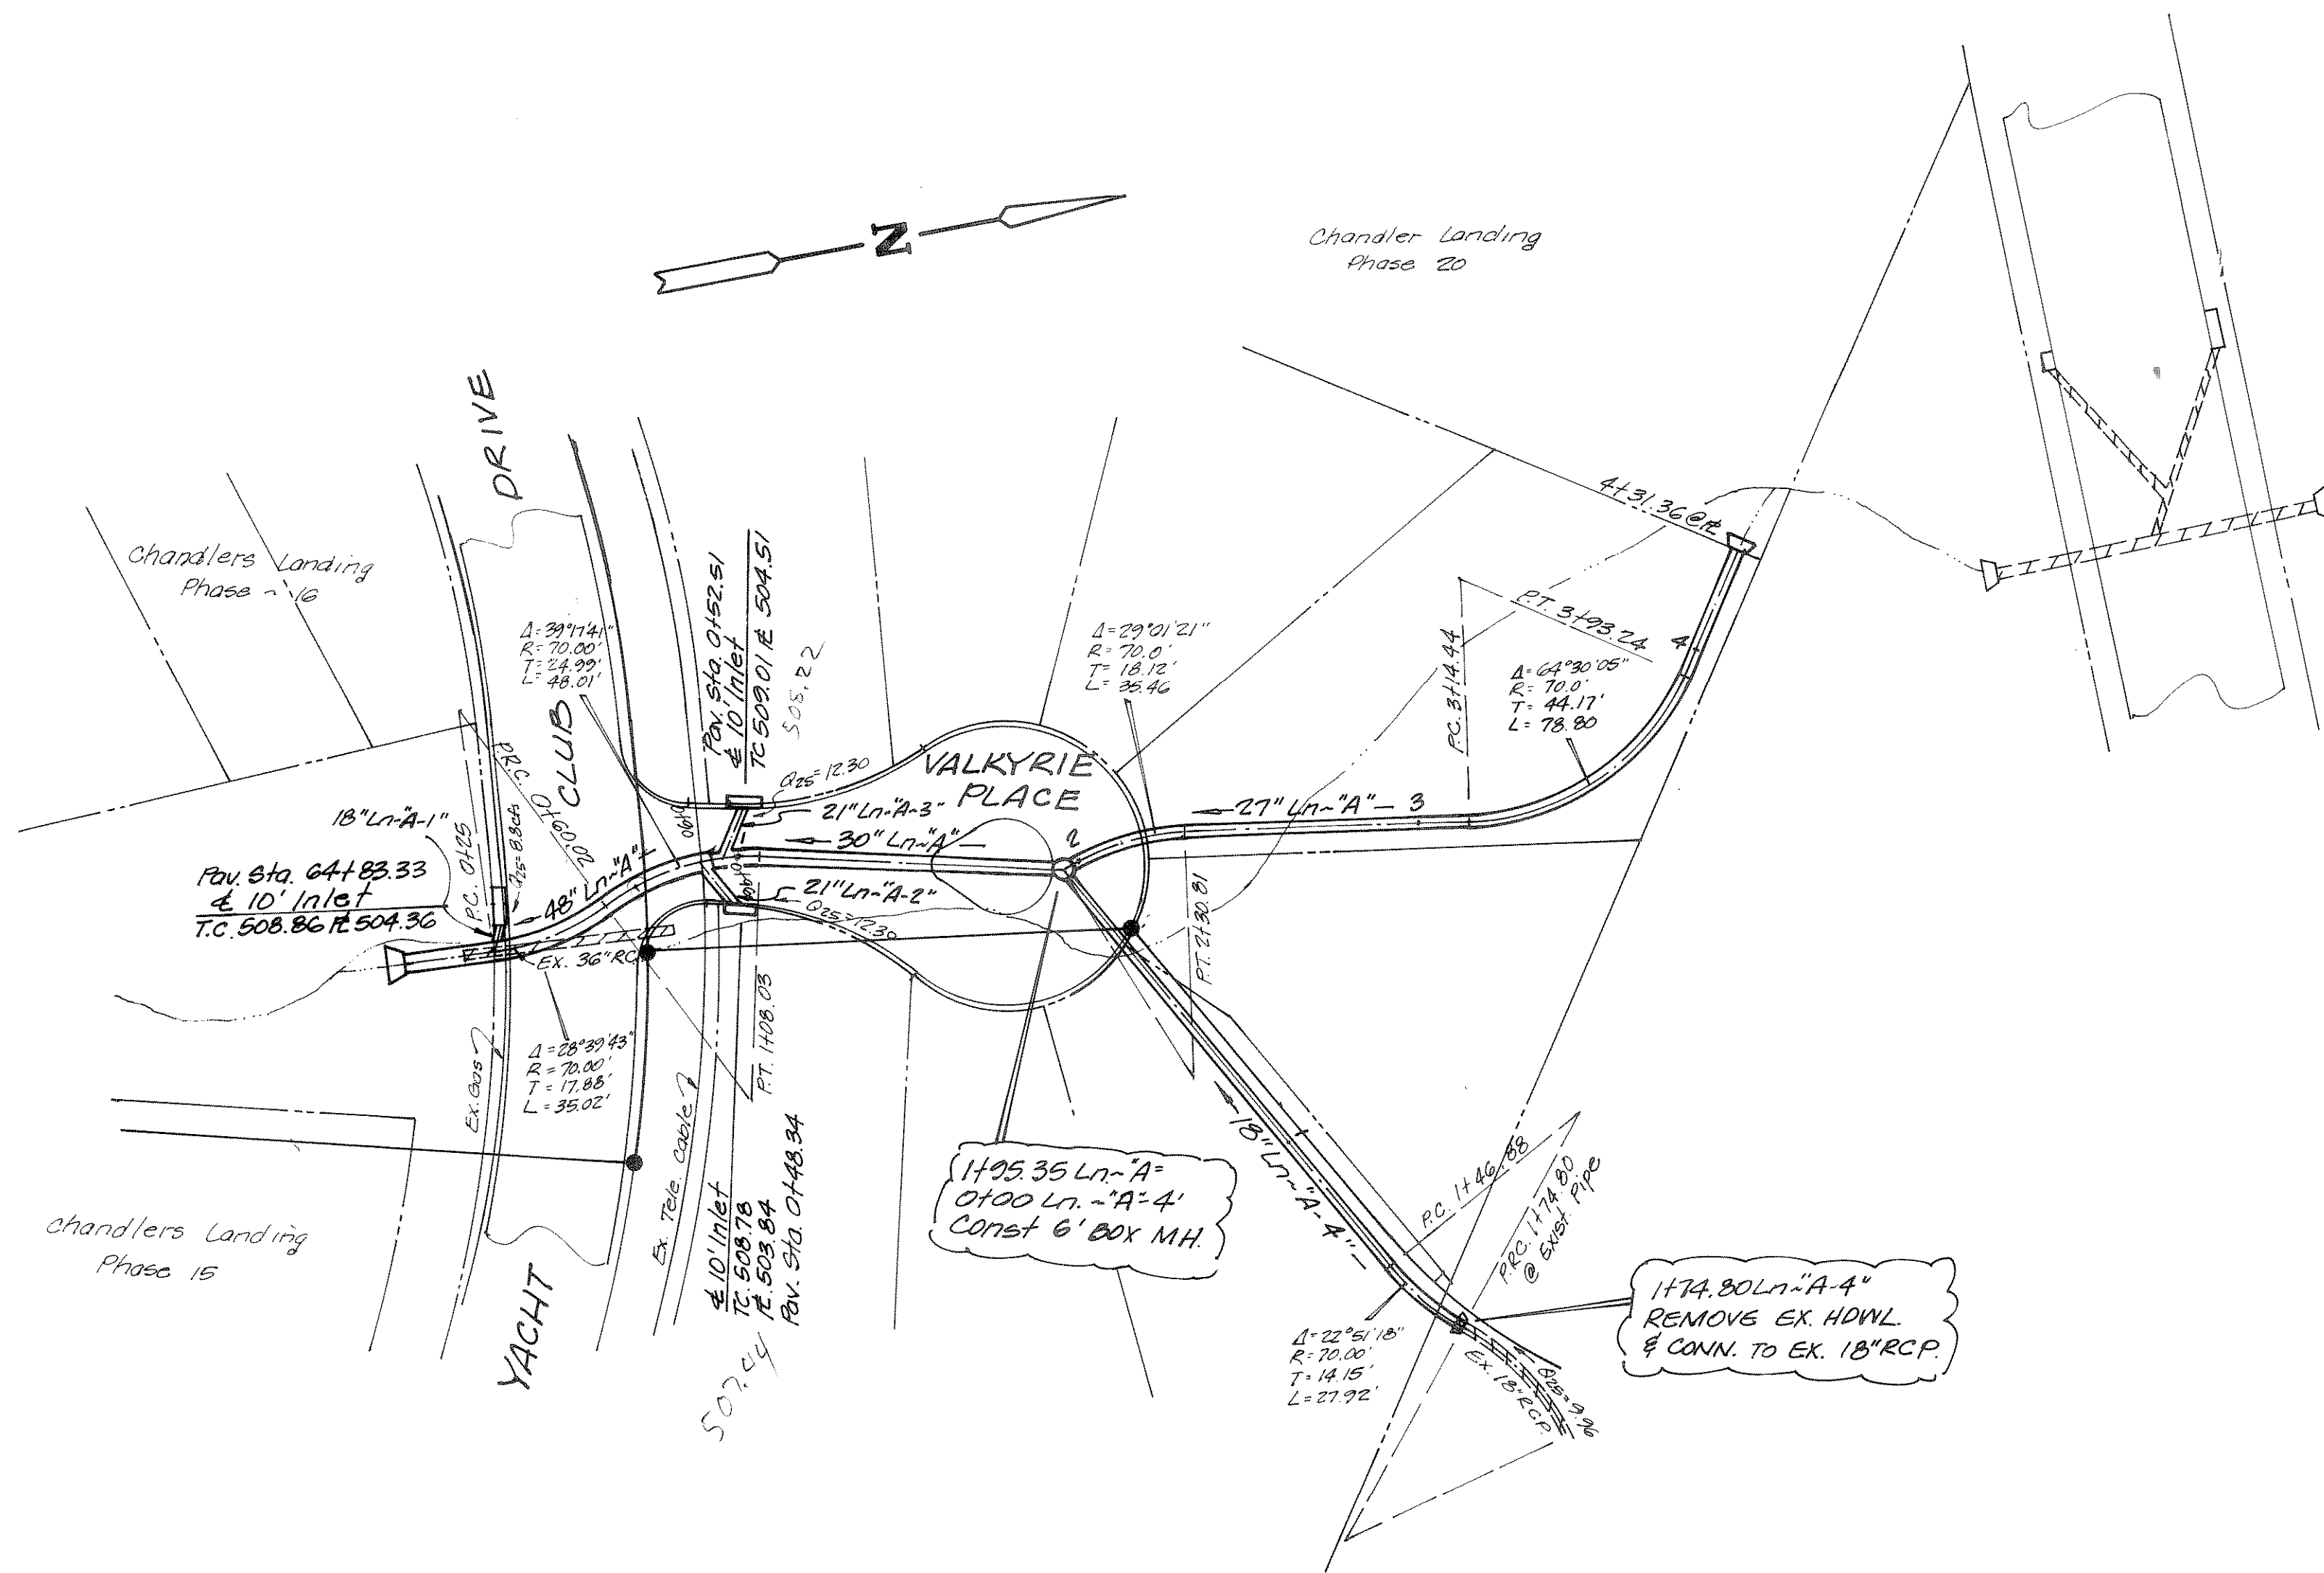

HAROLD L. EVANS
CONSULTING ENGINEER
2331 GUS THOMASSON RD., SUITE 102
DALLAS, TEXAS 75228
PHONE (214) 328-8133

STORM SEWER PLAN
CHANDLERS LANDING - PHASE 19
CITY OF ROCKWALL
ROCKWALL COUNTY TEXAS

SCALE DATE JOB NO.
1"=40' H & 1"=6' V 7/21/22