
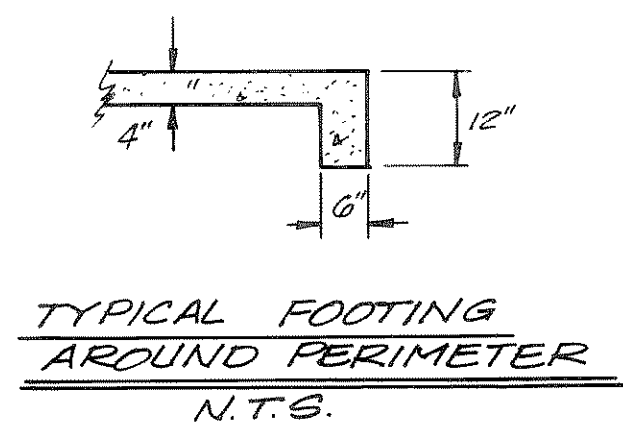
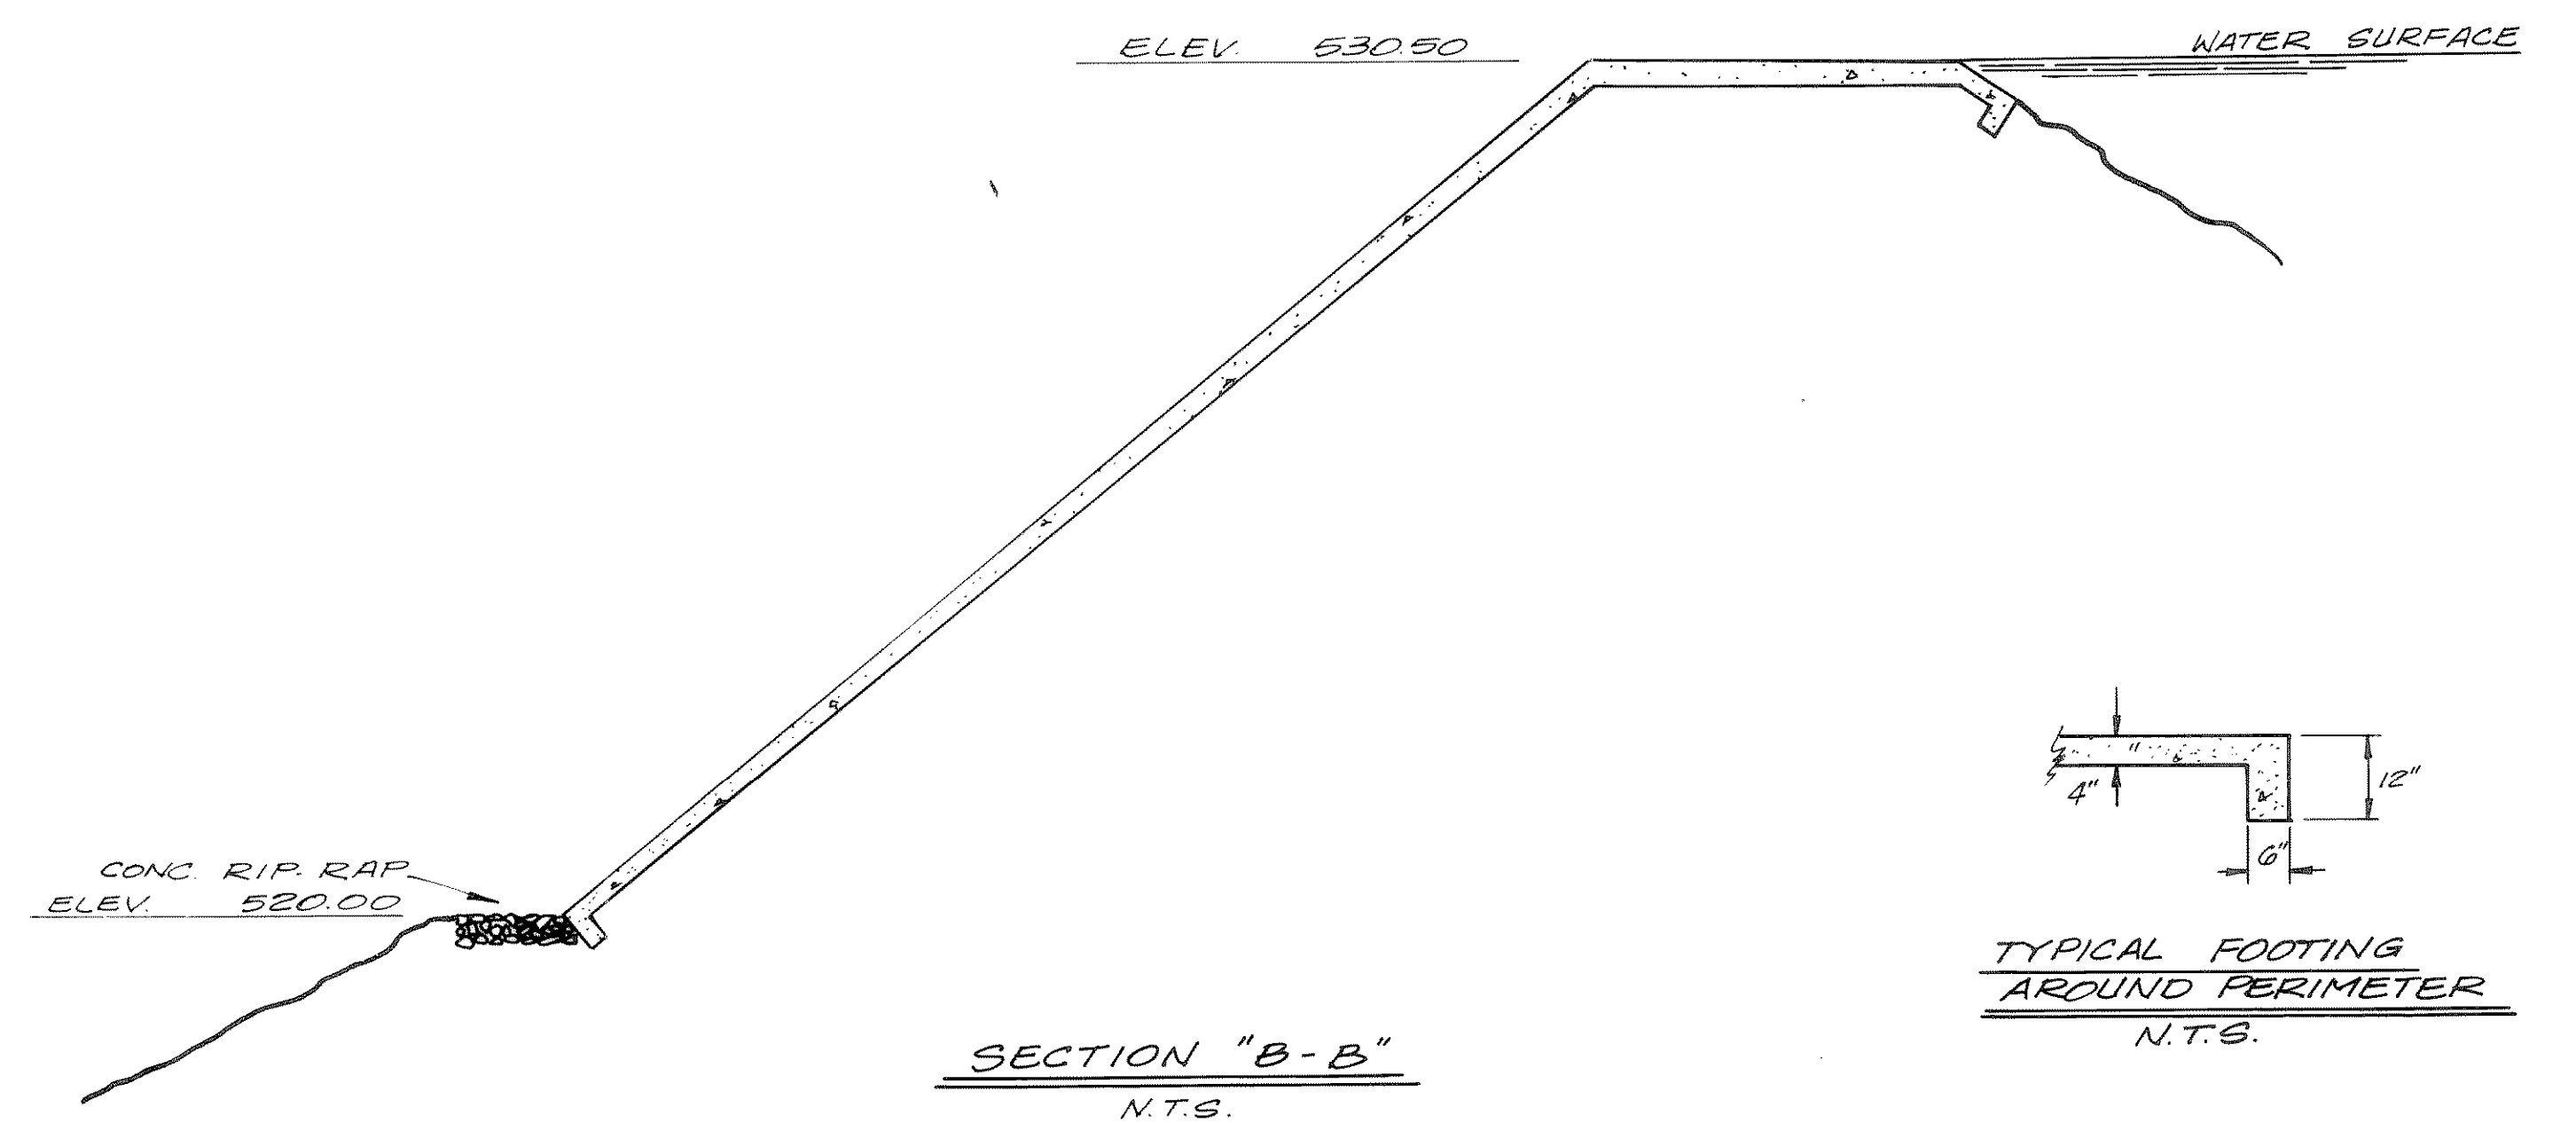
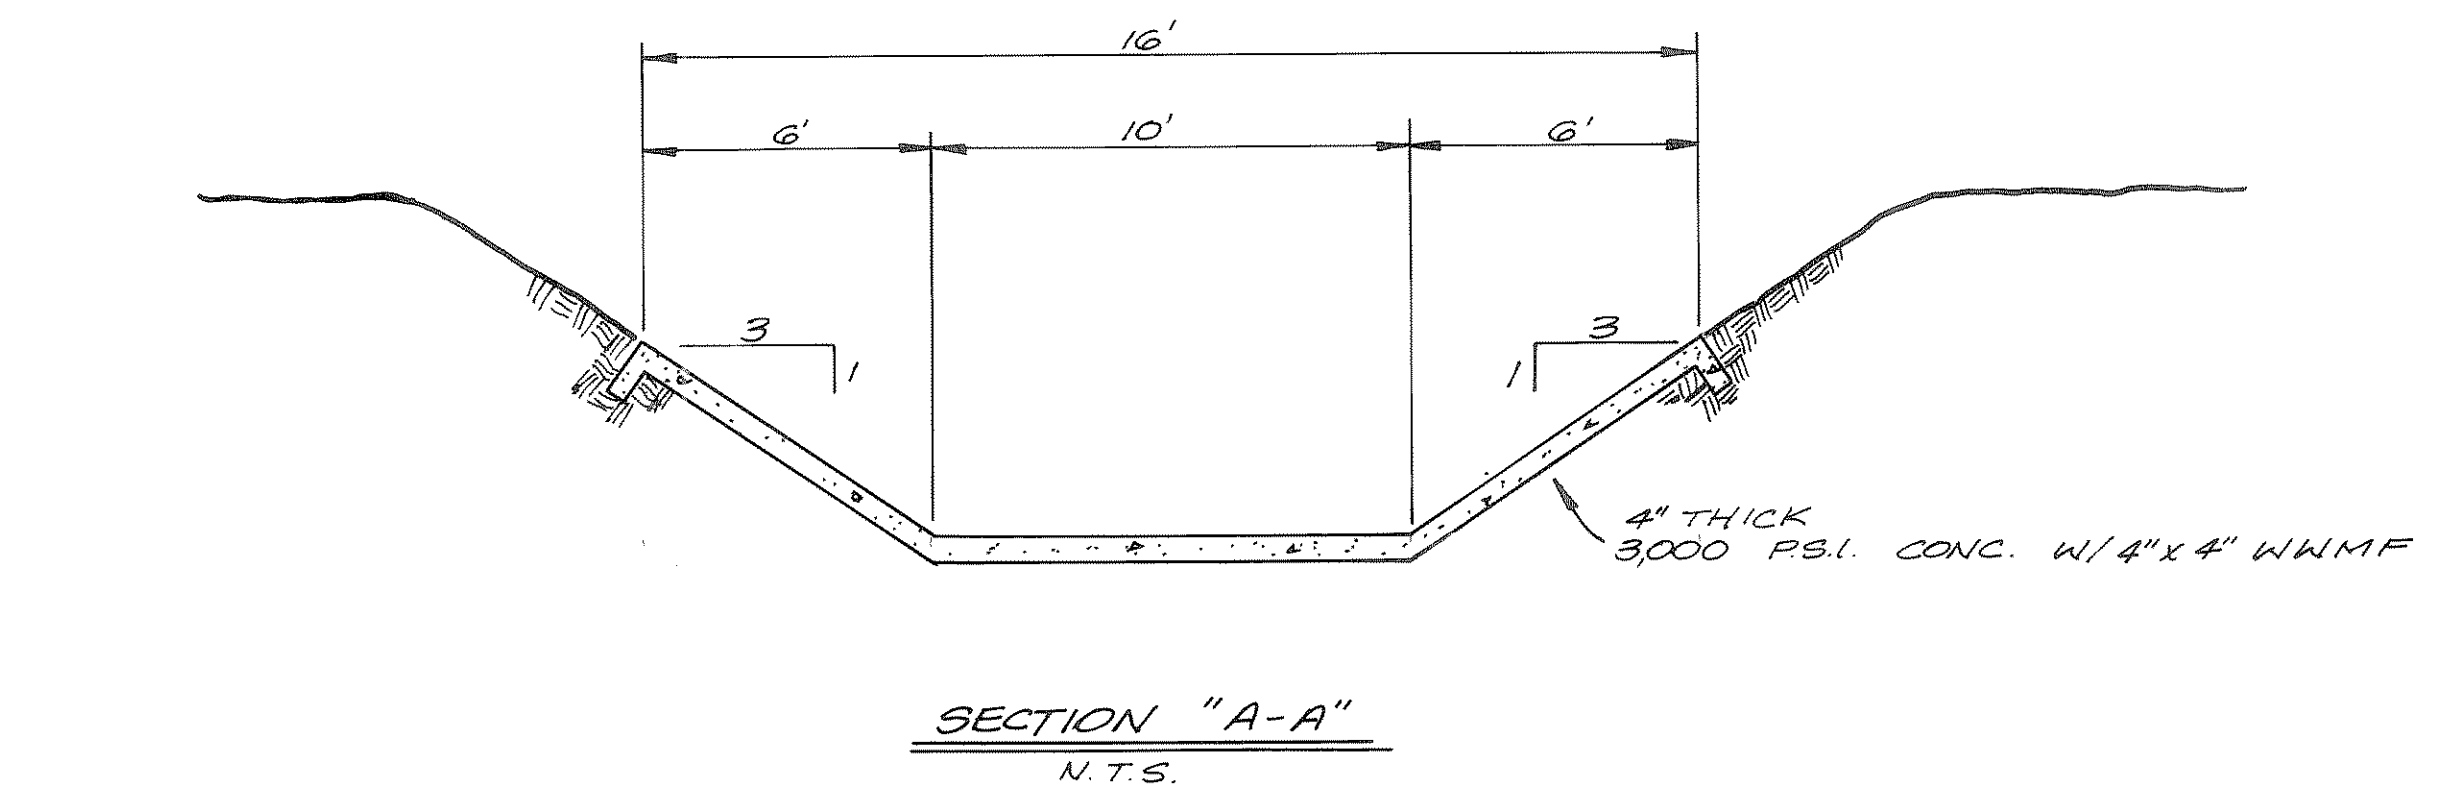


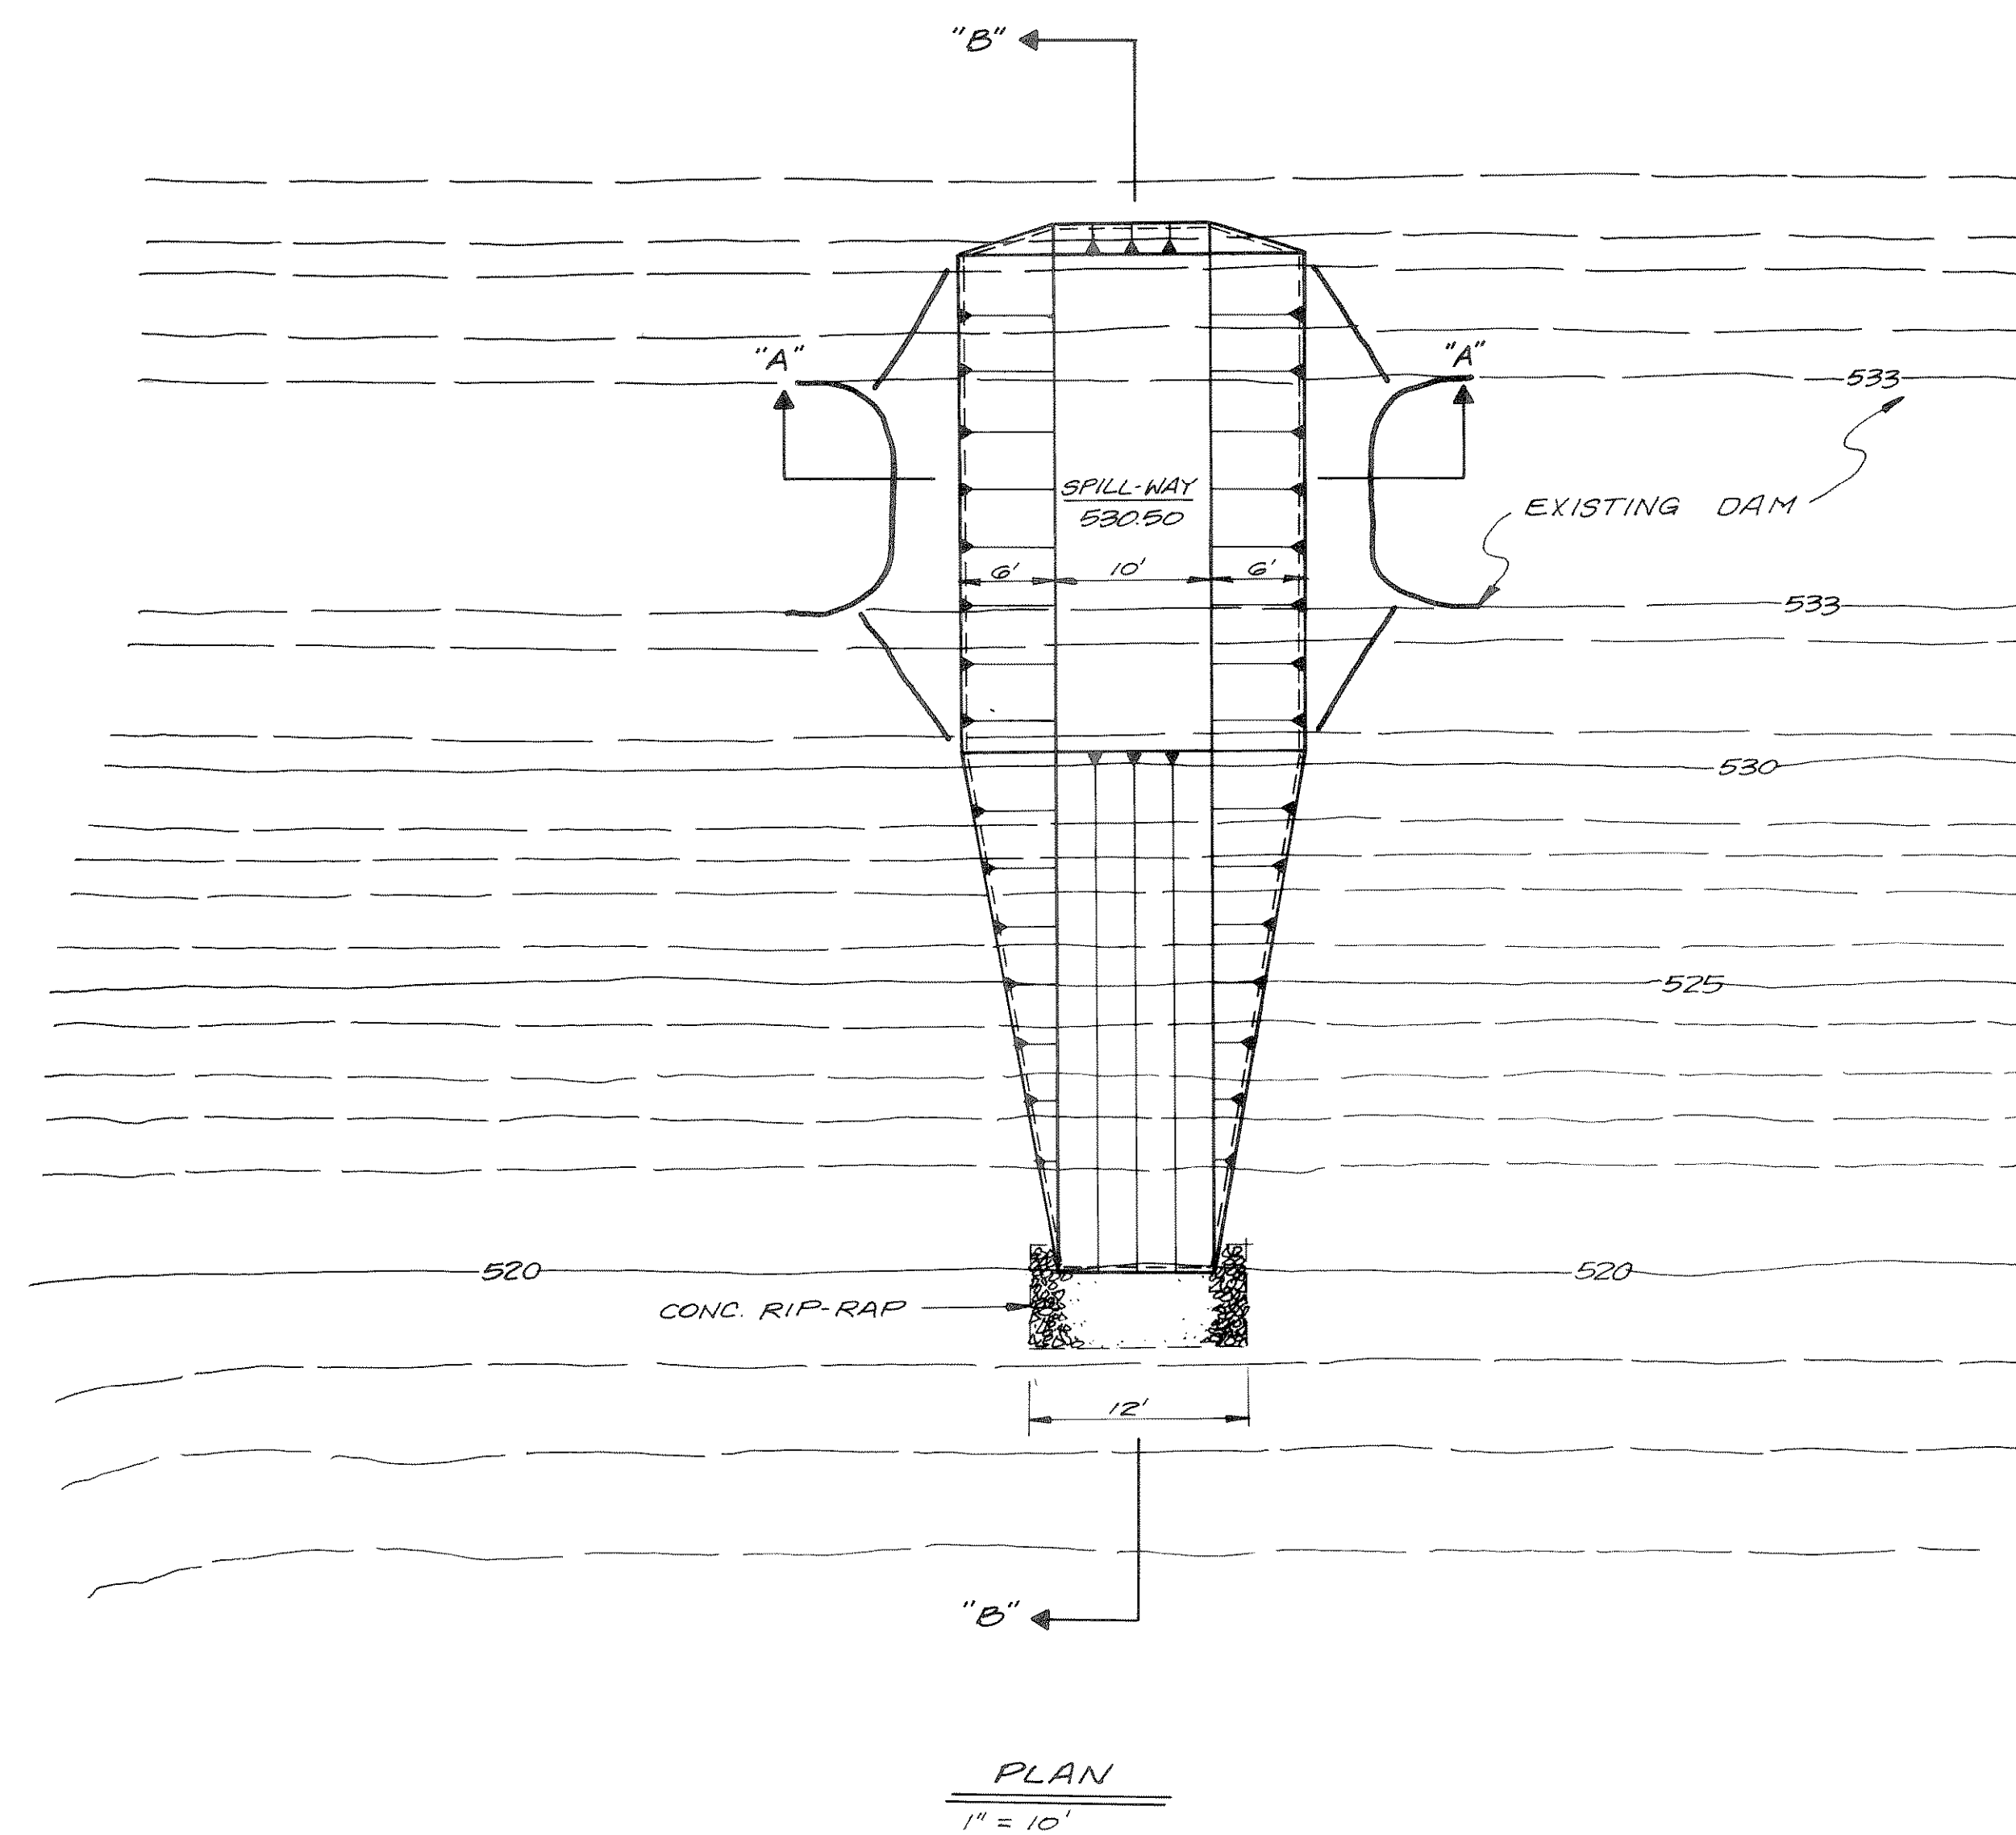

AS BUILT

HAROLD L. EVANS
CONSULTING ENGINEER
2331 GUS THOMASSON RD. SUITE 102
DALLAS, TEXAS 75228
PHONE (214) 328-8133

SPILL-WAY DETAIL
CHANDLER LANDING - PHASE NINETEEN
CITY OF ROCKWALL
ROCKWALL COUNTY, TEXAS