


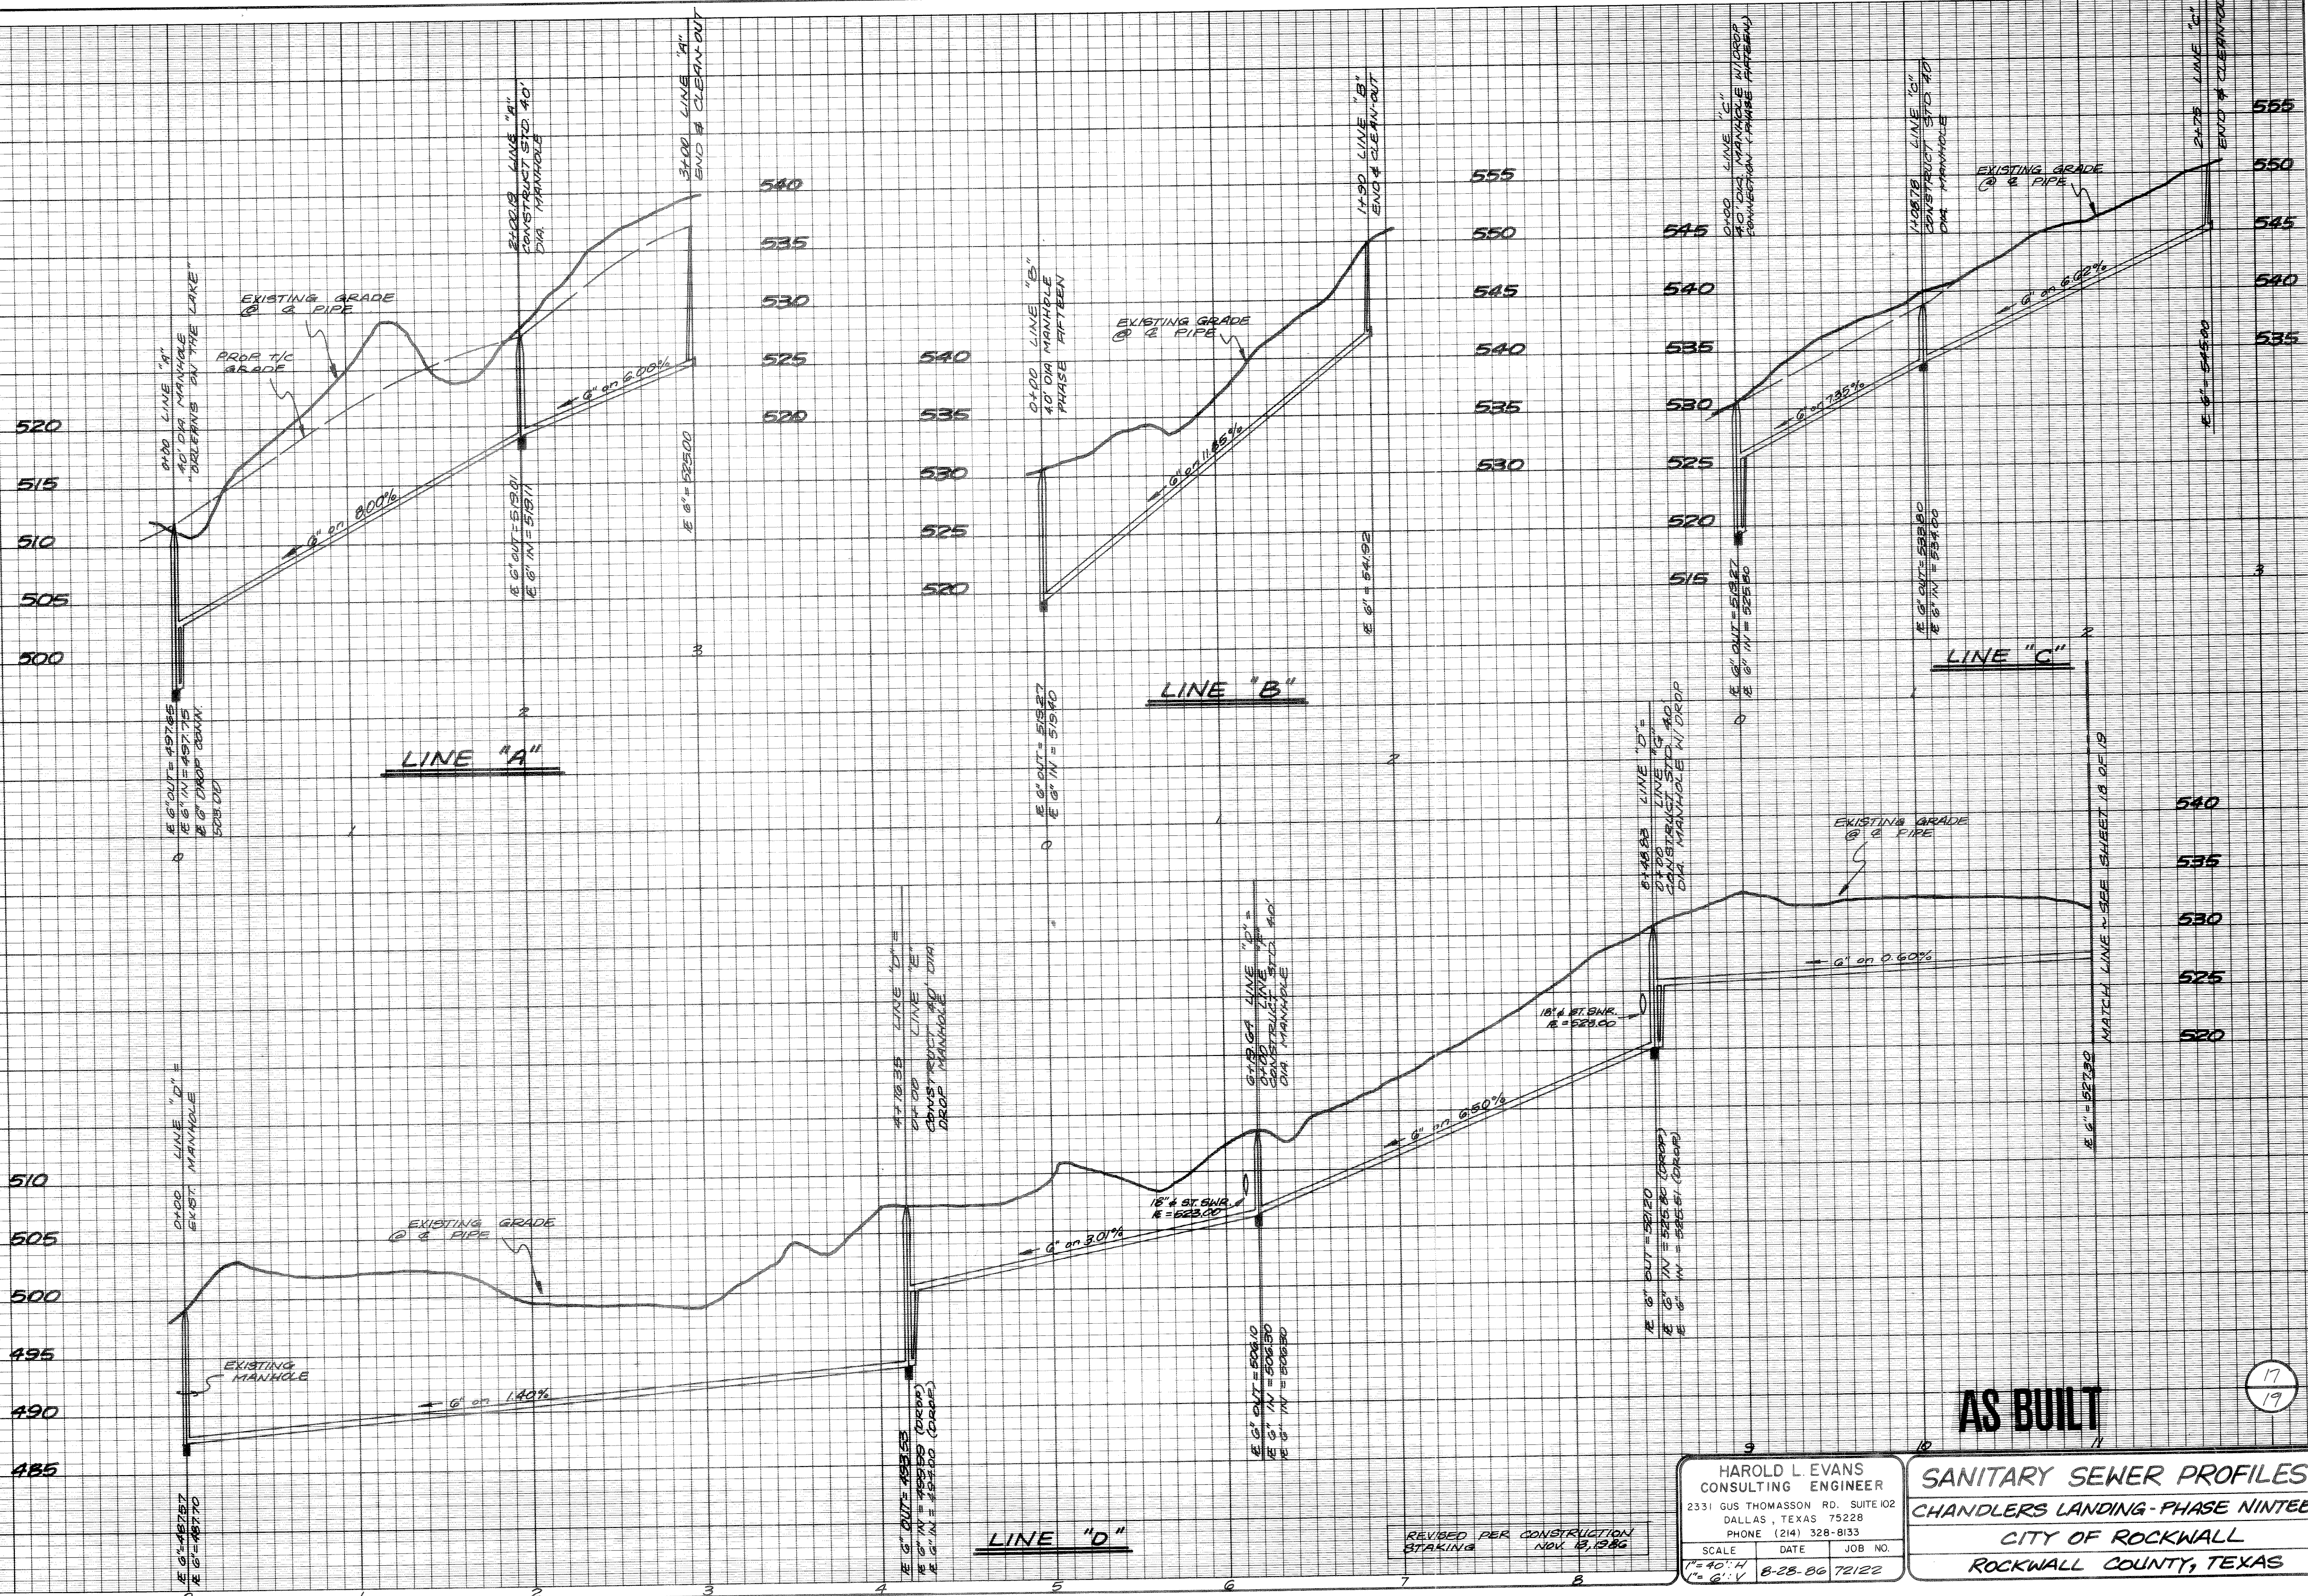

AS BUILT

HAROLD L. EVANS
 CONSULTING ENGINEER
 2331 GUS THOMASSON RD., SUITE 102
 DALLAS, TEXAS 75228
 PHONE (214) 328-8133
 SCALE DATE JOB NO.
 1" = 40' H 8-25-86 72122
 1" = 6' V

SANITARY SEWER PROFILES
 CHANDLERS LANDING - PHASE NINETEEN
 CITY OF ROCKWALL
 ROCKWALL COUNTY, TEXAS

REVISED PER CONSTRUCTION
 STAKING NOV. 12, 1986