


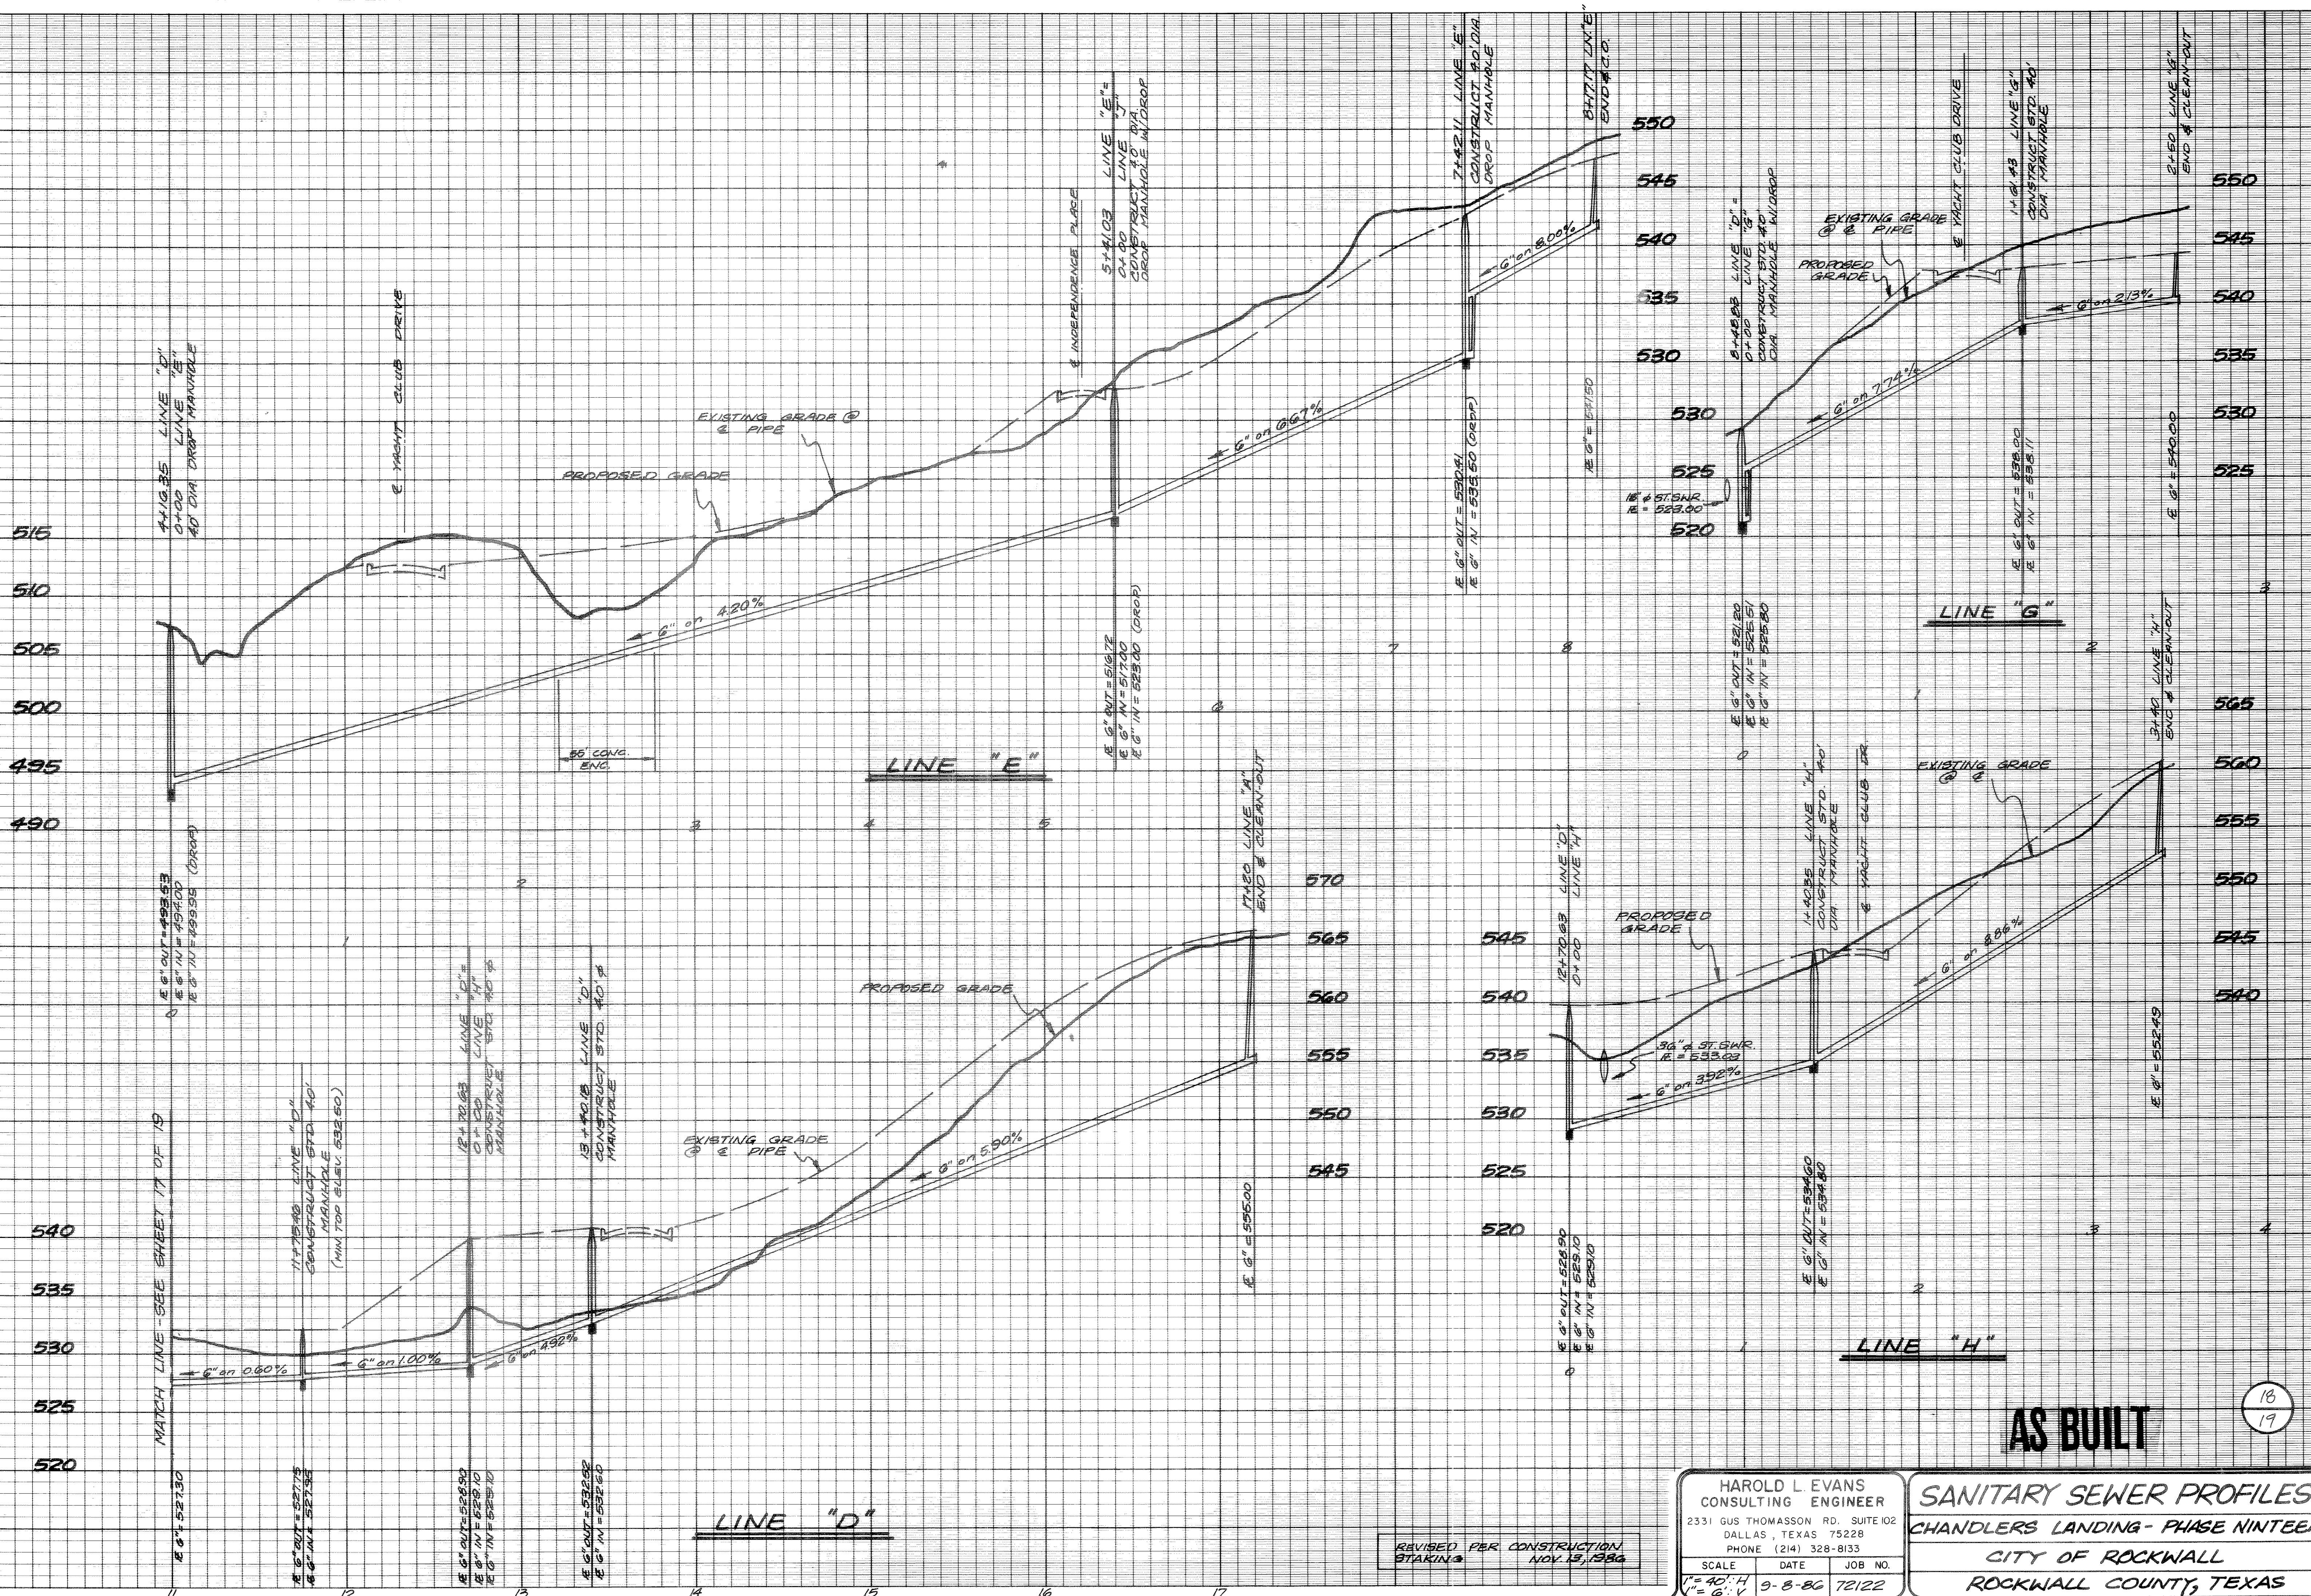

AS BUILT

18
19

REVISED PER CONSTRUCTION
STAKING
NOV. 15, 1984

HAROLD L. EVANS
CONSULTING ENGINEER
2331 GUS THOMASSON RD. SUITE 102
DALLAS, TEXAS 75228
PHONE (214) 328-8133
SCALE 1" = 40' H
1" = 6' V
DATE 9-8-86
JOB NO. 72122

SANITARY SEWER PROFILES
CHANDLERS LANDING - PHASE NINETEEN
CITY OF ROCKWALL
ROCKWALL COUNTY, TEXAS