
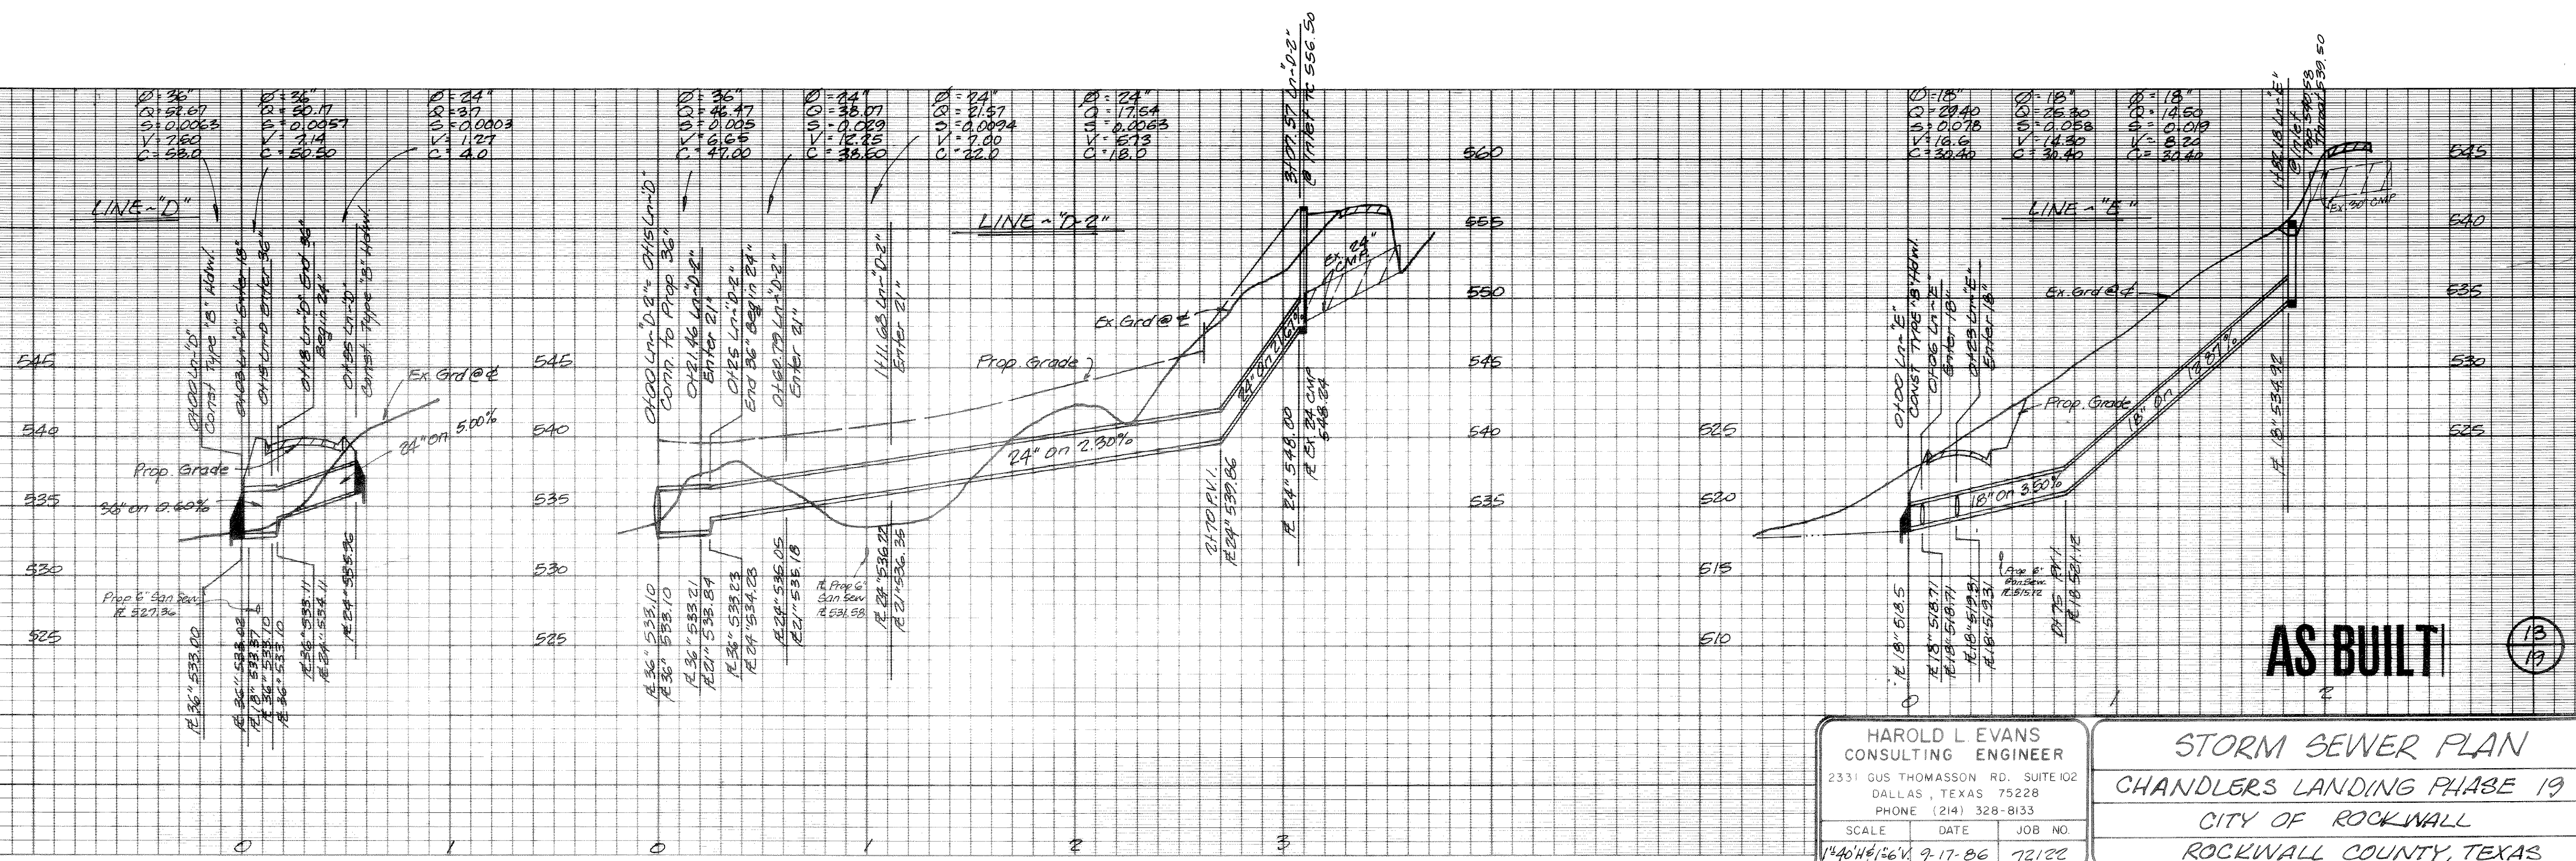
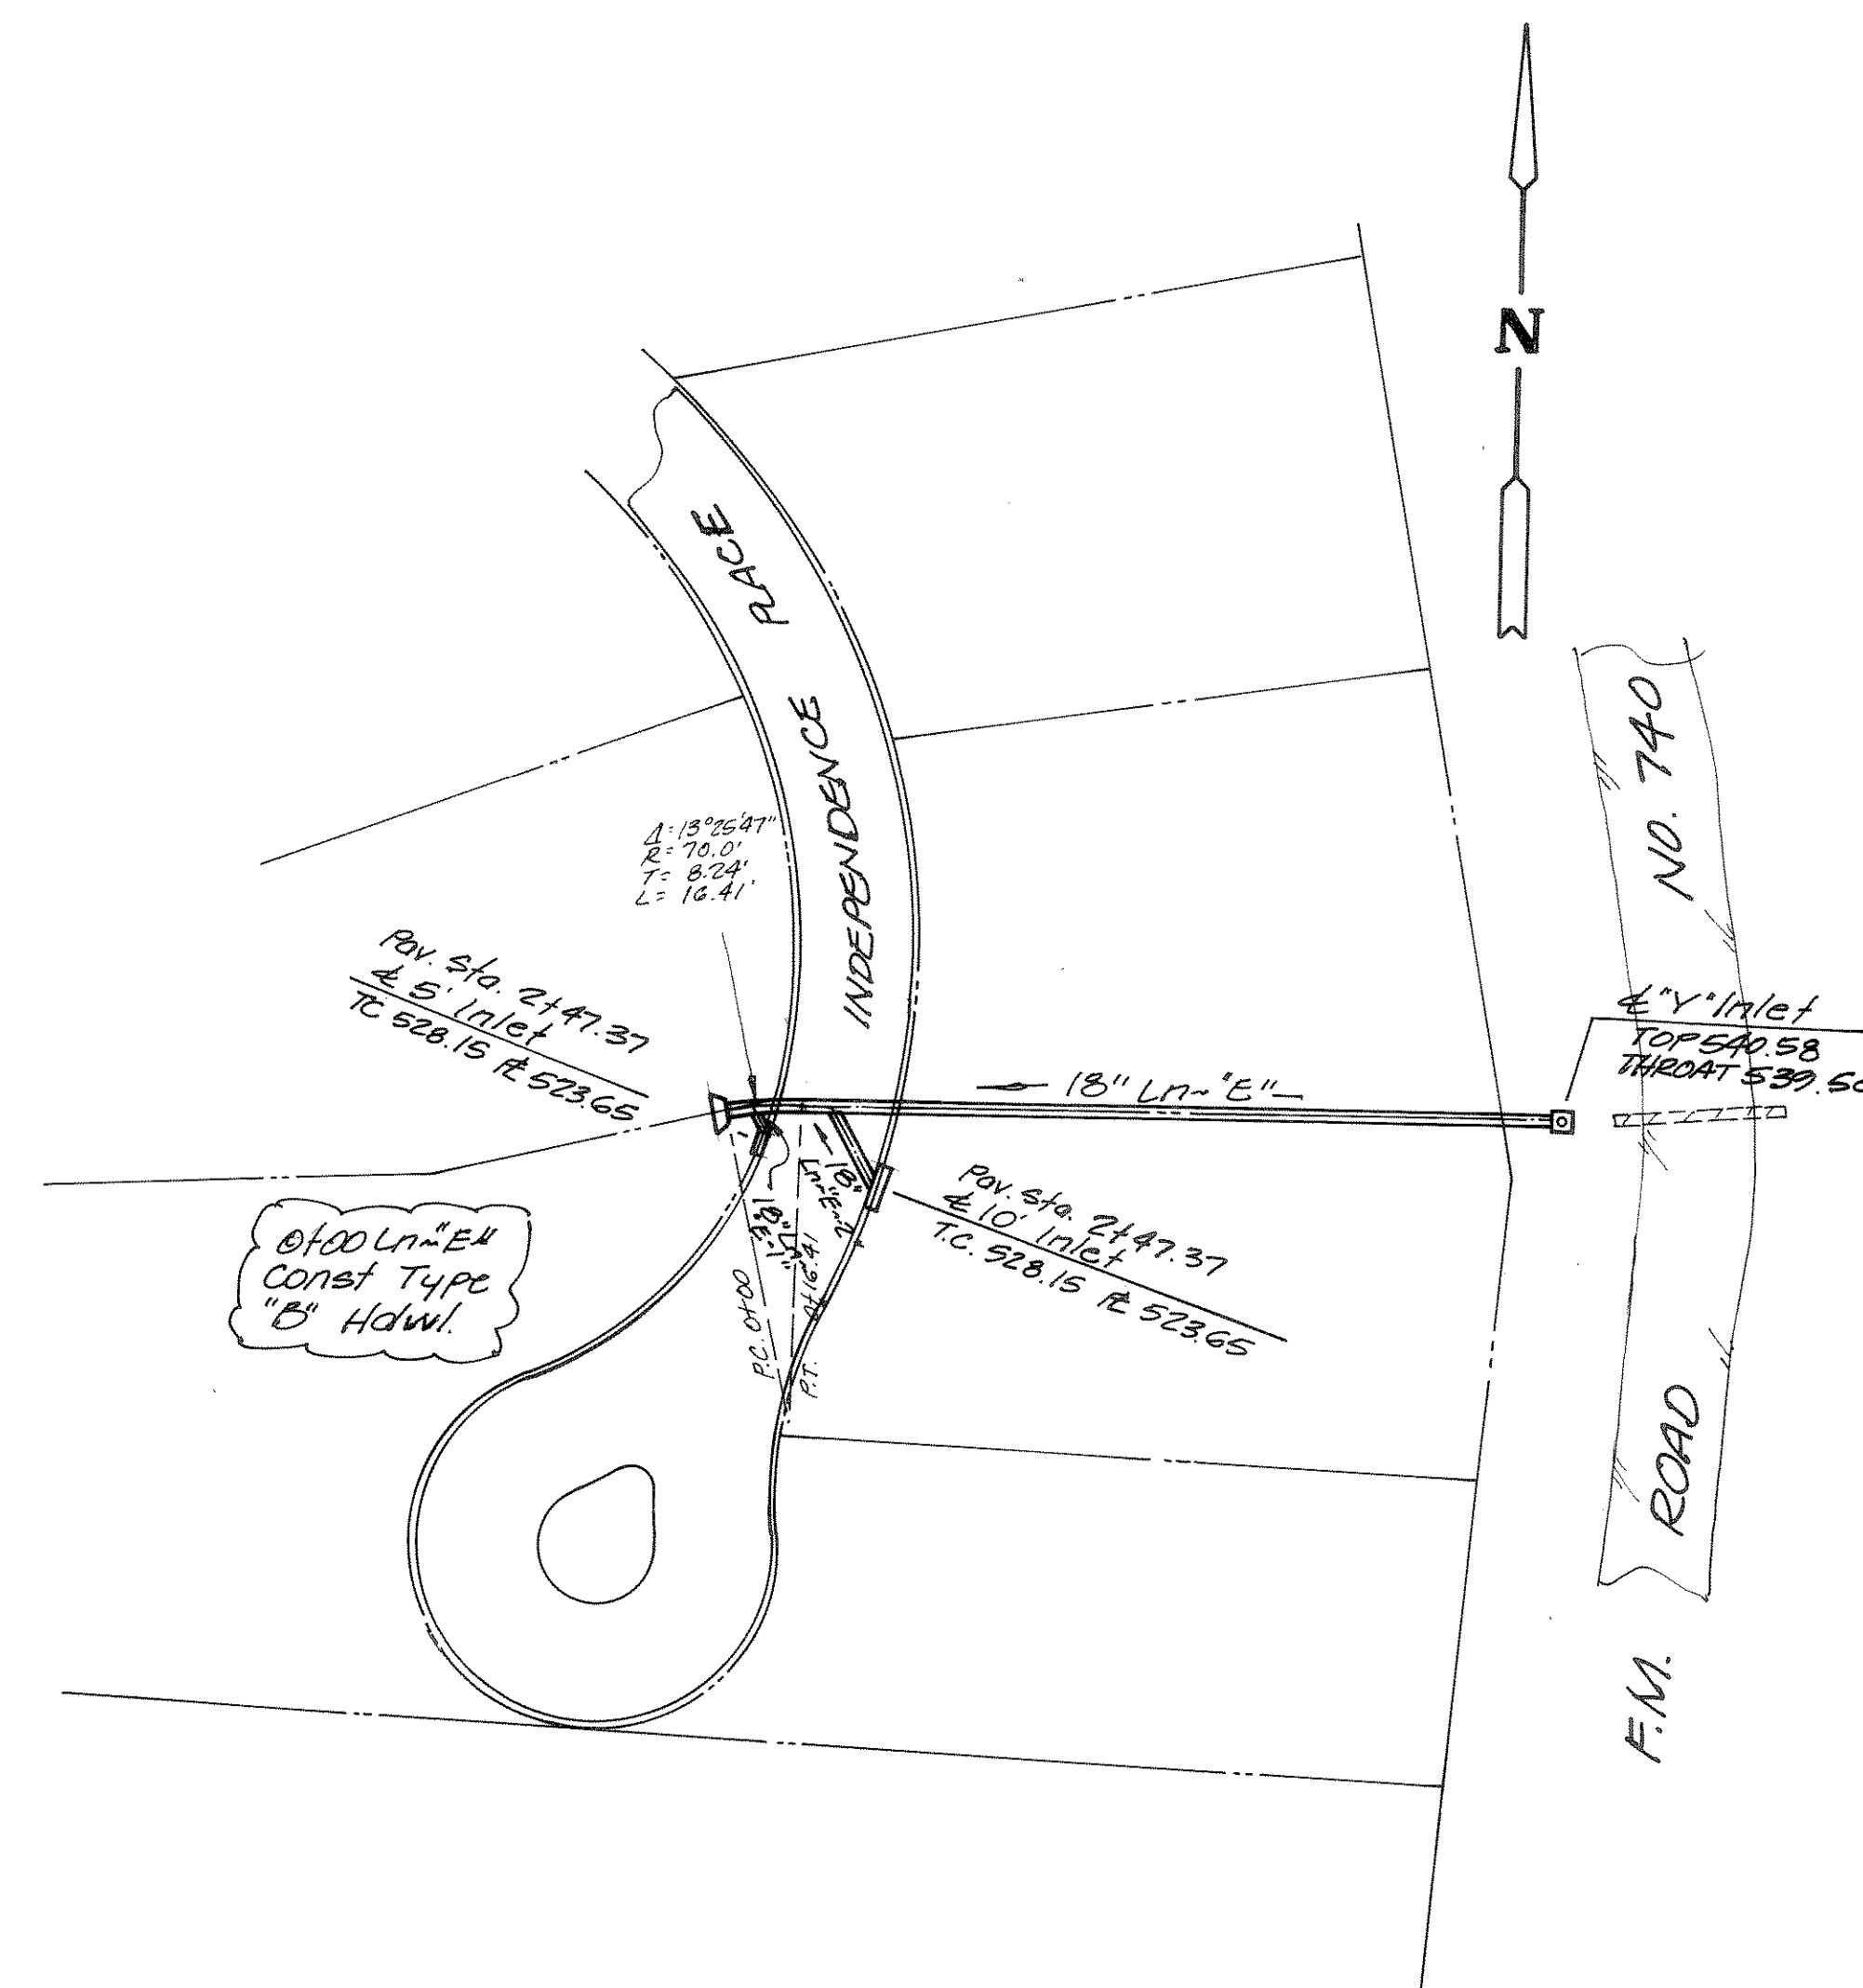


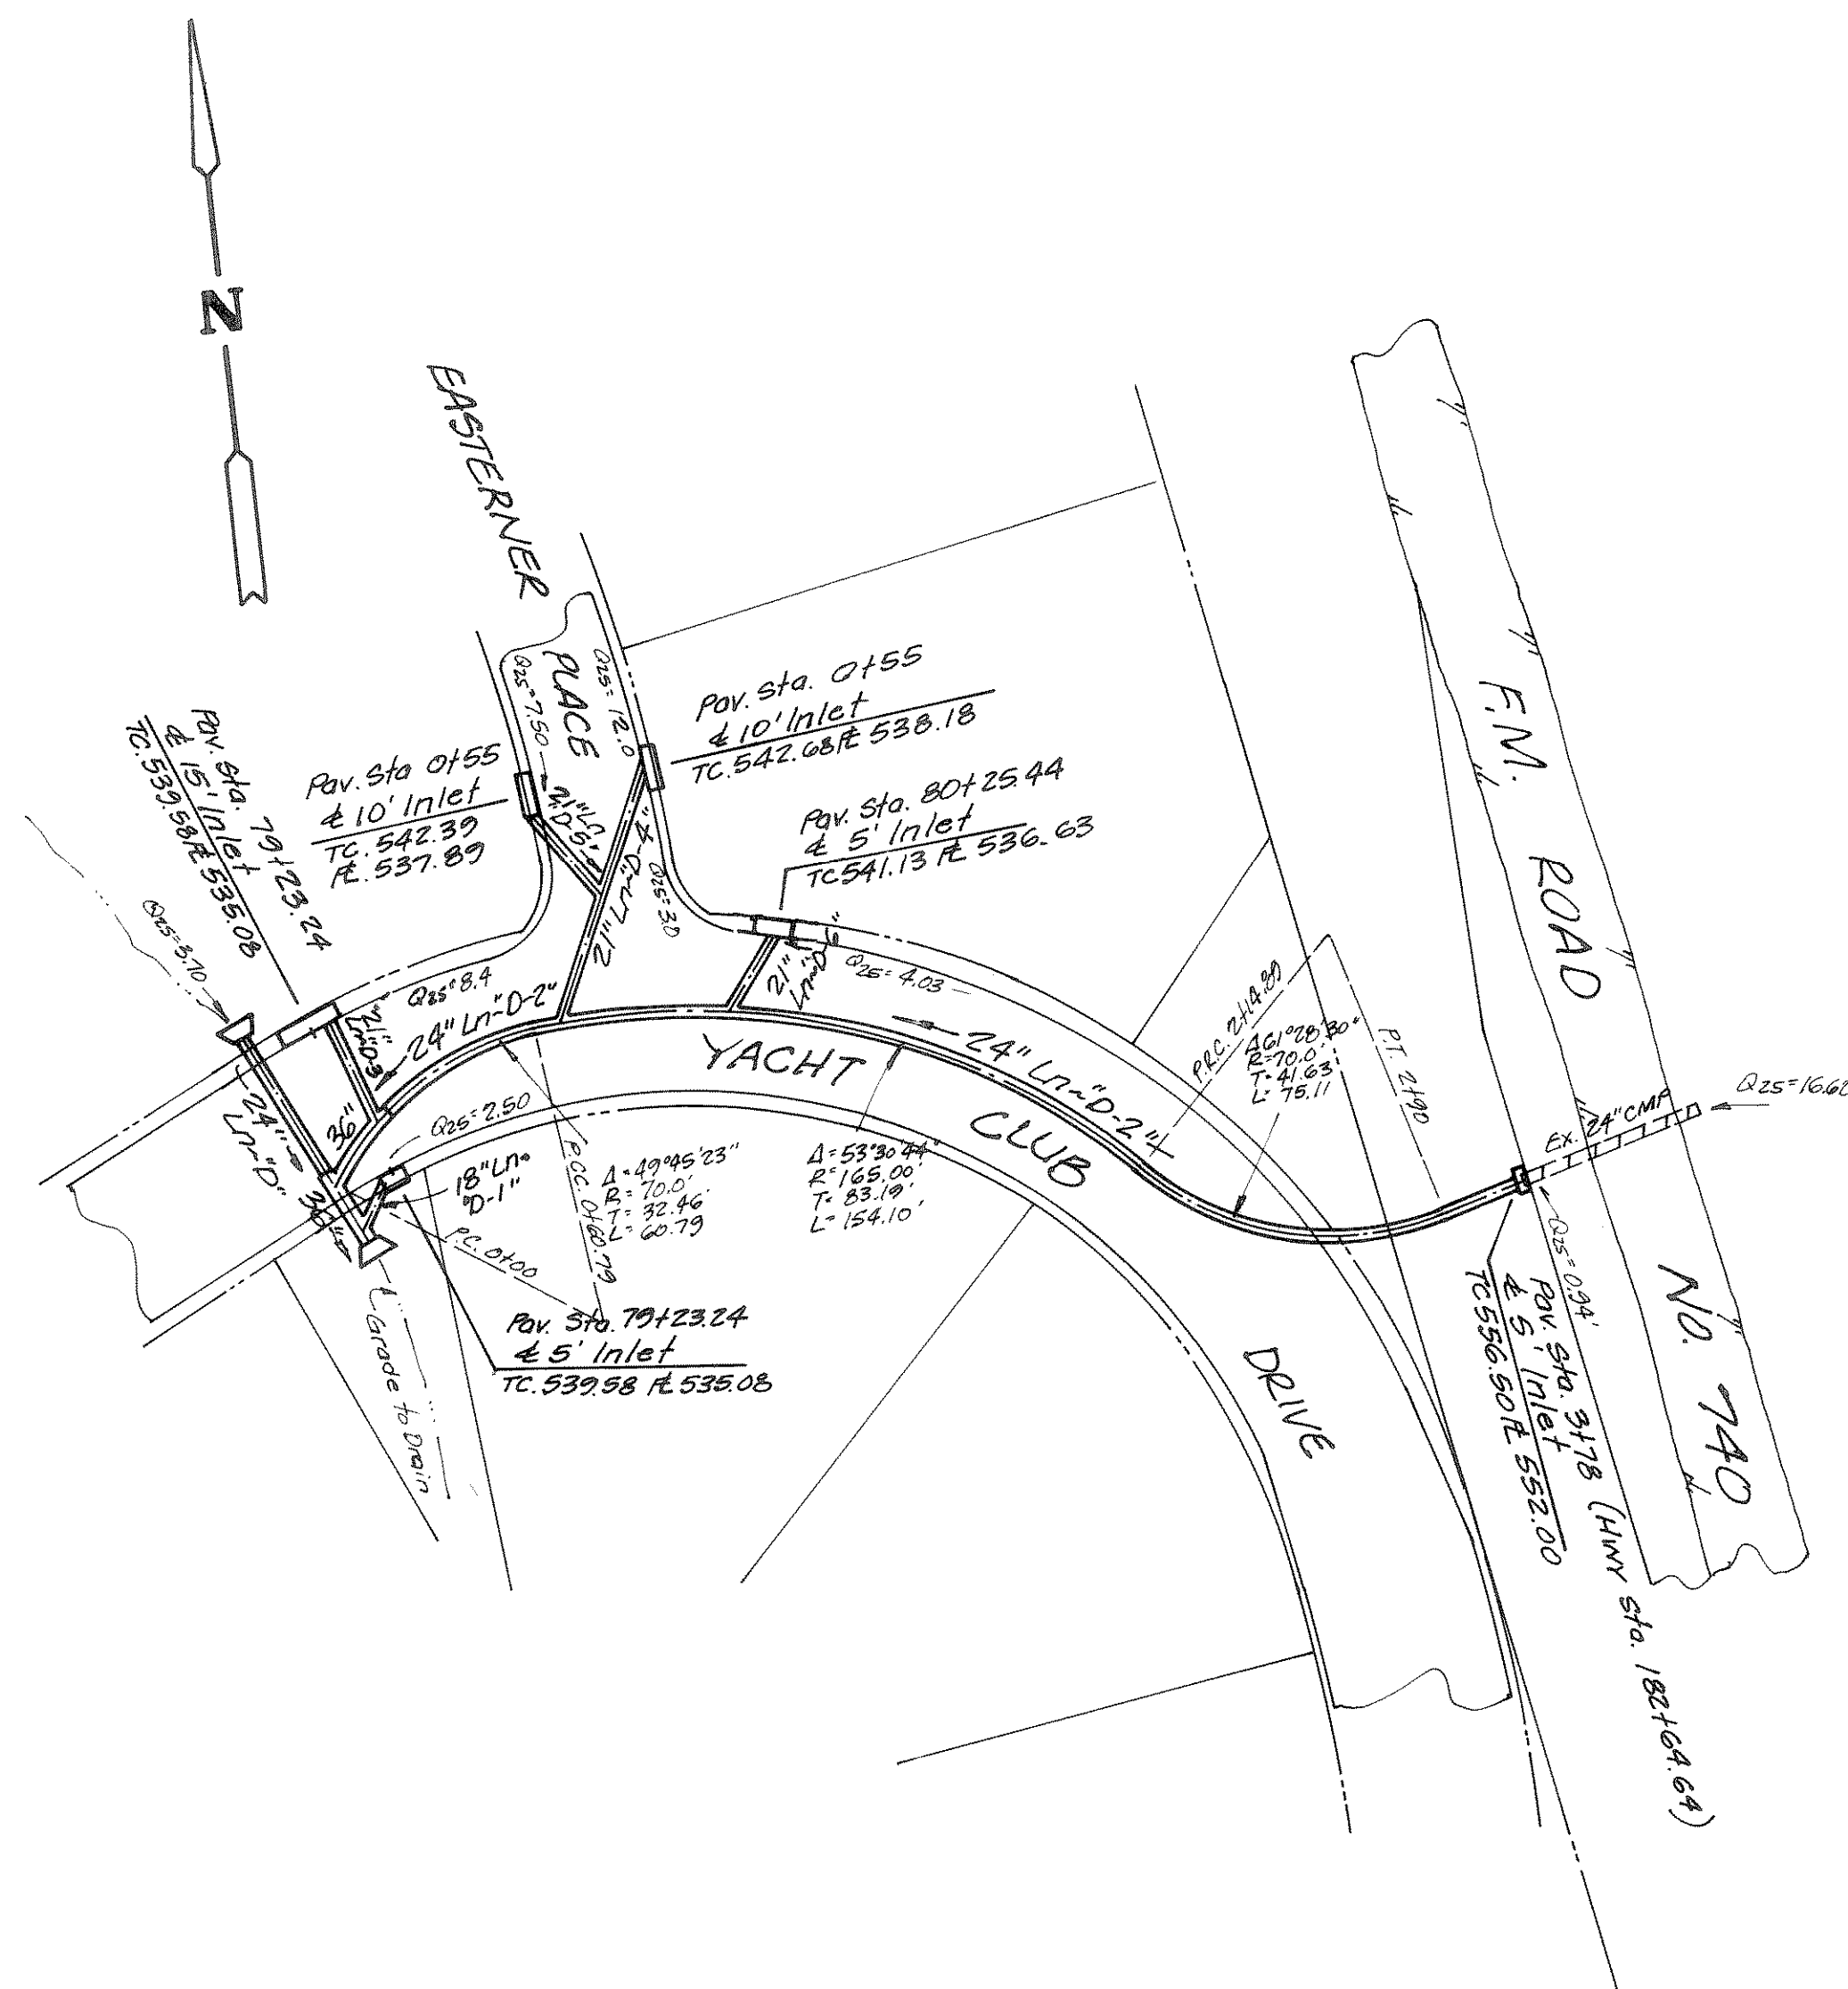

HAROLD L EVANS
CONSULTING ENGINEER
2331 GUS THOMASSON RD. SUITE 102
DALLAS, TEXAS 75228
PHONE (214) 328-8133

STORM SEWER PLAN
CHANDLERS LANDING PHASE 19
CITY OF ROCKWALL
ROCKWALL COUNTY, TEXAS

SCALE: 1"=40'

DATE: 9.17.86

JOB NO: 72122