


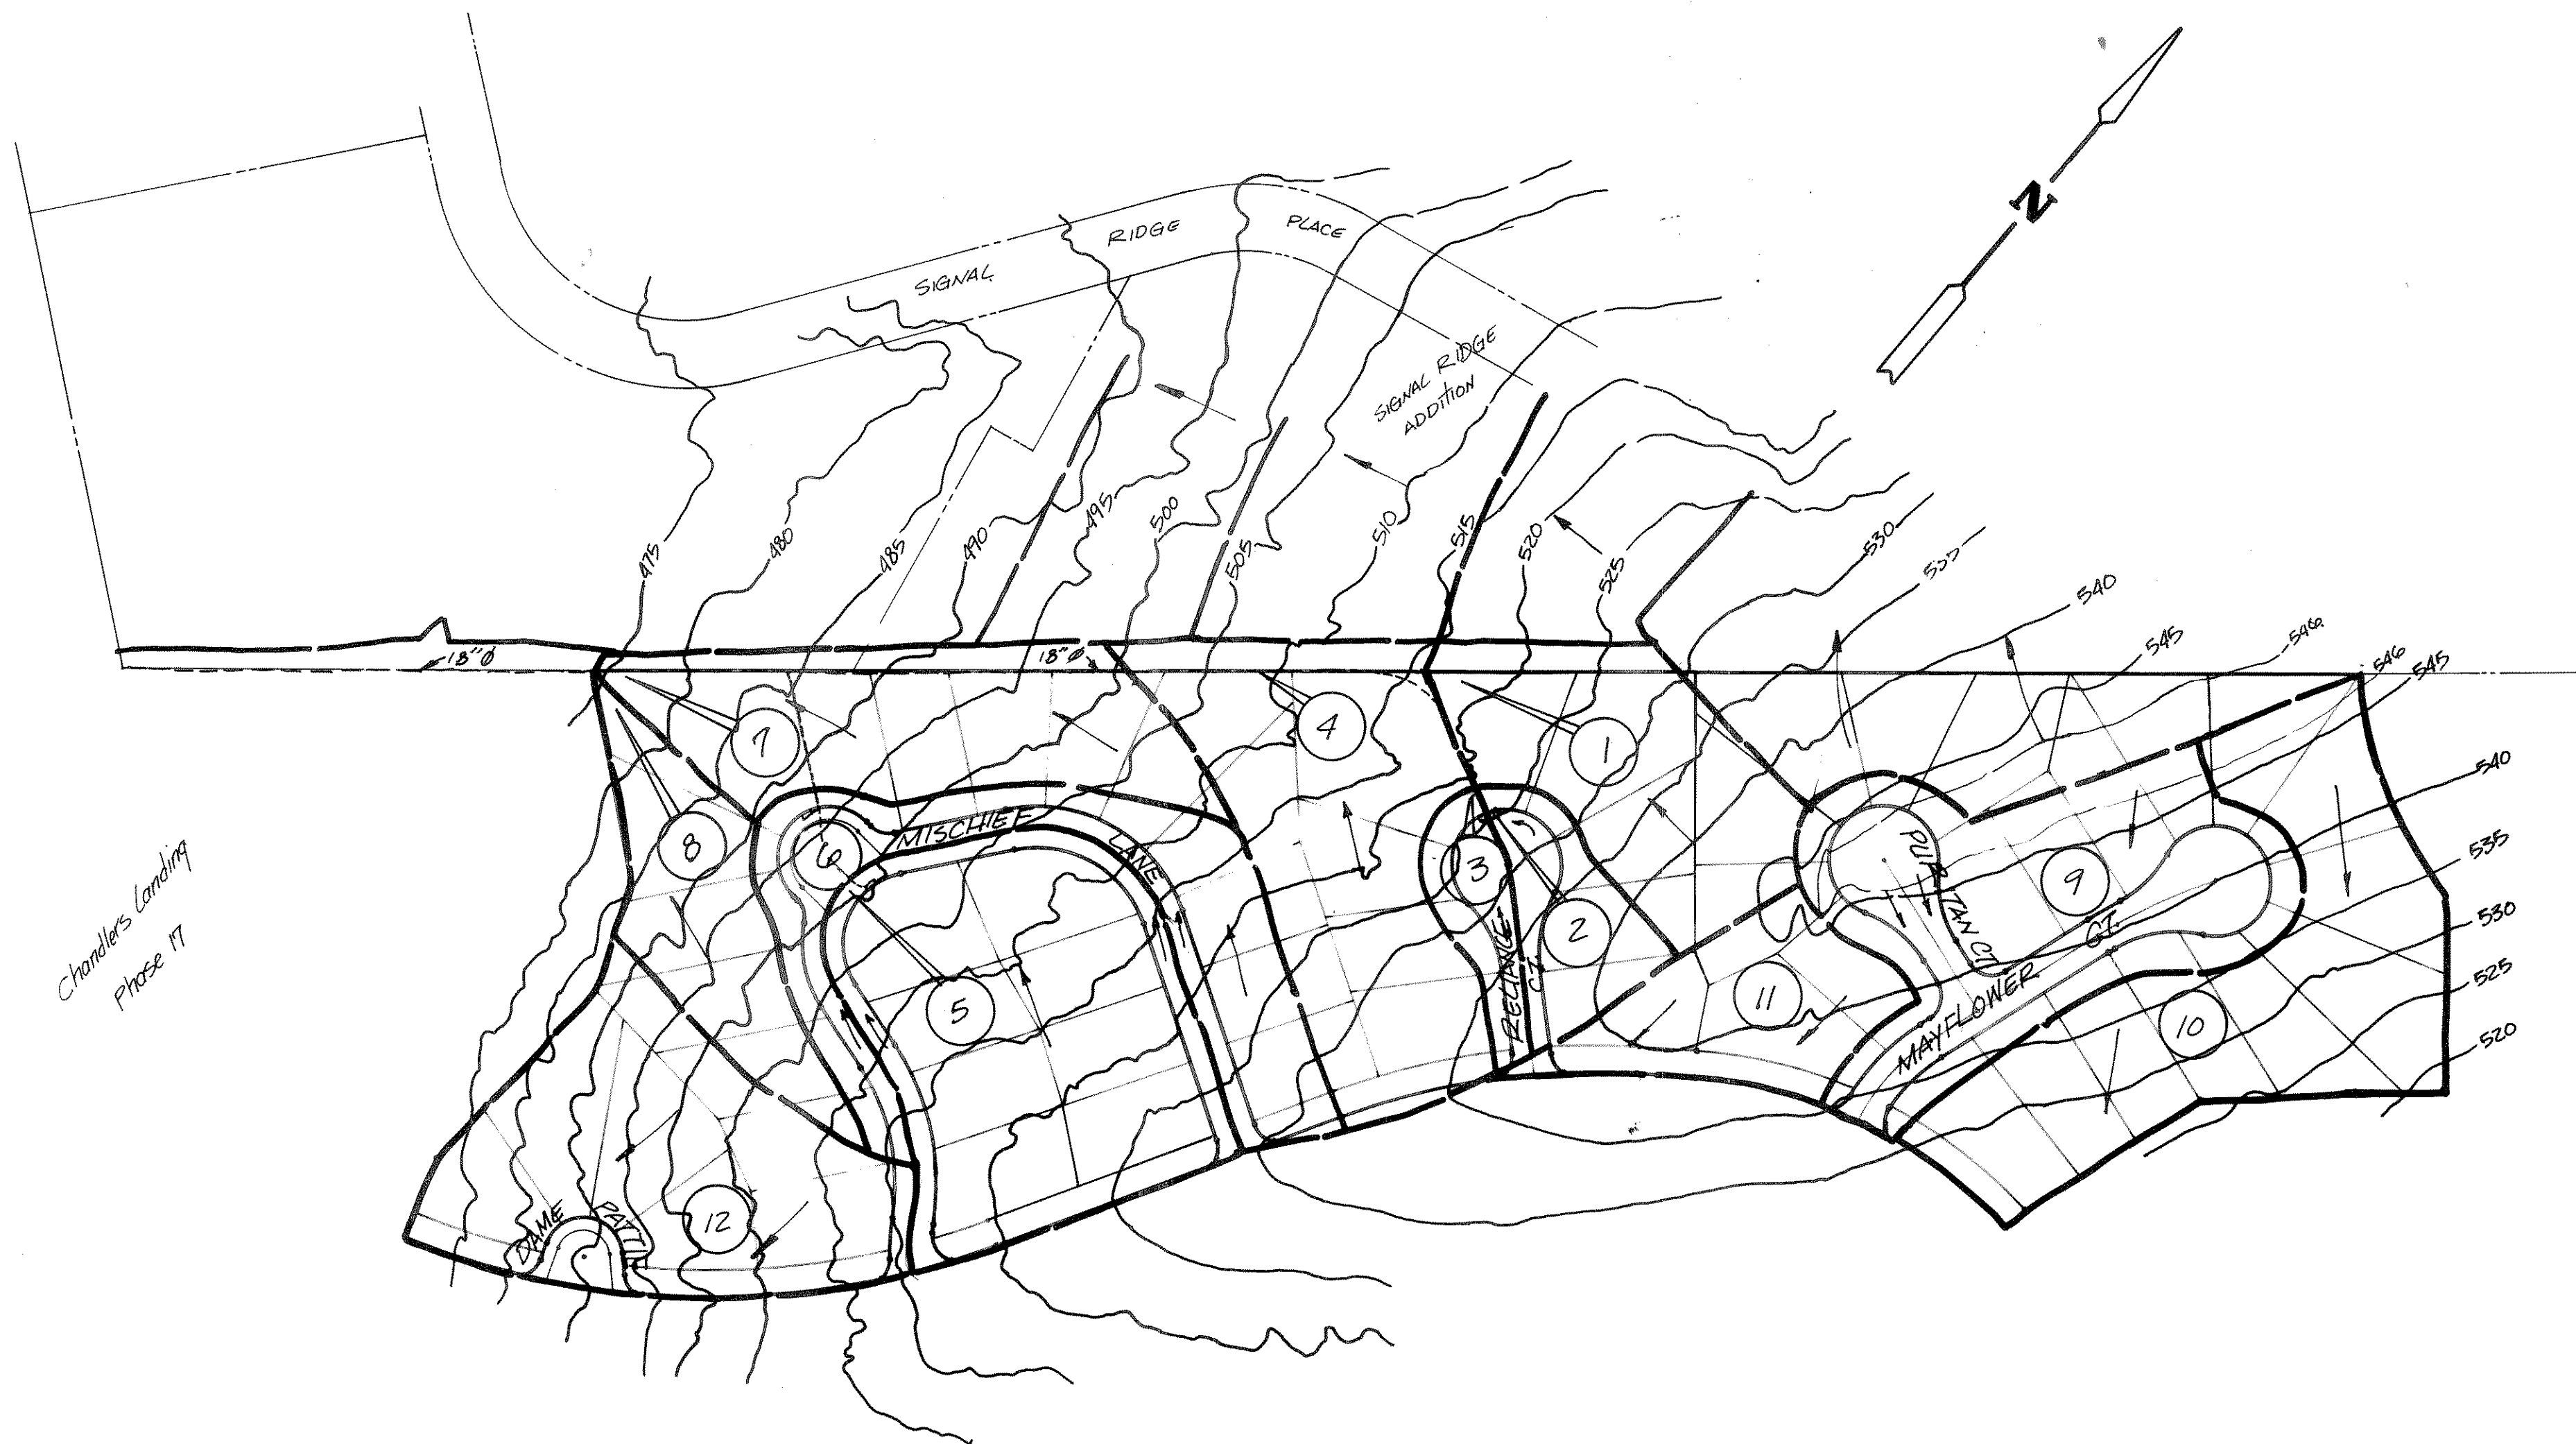

D.A. NO.	ACRES	DRAINAGE					DATA					
		C	T _c	I _S	Q ₅	Q _{5ACC}	I ₂₅	Q ₂₅	Q _{25ACC}	I ₁₀₀	Q ₁₀₀	Q _{100ACC}
1	0.89	0.50	10	0.20	2.80	—	8.30	3.70	—	9.10	4.05	—
2	0.35	"	"	"	1.10	3.90	"	1.50	5.20	"	1.60	5.65
3	0.20	"	"	"	0.60	4.50	"	0.80	6.00	"	0.90	6.60
4	1.30	"	"	"	4.00	8.50	"	5.40	11.40	"	5.90	12.50
5	1.58	"	"	"	4.90	13.40	"	6.60	18.00	"	7.20	19.70
6	0.90	"	"	"	3.00	16.40	"	4.00	22.00	"	4.40	24.10
7	1.05	"	"	"	3.30	19.70	"	4.40	26.40	"	4.80	28.90
8	0.58	"	"	"	1.80	21.50	"	2.40	28.80	"	2.60	31.60
9	1.44	"	"	"	4.50	—	"	6.00	—	"	6.60	—
10	1.45	"	"	"	4.50	9.00	"	6.00	12.00	"	6.60	13.20
11	0.53	"	"	"	1.60	10.00	"	2.20	14.20	"	2.40	15.60
12	1.60	"	"	"	5.00	15.60	"	6.60	20.80	"	7.30	22.90

AS BUILT

0
10

HAROLD L. EVANS
CONSULTING ENGINEER
2331 GUS THOMASSON RD. SUITE 102
DALLAS, TEXAS 75228
PHONE (214) 328-8133
SCALE 1"=100'
DATE JUNE 85
JOB NO. 72122

DRAINAGE AREA MAP
CHANDLERS LANDING PHASE 20
CITY OF ROCKWALL
ROCKWALL COUNTY, TEXAS