


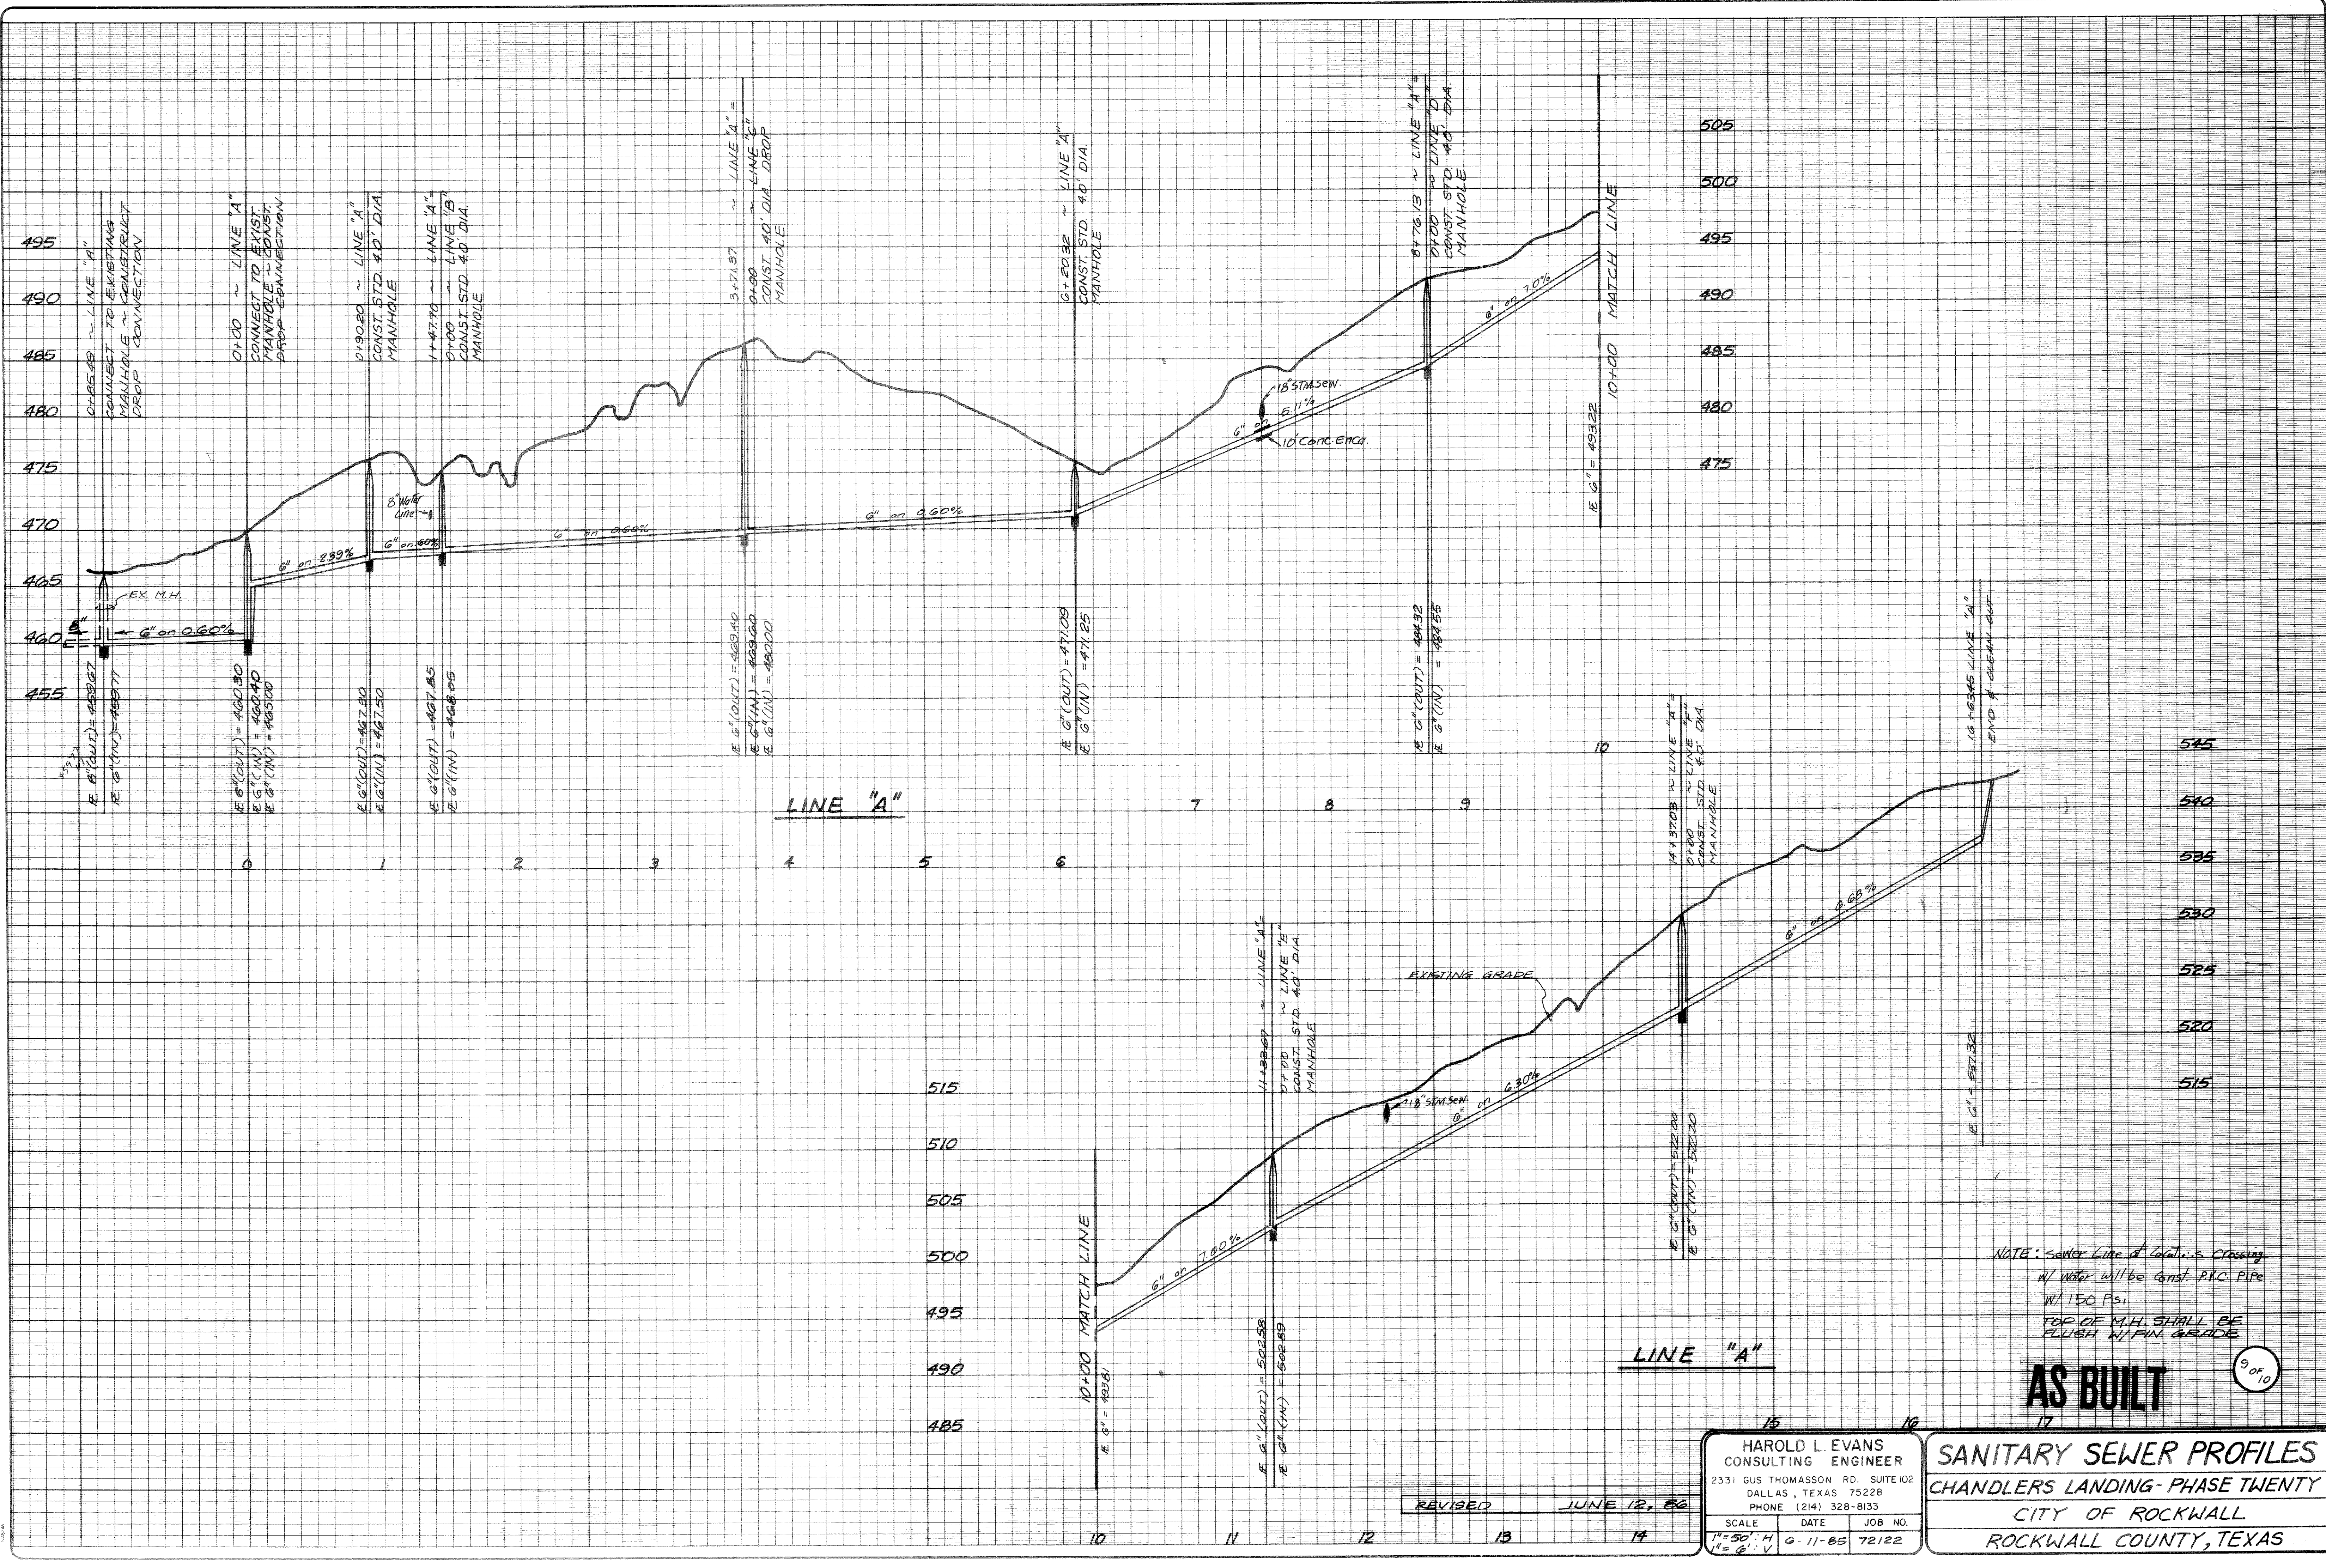

HAROLD L. EVANS
CONSULTING ENGINEER
2331 GUS THOMASSON RD. SUITE 102
DALLAS, TEXAS 75228
PHONE (214) 328-8133

SCALE: 1" = 50' H
1" = 6' V

DATE: 6-11-85

JOB NO.: 72122

REVISED: JUNE 12, 86

9 of 10

SANITARY SEWER PROFILES
CHANDLERS LANDING - PHASE TWENTY
CITY OF ROCKWALL
ROCKWALL COUNTY, TEXAS