


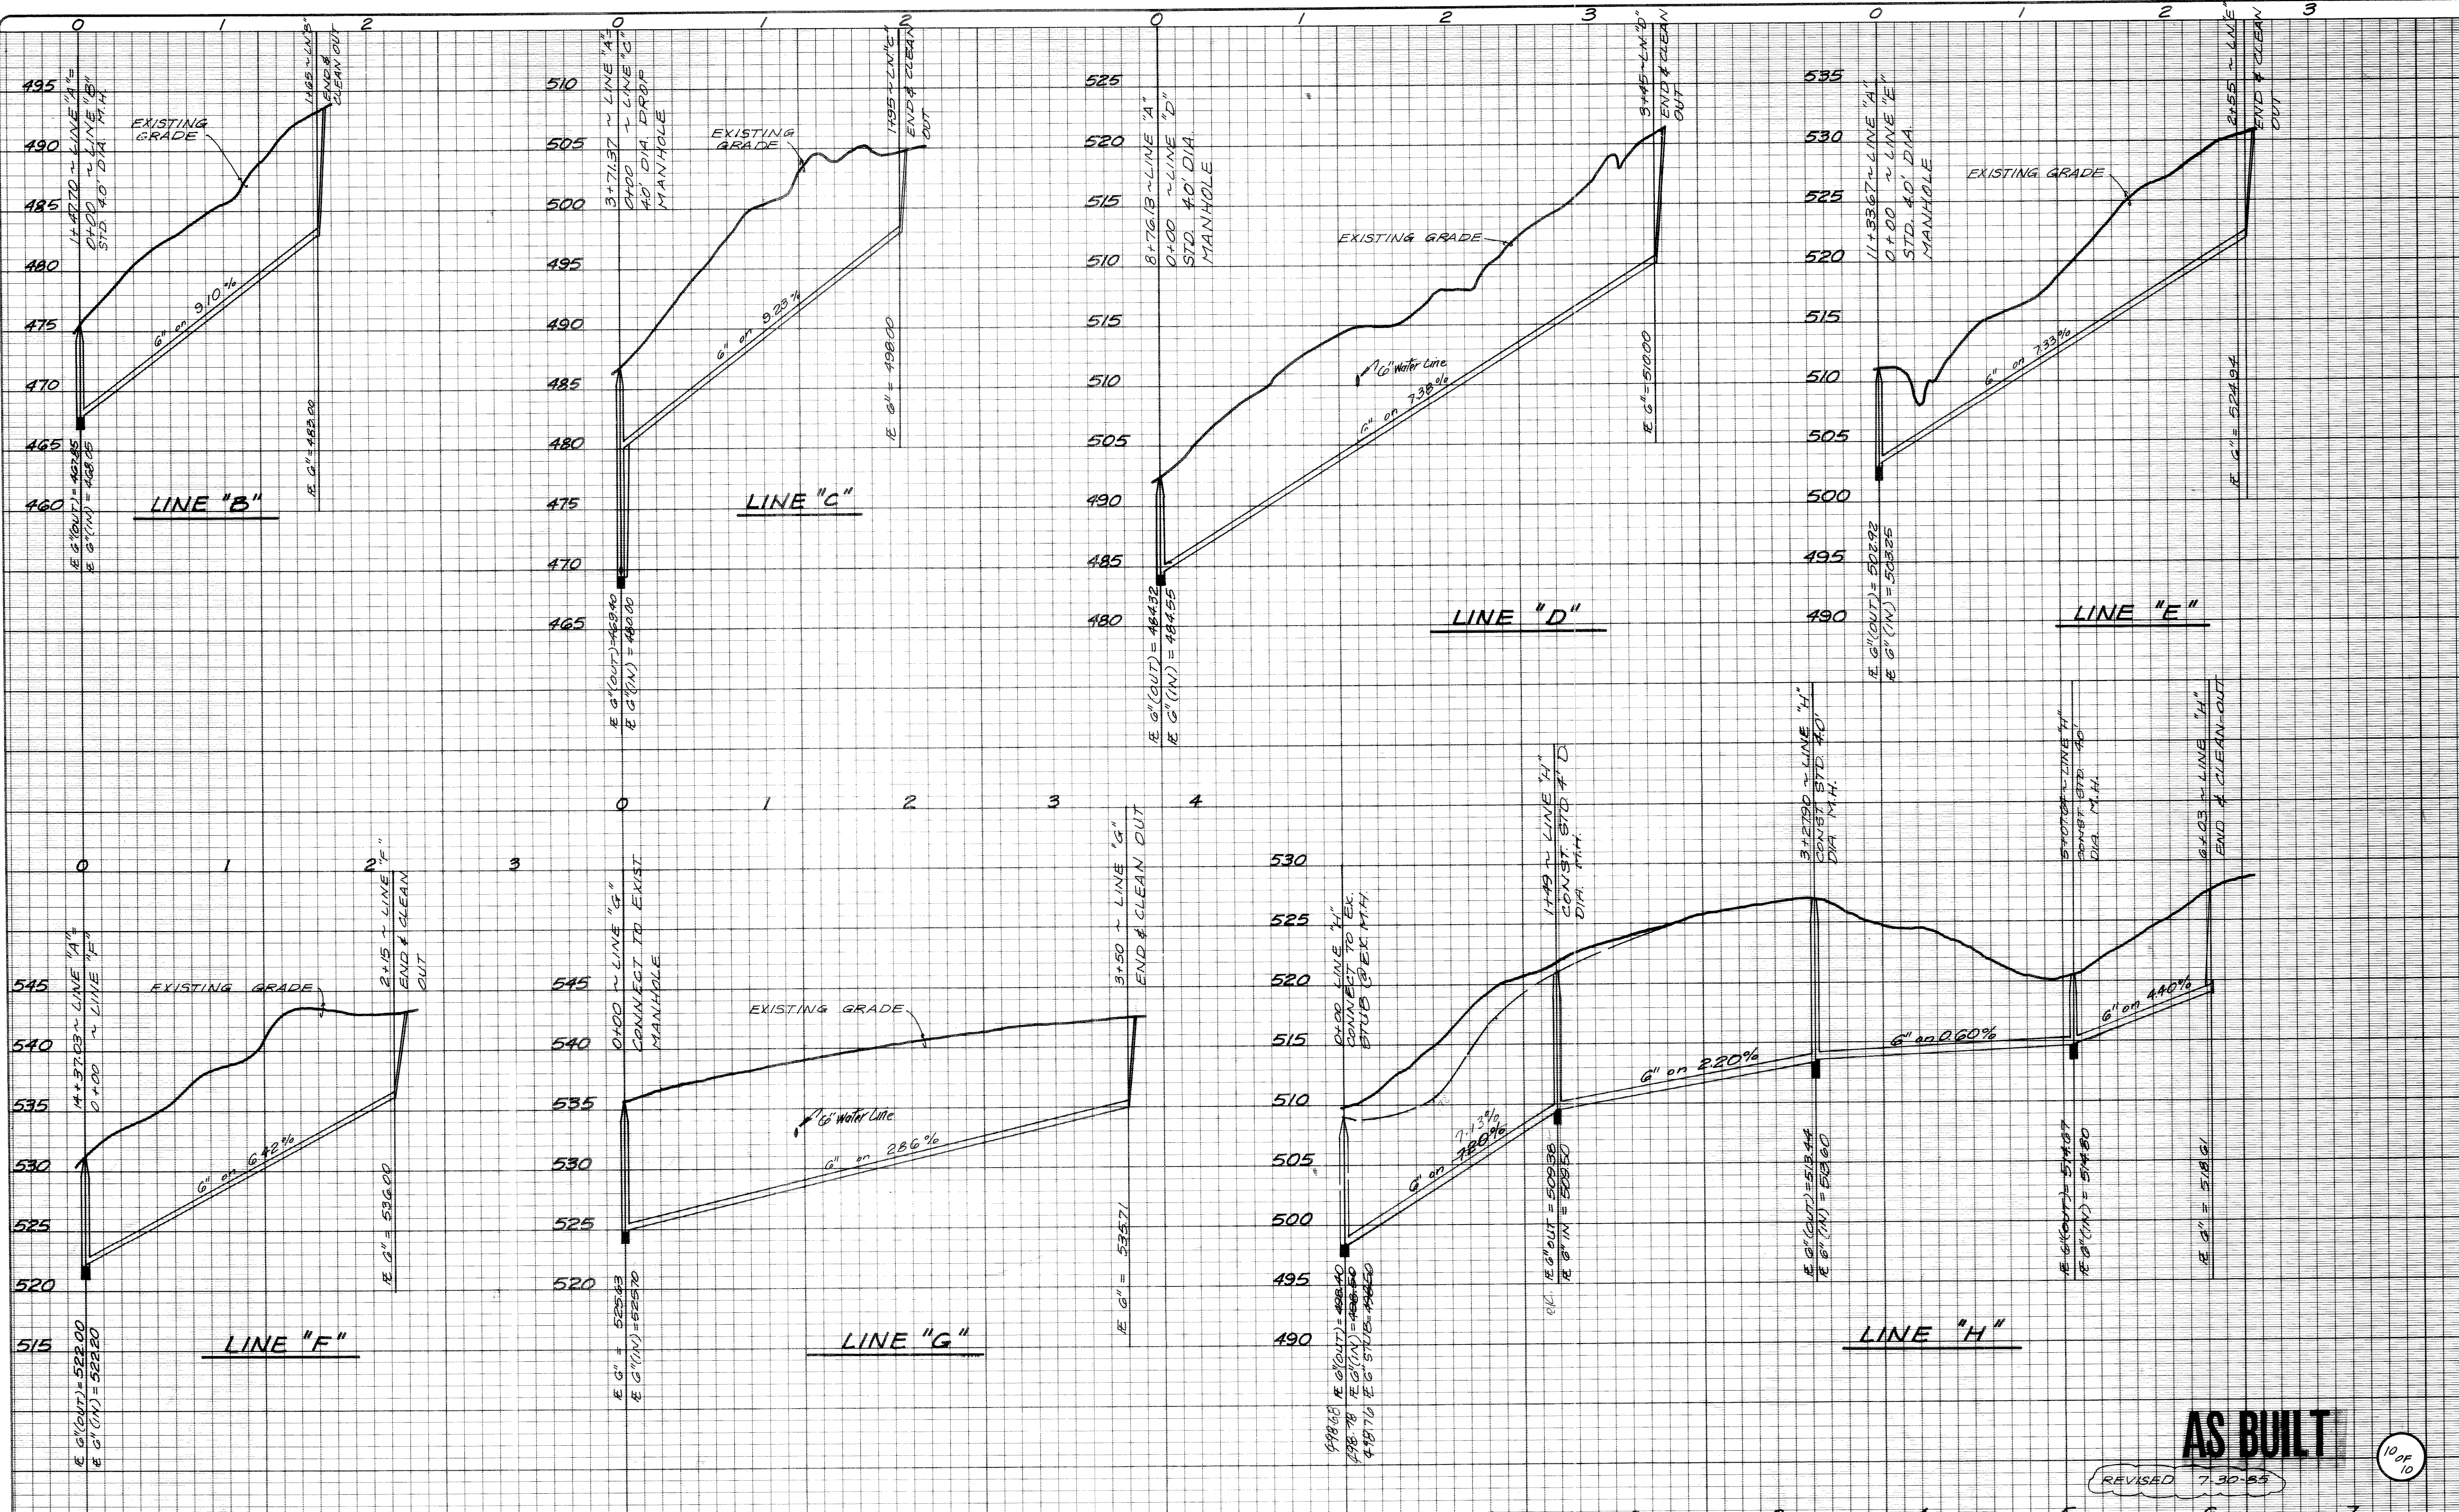

NOTE:
 TOP M.H. SHALL BE
 FLUSH W/ FIN. GRADE

REVISED JUNE 12, 1986

HAROLD L. EVANS CONSULTING ENGINEER 2331 GUS THOMASSON RD. SUITE 102 DALLAS, TEXAS 75228 PHONE (214) 328-8133			SANITARY SEWER PROFILES CHANDLERS LANDING - PHASE TWENTY CITY OF ROCKWALL ROCKWALL COUNTY, TEXAS		
SCALE	DATE	JOB NO.			
1" = 50' : H 1" = 6' : V	G-11-85	73122			

AS BUILT