
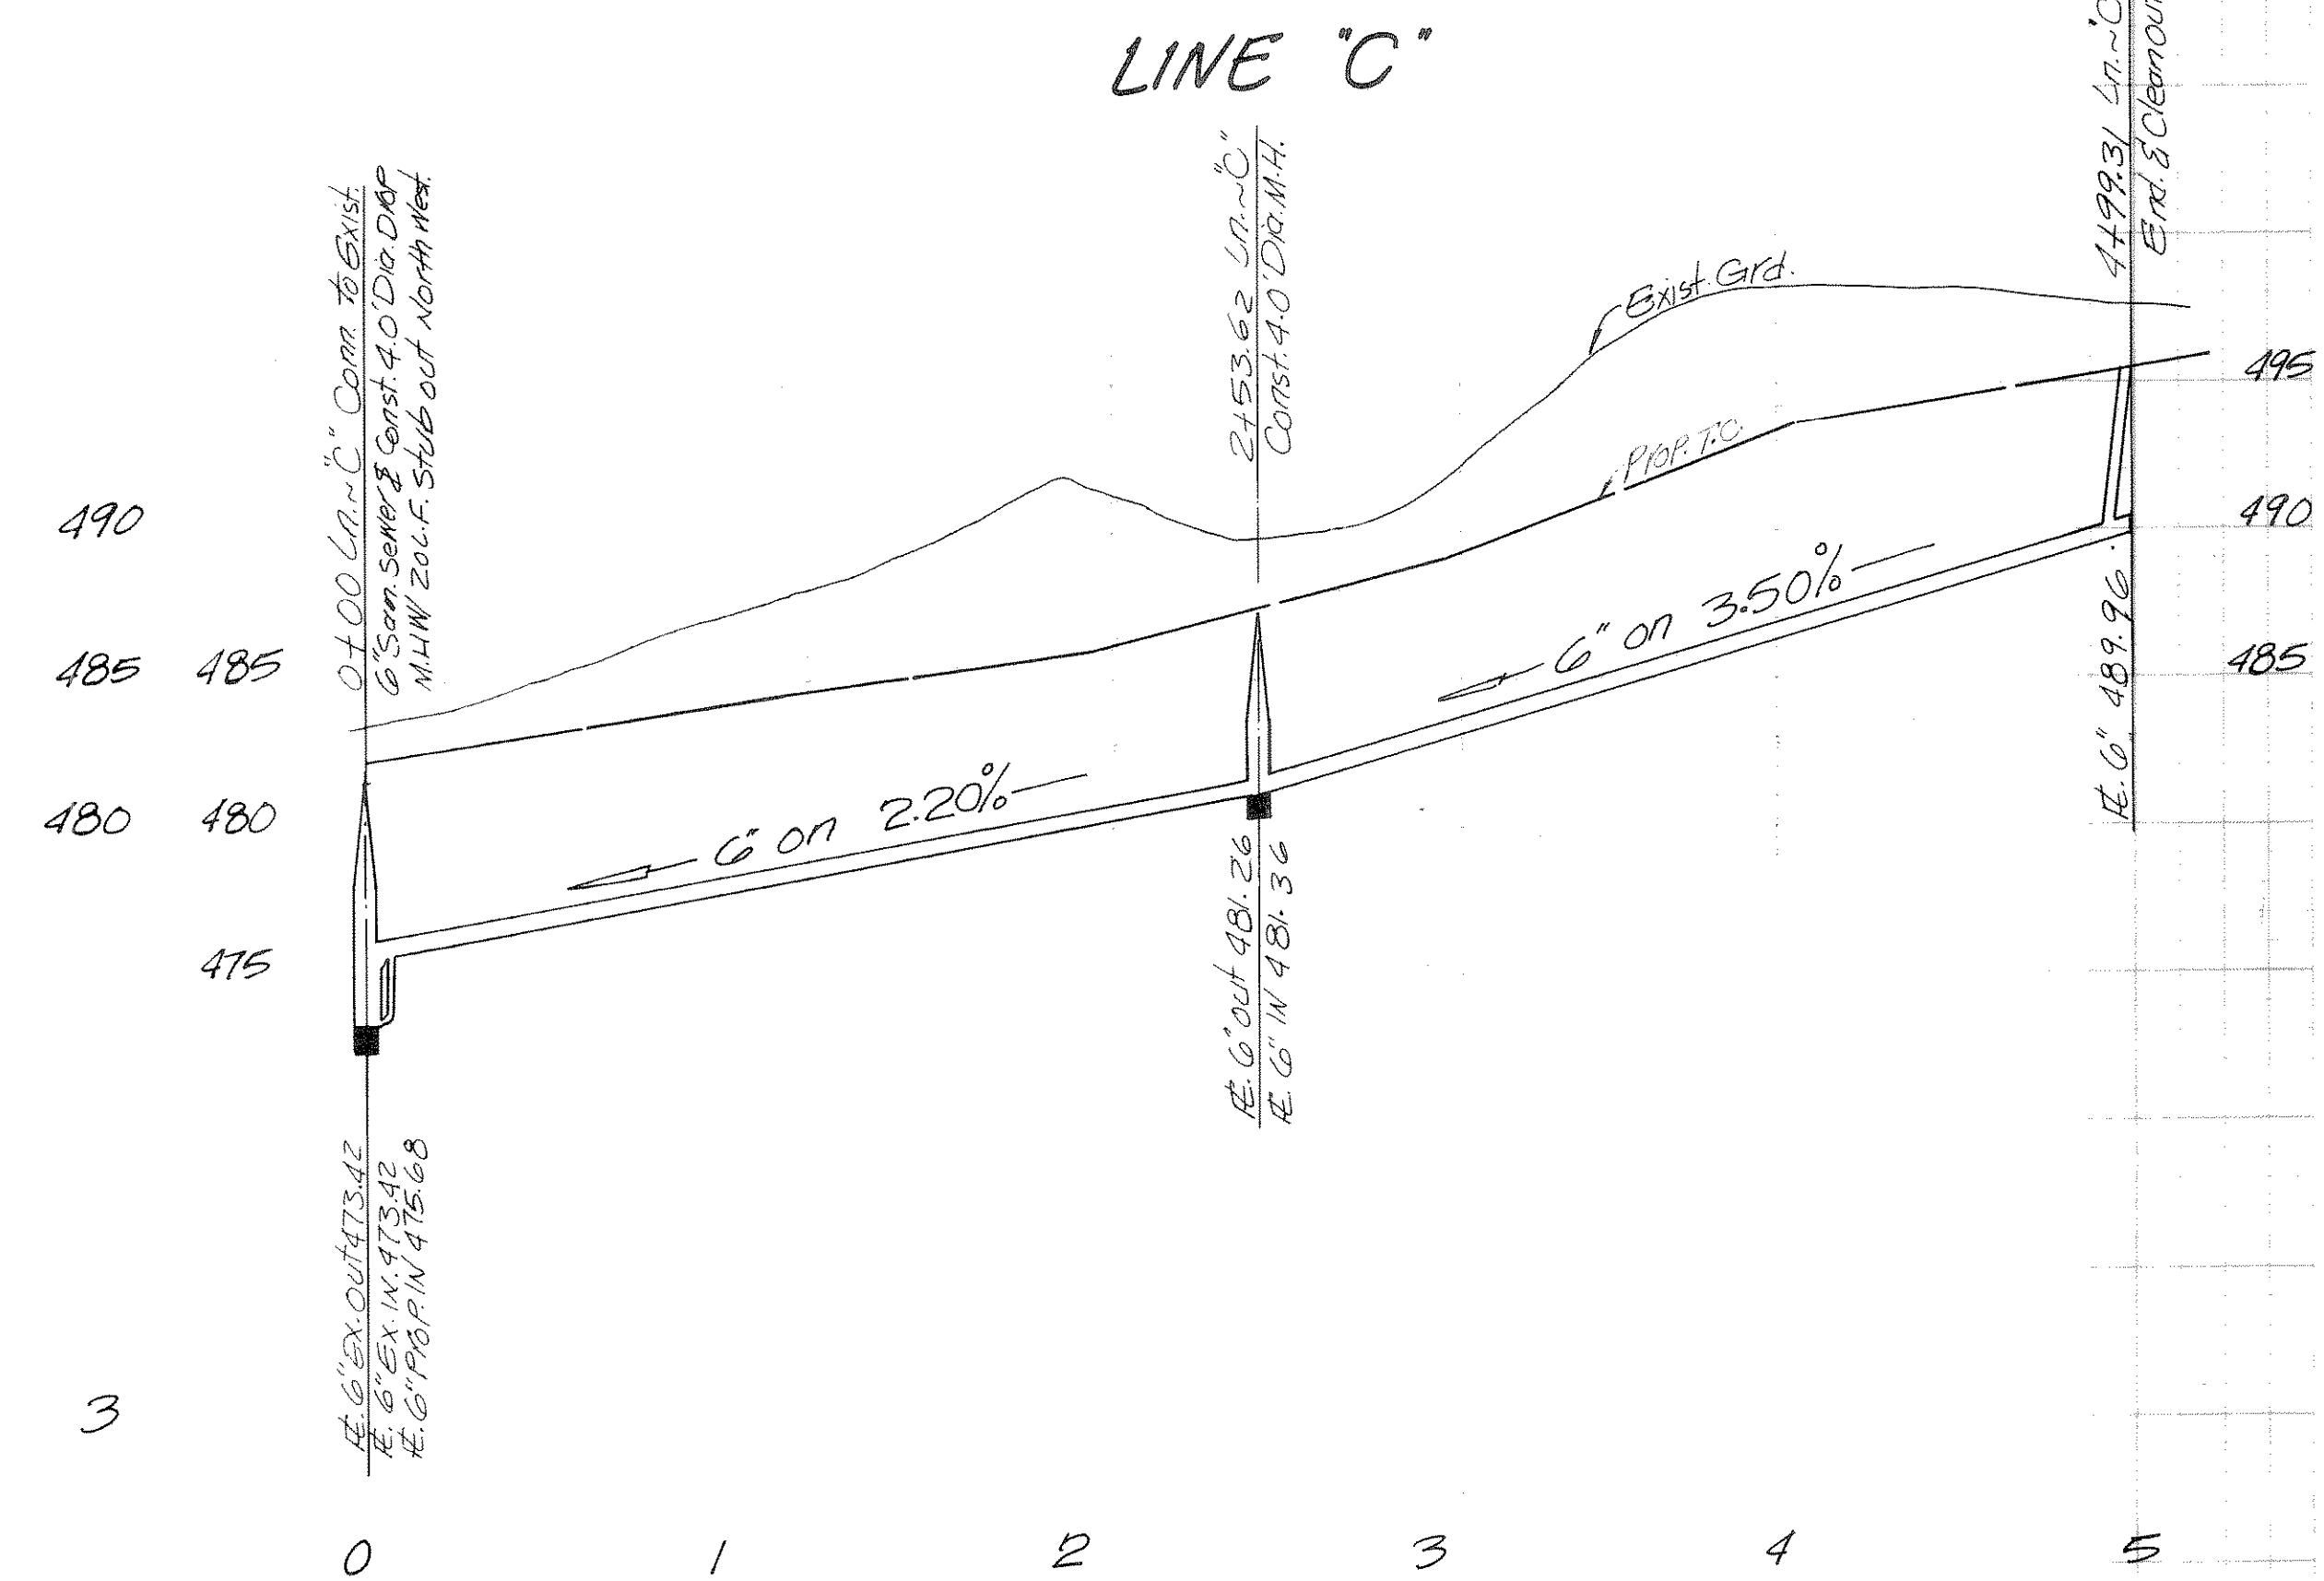
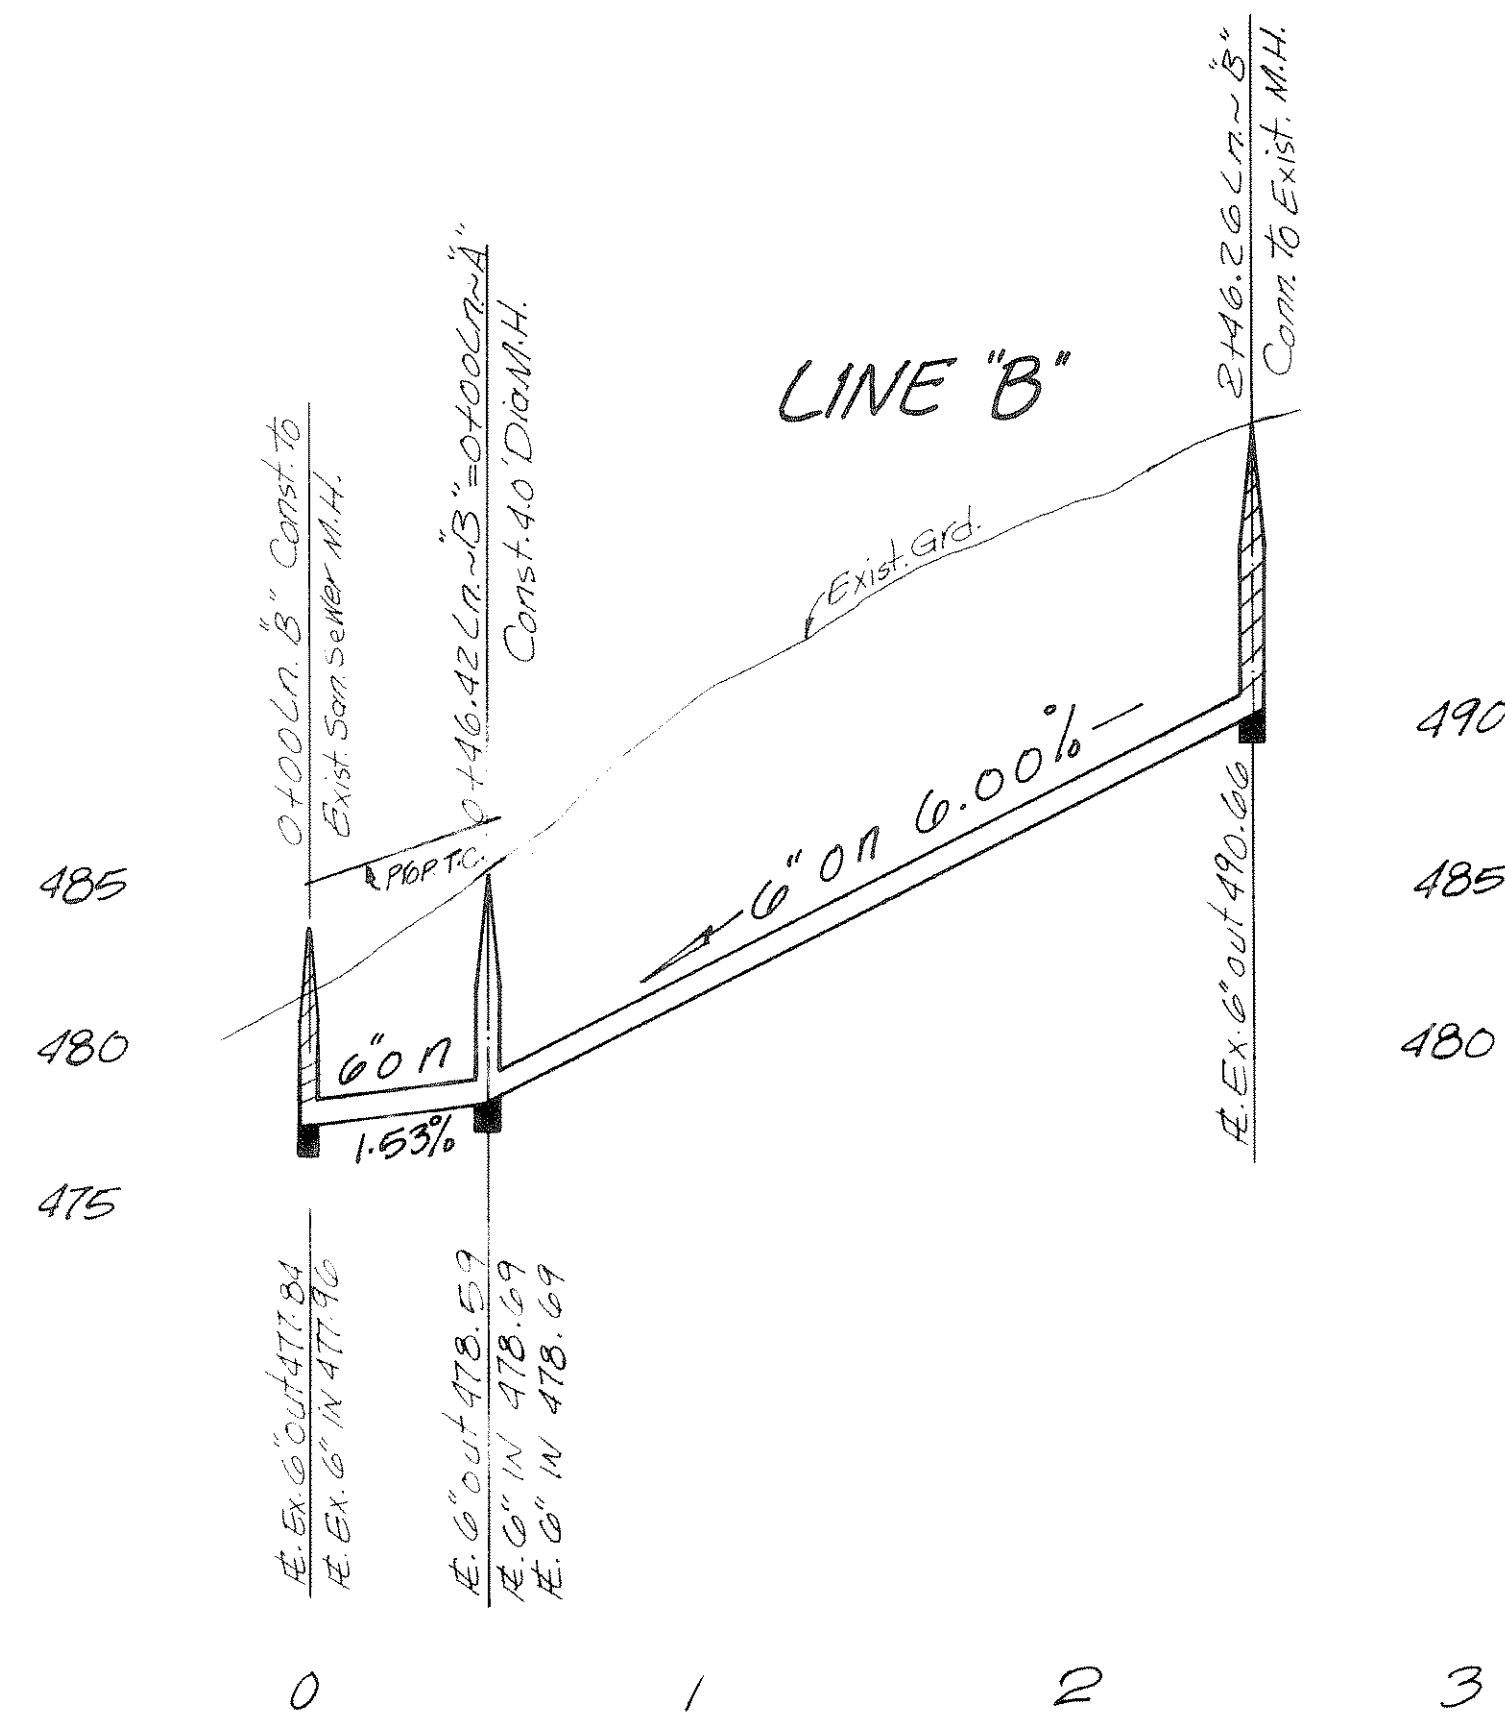


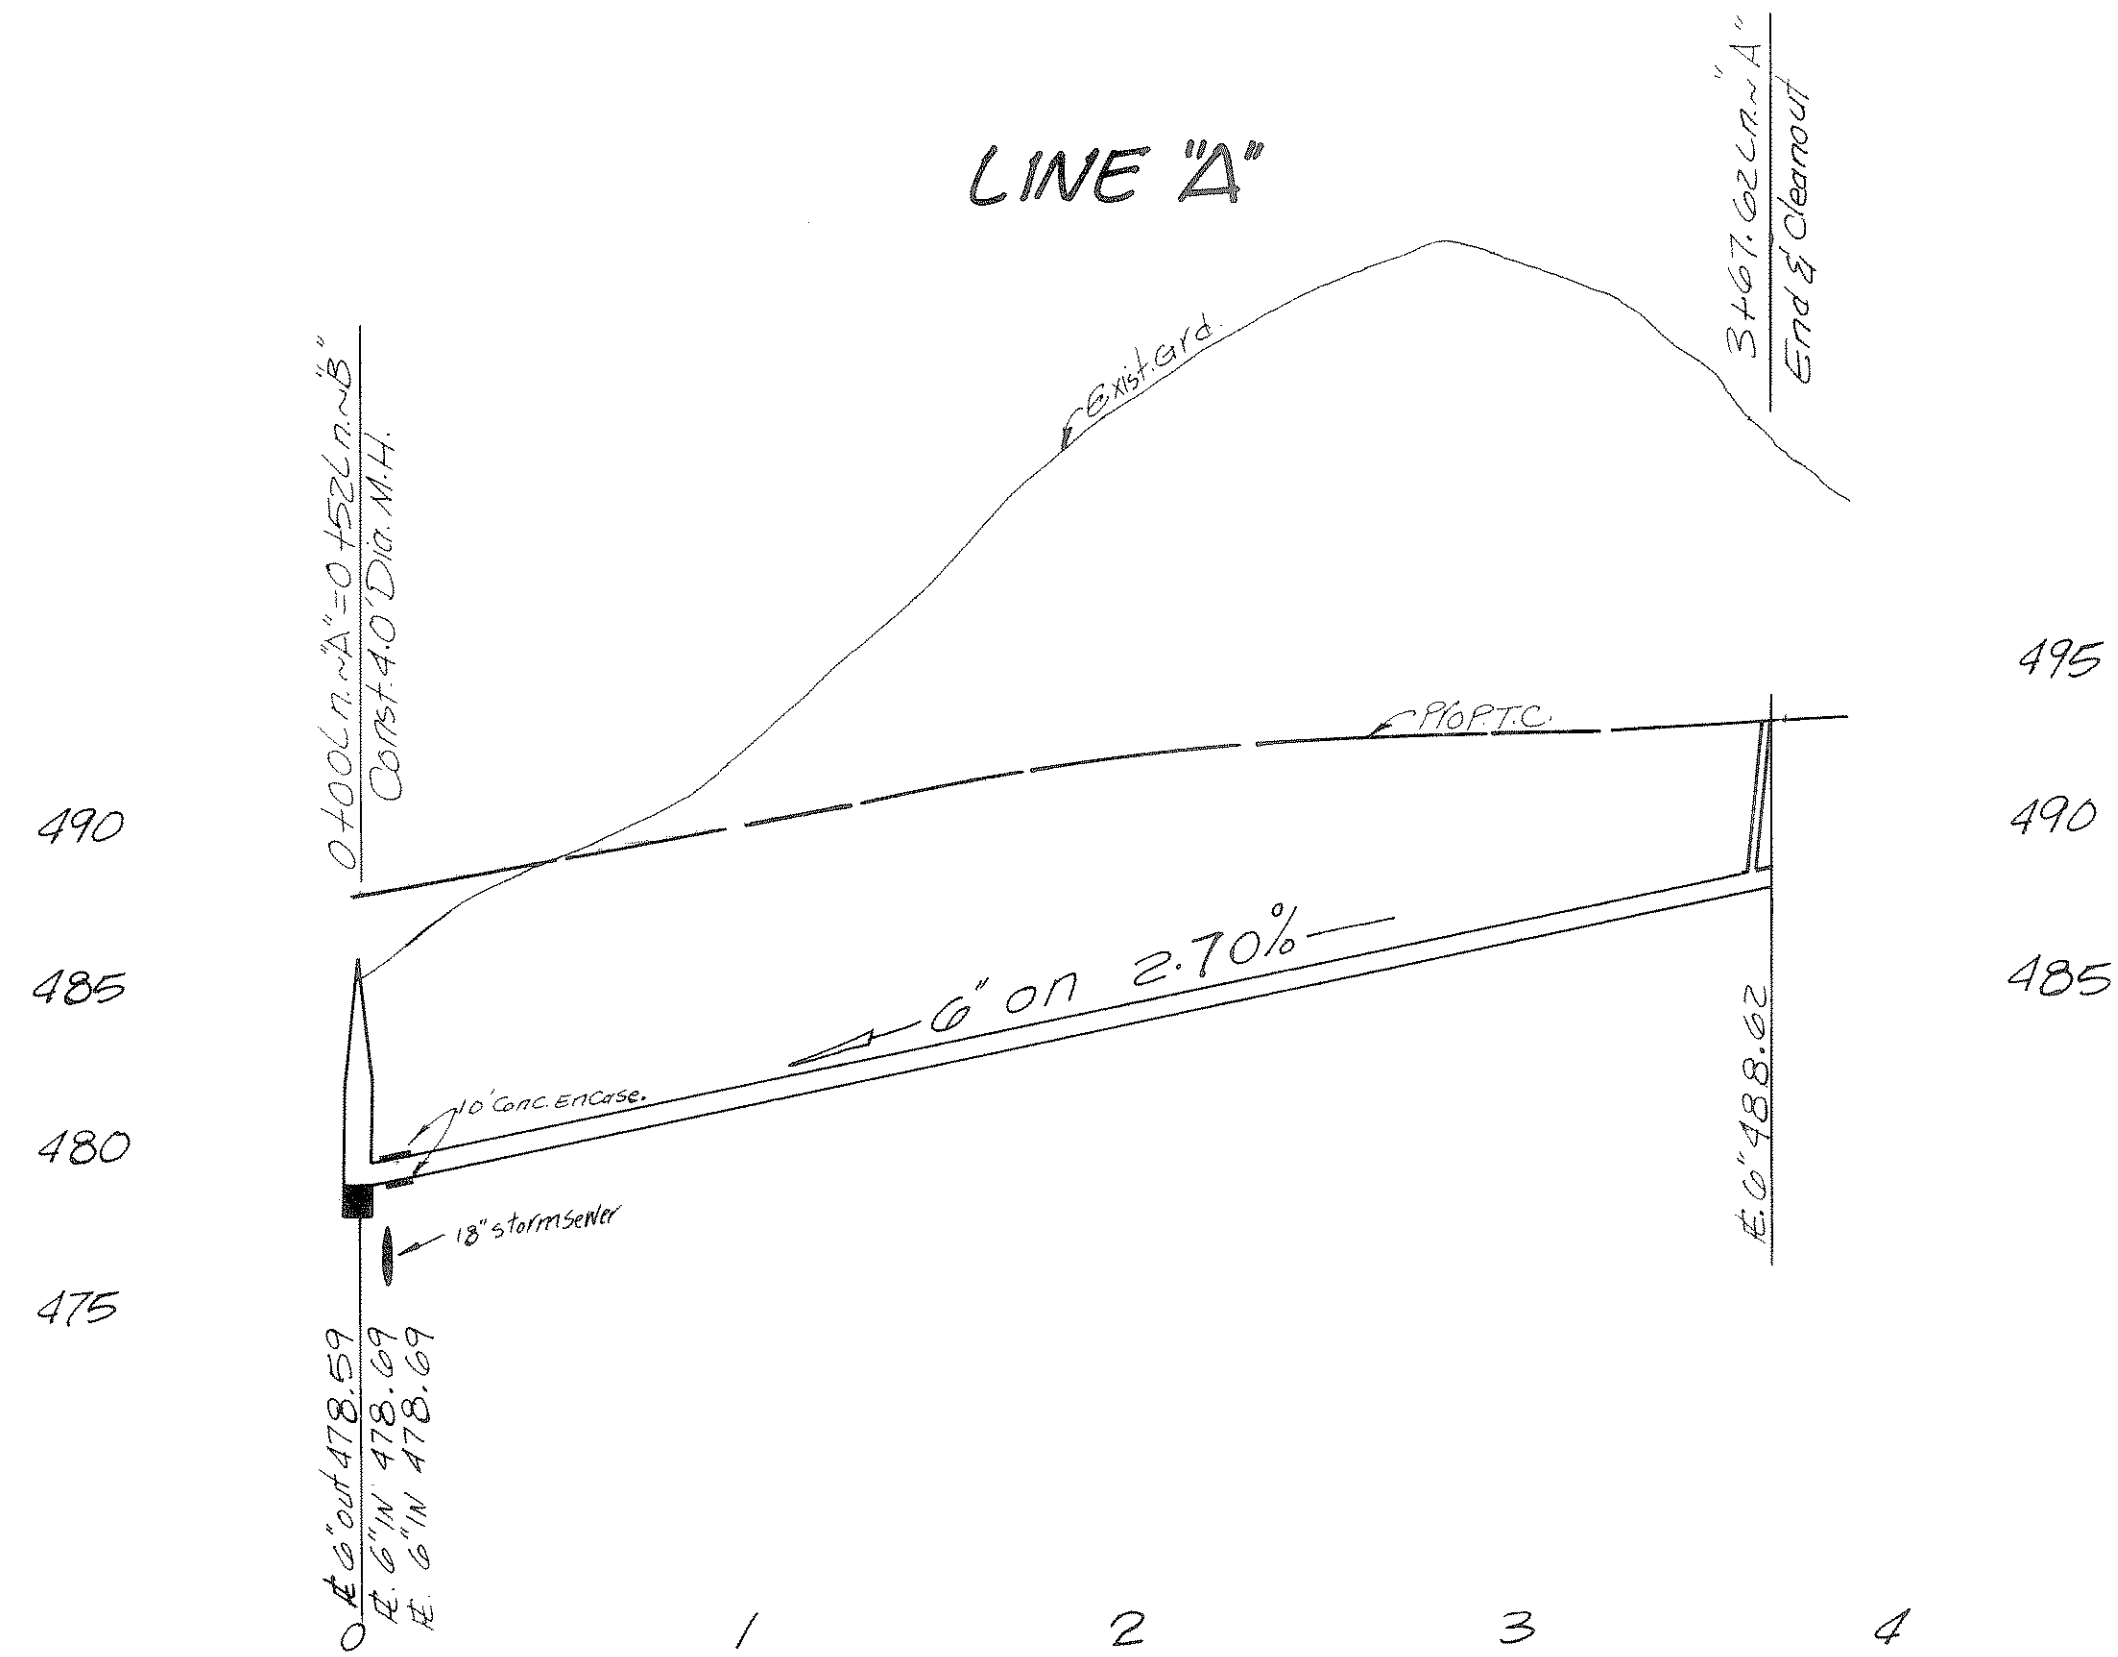

AS BUILT

SANITARY SEWER PROFILE
 CHANDLERS LANDING PHASE FOUR
 CITY OF ROCKWALL
 ROCKWALL COUNTY, TEXAS
 HAROLD L. EVANS-CONSULTING ENGINEER

D.M.H. D.M.H. 8-10-84 1"=50'
 1"=60'

Rev 8-26-84

7 OF 7

NO

72122