


INLET	D.A.	Q _p	CARRY	TOTAL	Z	Z/N	S _o	Y _o	PONDED	L _o	L _o	L _o	L _o	L _o	L _o	L _o	L _o	REMARKS
TYPE & NO.	STATION	NO.	C.F.S.	OVER FLOW C.F.S.			FT/FT	FT	WIDTH	C.F.S.	FT	FT	FT	FT	FT	FT	FT	
10' 24+25	3	8.60	0	8.60	29	1812	0	0.42	12.20	1.05	8.20	10'	1.22	1.0	8.60	0		
10' 24+25	3	8.61	0	8.61	29	1812	0	0.42	12.20	1.05	8.20	10'	1.22	1.0	8.61	0		
10' 18+05	4	7.23	0	7.23	29	1812	0	0.42	12.20	1.05	6.89	10'	1.45	1.0	7.23	0		
10' 18+05	4	7.23	0	7.23	29	1812	0	0.42	12.20	1.05	6.89	10'	1.45	1.0	7.23	0		

DRAINAGE DATA

AREA	ACRES	t _c	C	I _s	Q _s	Q _s ACC.	I ₂₅	Q ₂₅	Q ₂₅ ACC.
1	2.09	10	0.65	6.20	8.42		8.30	11.28	
2	2.16	10	0.65	6.20	8.70	17.12	8.30	11.65	22.93
3	3.19	10	0.65	6.20	12.86	29.98	8.30	17.21	40.14
4	2.68	10	0.65	6.20	10.80		8.30	14.46	

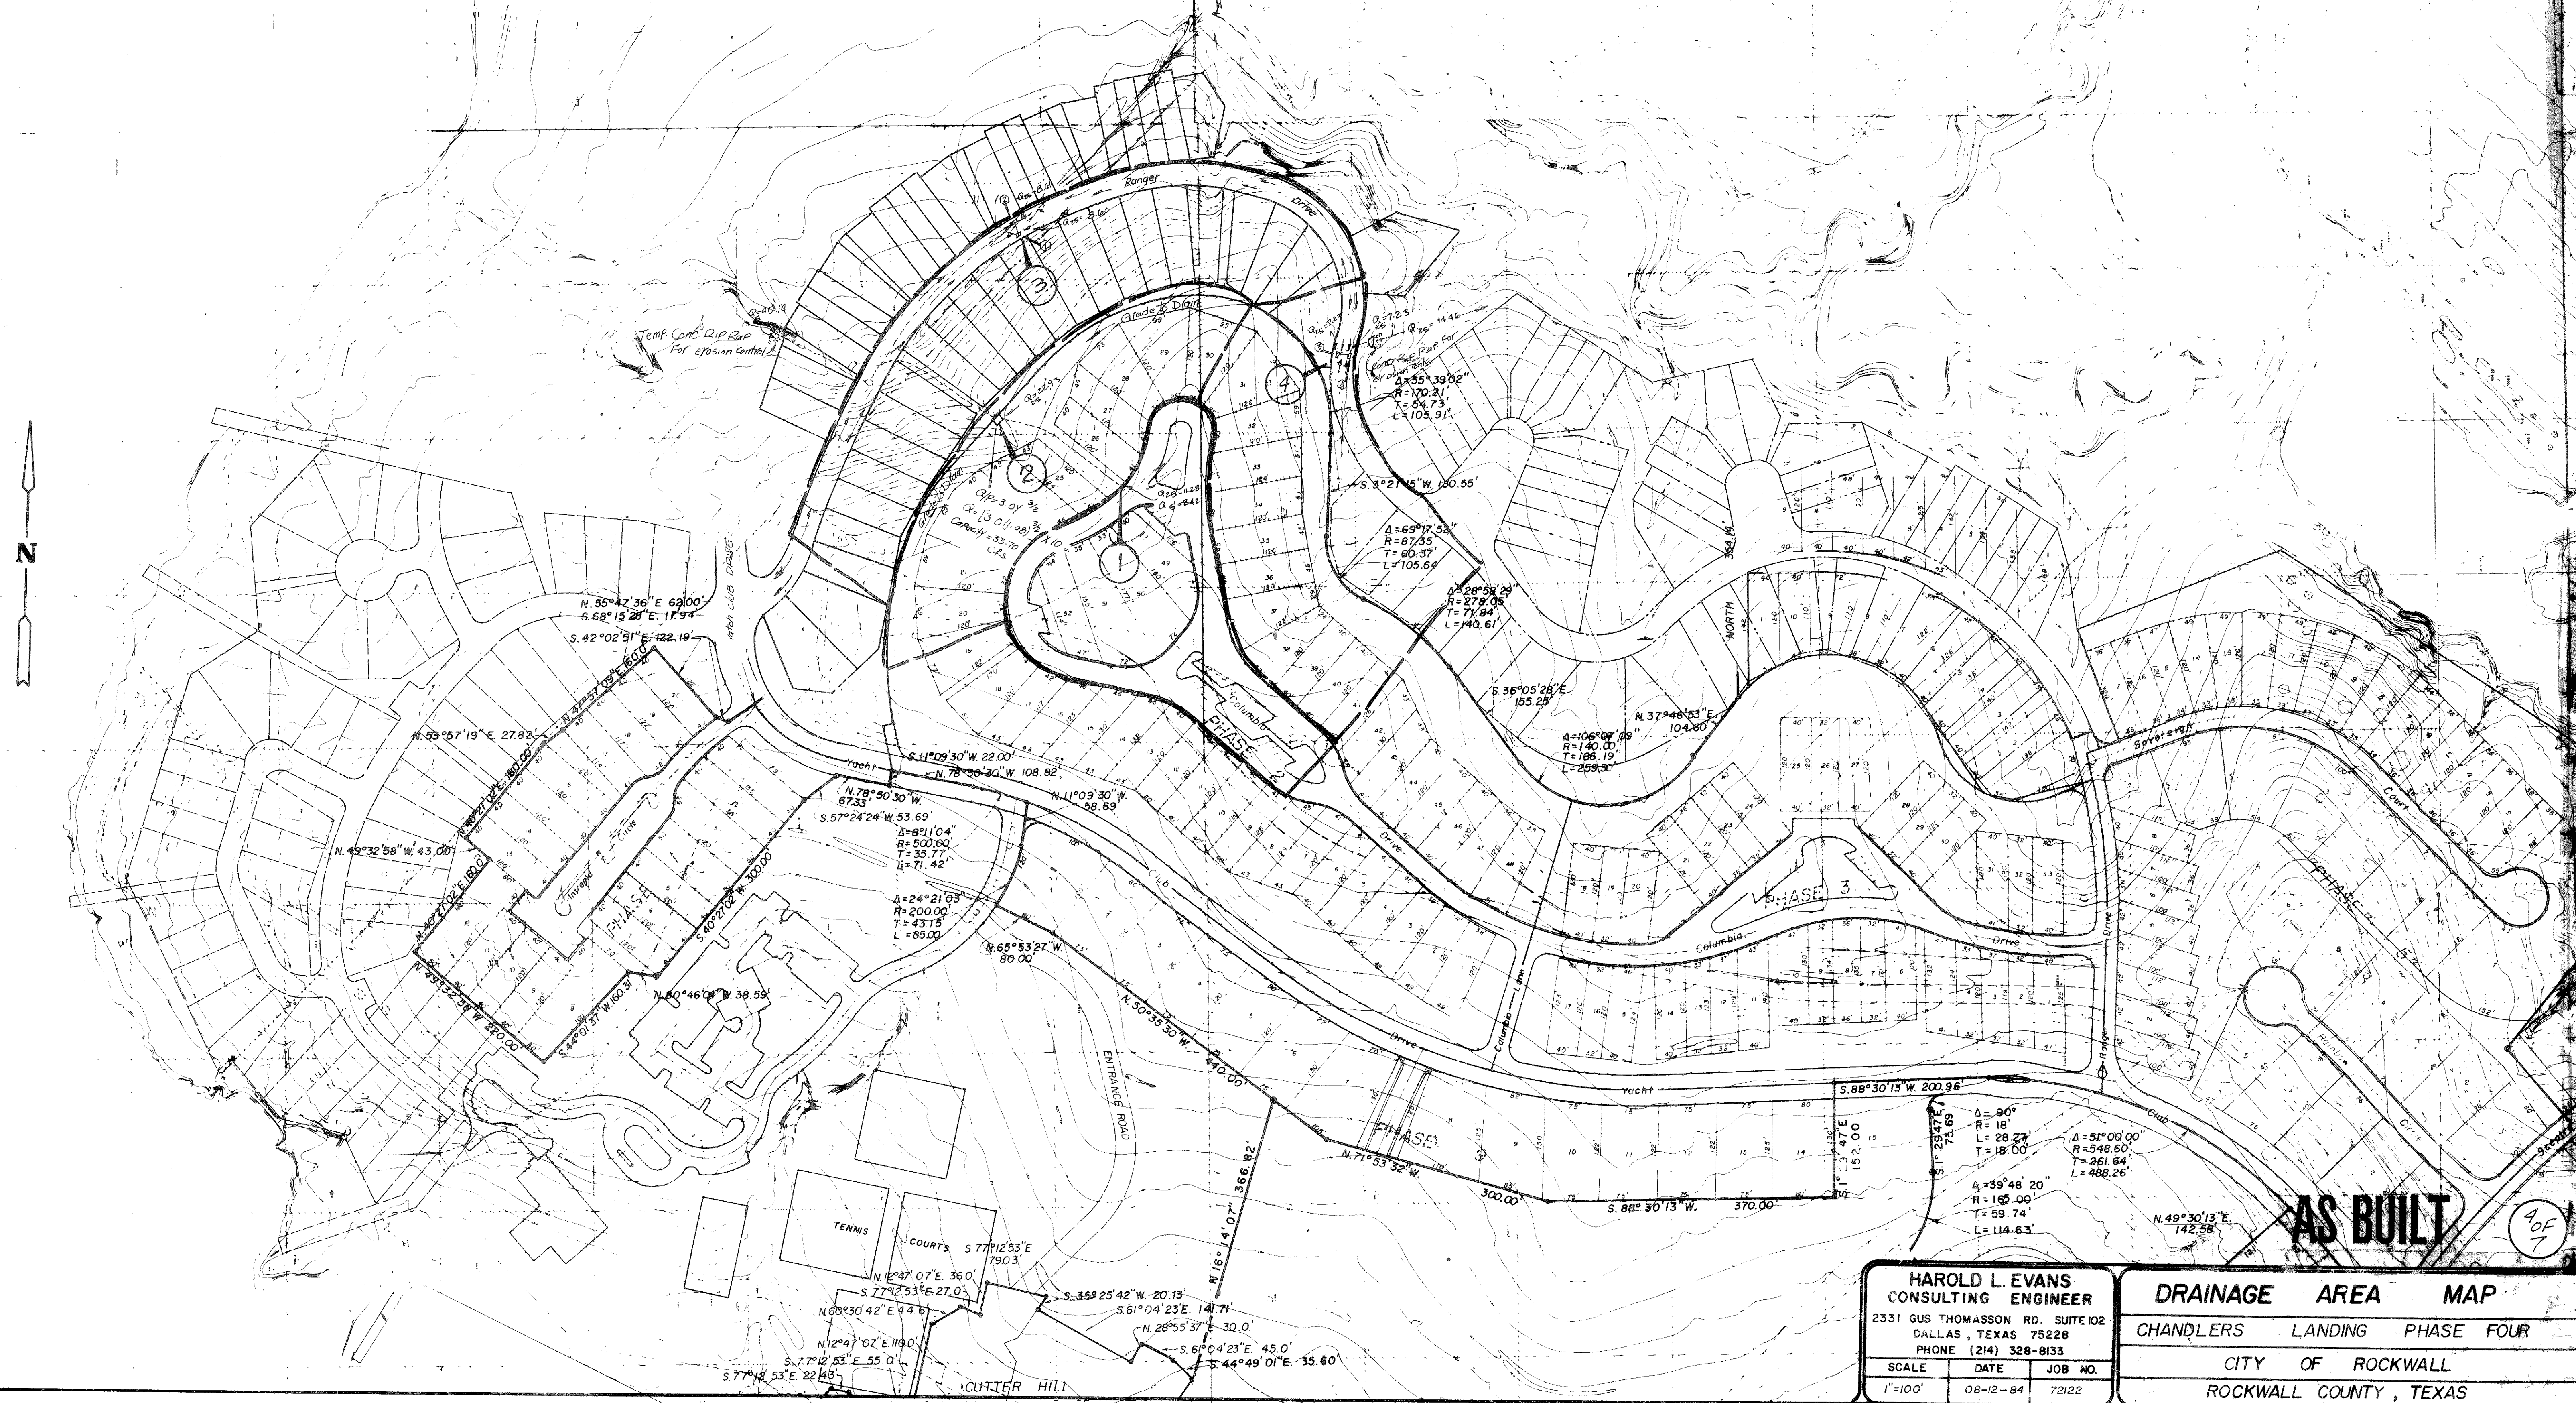

HAROLD L. EVANS CONSULTING ENGINEER 2331 GUS THOMASSON RD., SUITE 102 DALLAS, TEXAS 75228 PHONE (214) 328-8133			DRAINAGE AREA MAP CHANDLERS LANDING PHASE FOUR CITY OF ROCKWALL ROCKWALL COUNTY, TEXAS	
SCALE	DATE	JOB NO.		
1"=100'	08-12-84	72122		