
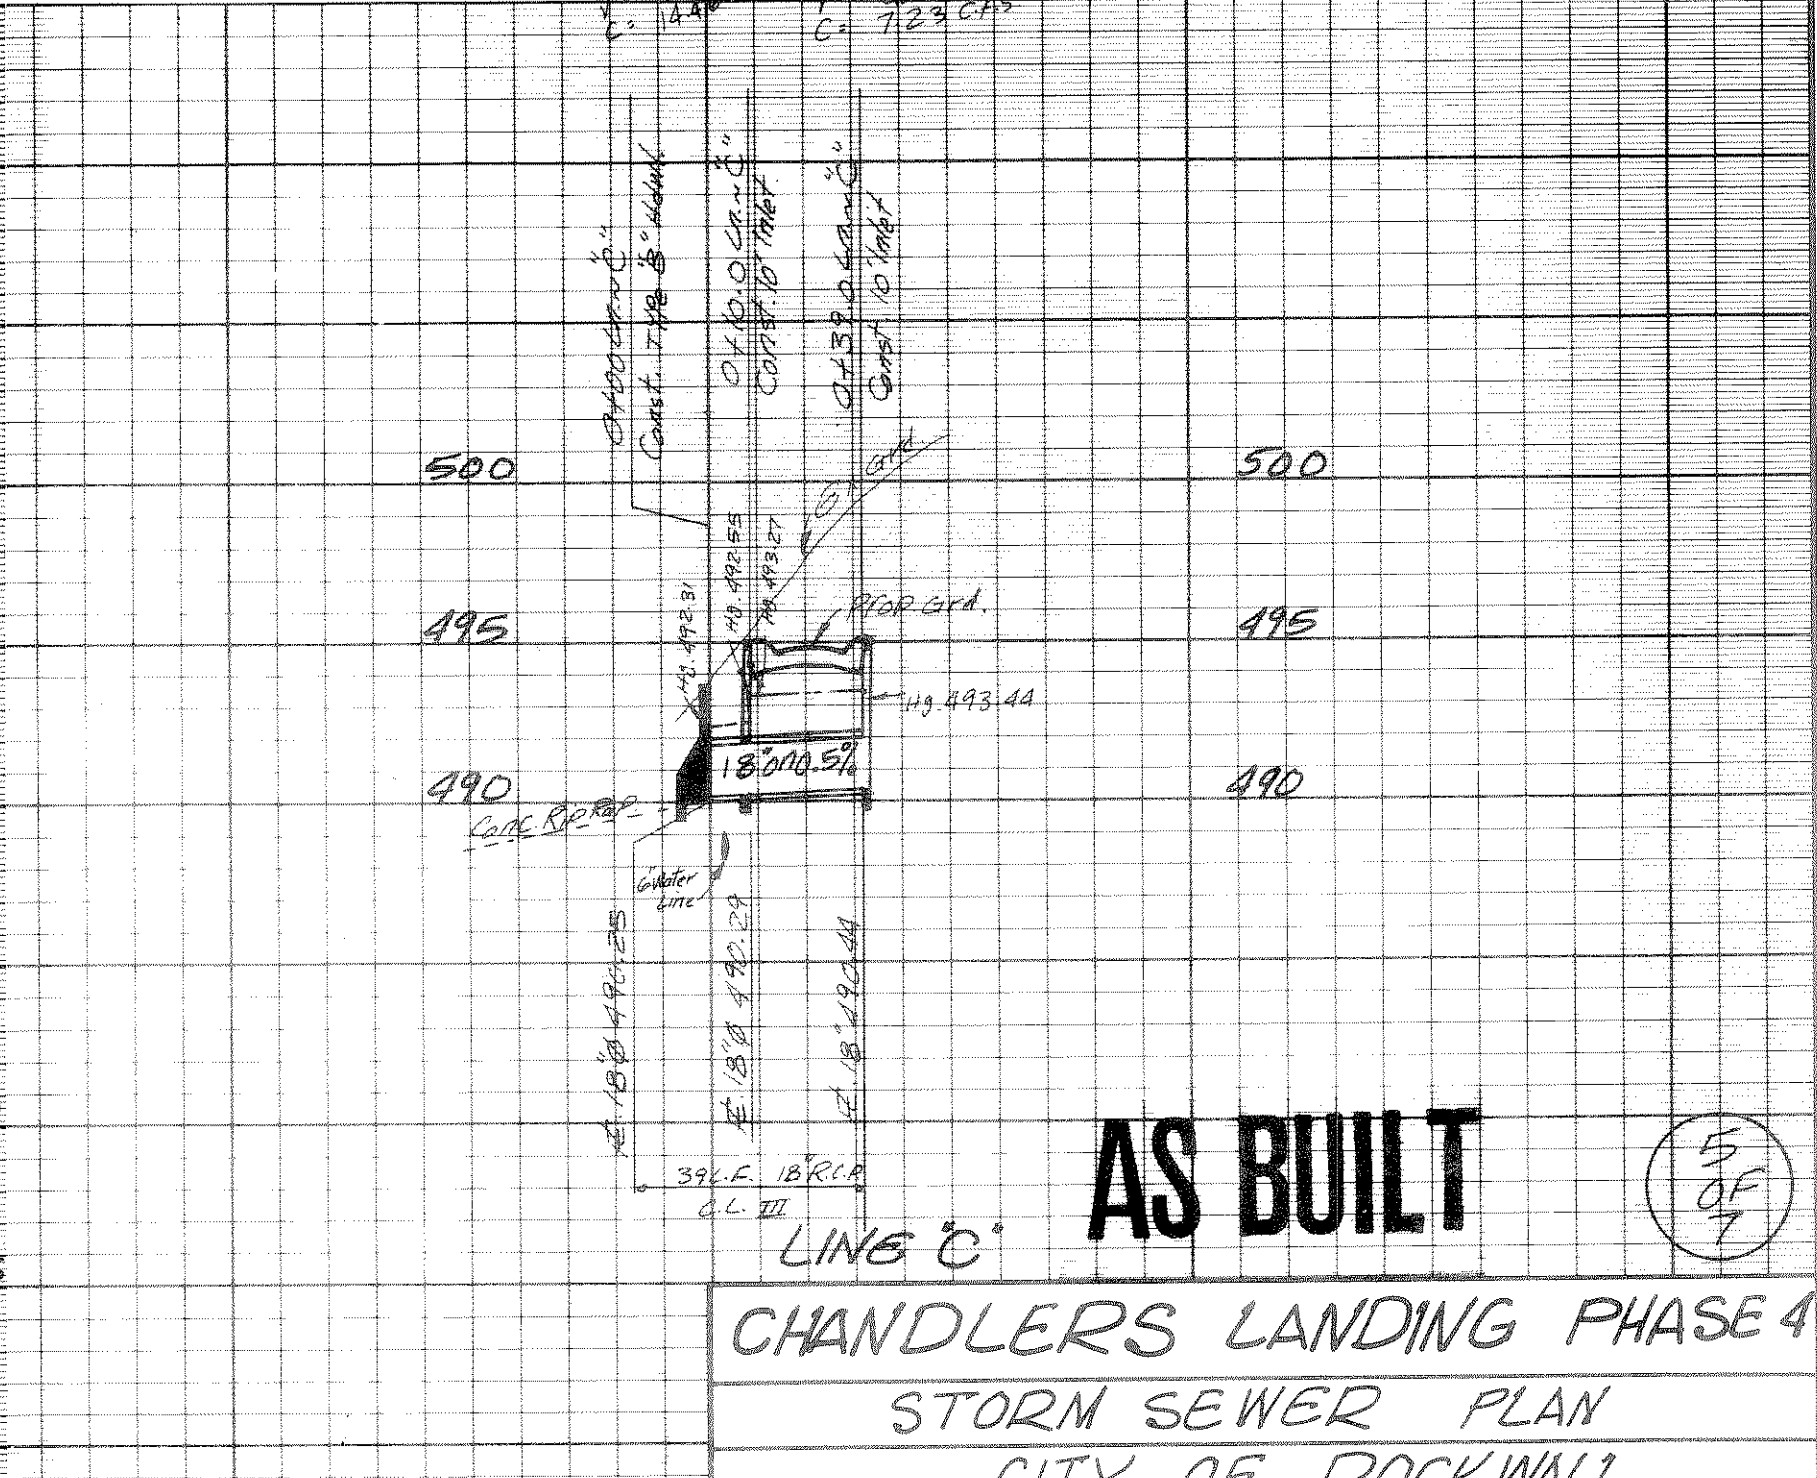
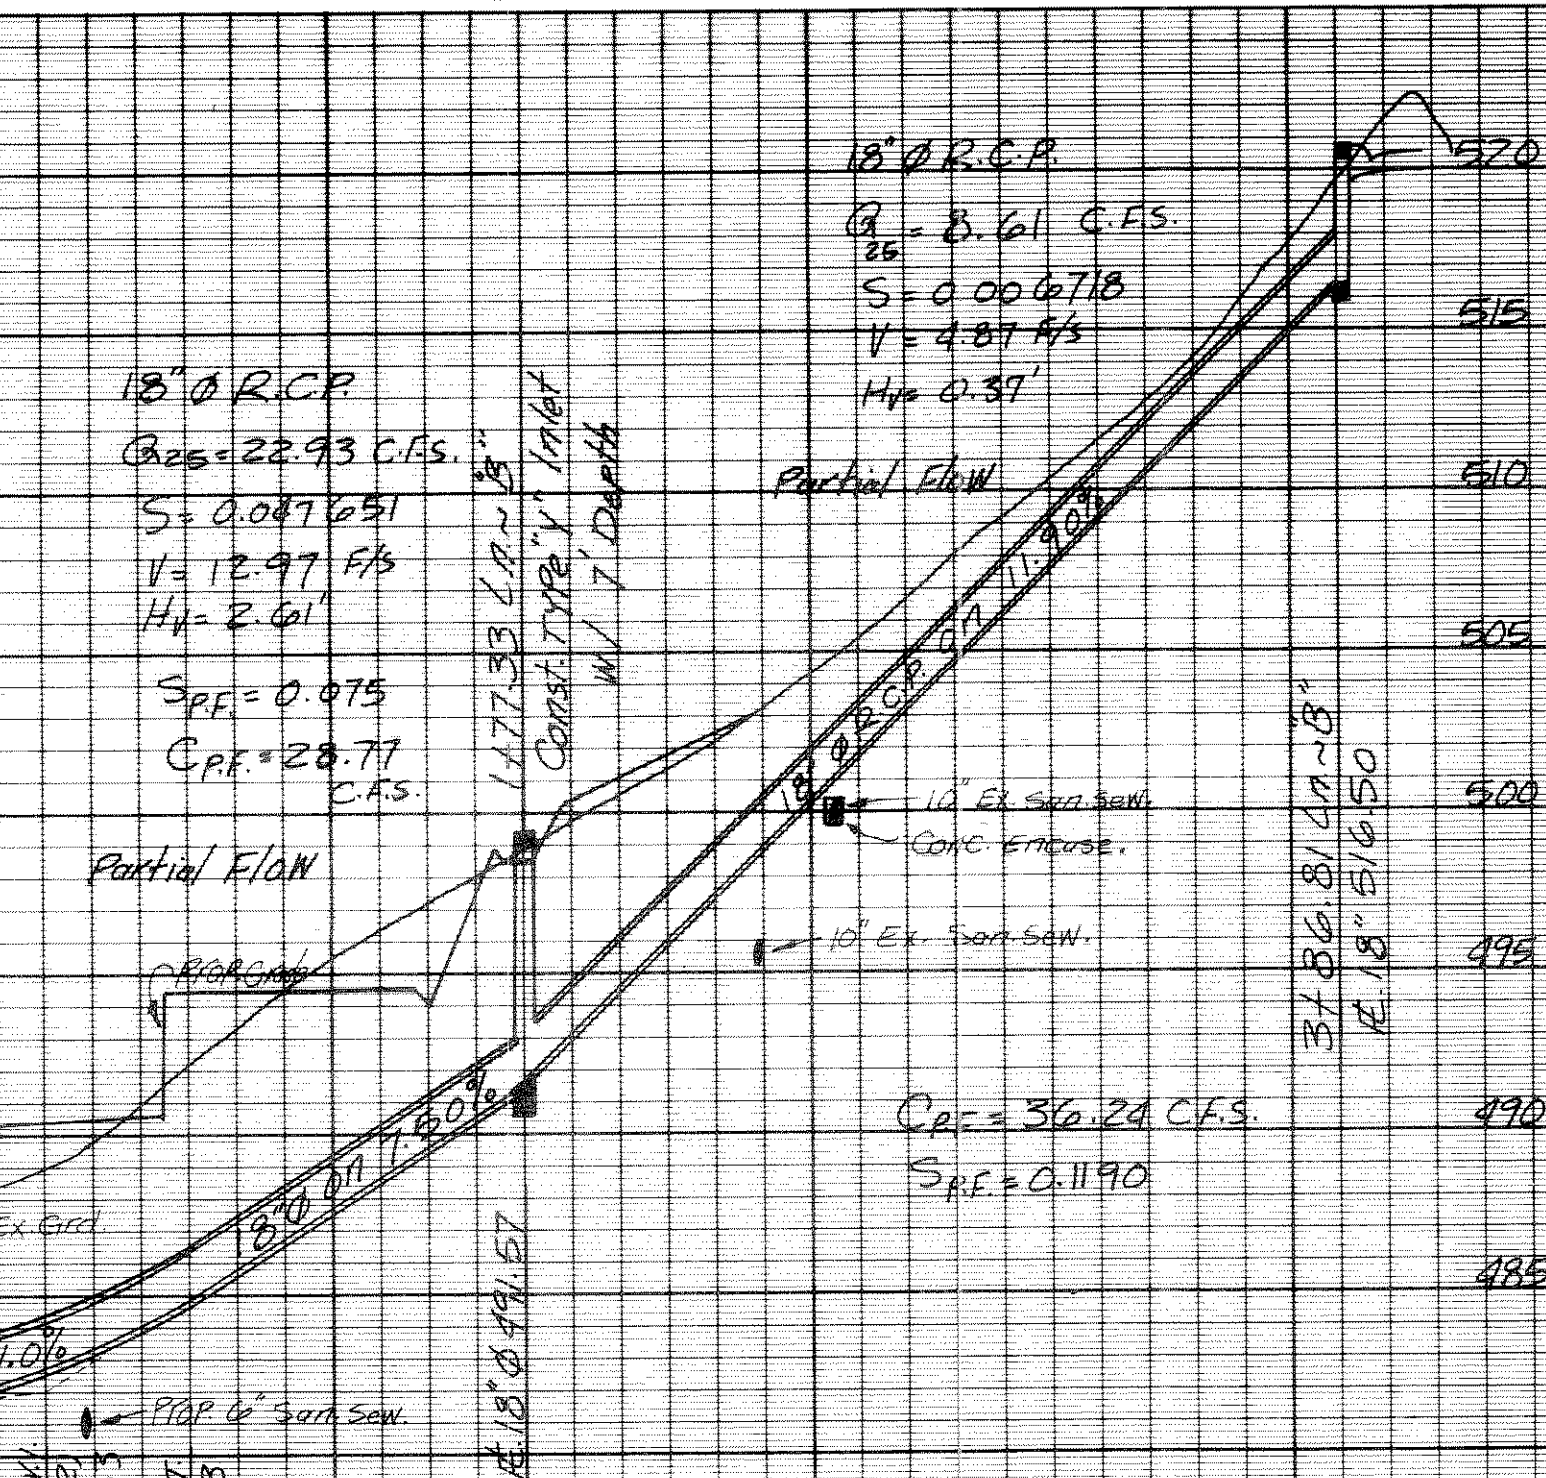
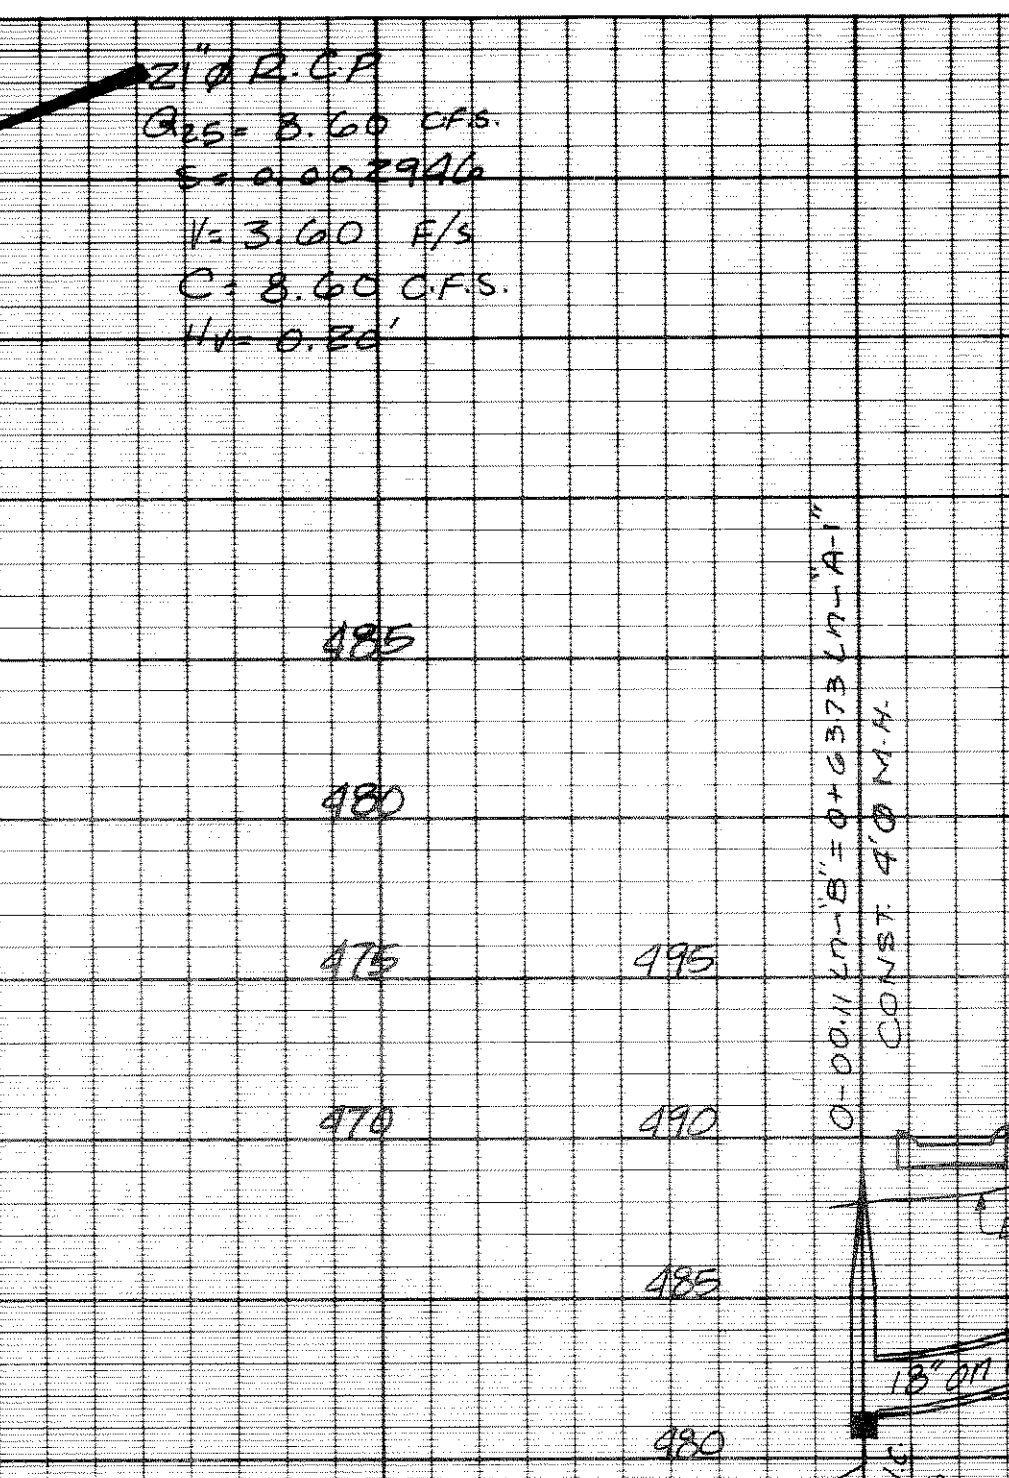
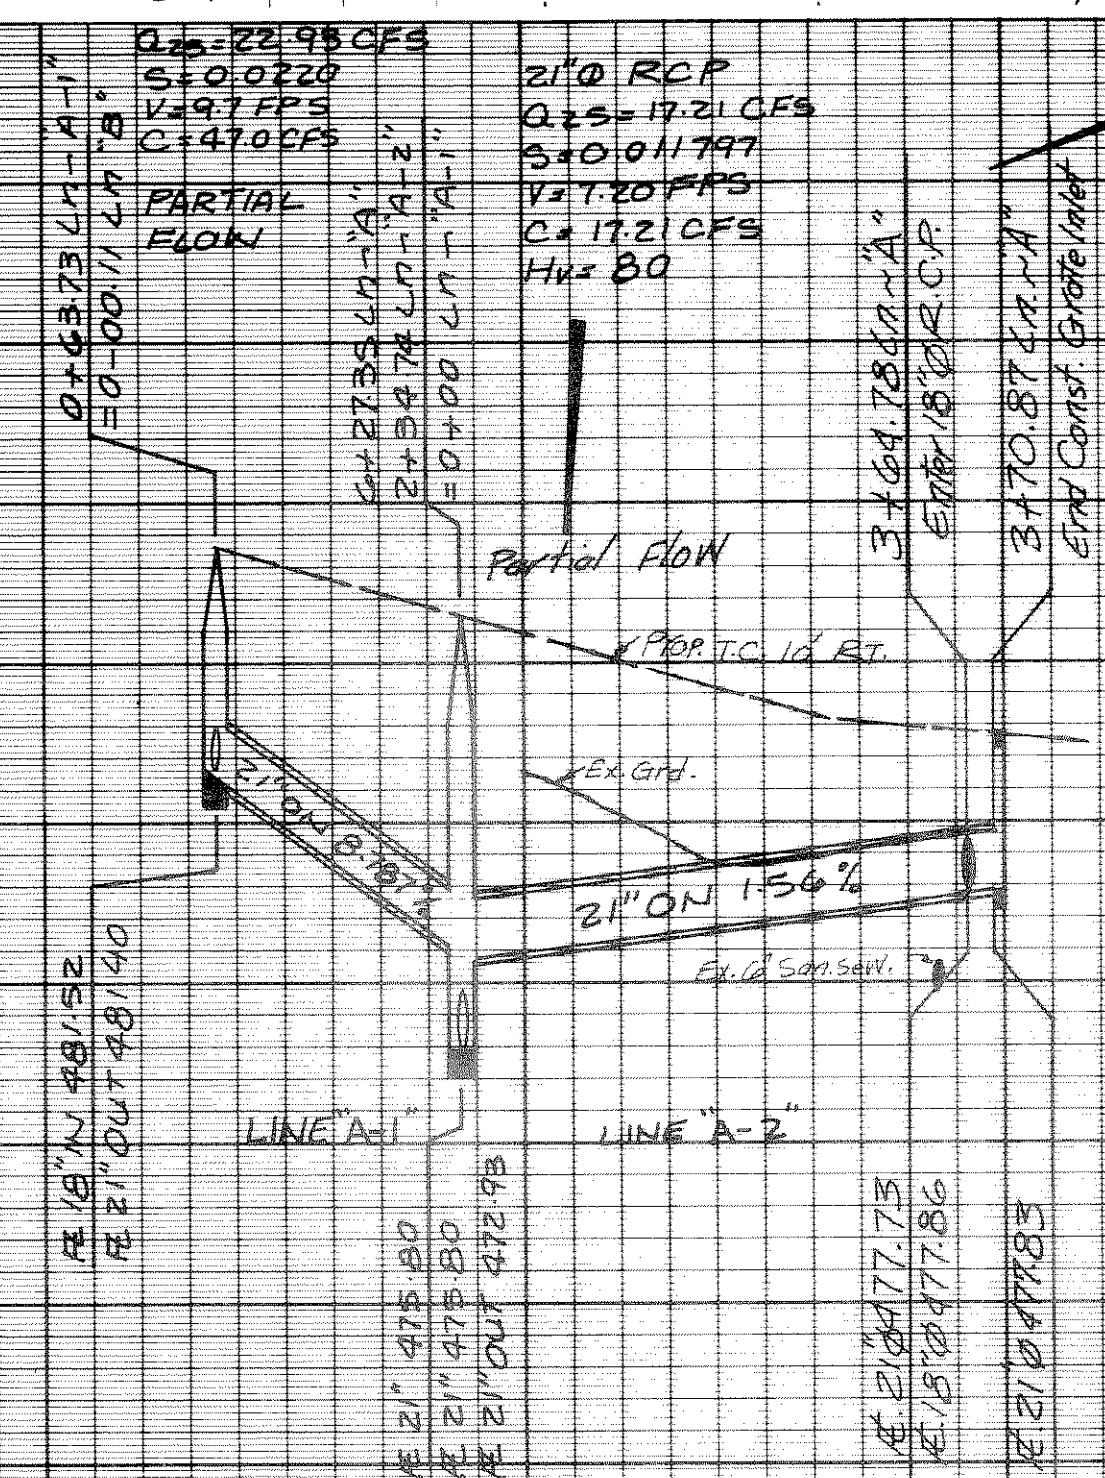


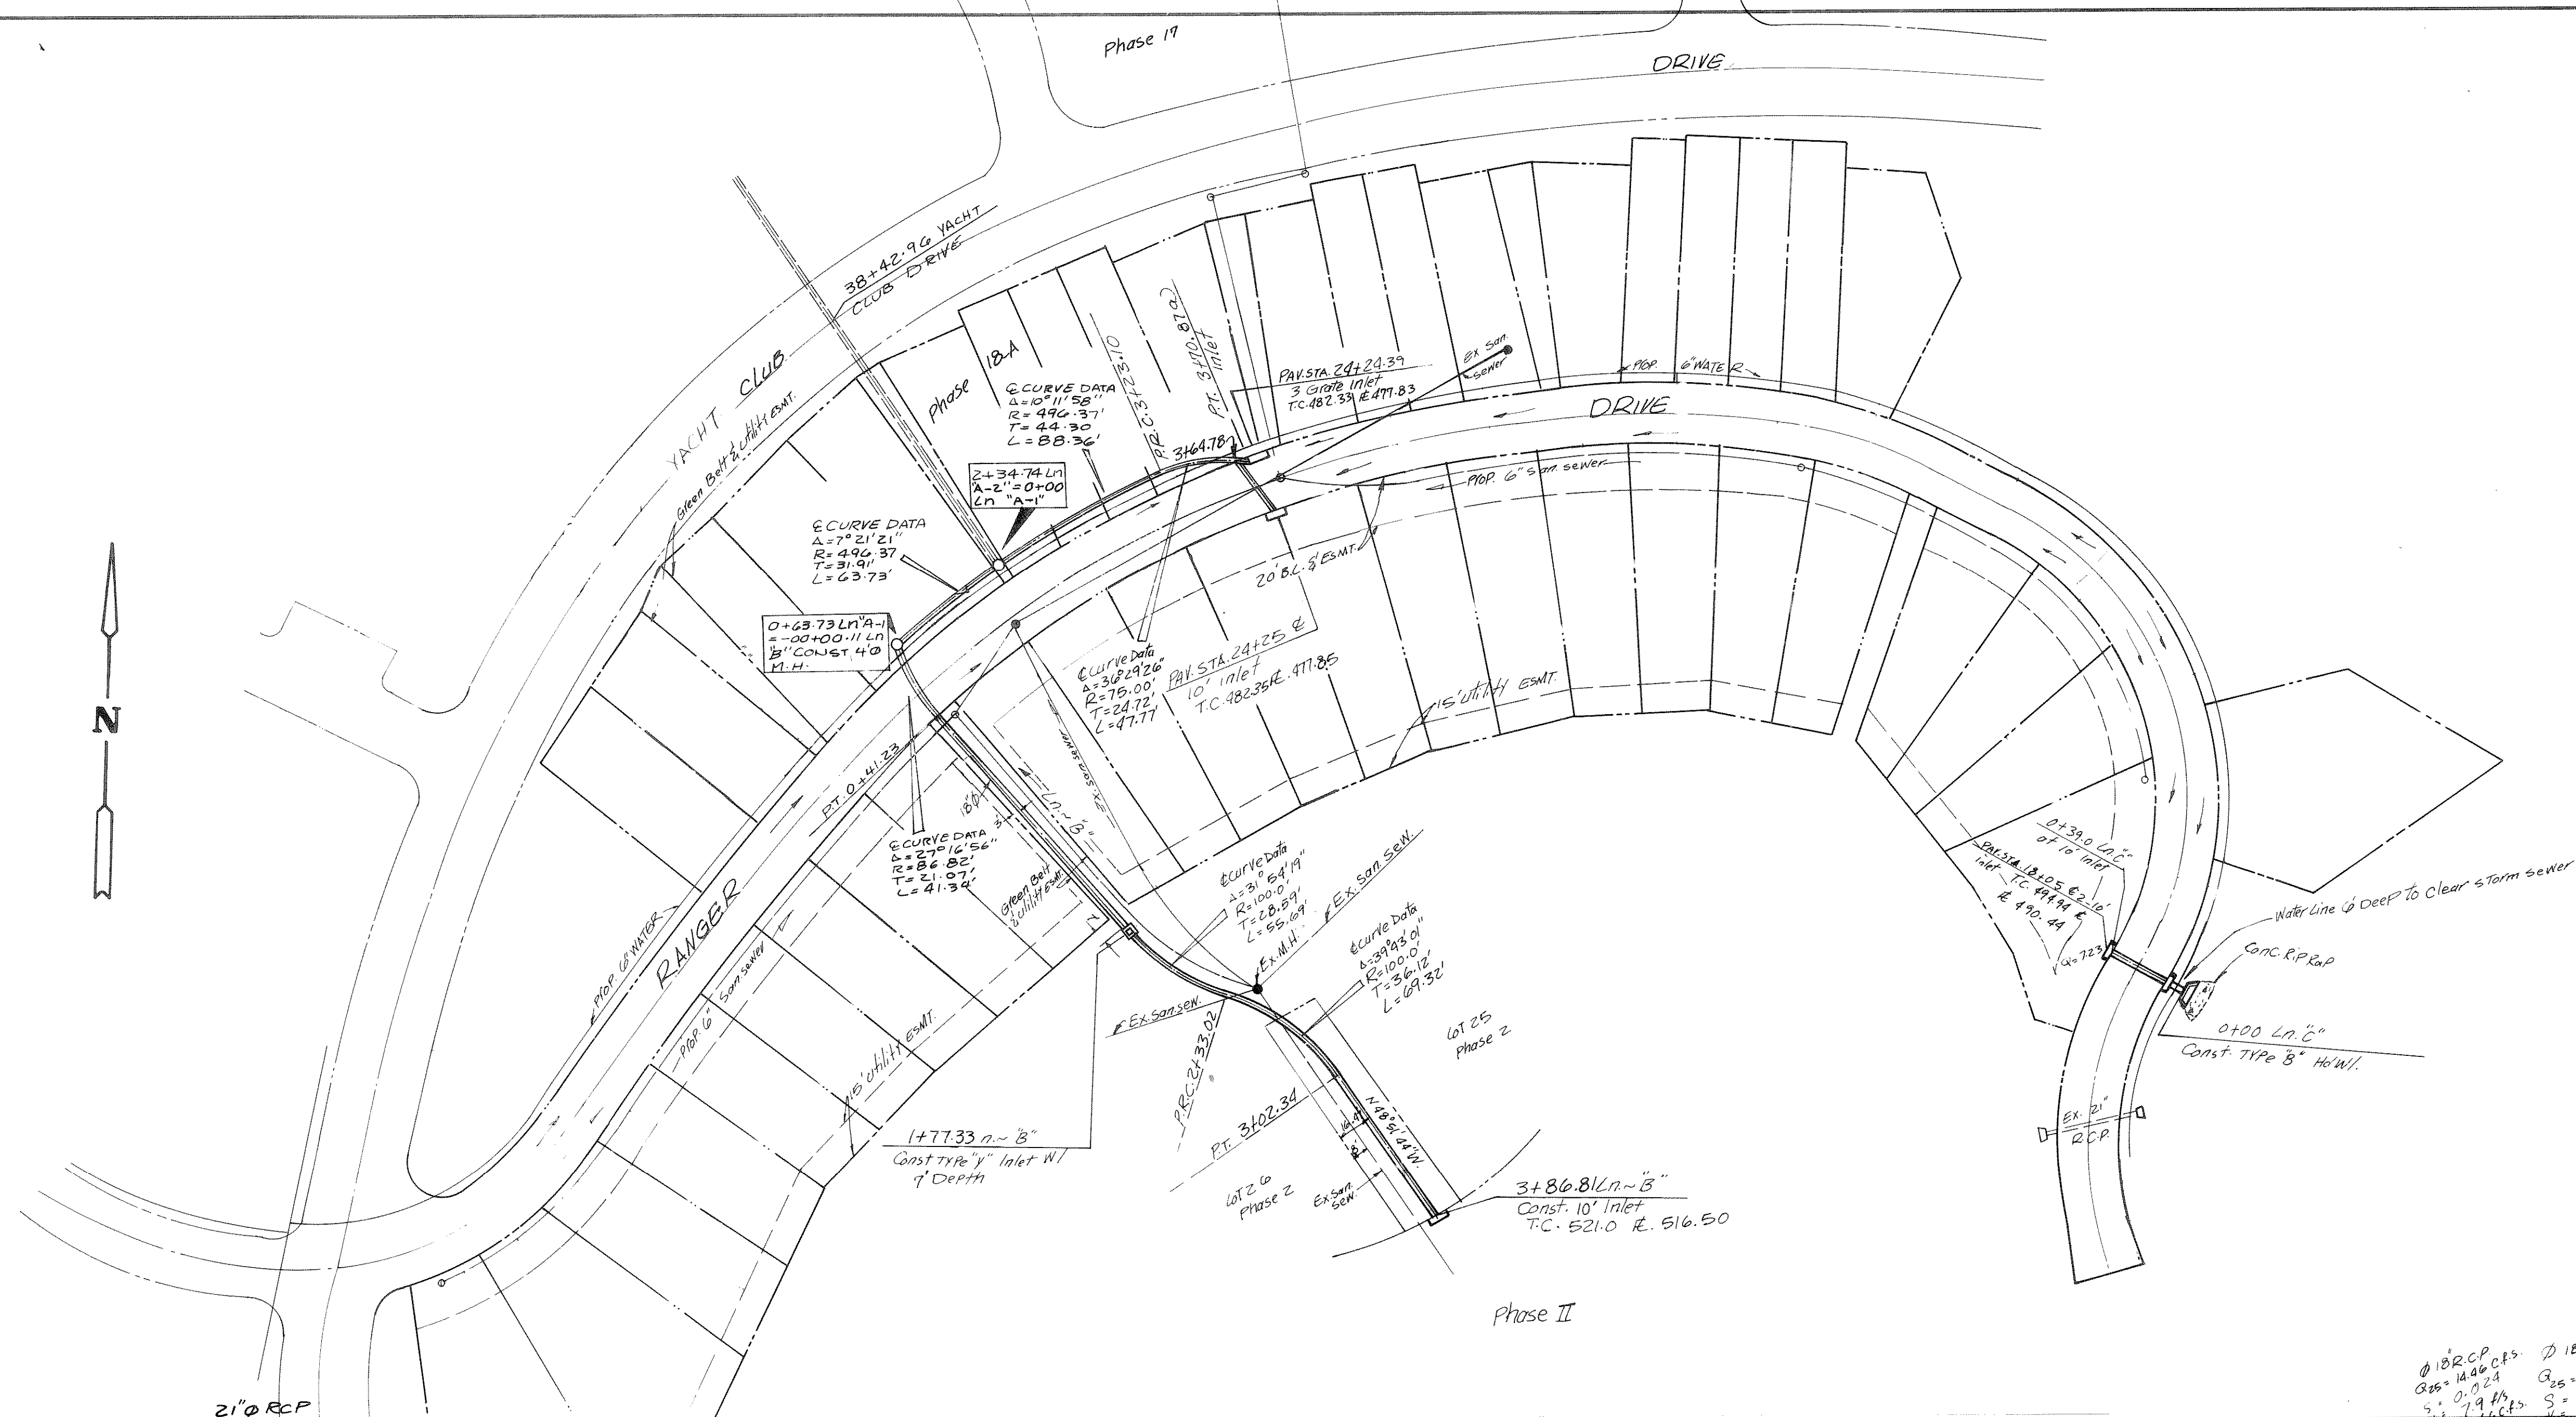

**AS BUILT**

**CHANDLERS LANDING PHASE 4**

**STORM SEWER PLAN**

**CITY OF ROCKWALL**

**ROCKWALL COUNTY, TEXAS**

**HAROLD L. EVANS - CONSULTING ENGINEER**

| DESIGN | DRAWN | DATE    | SCALE               | NOTES | FILE | NO.   |
|--------|-------|---------|---------------------|-------|------|-------|
| DMH    |       | 8-14-84 | 1"=50' H<br>1"=6' V |       |      | 72122 |

REVISED  
1-11-85