


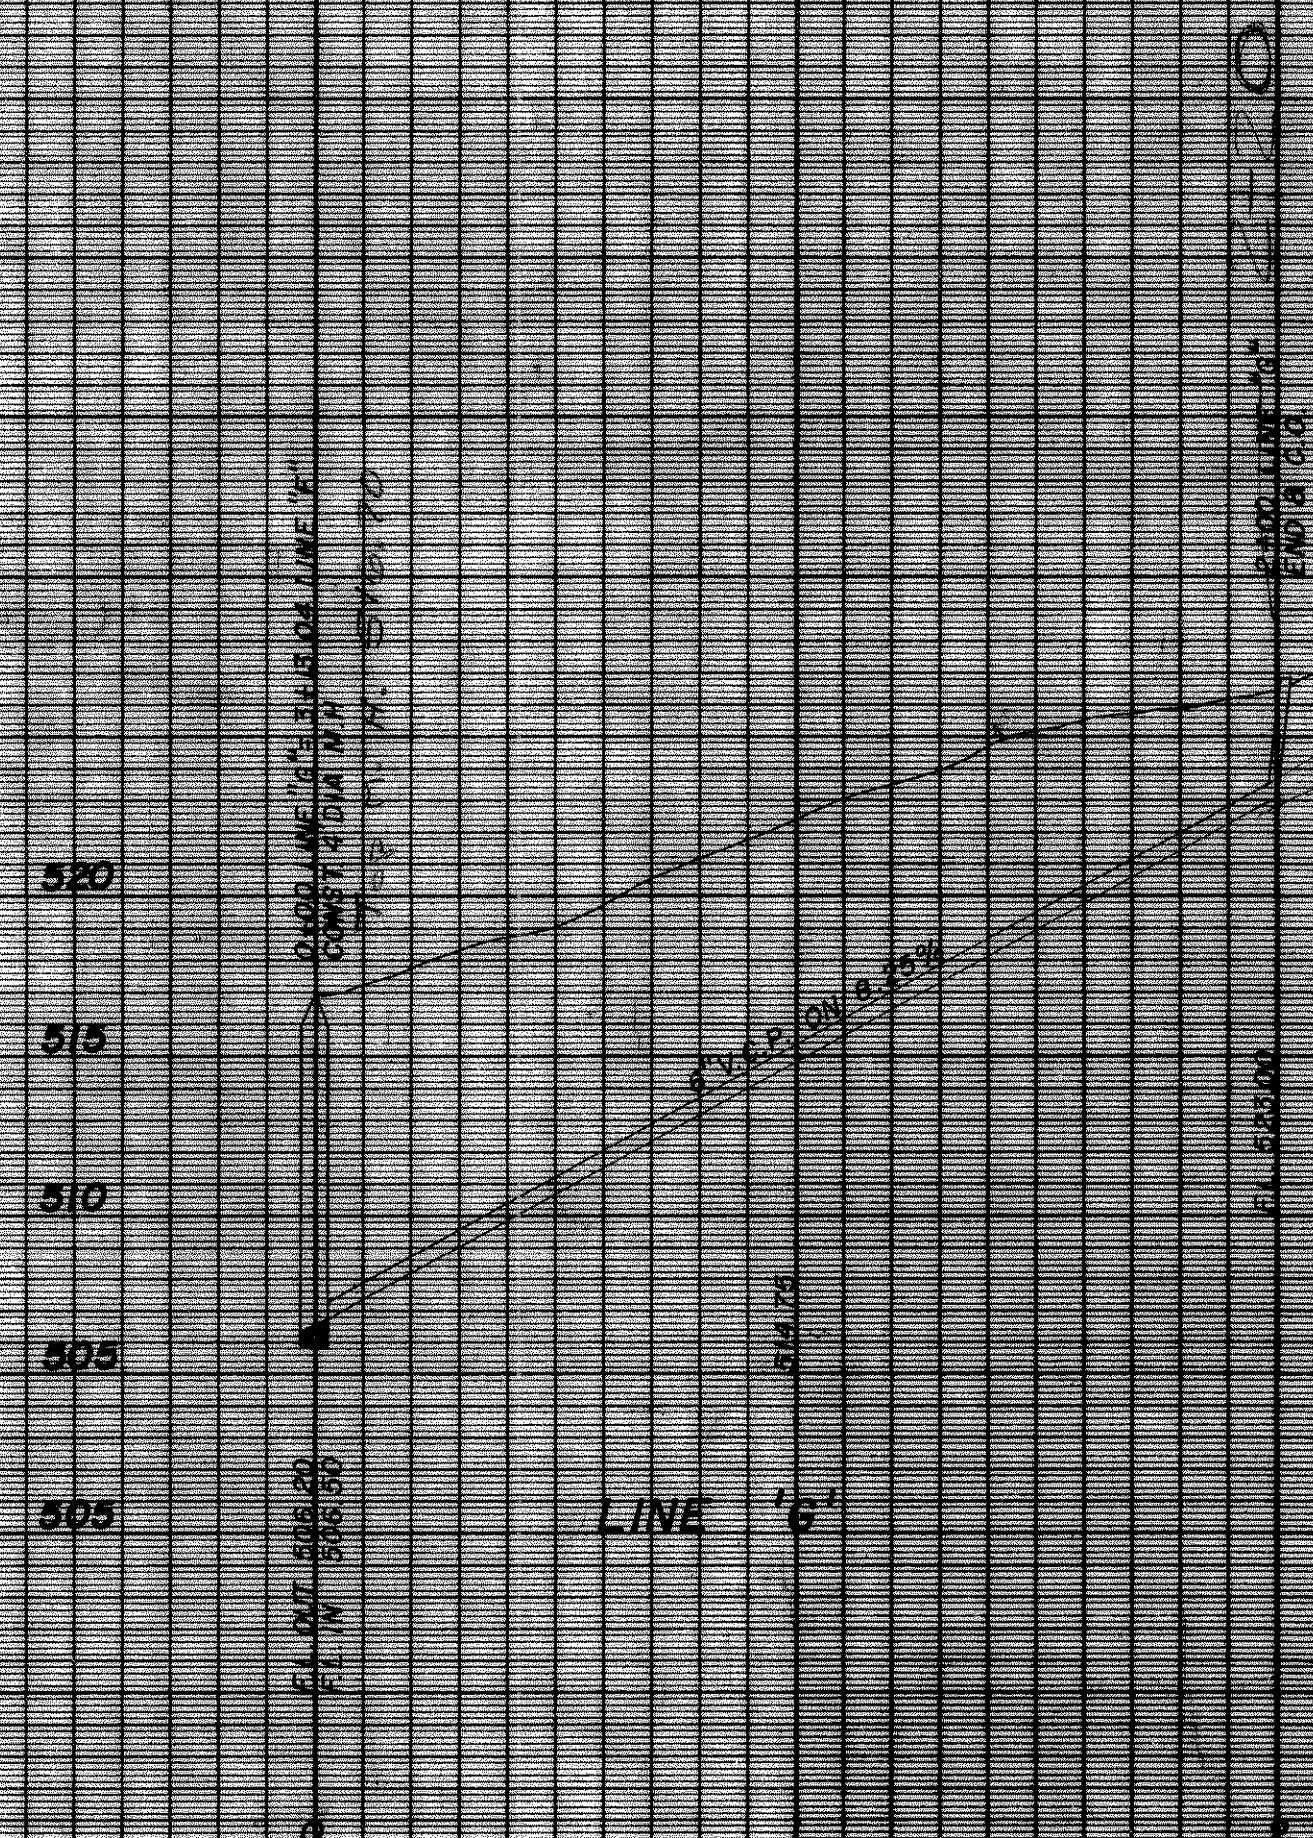

21
24

CHANDLERS LANDING						
PROPOSED SANITARY SEWER						
PHASE 5						
LINE "G"						
DESIGN	DRAWN	DATE	SCALE	NOTES	FILE	NO.
W.H.W.	R.M.H.		1"= 40'H. 1"= 6' V.			