



Q CURVE DATA
 $\Delta = 29^\circ 36' 53''$
 $R = 211.69'$
 $L = 109.60'$
 $T = 56.06'$

E DATA
 $\Delta = 82^\circ 36' 10''$
 $R = 100.0'$
 $T = 87.86'$
 $L = 144.17'$

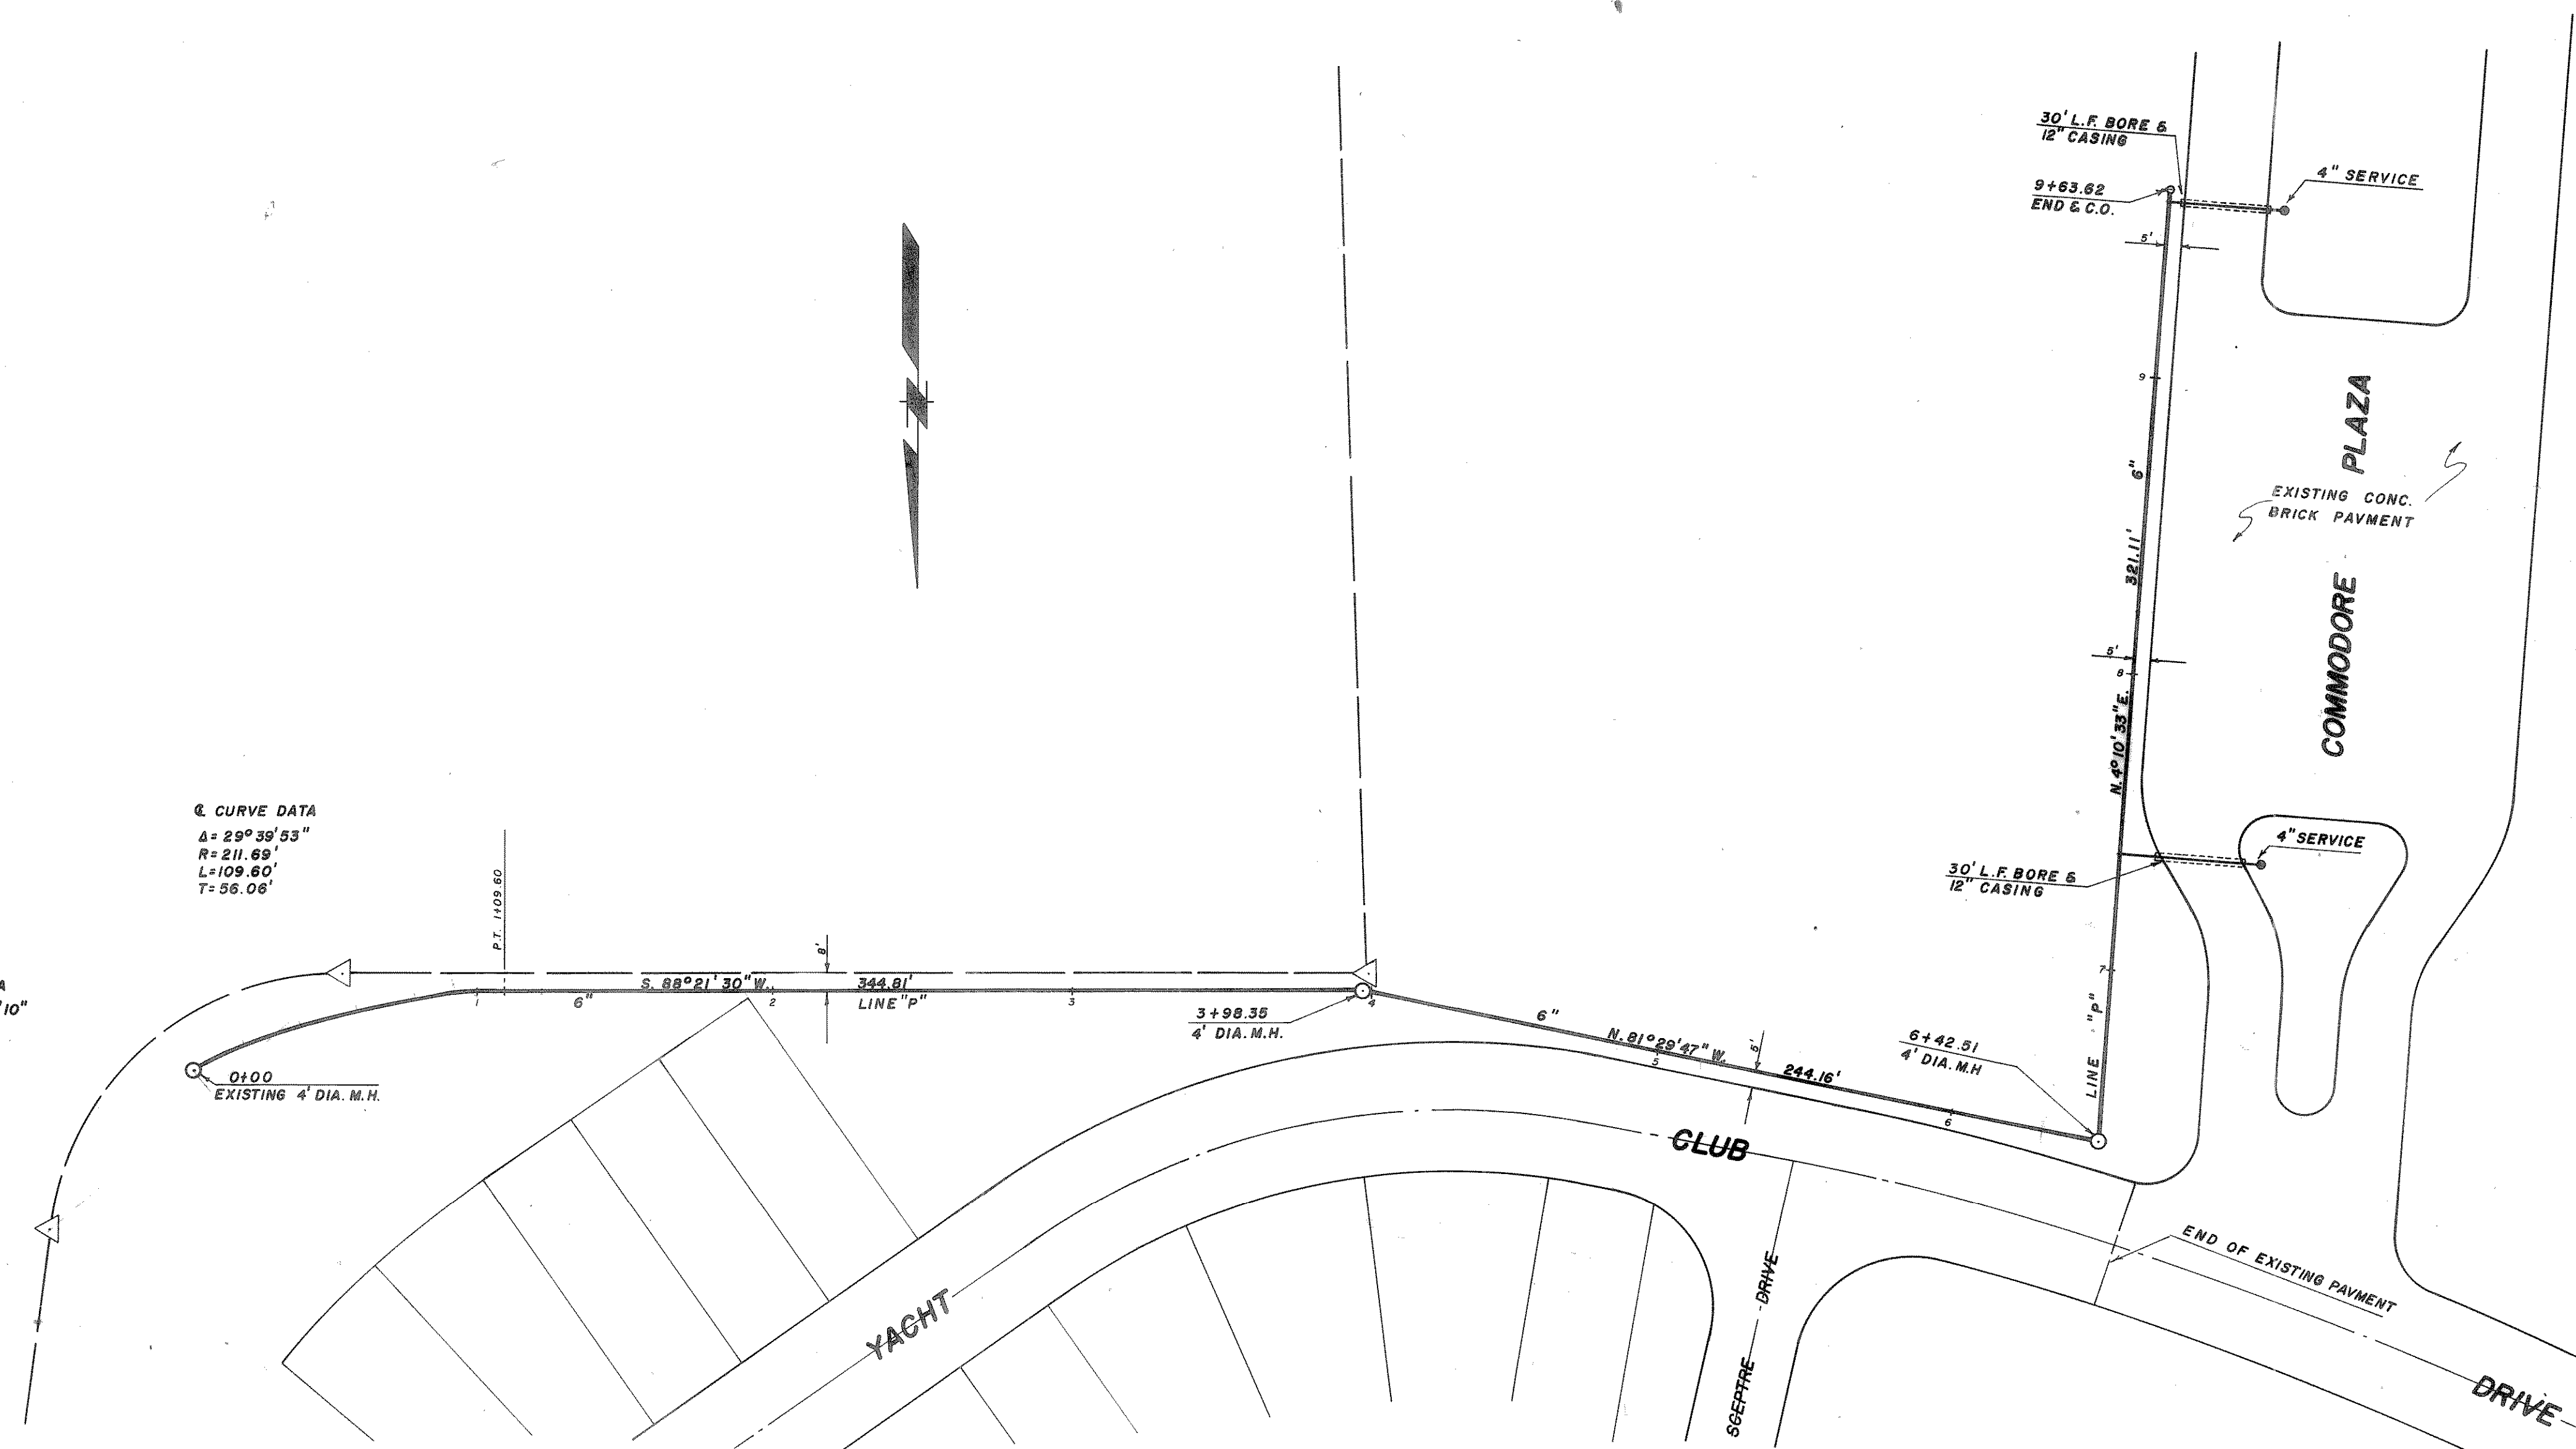

NOTE:
 ALL EXISTING UTILITIES MUST BE LOCATED
 BY THE CONTRACTOR IN THE FIELD PRIOR TO
 CONSTRUCTION.

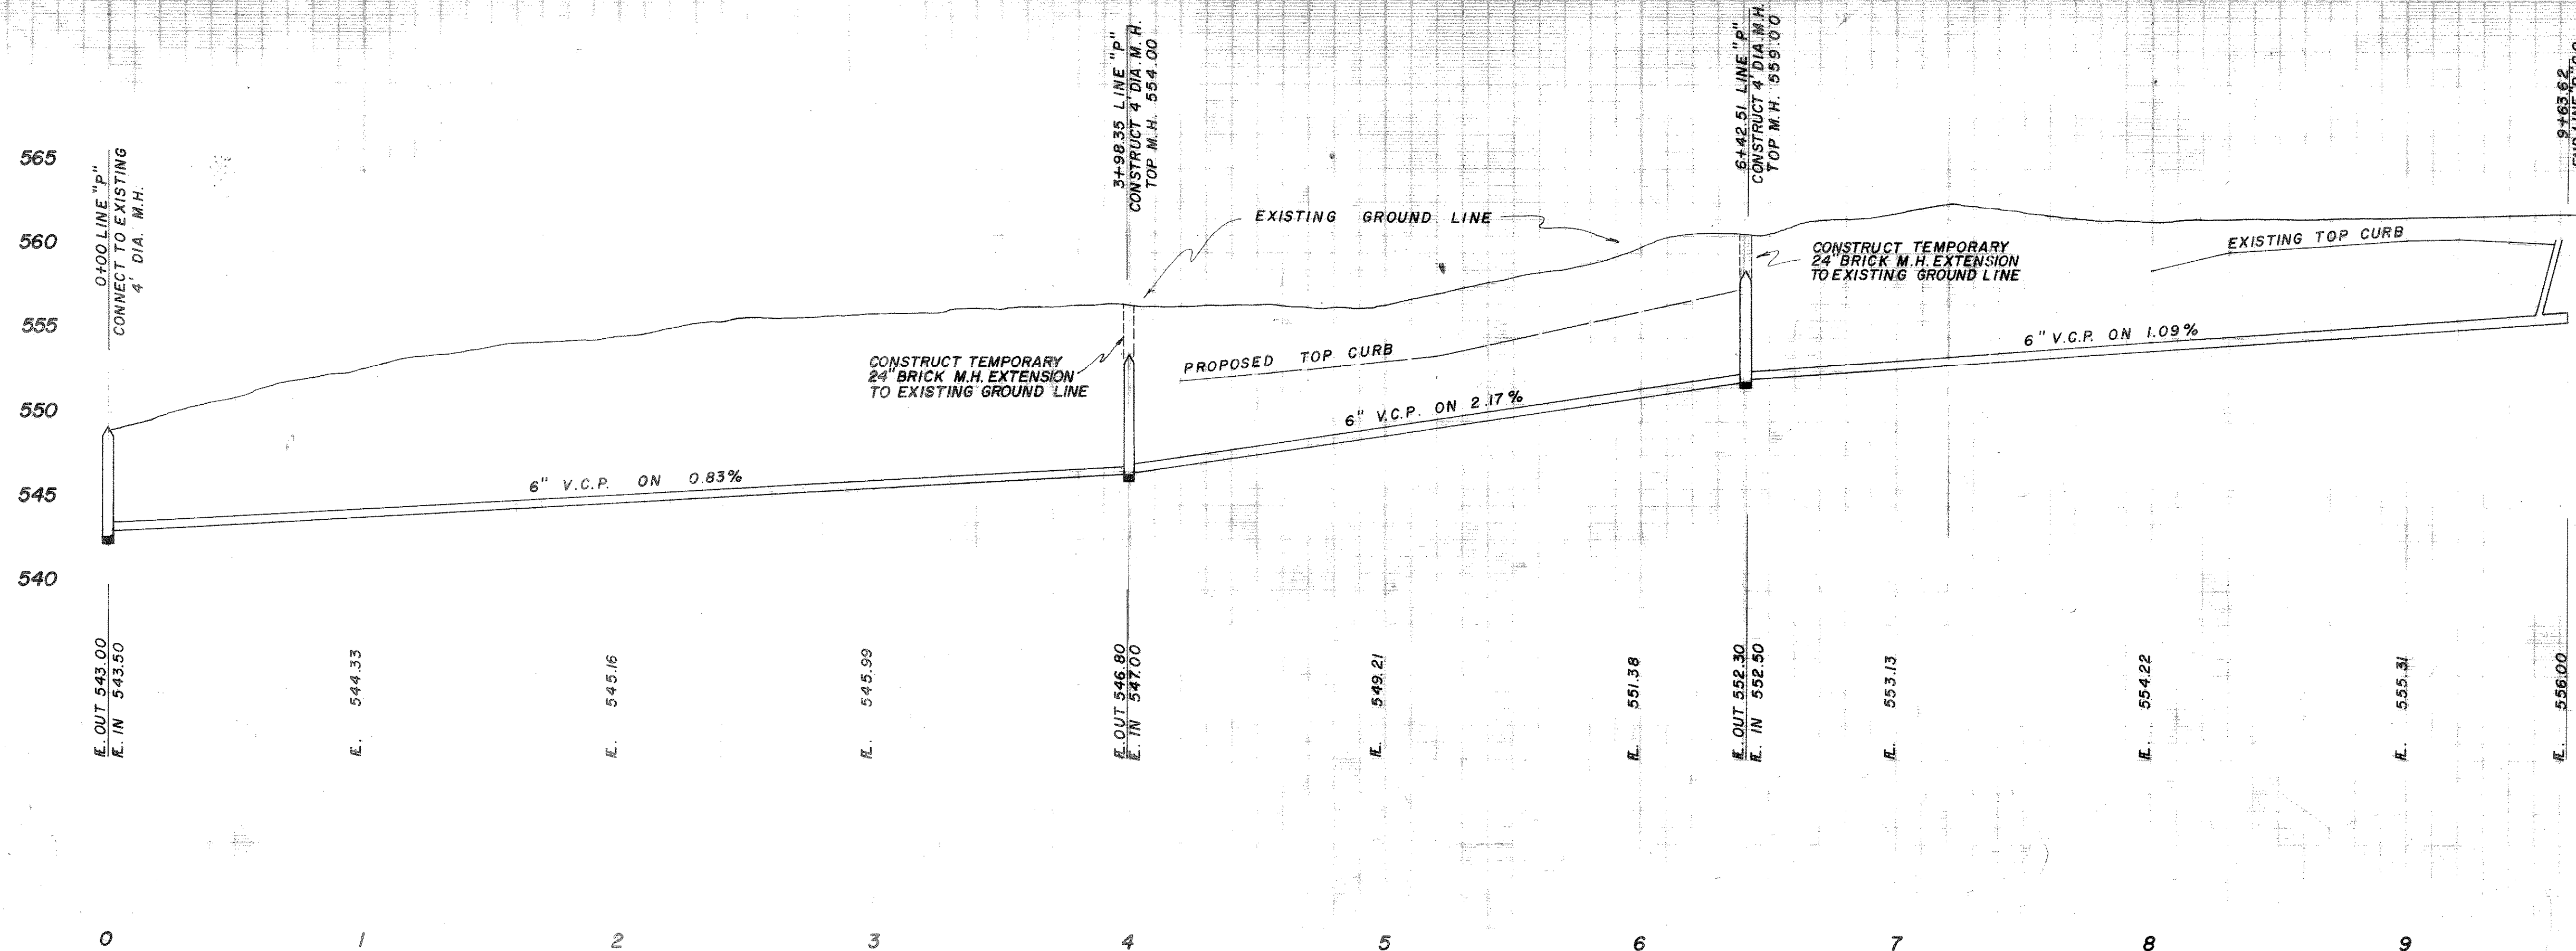

AS BUILT

CHANDLERS LANDING
 PROPOSED SANITARY SEWER
 LINE "P"

OUTFALL LINE

HAROLD L. EVANS & CONSULTING ENGINEER

DESIGN	DRAWN	DATE	SCALE	NOTES	FILE	NO.
W.H.W.	H. RAY M.		1" = 40' H. 1" = 6' V.			

PHASE 5

22
24