


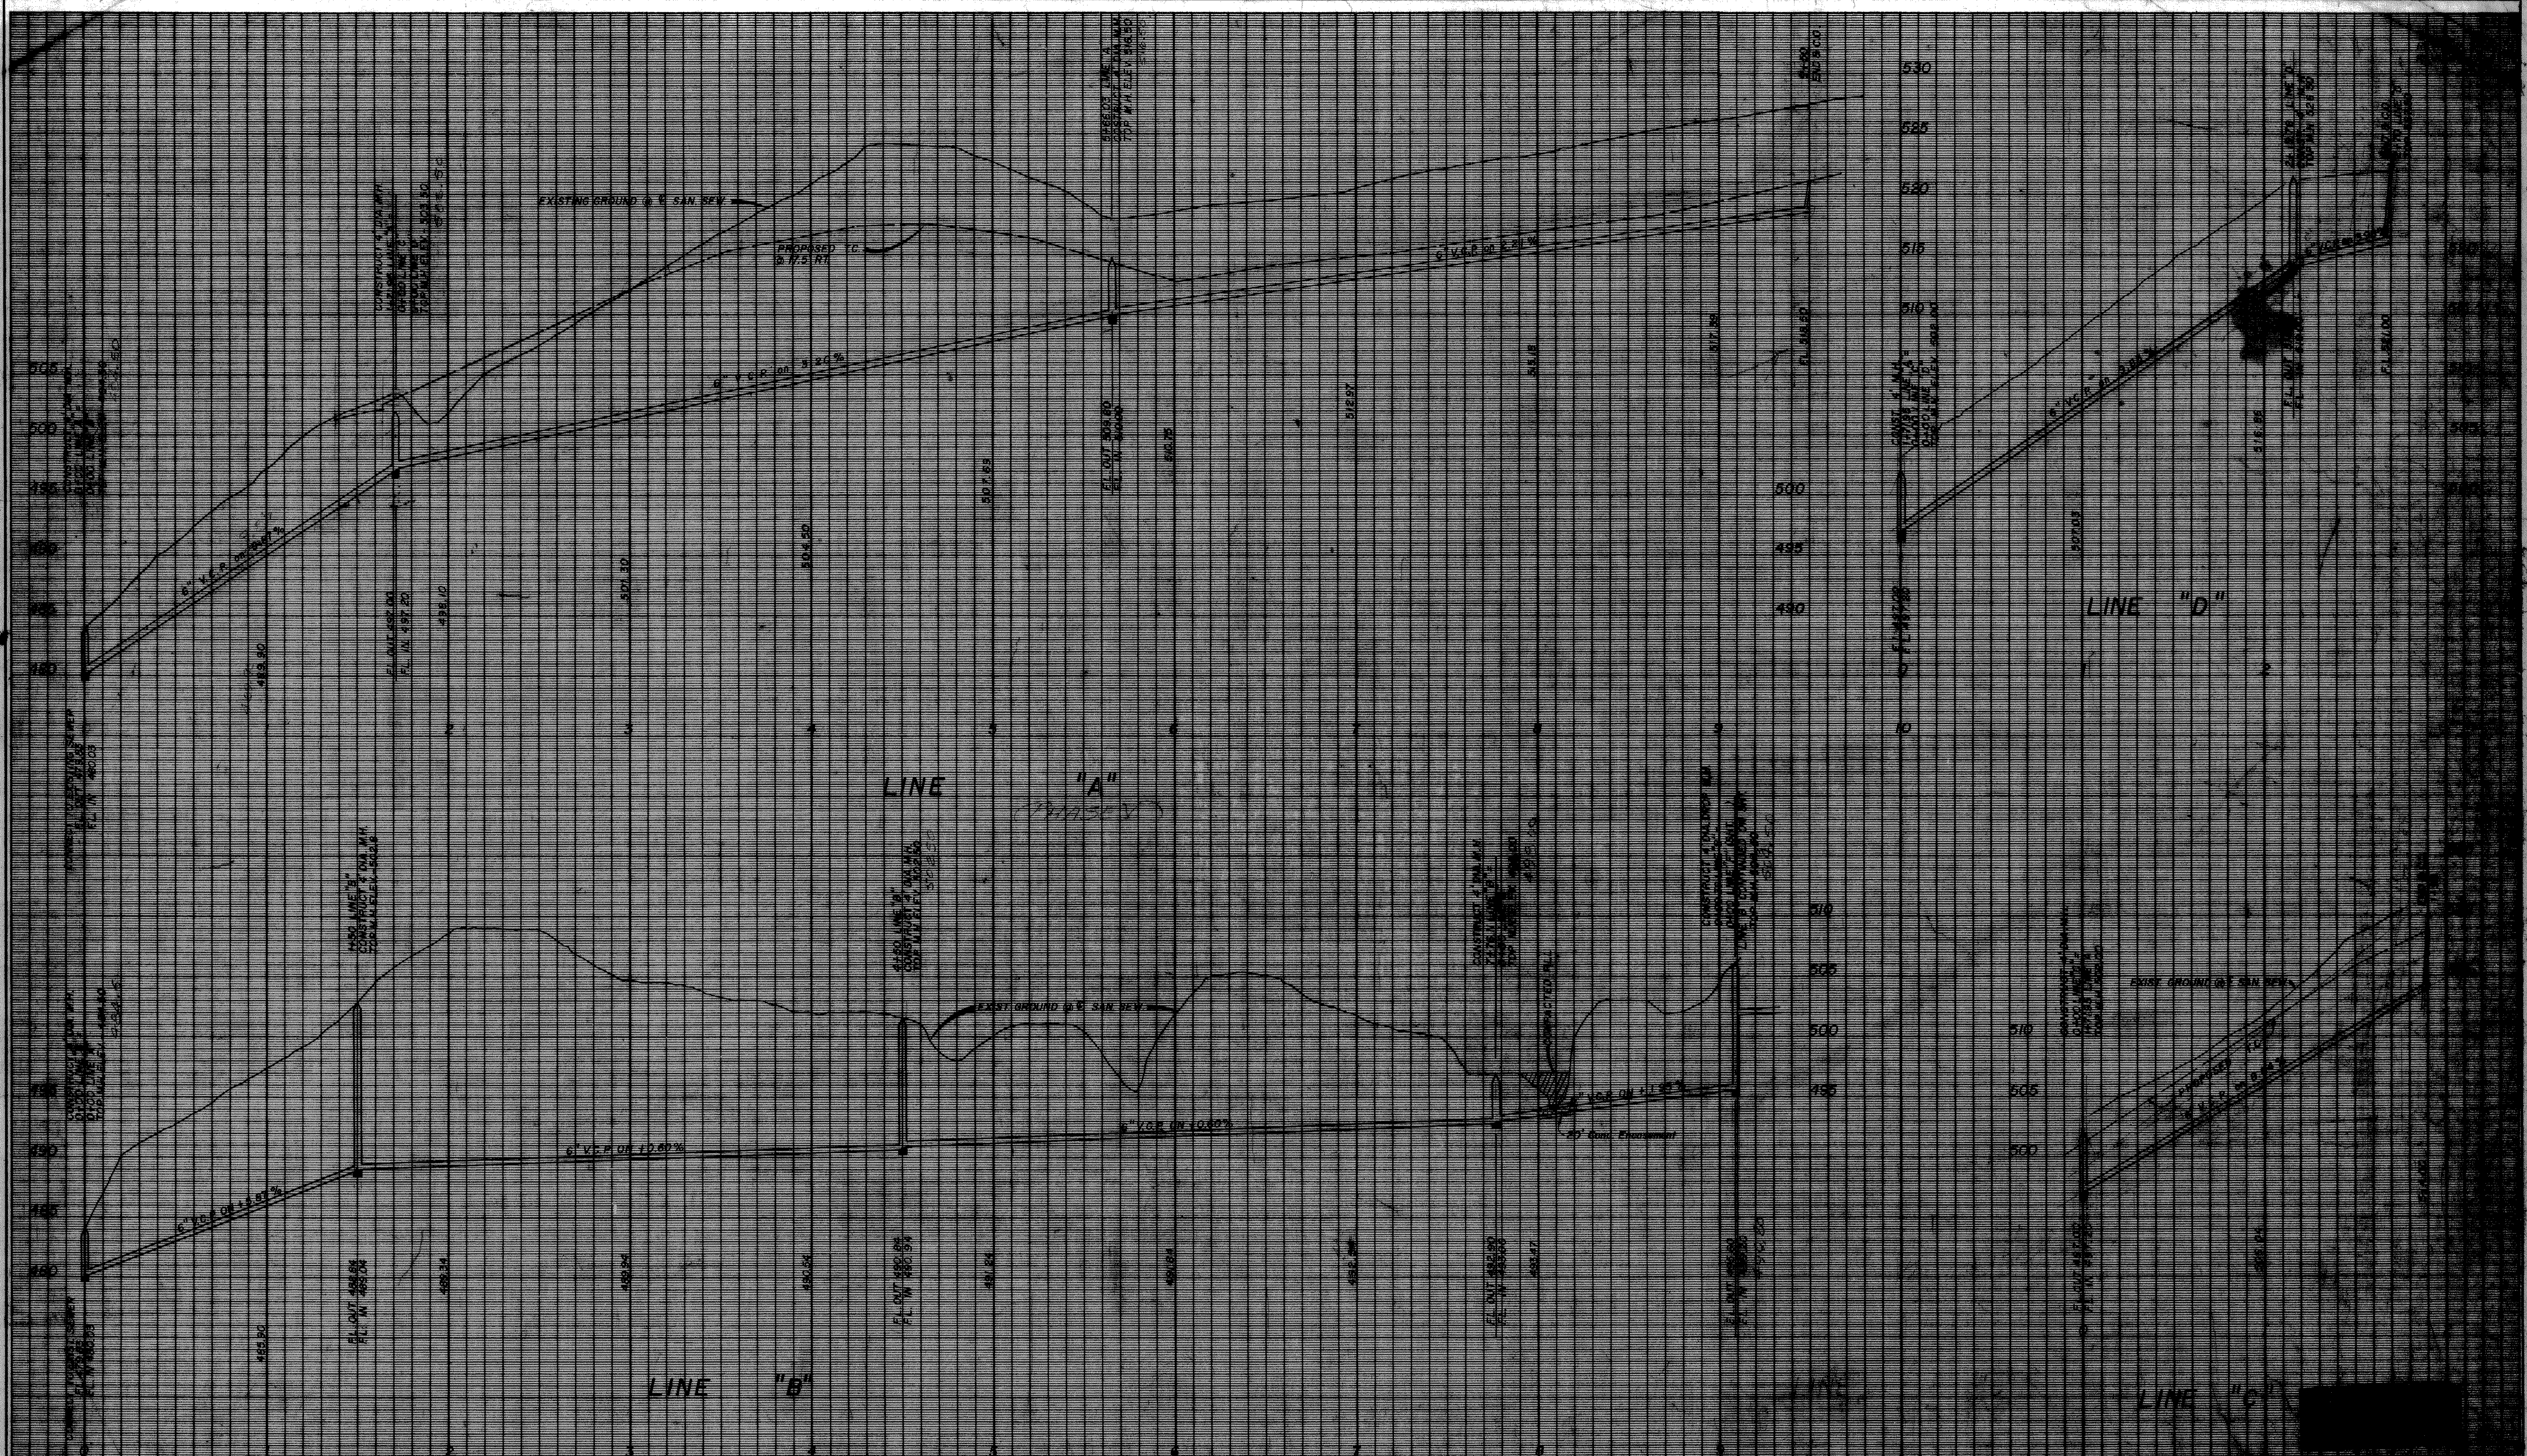

17

24

# CHANDLERS LANDING

## PROPOSED SANITARY SEWER

## LINES "A", "B", "C", "D"

## ROCKWALL, TEXAS

| DESIGN | DRAWN | DATE   | SCALE                     | NOTES | FILE | NO.   |
|--------|-------|--------|---------------------------|-------|------|-------|
| HLE    | GDM   | 3 / 74 | 1" = 40' H<br>1/2" = 6' V |       |      | 72122 |

PH FIVE

24 FIVE