
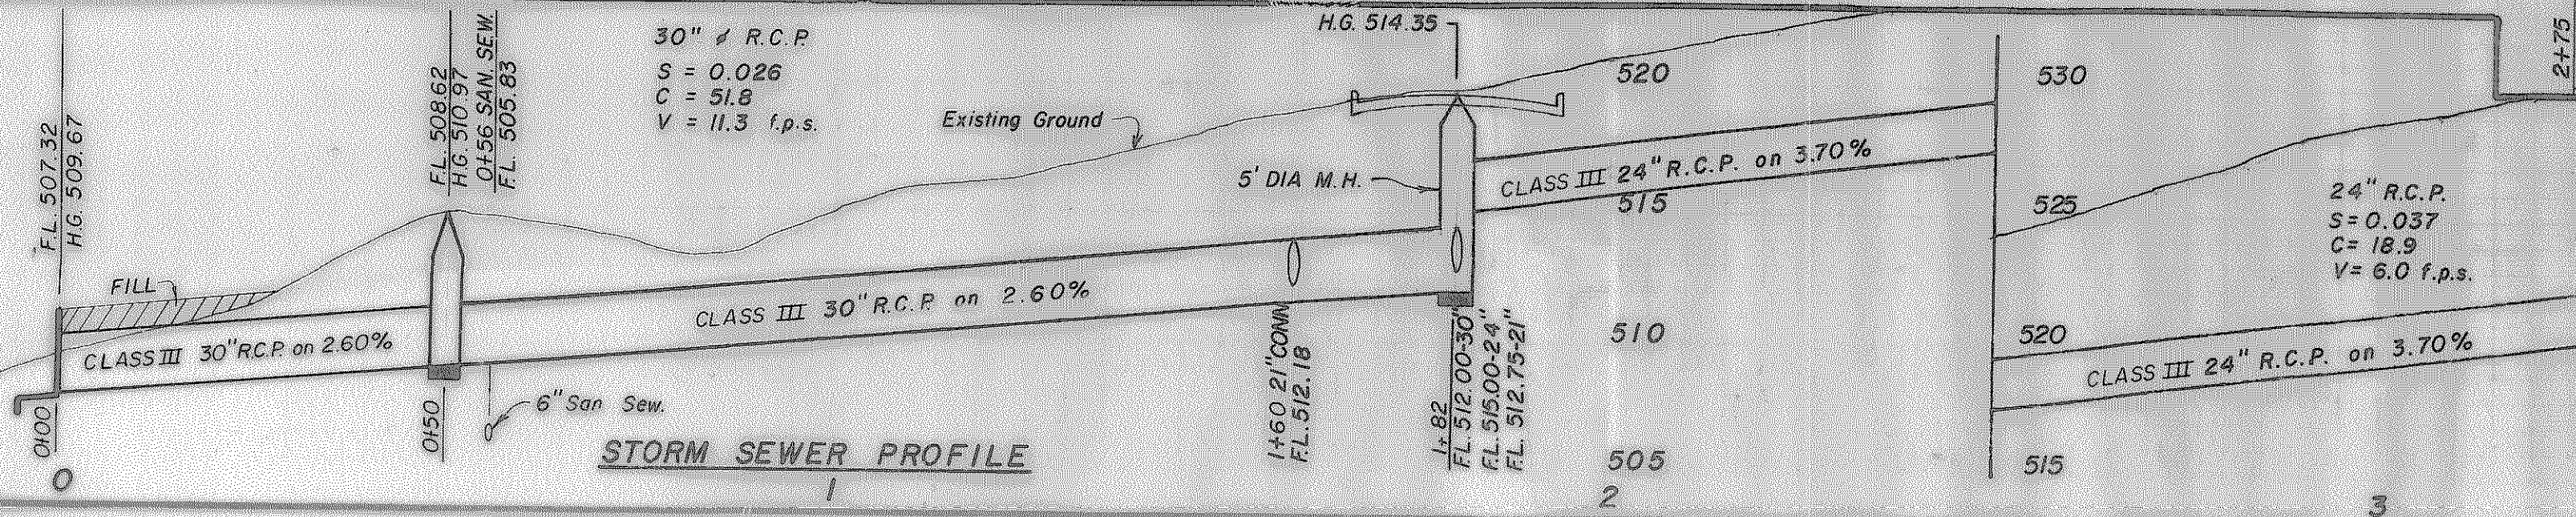


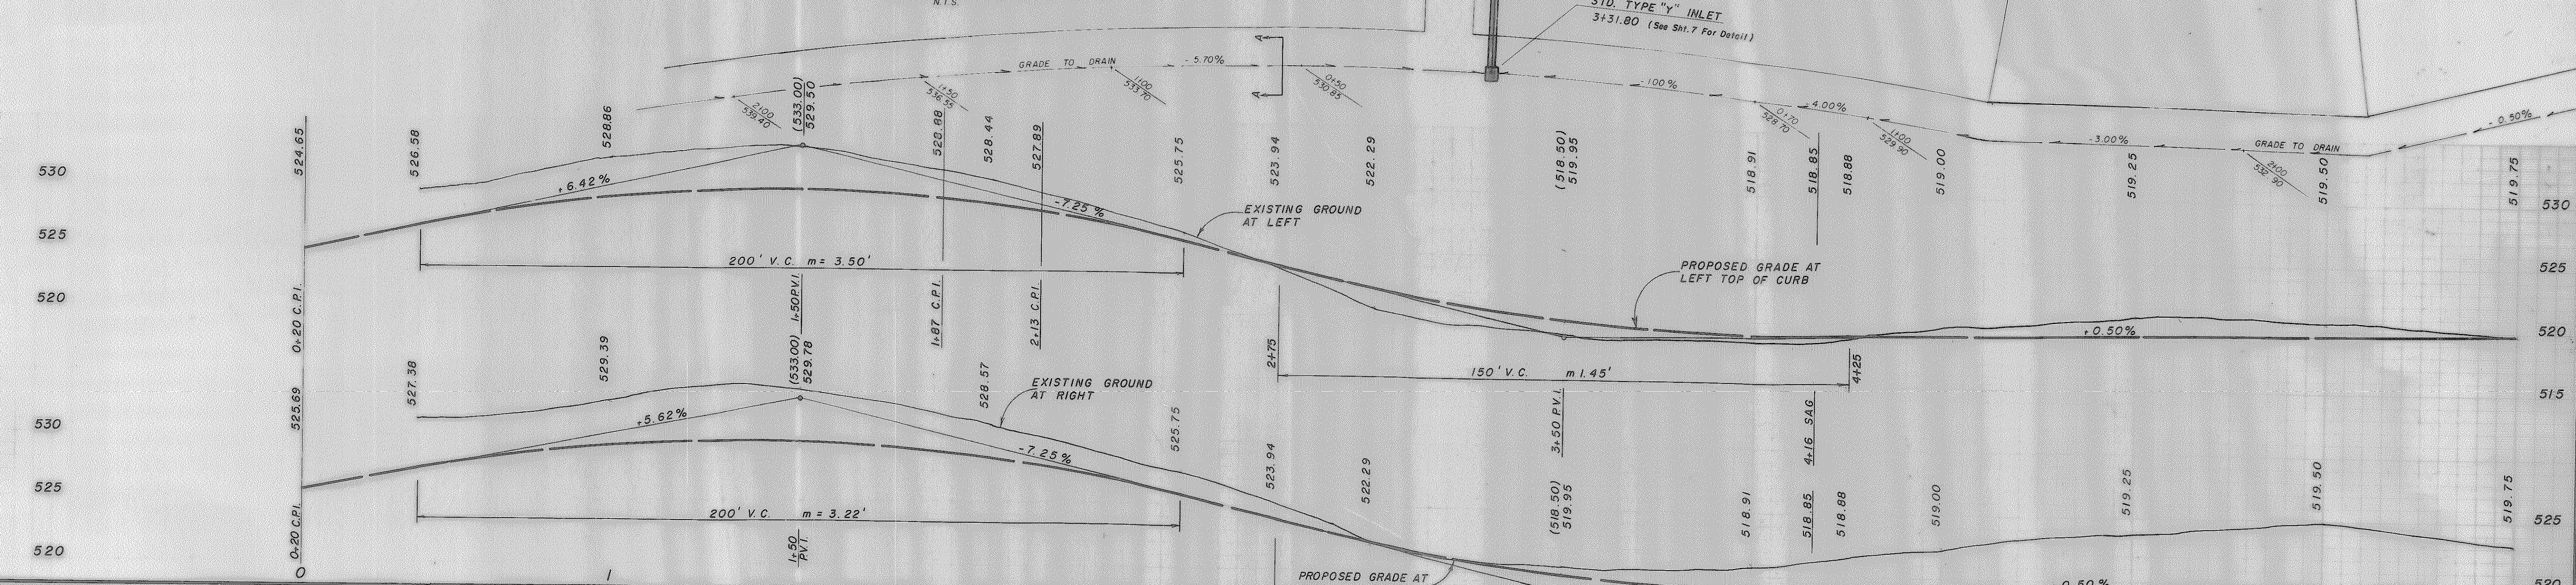

& CURVE DATA
 $\Delta = 31^\circ 03' 15''$
 $R = 197.519$
 $T = 54.877'$
 $L = 107.054'$

& PIPE CURVE DATA
 $\Delta = 38^\circ 30'$
 $R = 100.00'$
 $T = 34.92'$
 $L = 67.20'$

AS BUILT

REVISED 3-3-77

CHANDLERS LANDING	
PROPOSED	PAVING
SCEPTRE DRIVE	
ROCKWALL, TEXAS	
HAROLD L. EVANS & CONSULTING ENGINEER	
DESIGN	H.L.E.
DRAWN	J.R.P.
DATE	
SCALE	1"=20'H 1"=6'V
NOTES	
FILE	
NO.	72122

(PHASE SIX)