
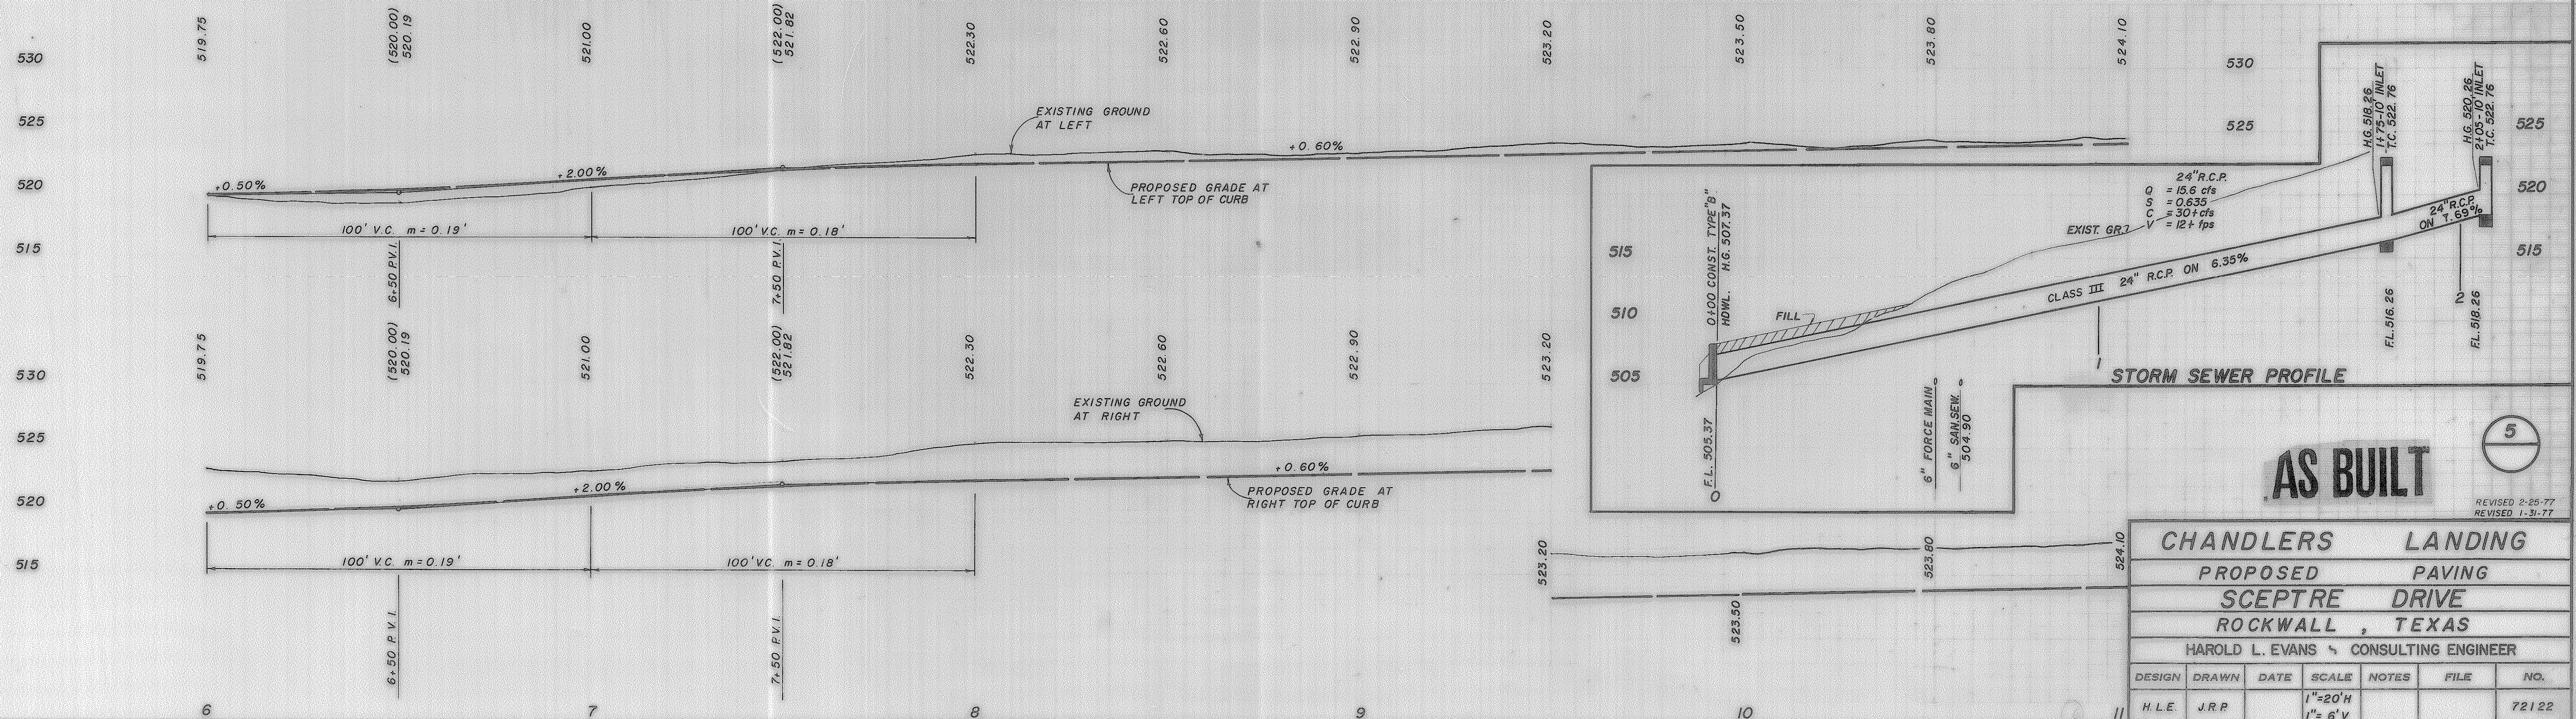


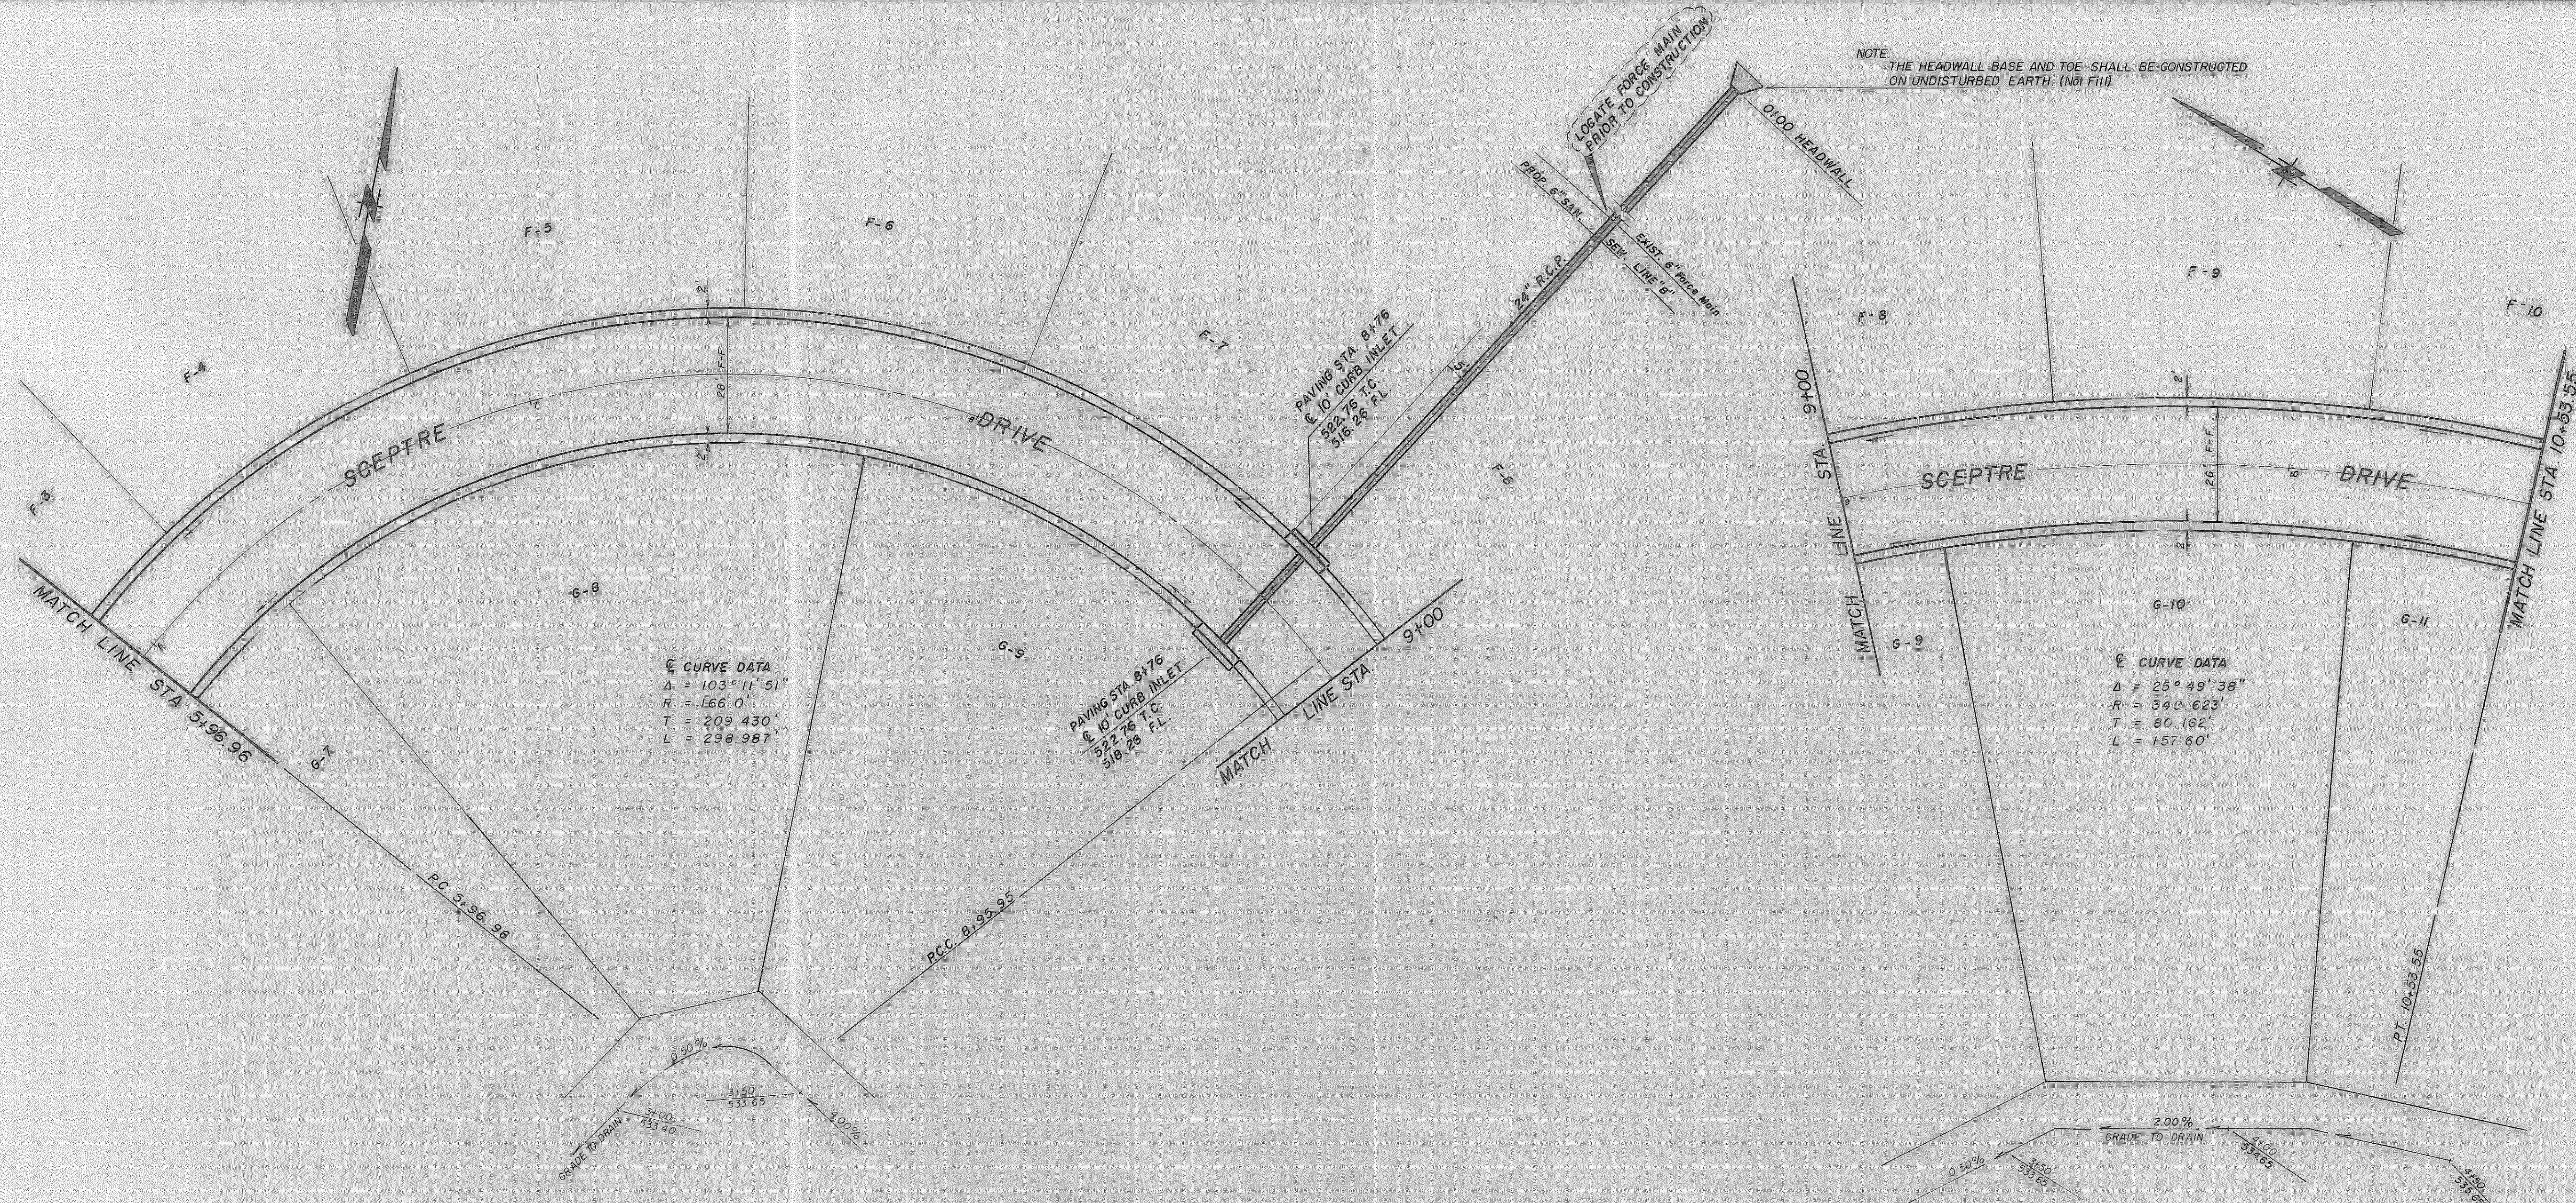

AS BUILT

CHANDLERS LANDING					
PROPOSED PAVING					
SCEPTRE DRIVE					
ROCKWALL, TEXAS					
HAROLD L. EVANS & CONSULTING ENGINEER					
DESIGN	DRAWN	DATE	SCALE	NOTES	FILE
H.L.E.	J.R.P.		1"=20'H 1"=6'V		
					72122

(PHASE SIX)