


2 SANITARY SEWER CURVE DATA

NO.	Δ	R	T	L
1	06°37'51"	1423.00'	82.43'	164.68'
2	31°03'23"	74.52'	20.70'	40.39'
3	21°24'23"	289.00'	54.62'	107.97'
4	81°47'28"	289.00'	250.30'	412.55'
5	25°49'38"	472.62'	108.36'	213.04'
6	23°05'11"	514.70'	105.12'	207.39'
7	12°03'27"	1283.00'	135.50'	270.00'
8	07°05'19"	1283.00'	74.97'	158.73'
9	31°08'15"	214.52'	59.60'	116.57'
10	103°11'51"	149.00'	187.98'	268.37'
11	25°44'39"	332.62'	76.26'	149.94'
12	23°05'11"	374.70'	76.53'	150.98'
13	10°30'43"	740.56'	68.13'	135.87'
14	14°27'32"	198.48'	25.18'	50.09'

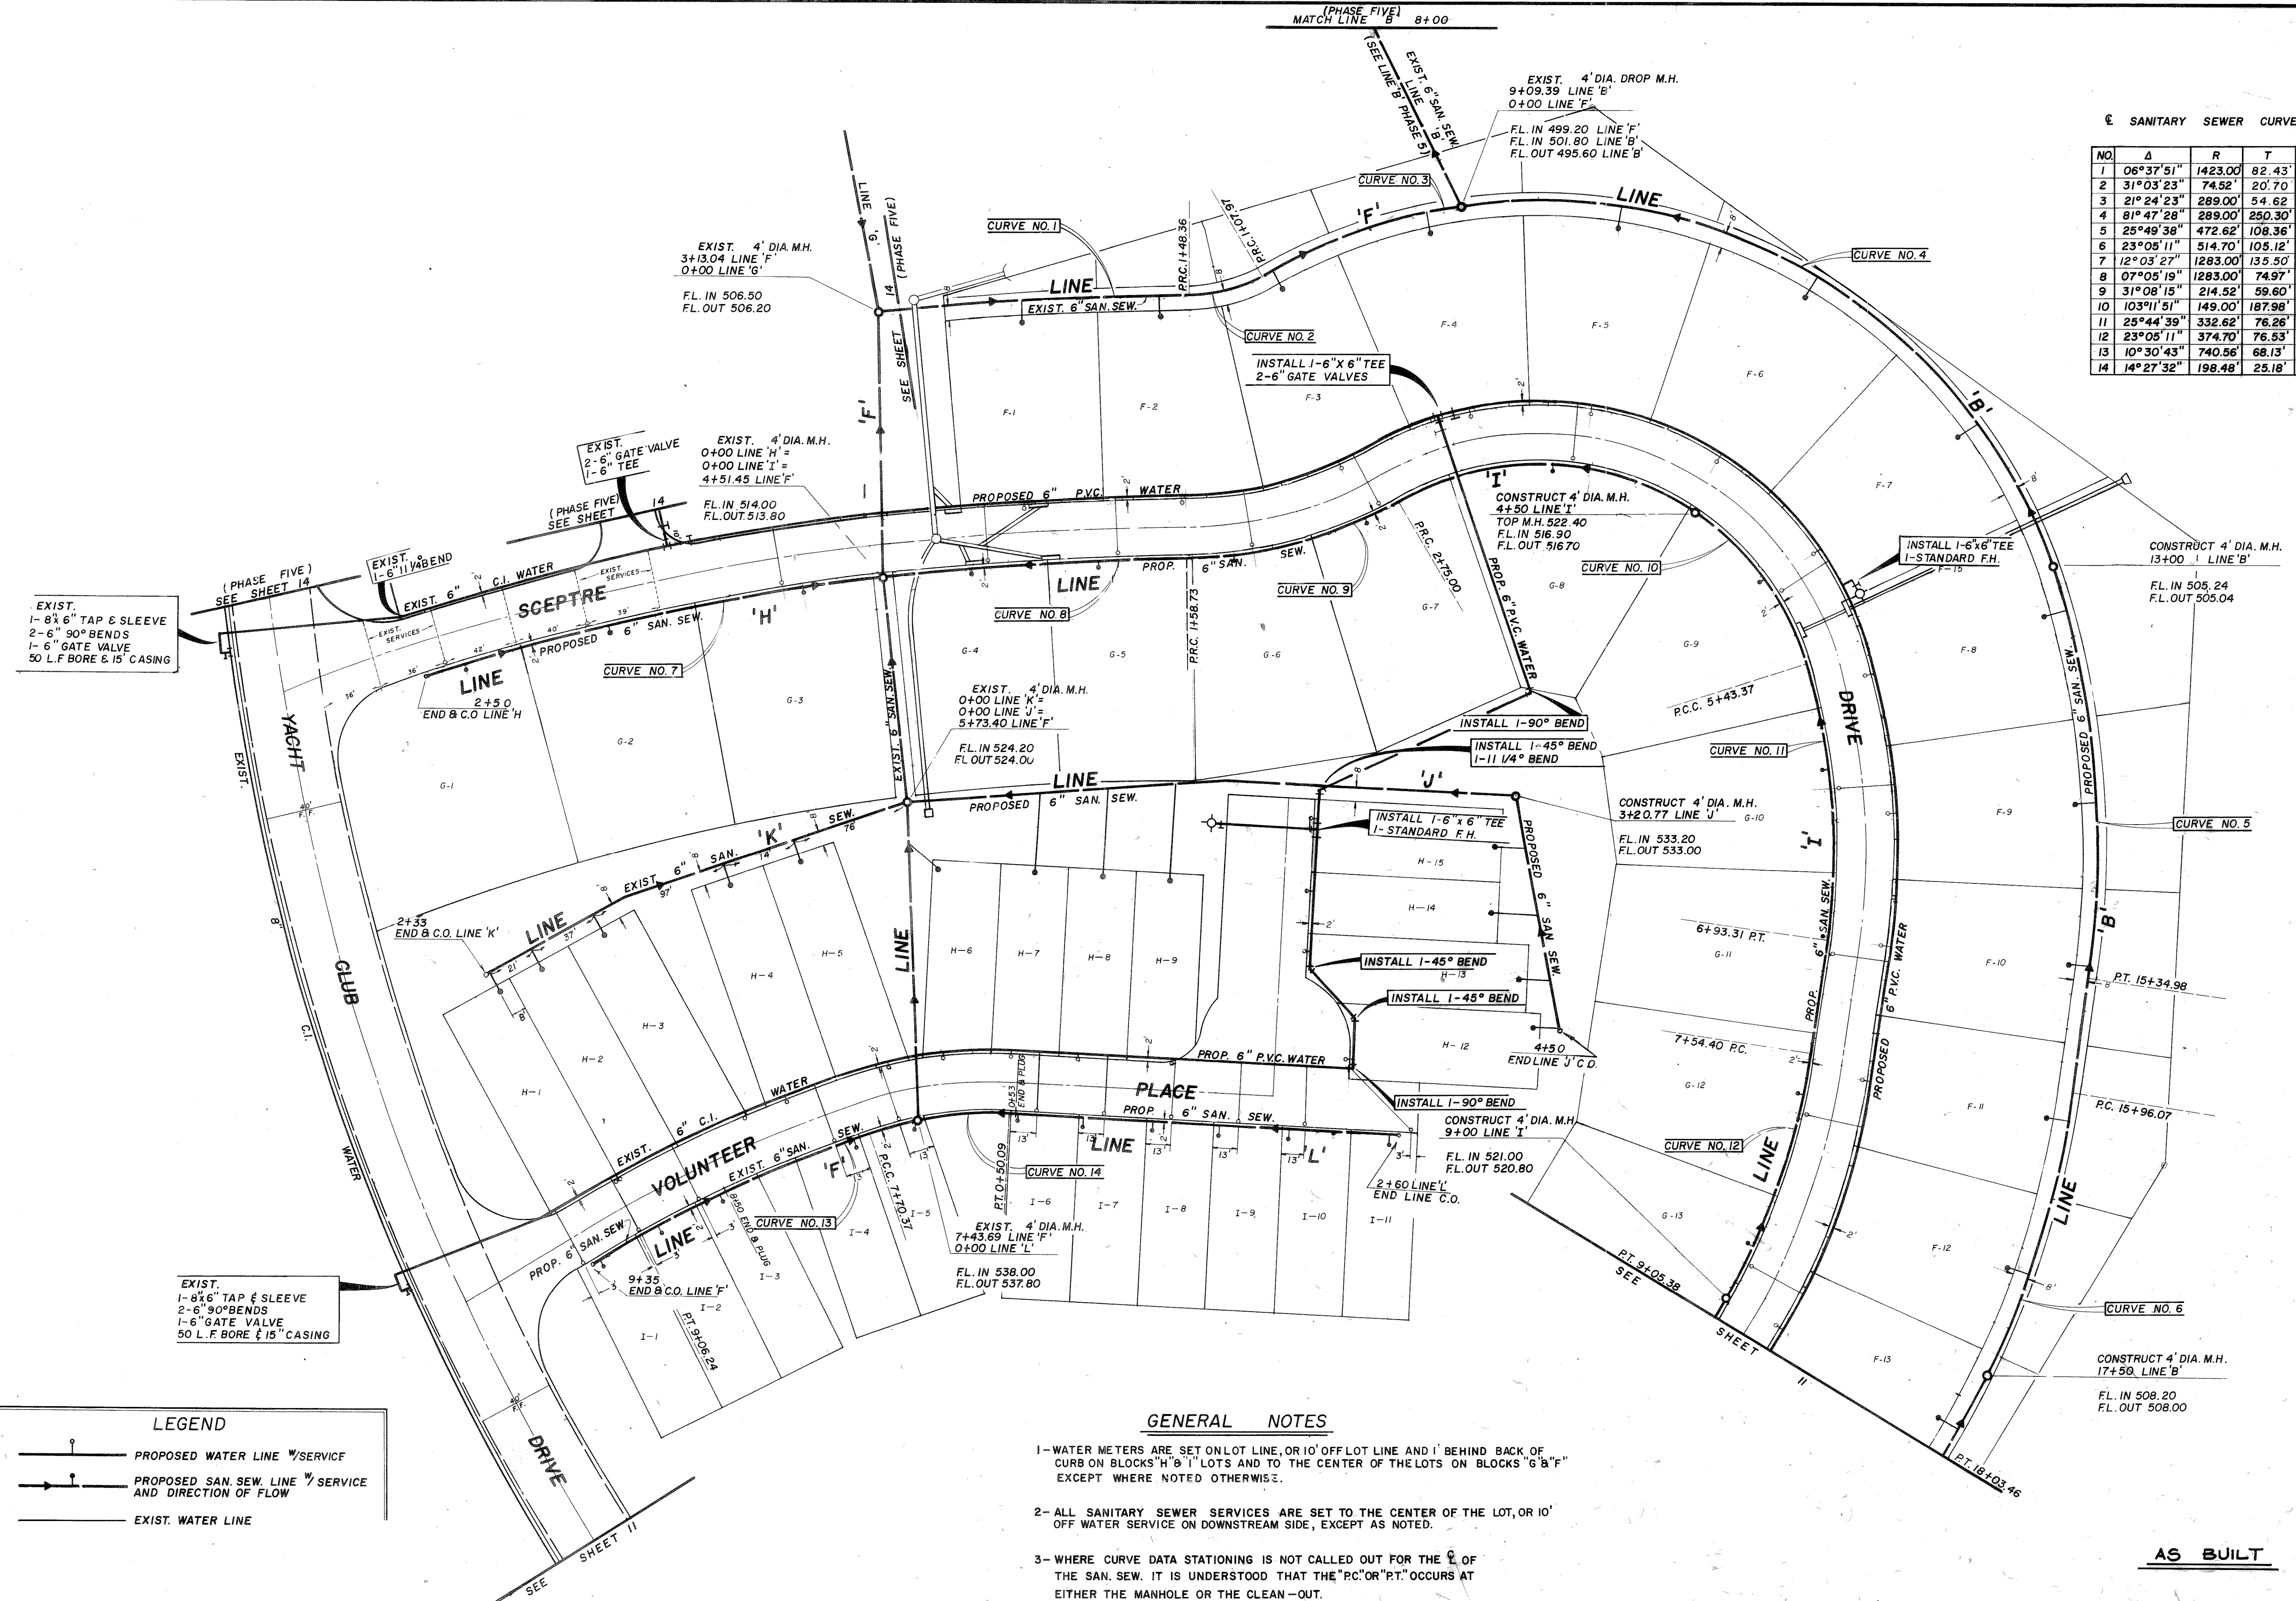

LEGEND

— W — PROPOSED WATER LINE W/ SERVICE

- - - S - - - PROPOSED SAN. SEW. LINE W/ SERVICE AND DIRECTION OF FLOW

— — — EXIST. WATER LINE

GENERAL NOTES

- 1- WATER METERS ARE SET ON LOT LINE, OR 10' OFF LOT LINE AND 1' BEHIND BACK OF CURB ON BLOCKS 'H' & 'I' LOTS AND TO THE CENTER OF THE LOTS ON BLOCKS 'G' & 'F' EXCEPT WHERE NOTED OTHERWISE.
- 2- ALL SANITARY SEWER SERVICES ARE SET TO THE CENTER OF THE LOT, OR 10' OFF WATER SERVICE ON DOWNSTREAM SIDE, EXCEPT AS NOTED.
- 3- WHERE CURVE DATA STATIONING IS NOT CALLED OUT FOR THE 2' OF THE SAN. SEW. IT IS UNDERSTOOD THAT THE "PC" OR "PT" OCCURS AT EITHER THE MANHOLE OR THE CLEAN-OUT.
- 4- WATER LINES ARE TO BE WARPED TO 5' OFF BACK OF CURB AT STORM SEWER INLETS.
- 5- PROPOSED MANHOLES UNDER THIS CONTRACT TO BE STUBBED FOR FUTURE LINES.

AS BUILT

WATER & SANITARY SEWER				CHANDLER'S LANDING	
PHASE SIX - MASTER PLAN				ROCKWALL, TEXAS	
DESIGN: W.H.W. R.M.H.	DRAWN: R.M.H.	DATE: FEB. 1974	SCALE: 1" = 40'	328-6135	HAROLD EVANS & CONSULTING ENGINEER DALLAS