


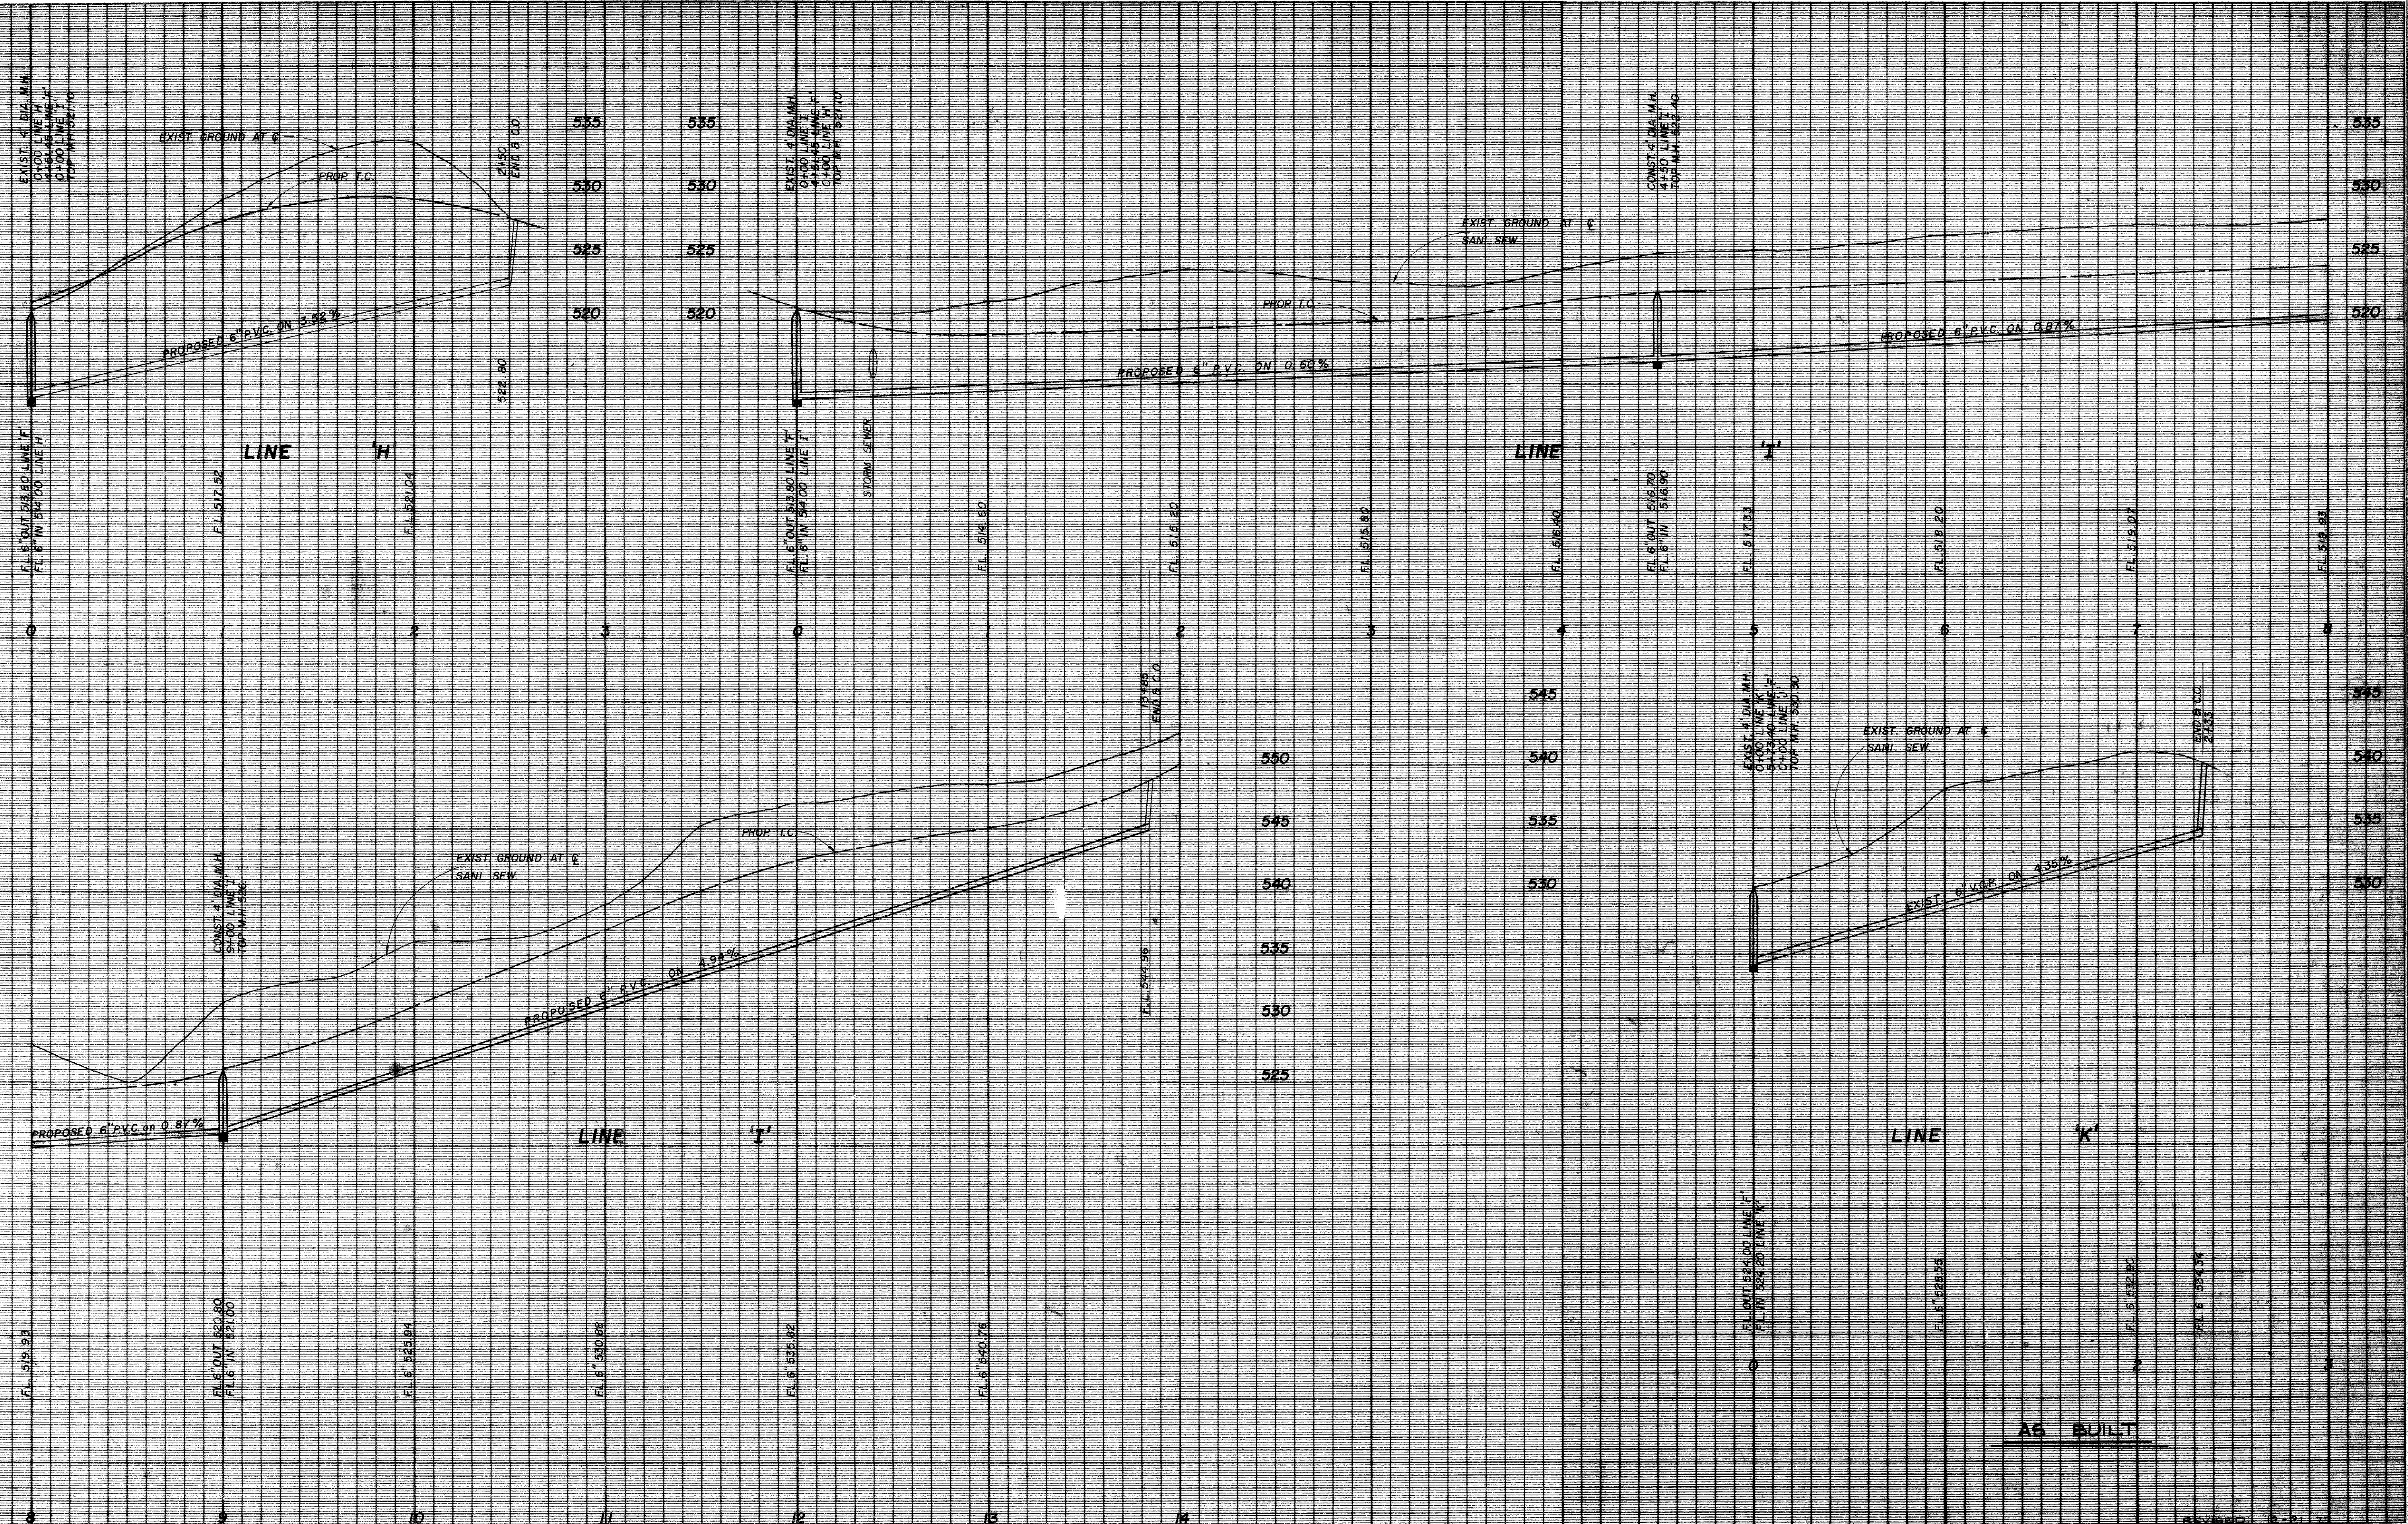

CHANDLERS LANDING						
PROPOSED SANITARY SEWER						
PHASE 6						
LINES 'H' 'I' & 'K'						
DESIGN	DRAWN	DATE	SCALE	NOTES	FILE	NO.
W.H.W.	R.M.H.		1"= 40' H. 1"= 6' V.			