
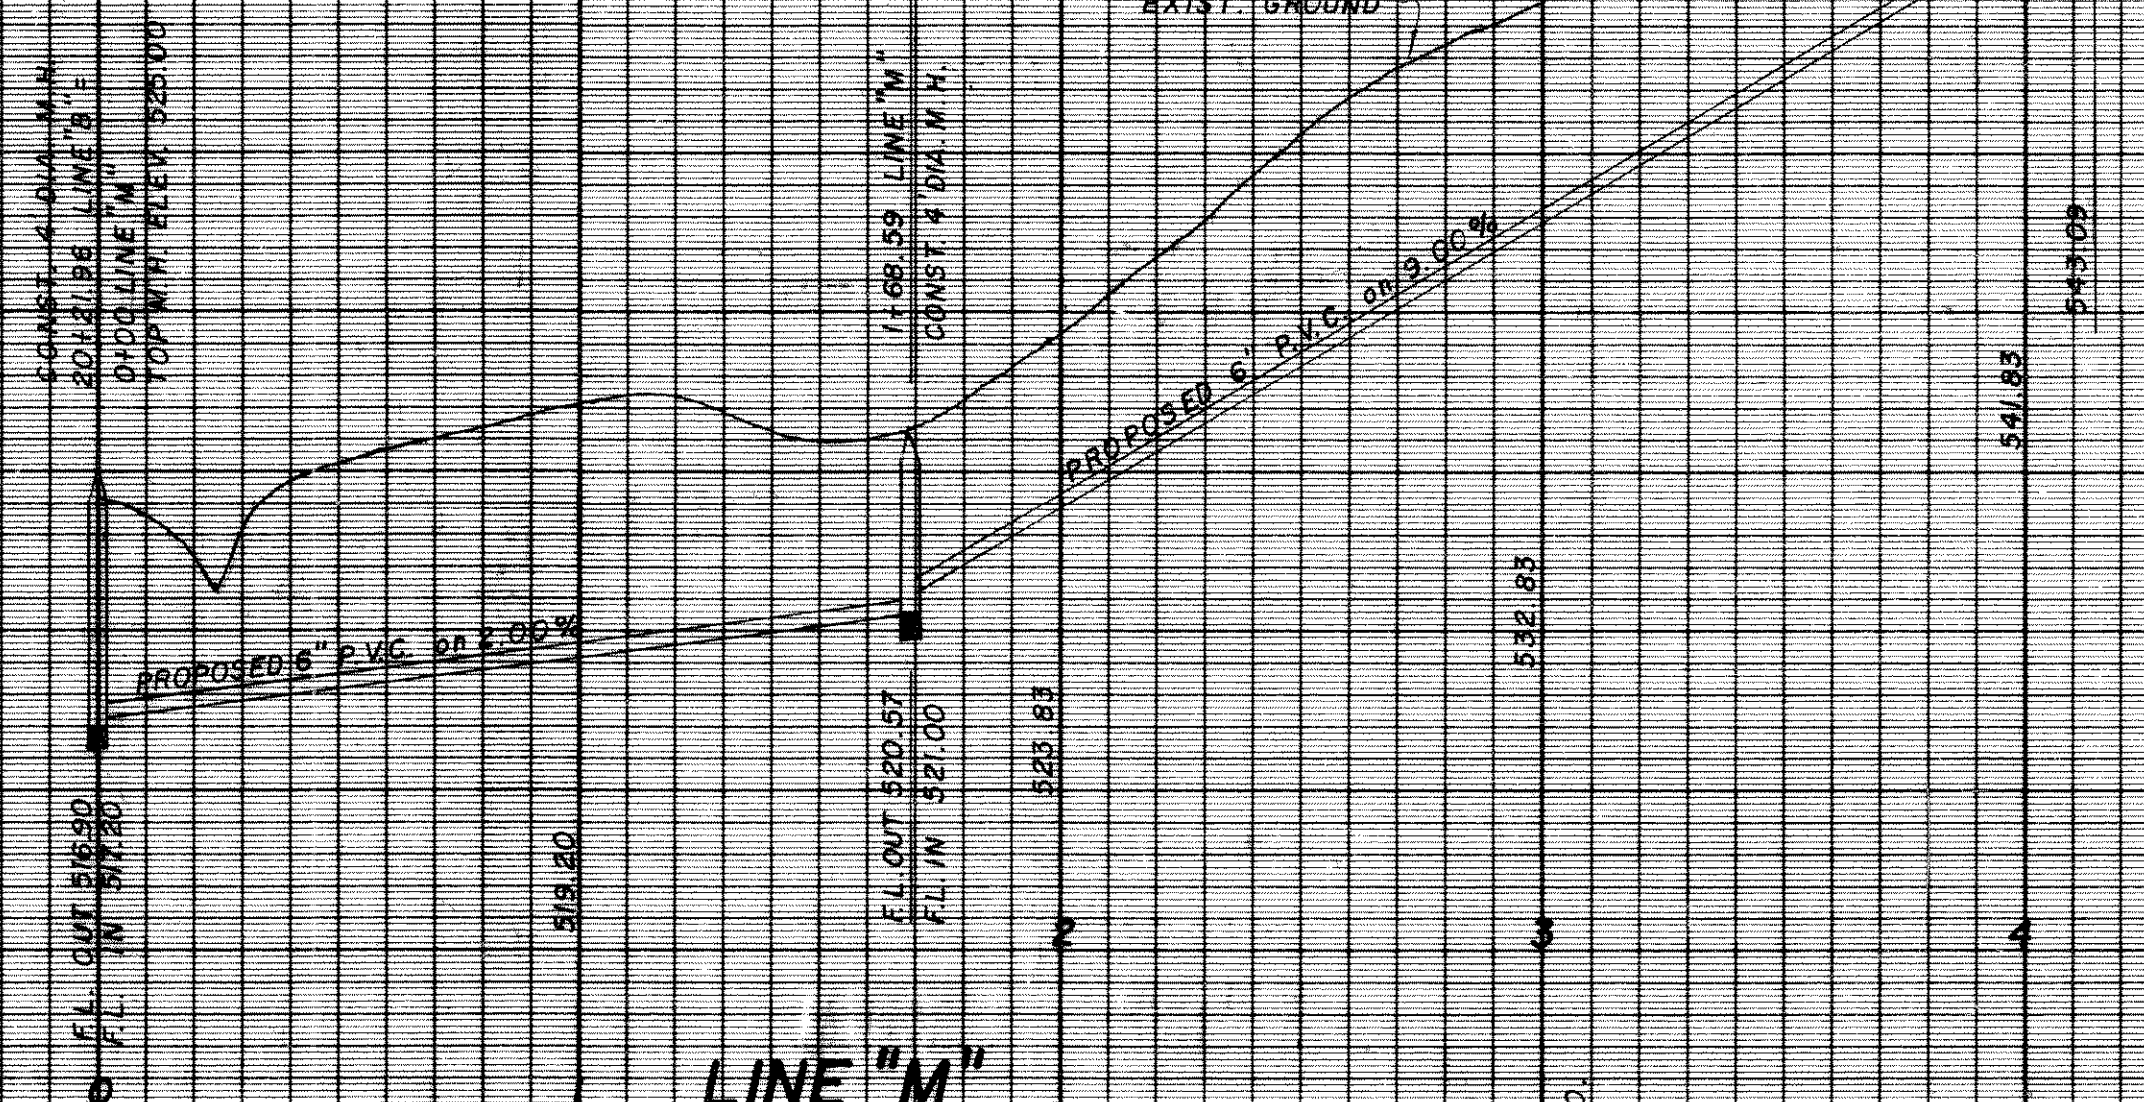
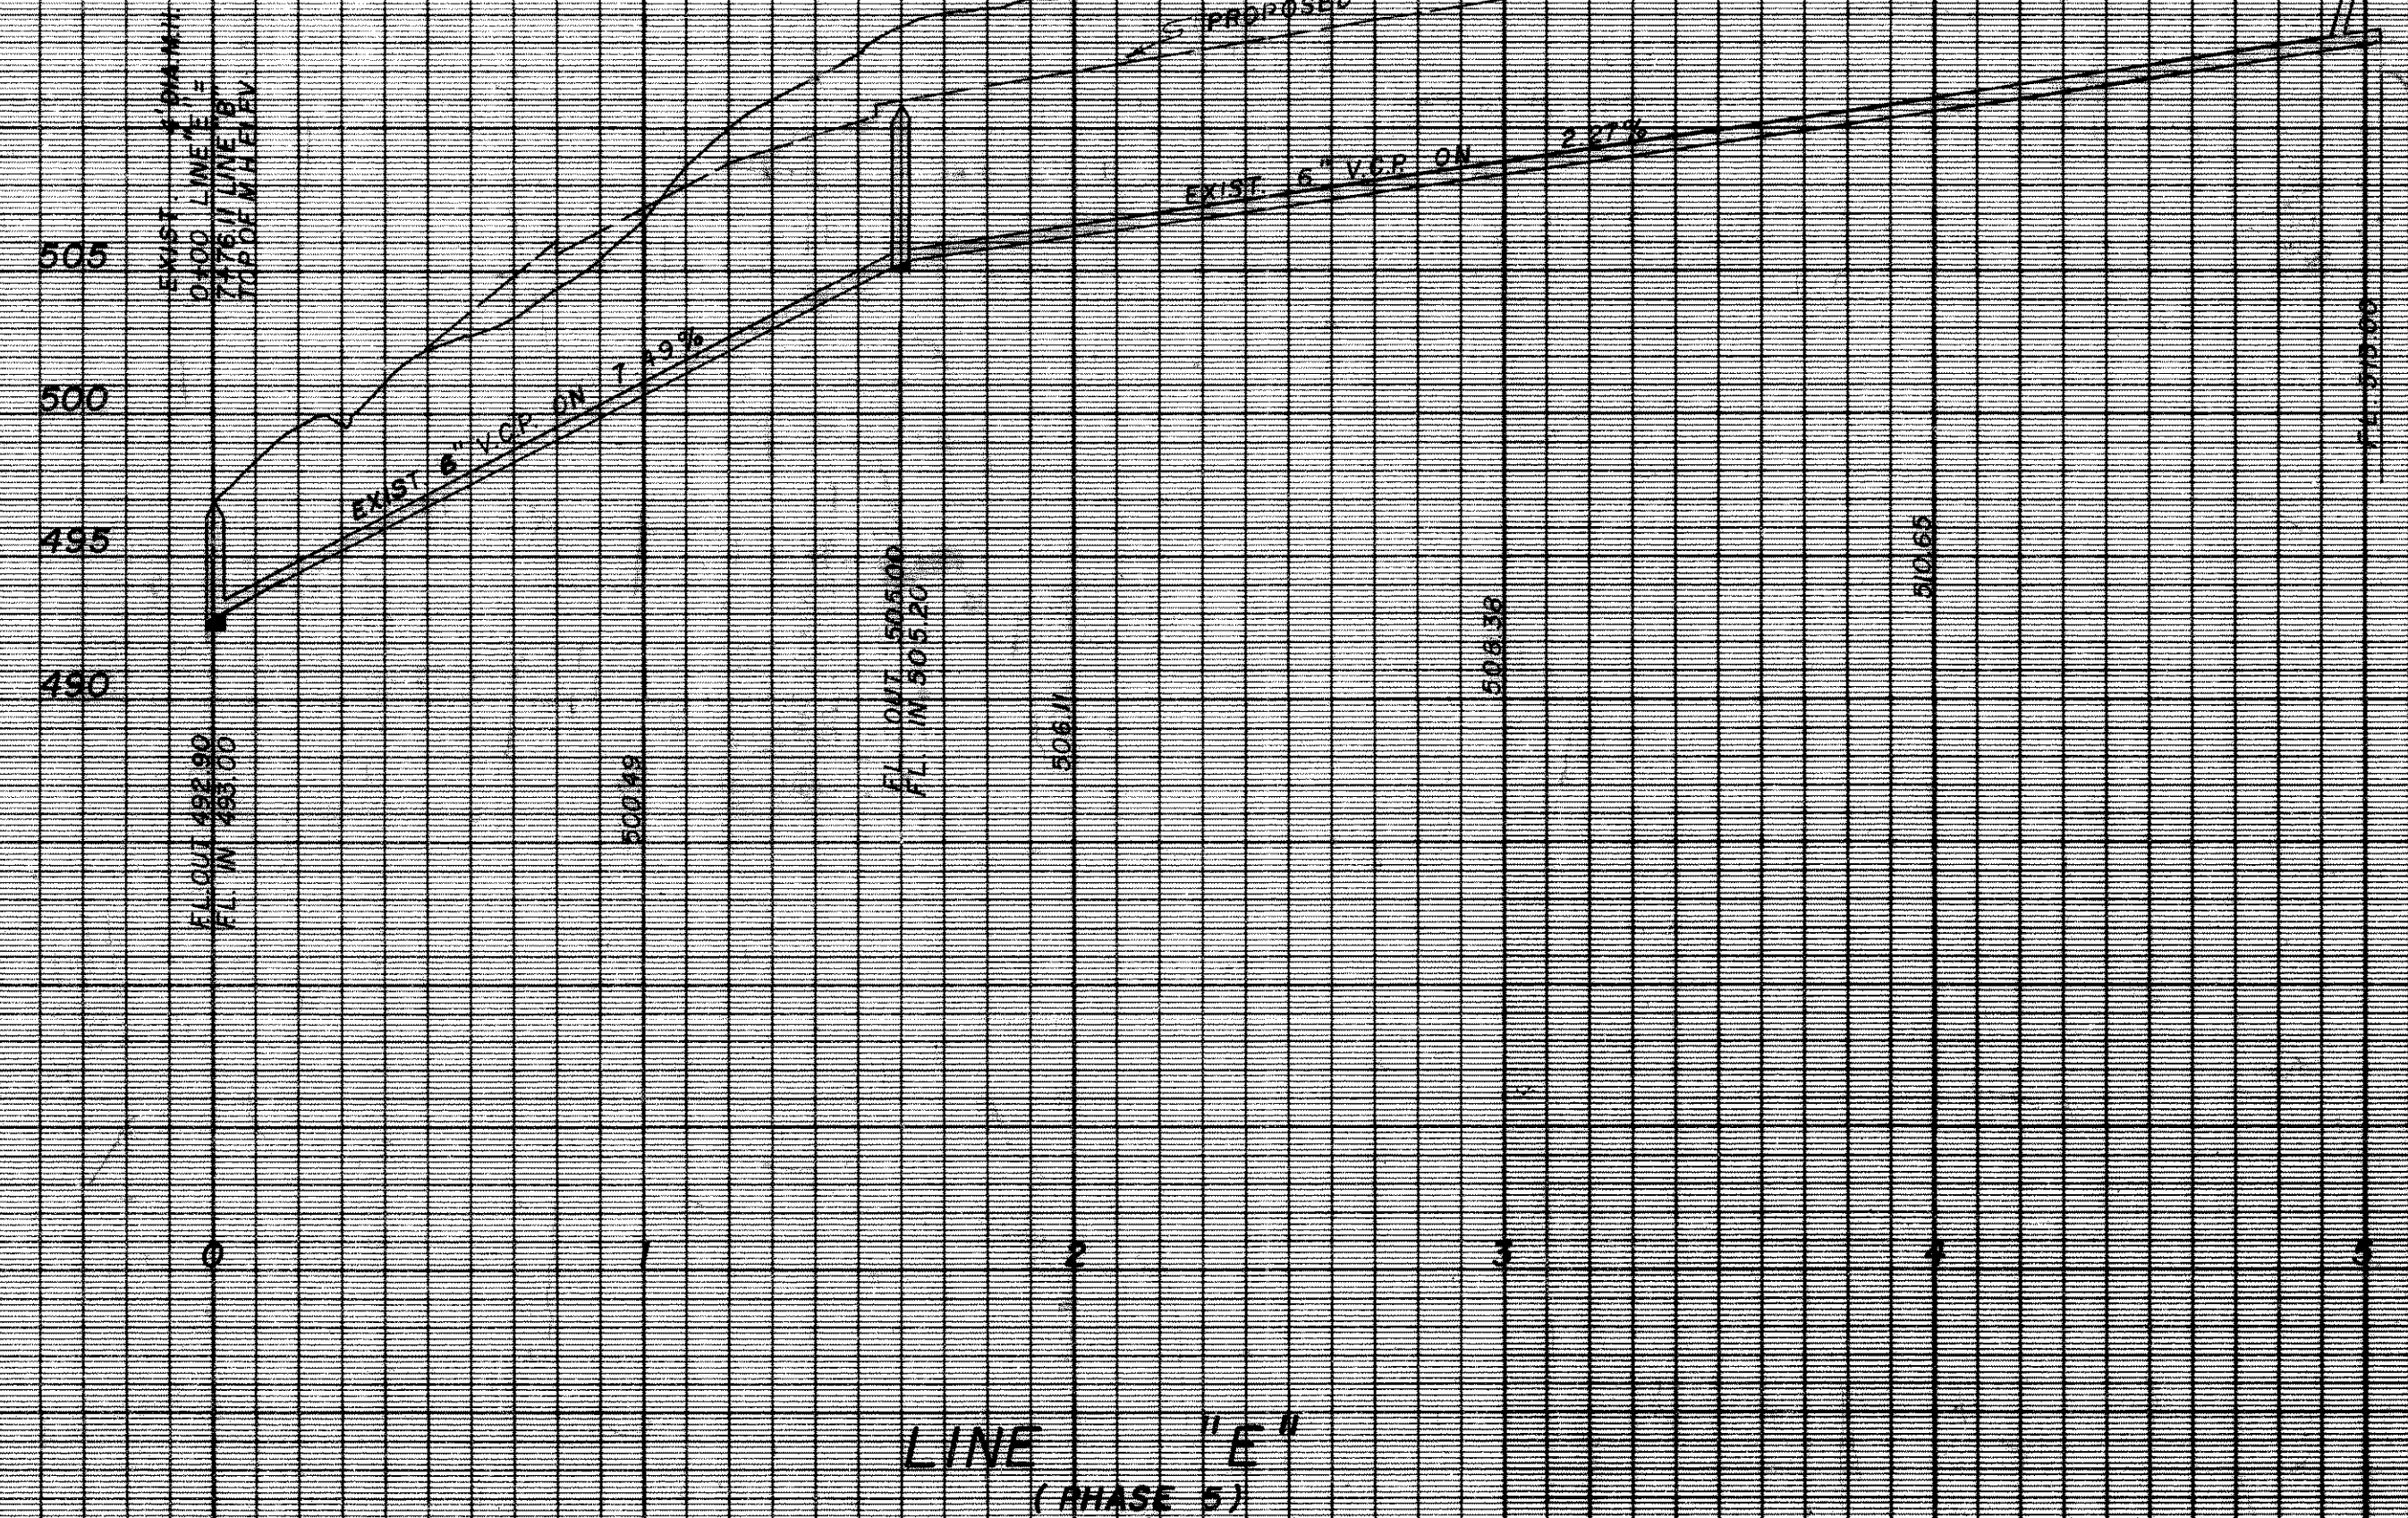
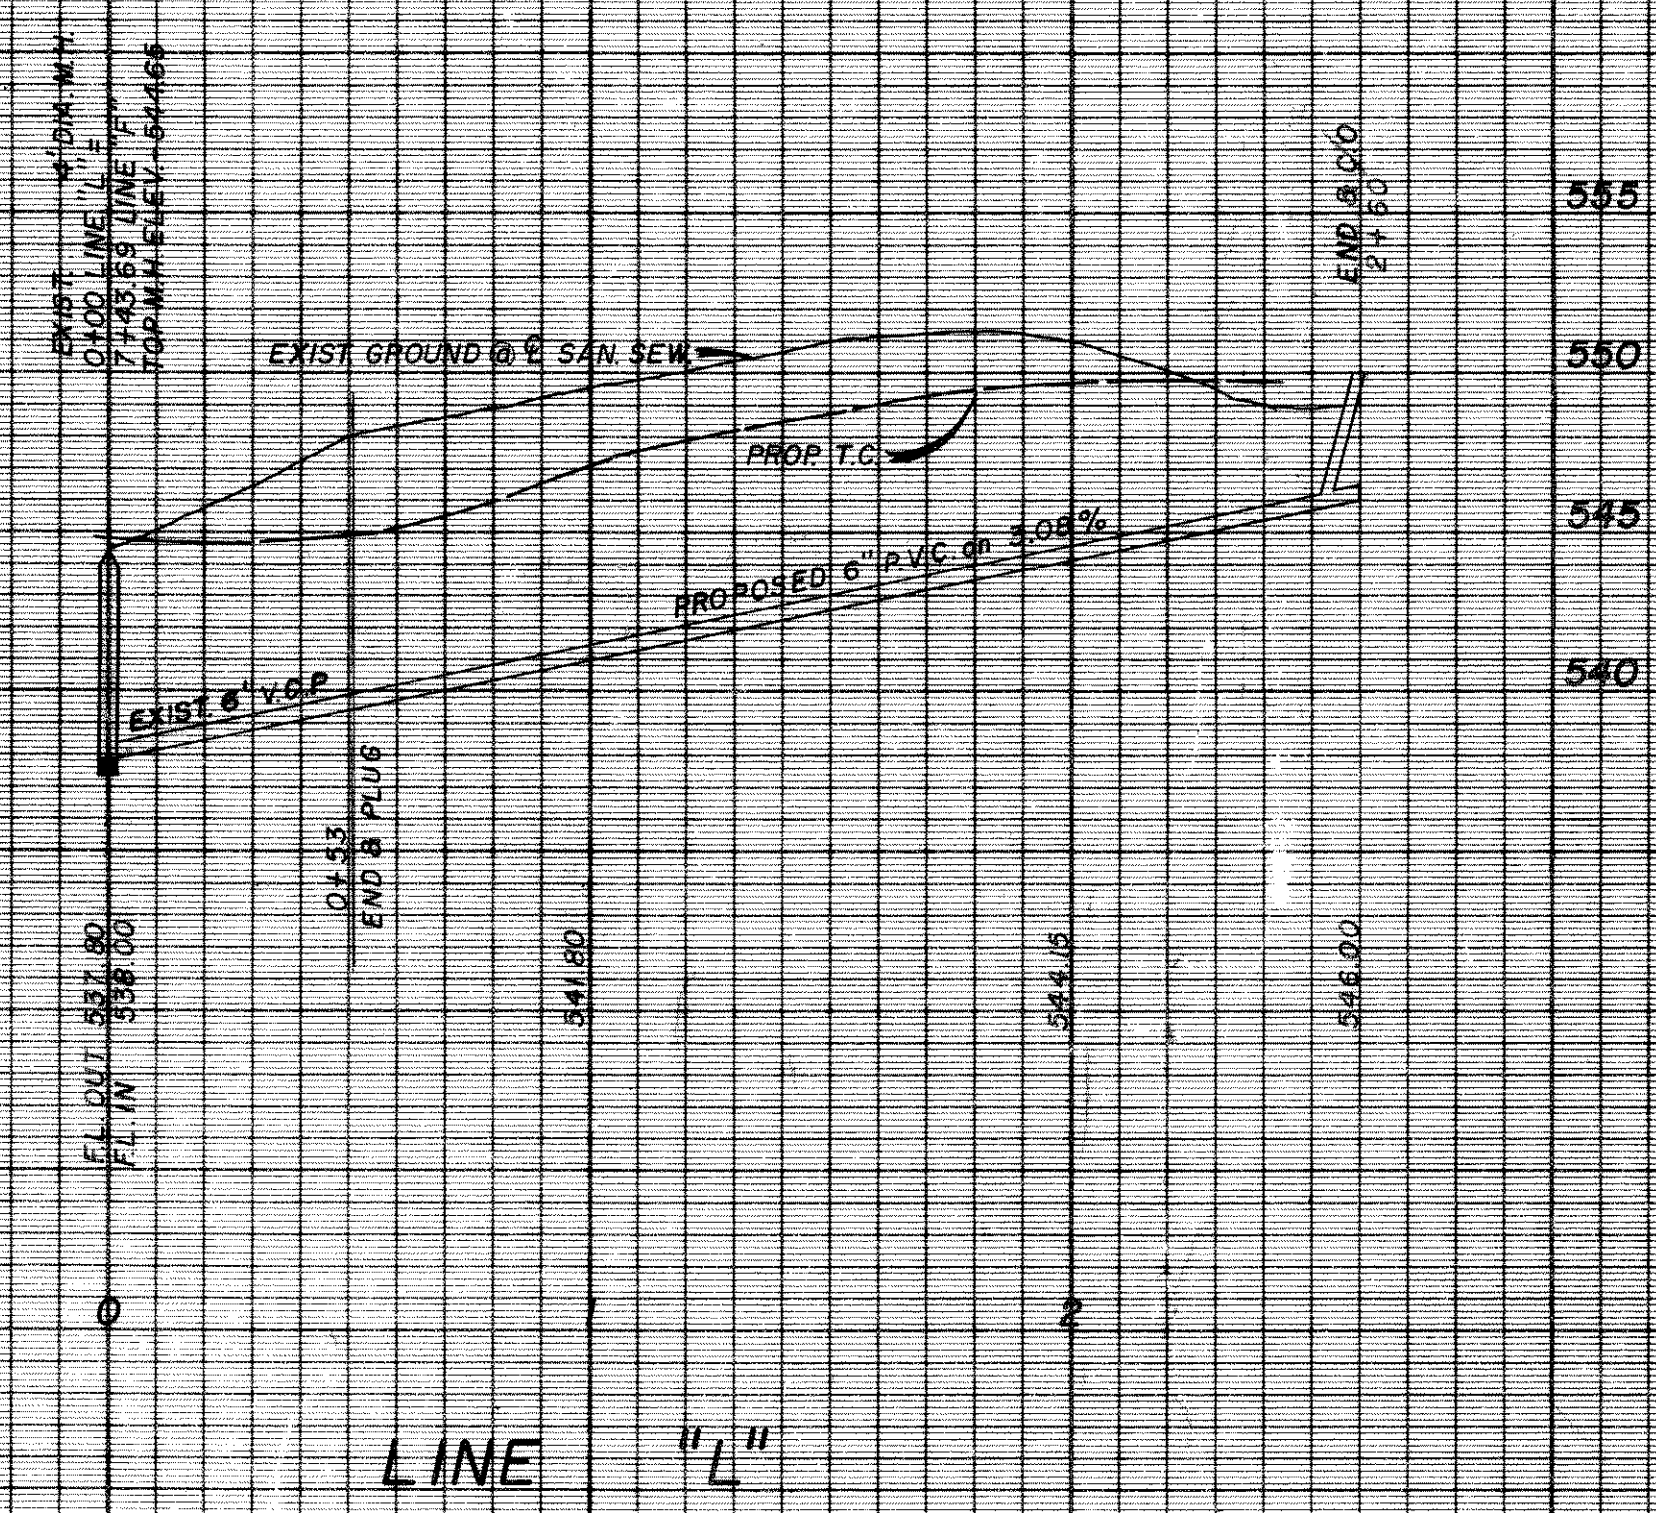


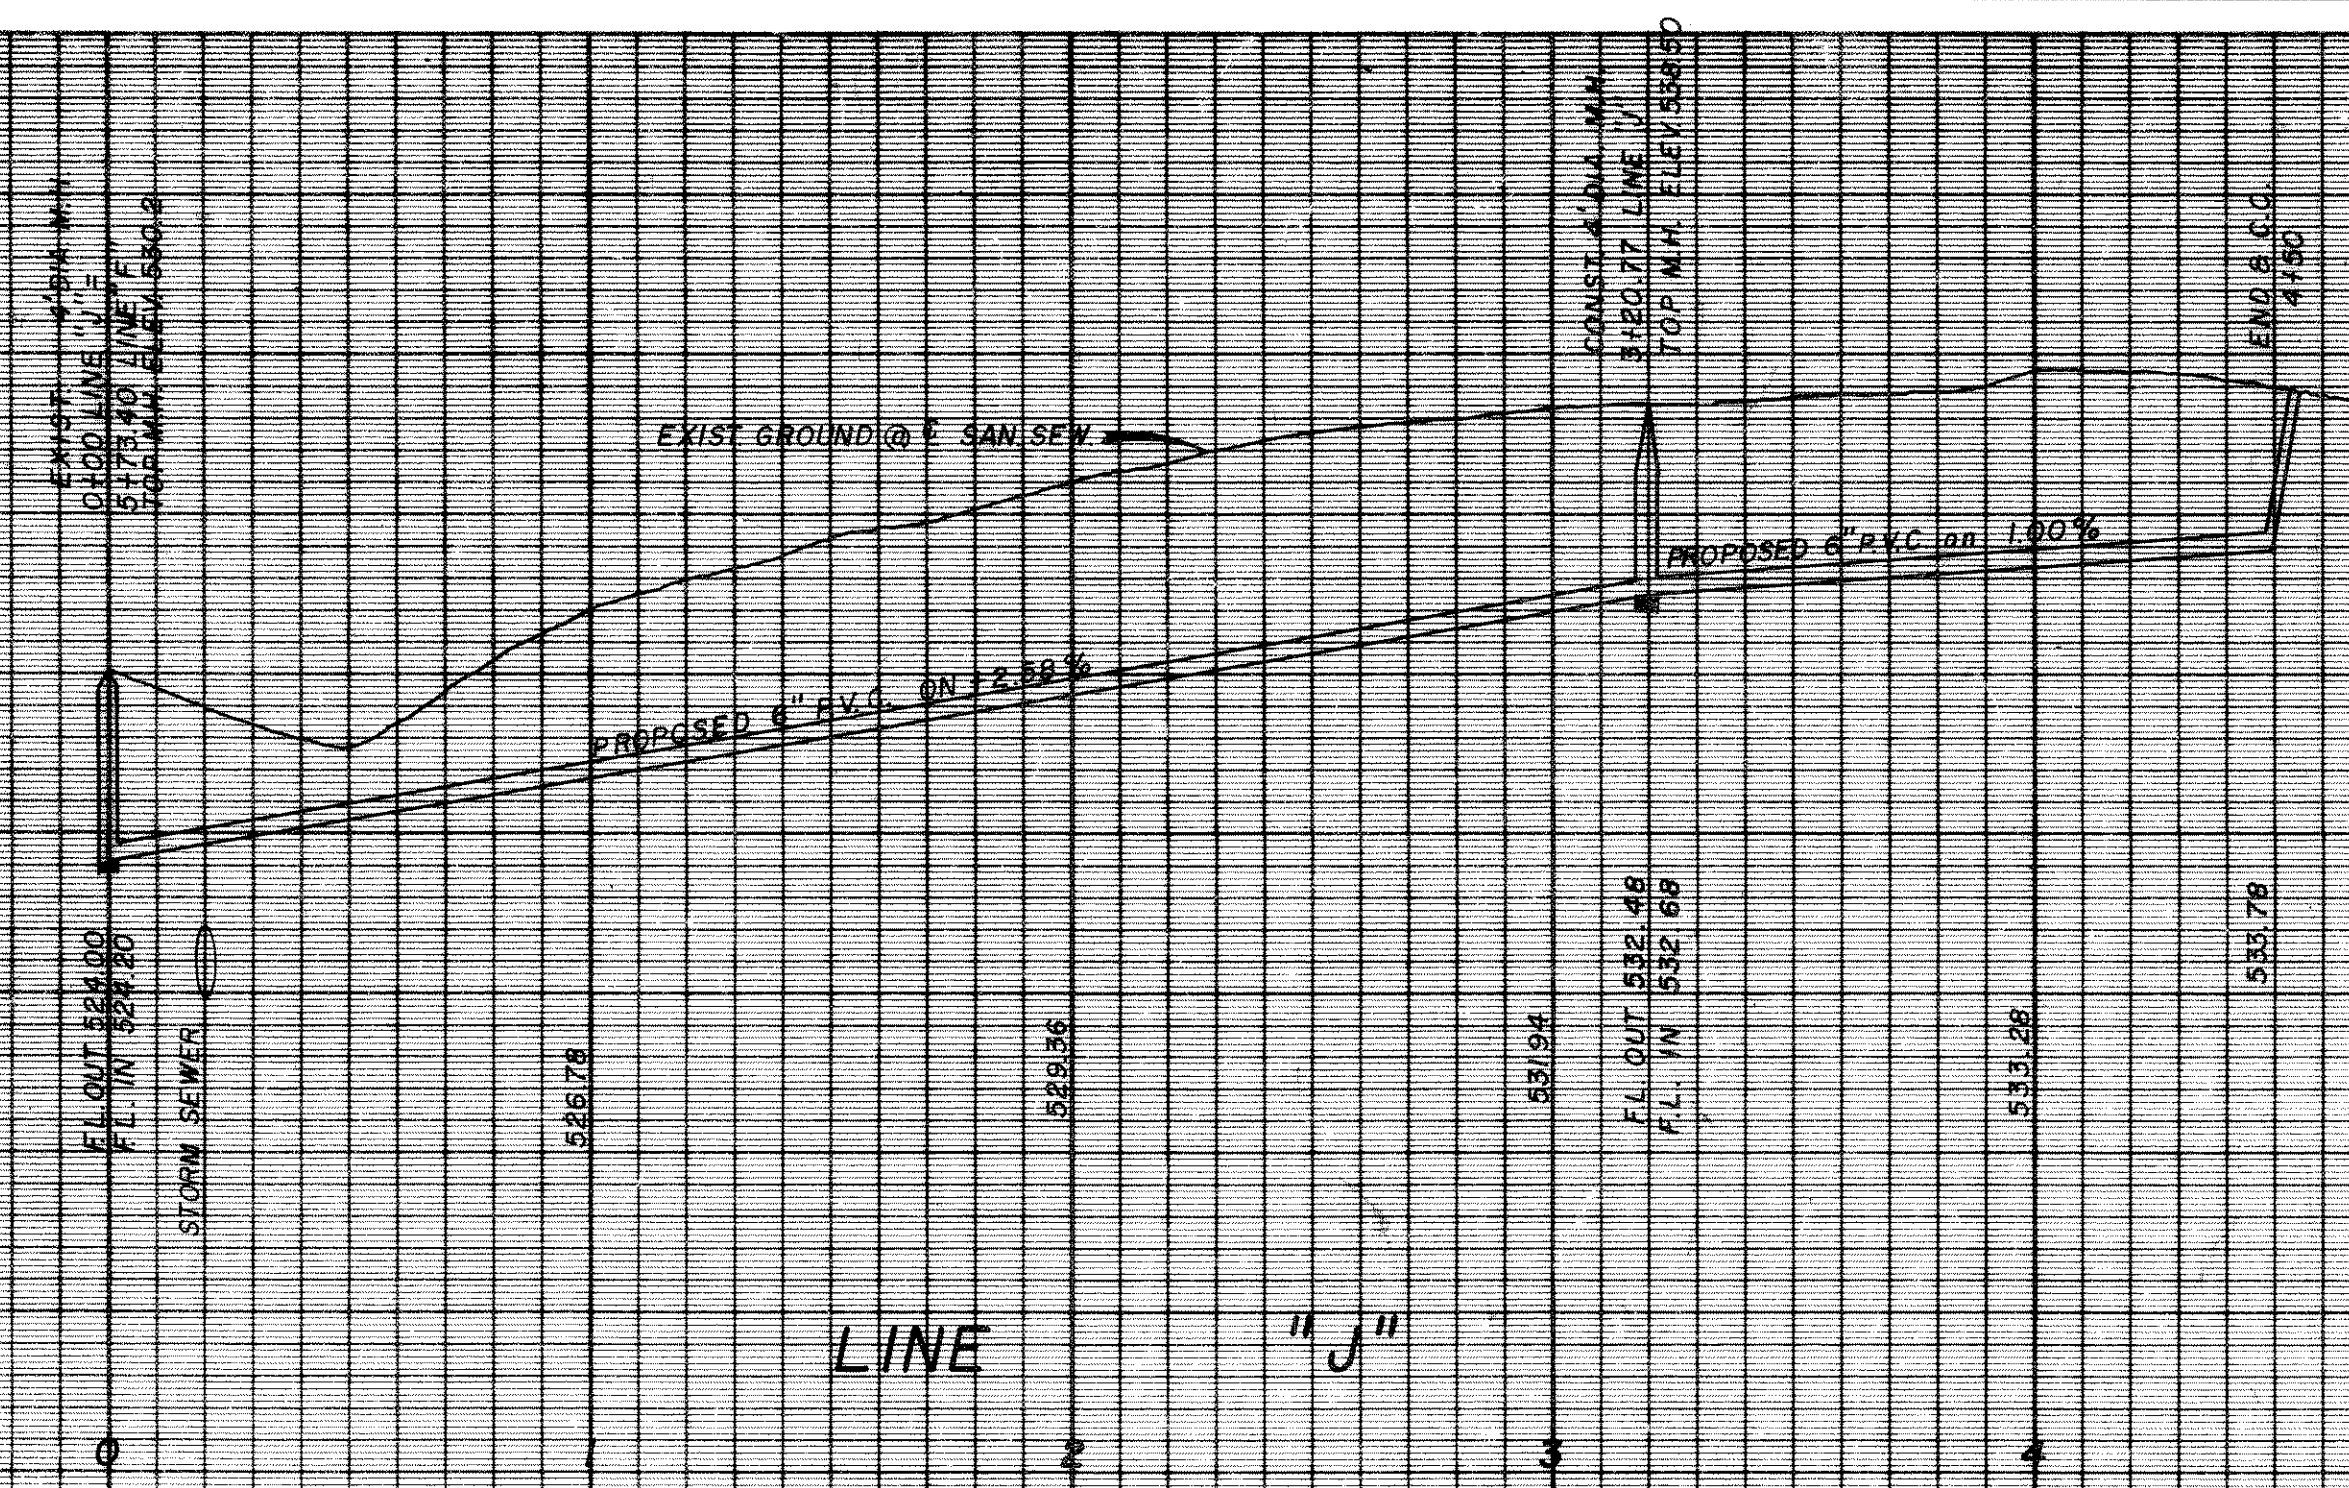

AS BUILT

14					
CHANDLERS LANDING					
PROPOSED SANITARY SEWER					
LINES "J", "L", "M" & "E"					
ROCKWALL, TEXAS					
PHASE 6					
DESIGN	DRAWN	DATE	SCALE	NOTES	FILE
H.L.E.	G.D.M.	6/7/73	1" = 40' H 1" = 6' V		NO.
					72122