



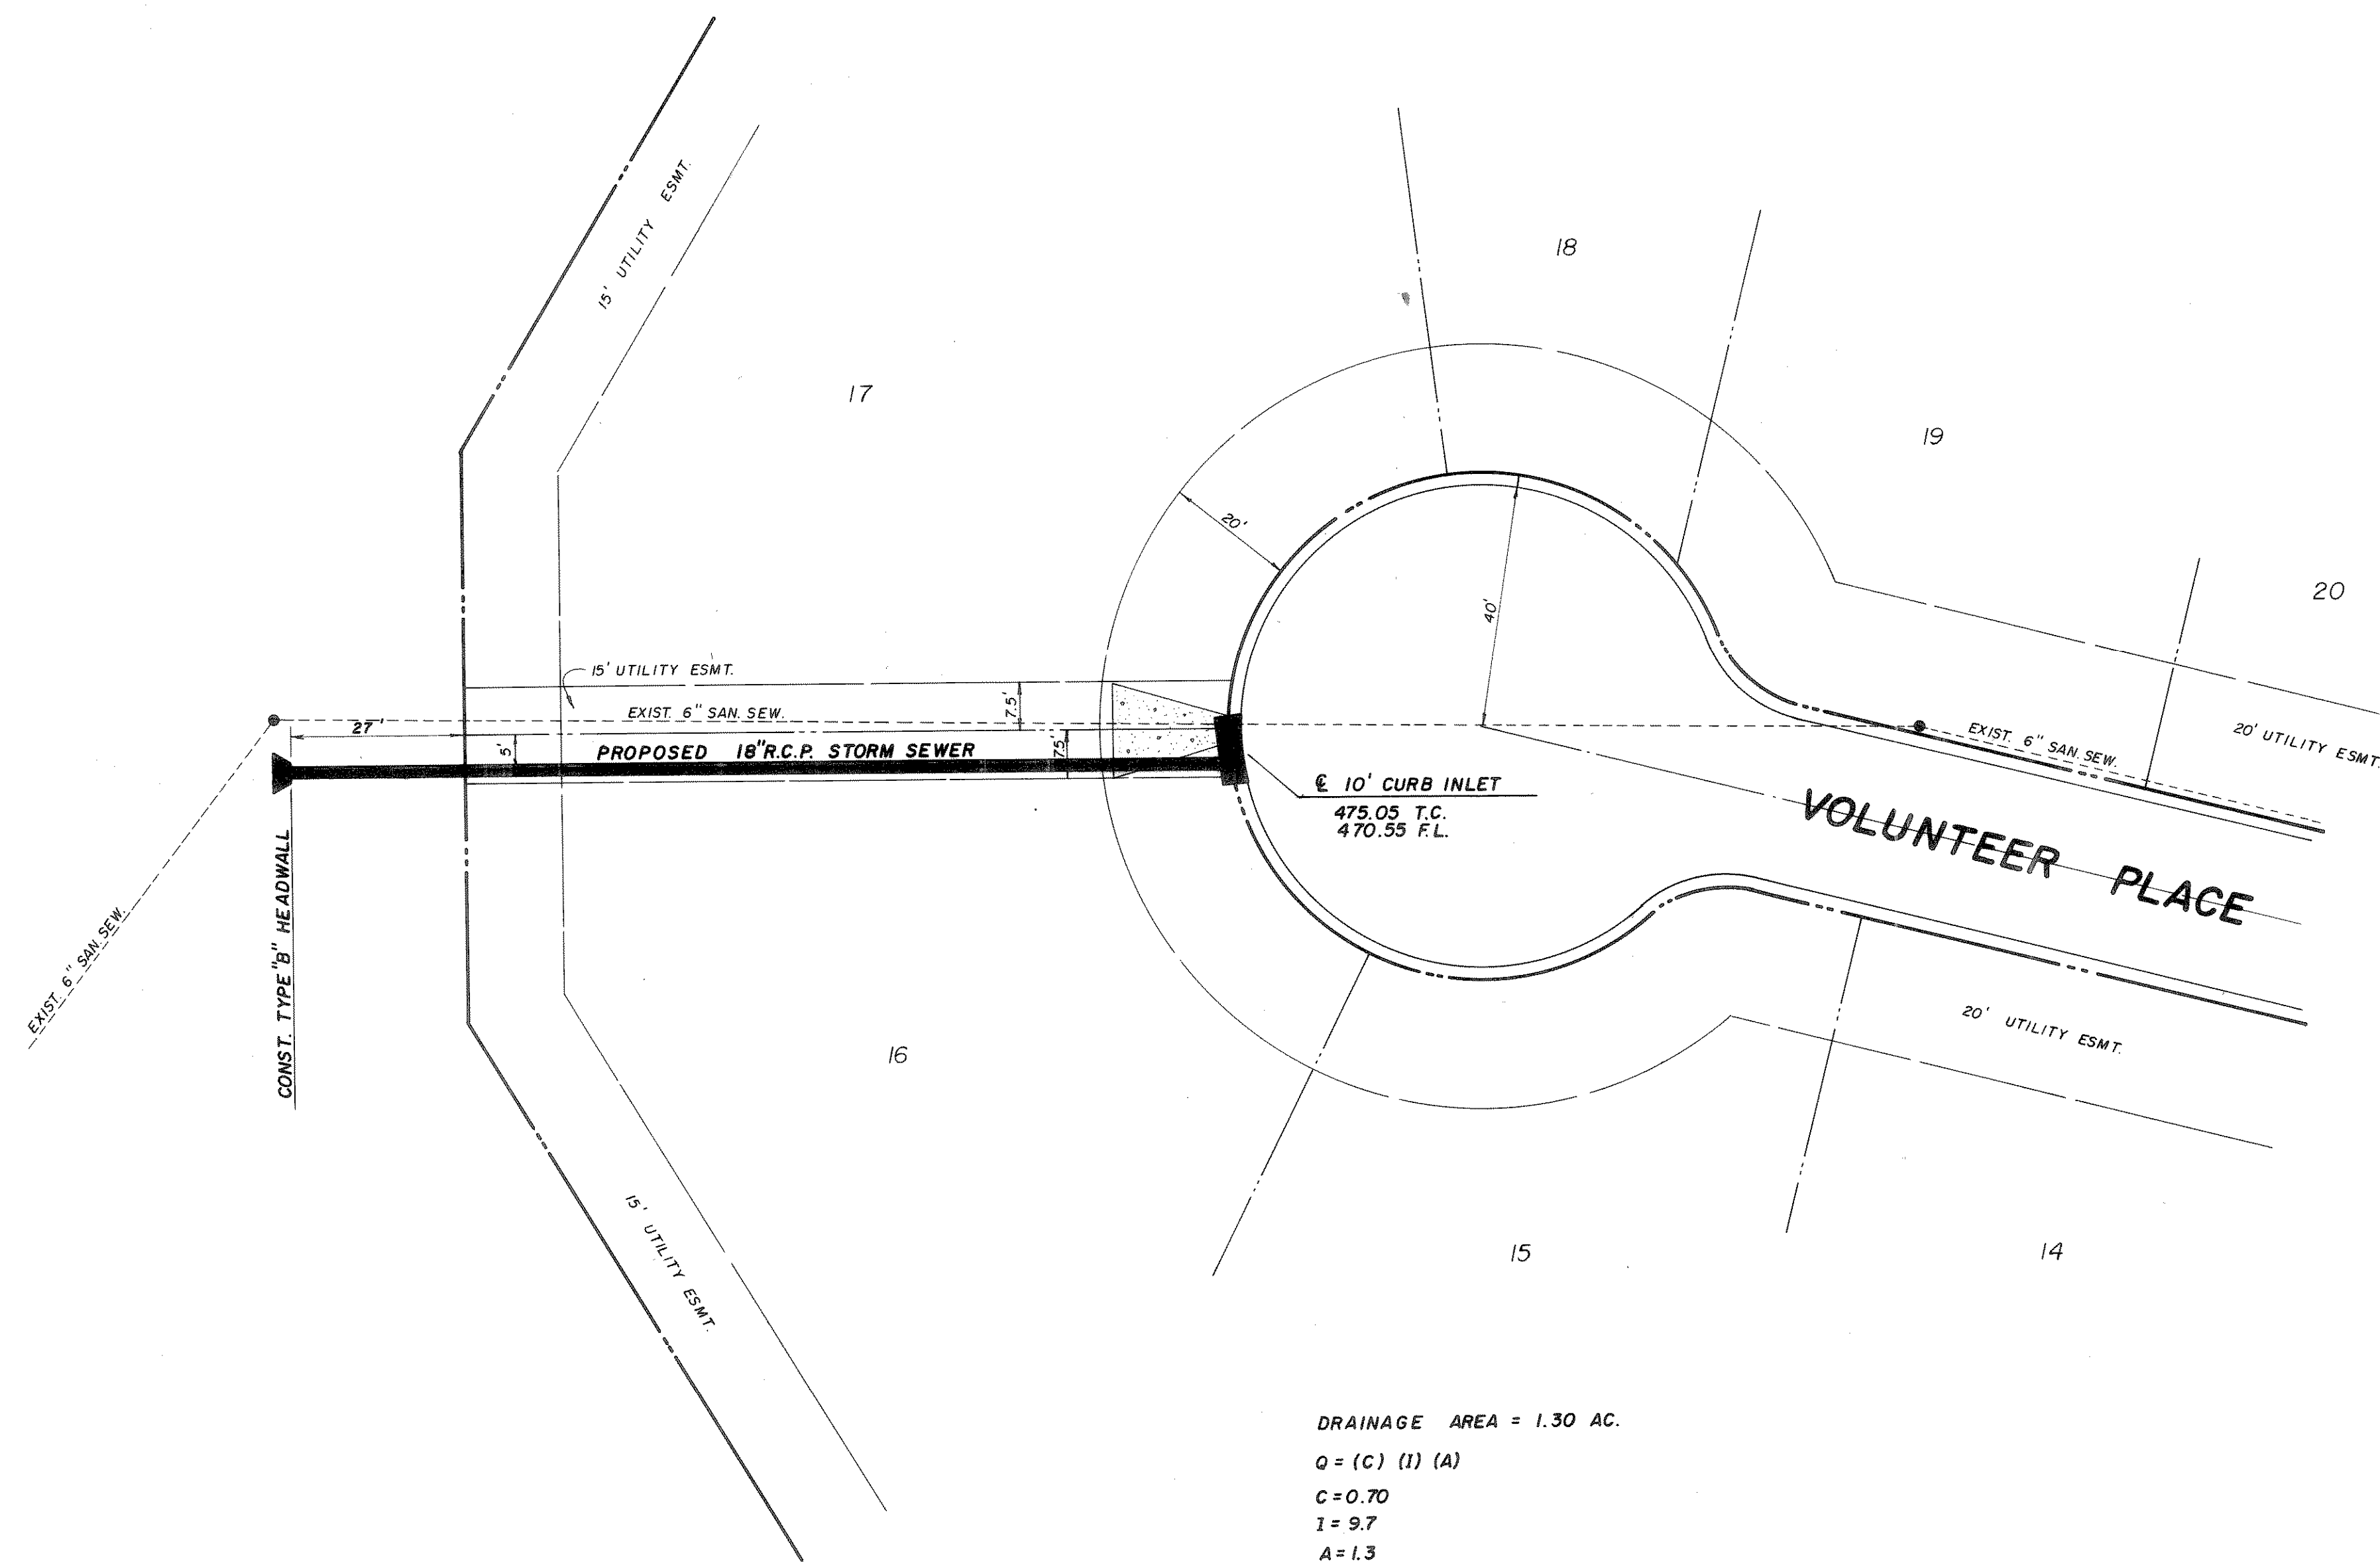

DRAINAGE AREA = 1.30 AC.
 $Q = (C) (I) (A)$
 $C = 0.70$
 $I = 9.7$
 $A = 1.3$
 $Q_{100} = (0.7) (9.7) (1.3) = 8.82 \text{ c.f.s.}$

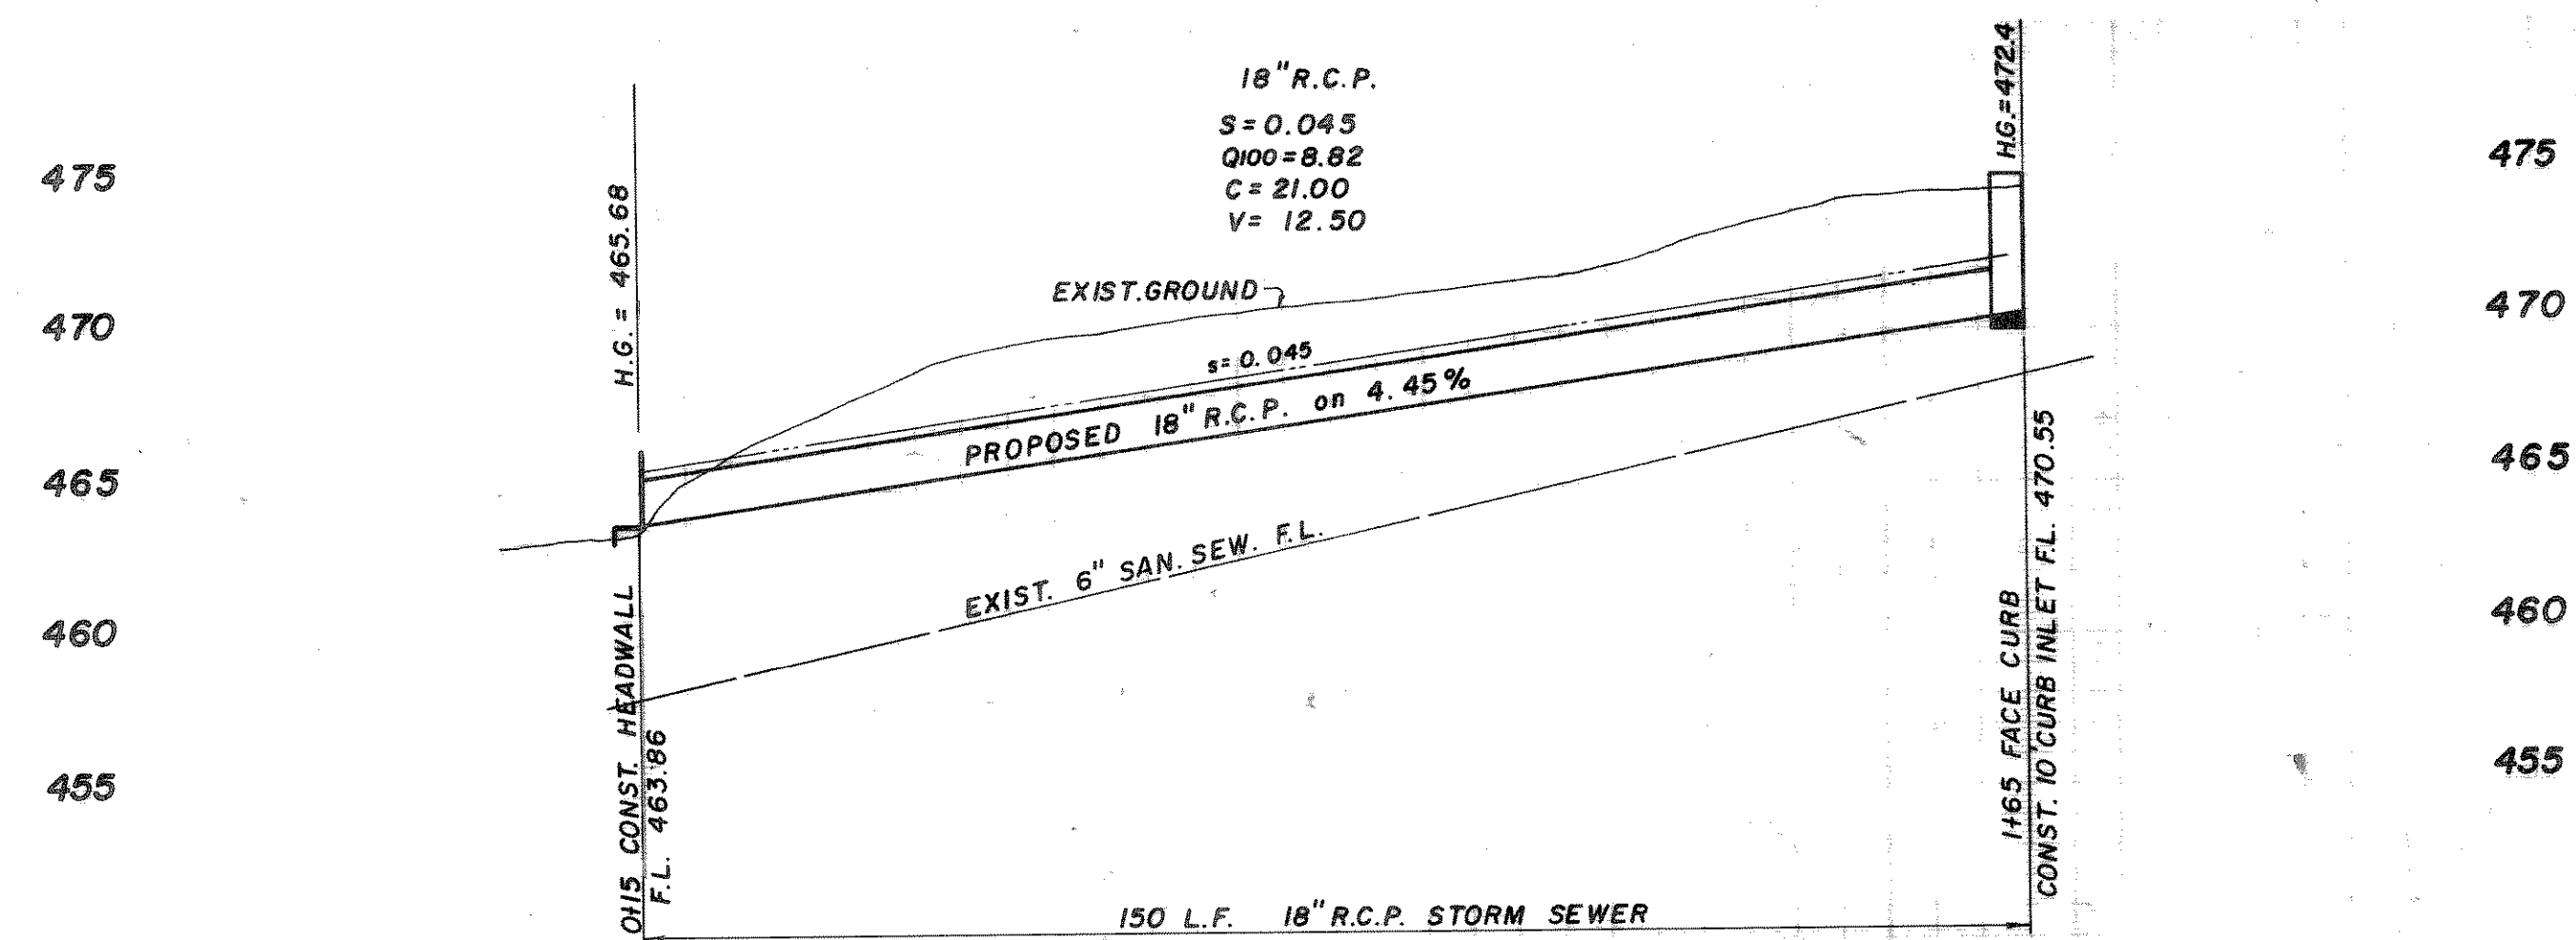

AS BUILT						
CHANDLERS LANDING PHASE SEVEN						
PROPOSED STORM SEWER						
ROCKWALL, TEXAS						
HAROLD L. EVANS CONSULTING ENGINEER						
DESIGN	DRAWN	DATE	SCALE	NOTES	FILE	NO.
H.L.E.	Danny O.	4-25-75	1"=20' H. 1"=6' V.			72122