
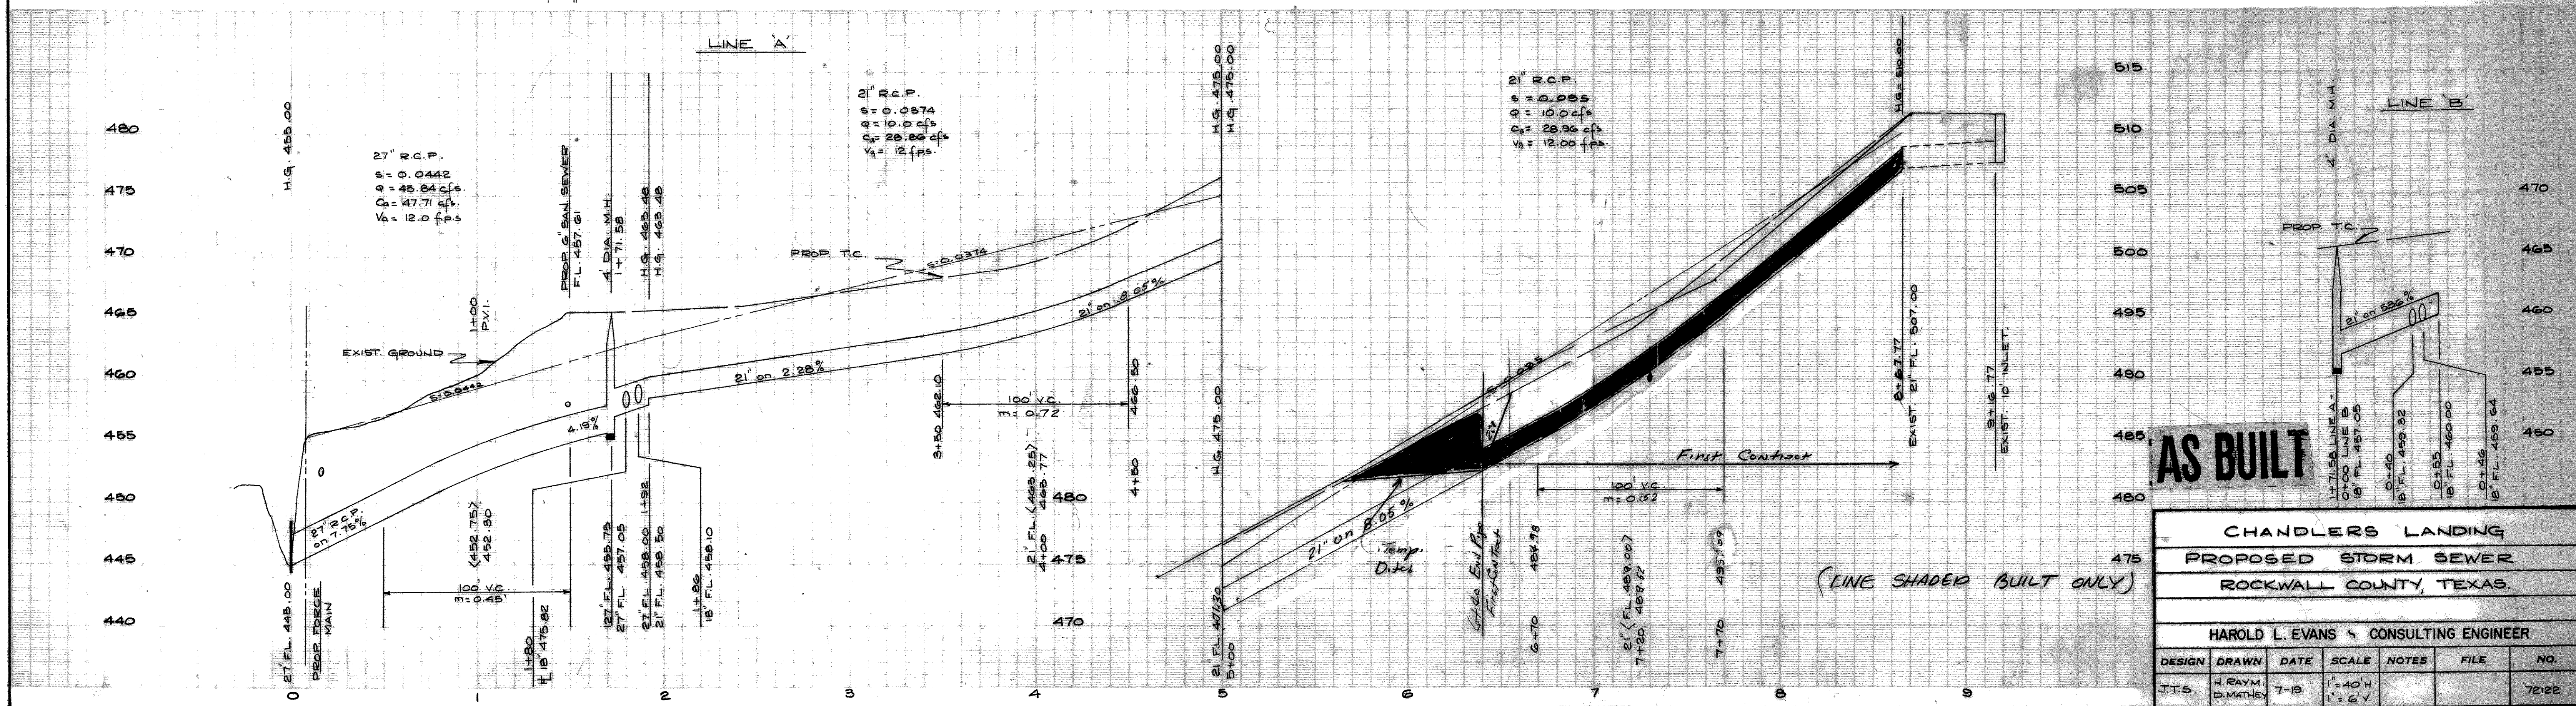


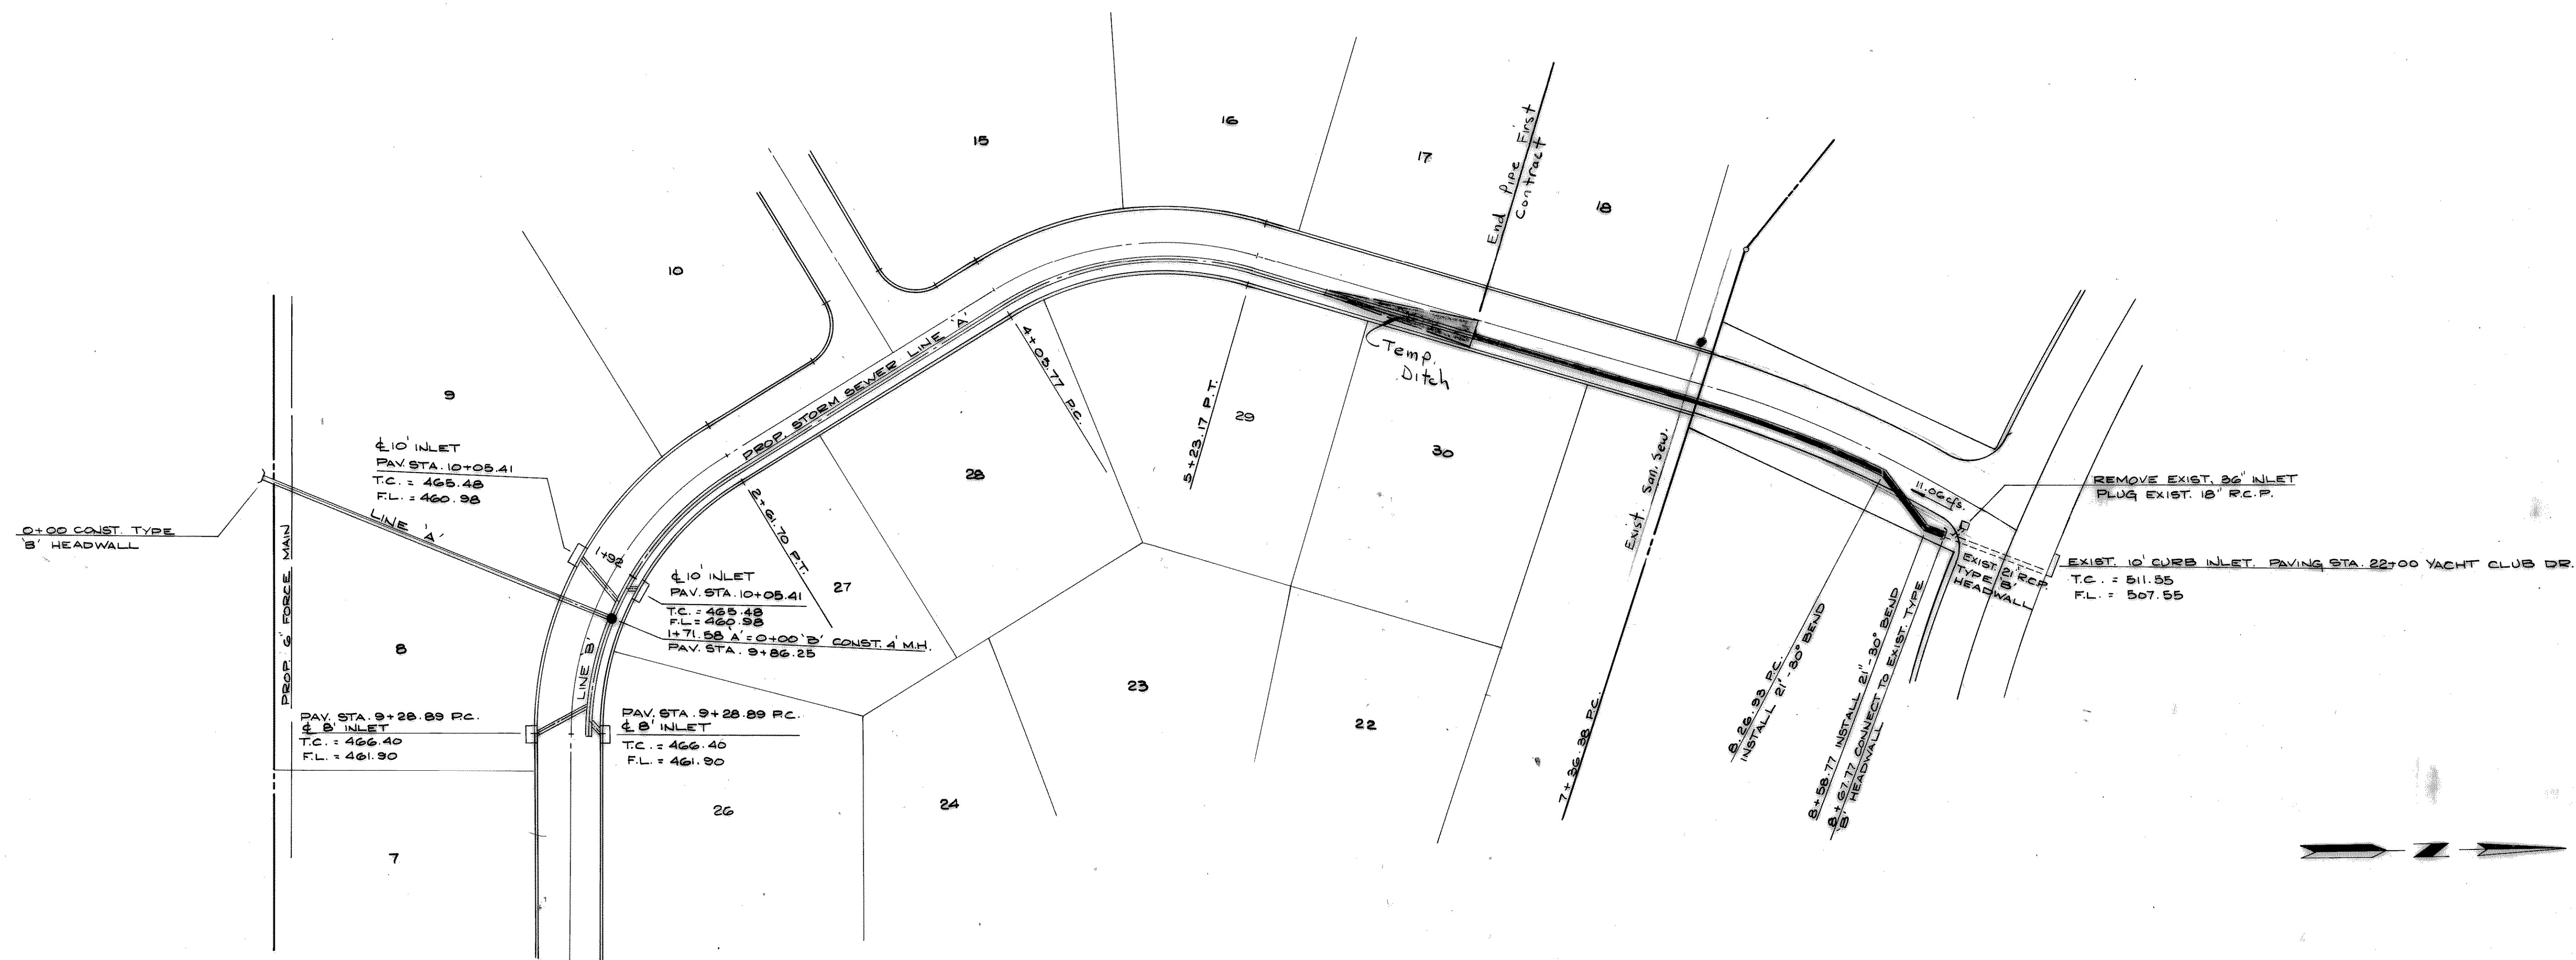

AS BUILT

CHANDLERS LANDING					
PROPOSED STORM SEWER					
ROCKWALL COUNTY, TEXAS.					
HAROLD L. EVANS & CONSULTING ENGINEER					
DESIGN	DRAWN	DATE	SCALE	NOTES	FILE NO.
J.T.S.	H. RAYM.	7-19	1" = 40' H 1" = 6' V		72122

(PHASE 9)?