

CUTTER HILL
PHASE II

0+45 F.M.
INSTALL: 1-45° BEND

1+25 F.M.
INSTALL: 1-45° BEND
1-22½ BEND.

PHASE NINE. SECTION 2 & 3

0+00 F.M.
PROPOSED ABOVE GROUND PACKAGE
LIFT STATION.


PROPOSED PACKAGE LIFT STATION

- 1) ABOVE GROUND.
- 2) VACUUM PRIME
- 3) ENCLOSED
- 4) 3-PHASE
- 5) 250 G.P.M. @ 142 T.D.H.
- 6) BY CAN-TEX INDUSTRIES

MATCH STA. 10+30

MARINA PARKING LOT.

CITY OF DALLAS TAKE LINE

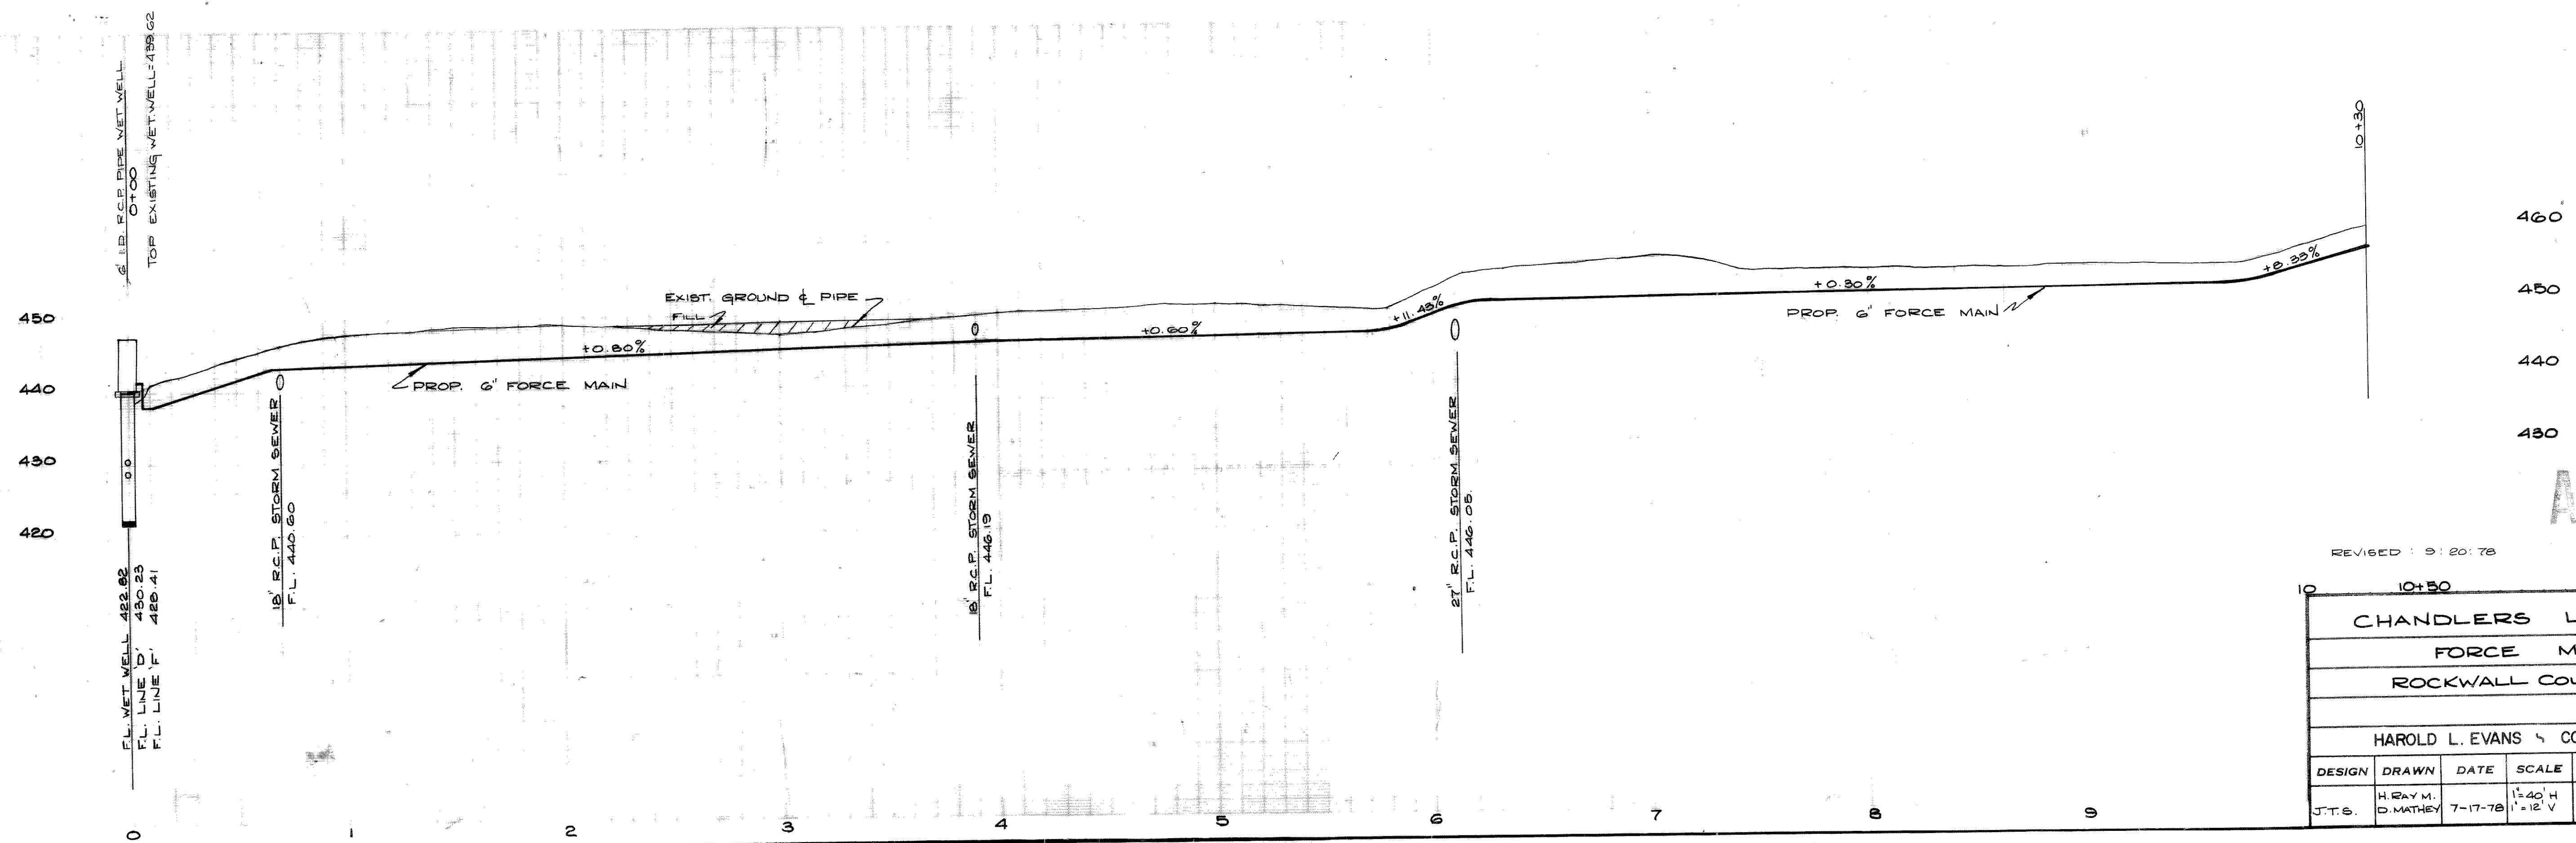

AS BUILT

REVISED: 9-20-78

CHANDLERS LANDING						
FORCE MAIN						
ROCKWALL COUNTY, TEXAS						
HAROLD L. EVANS & CONSULTING ENGINEER						
DESIGN	DRAWN	DATE	SCALE	NOTES	FILE	NO.
J.T.S.	H.E.A.Y. M. D. MATHIEY	7-17-78	1"=40' H 1"=12' V			7212.2