
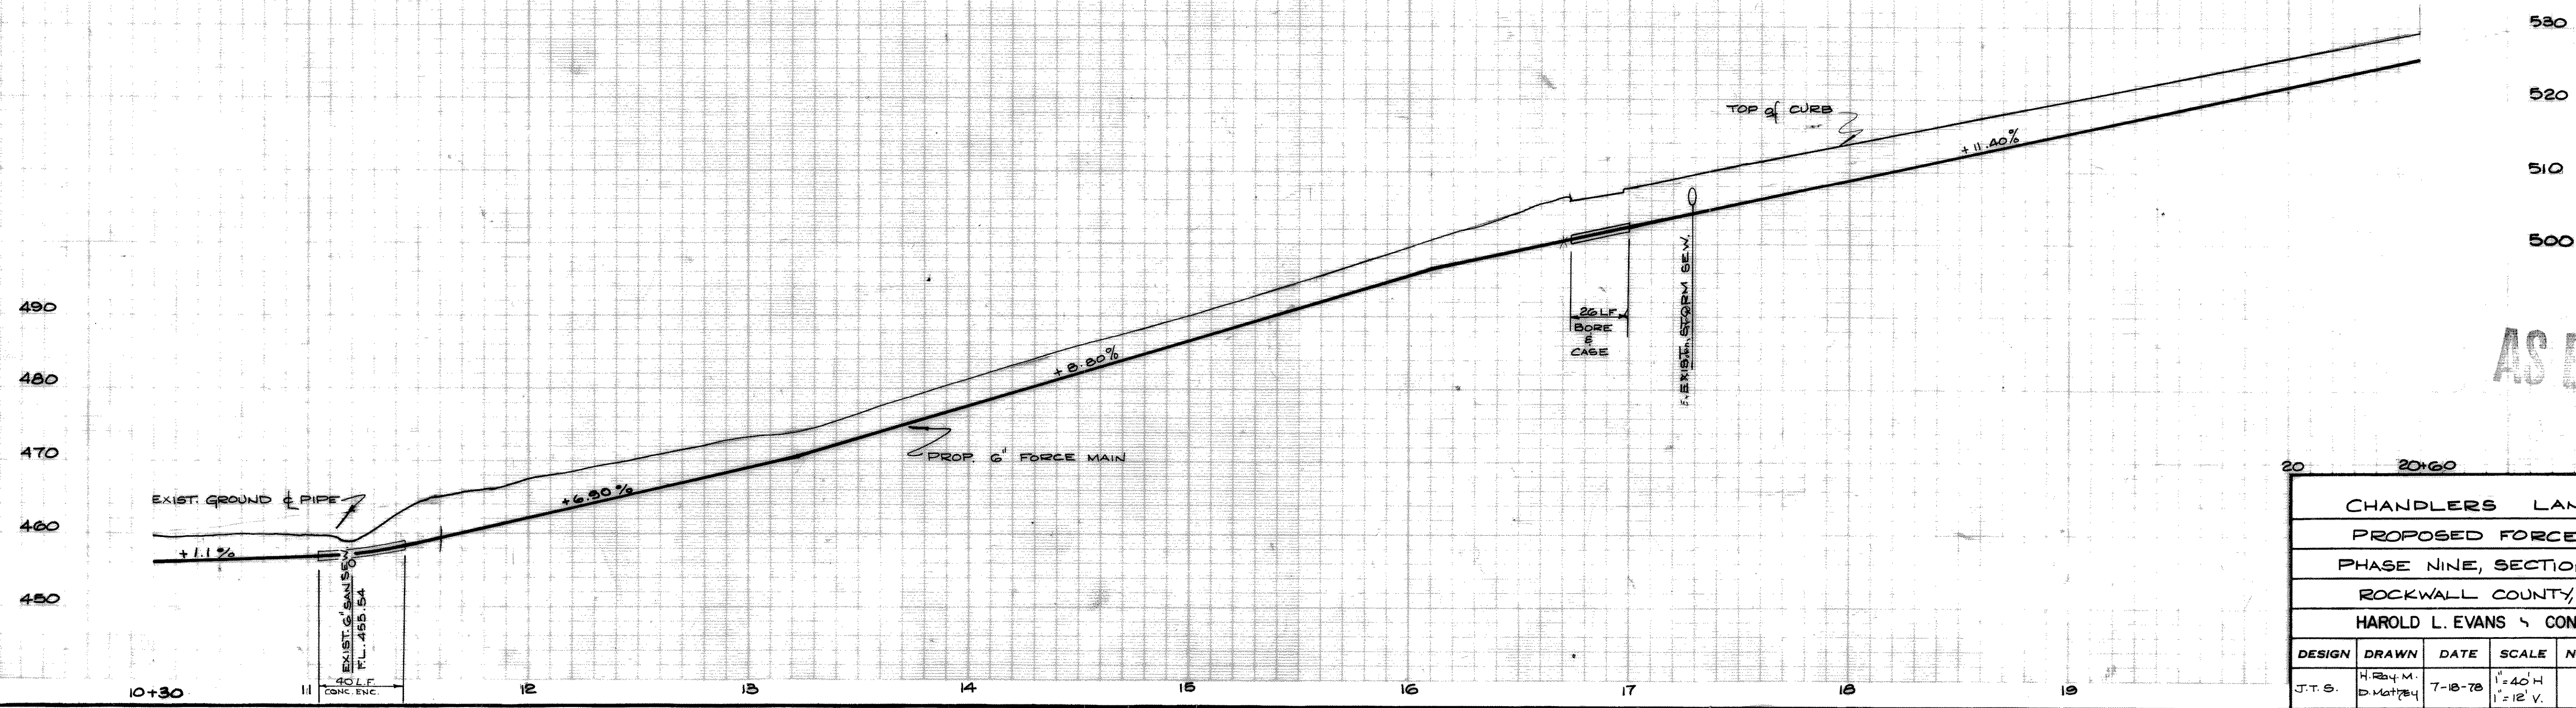


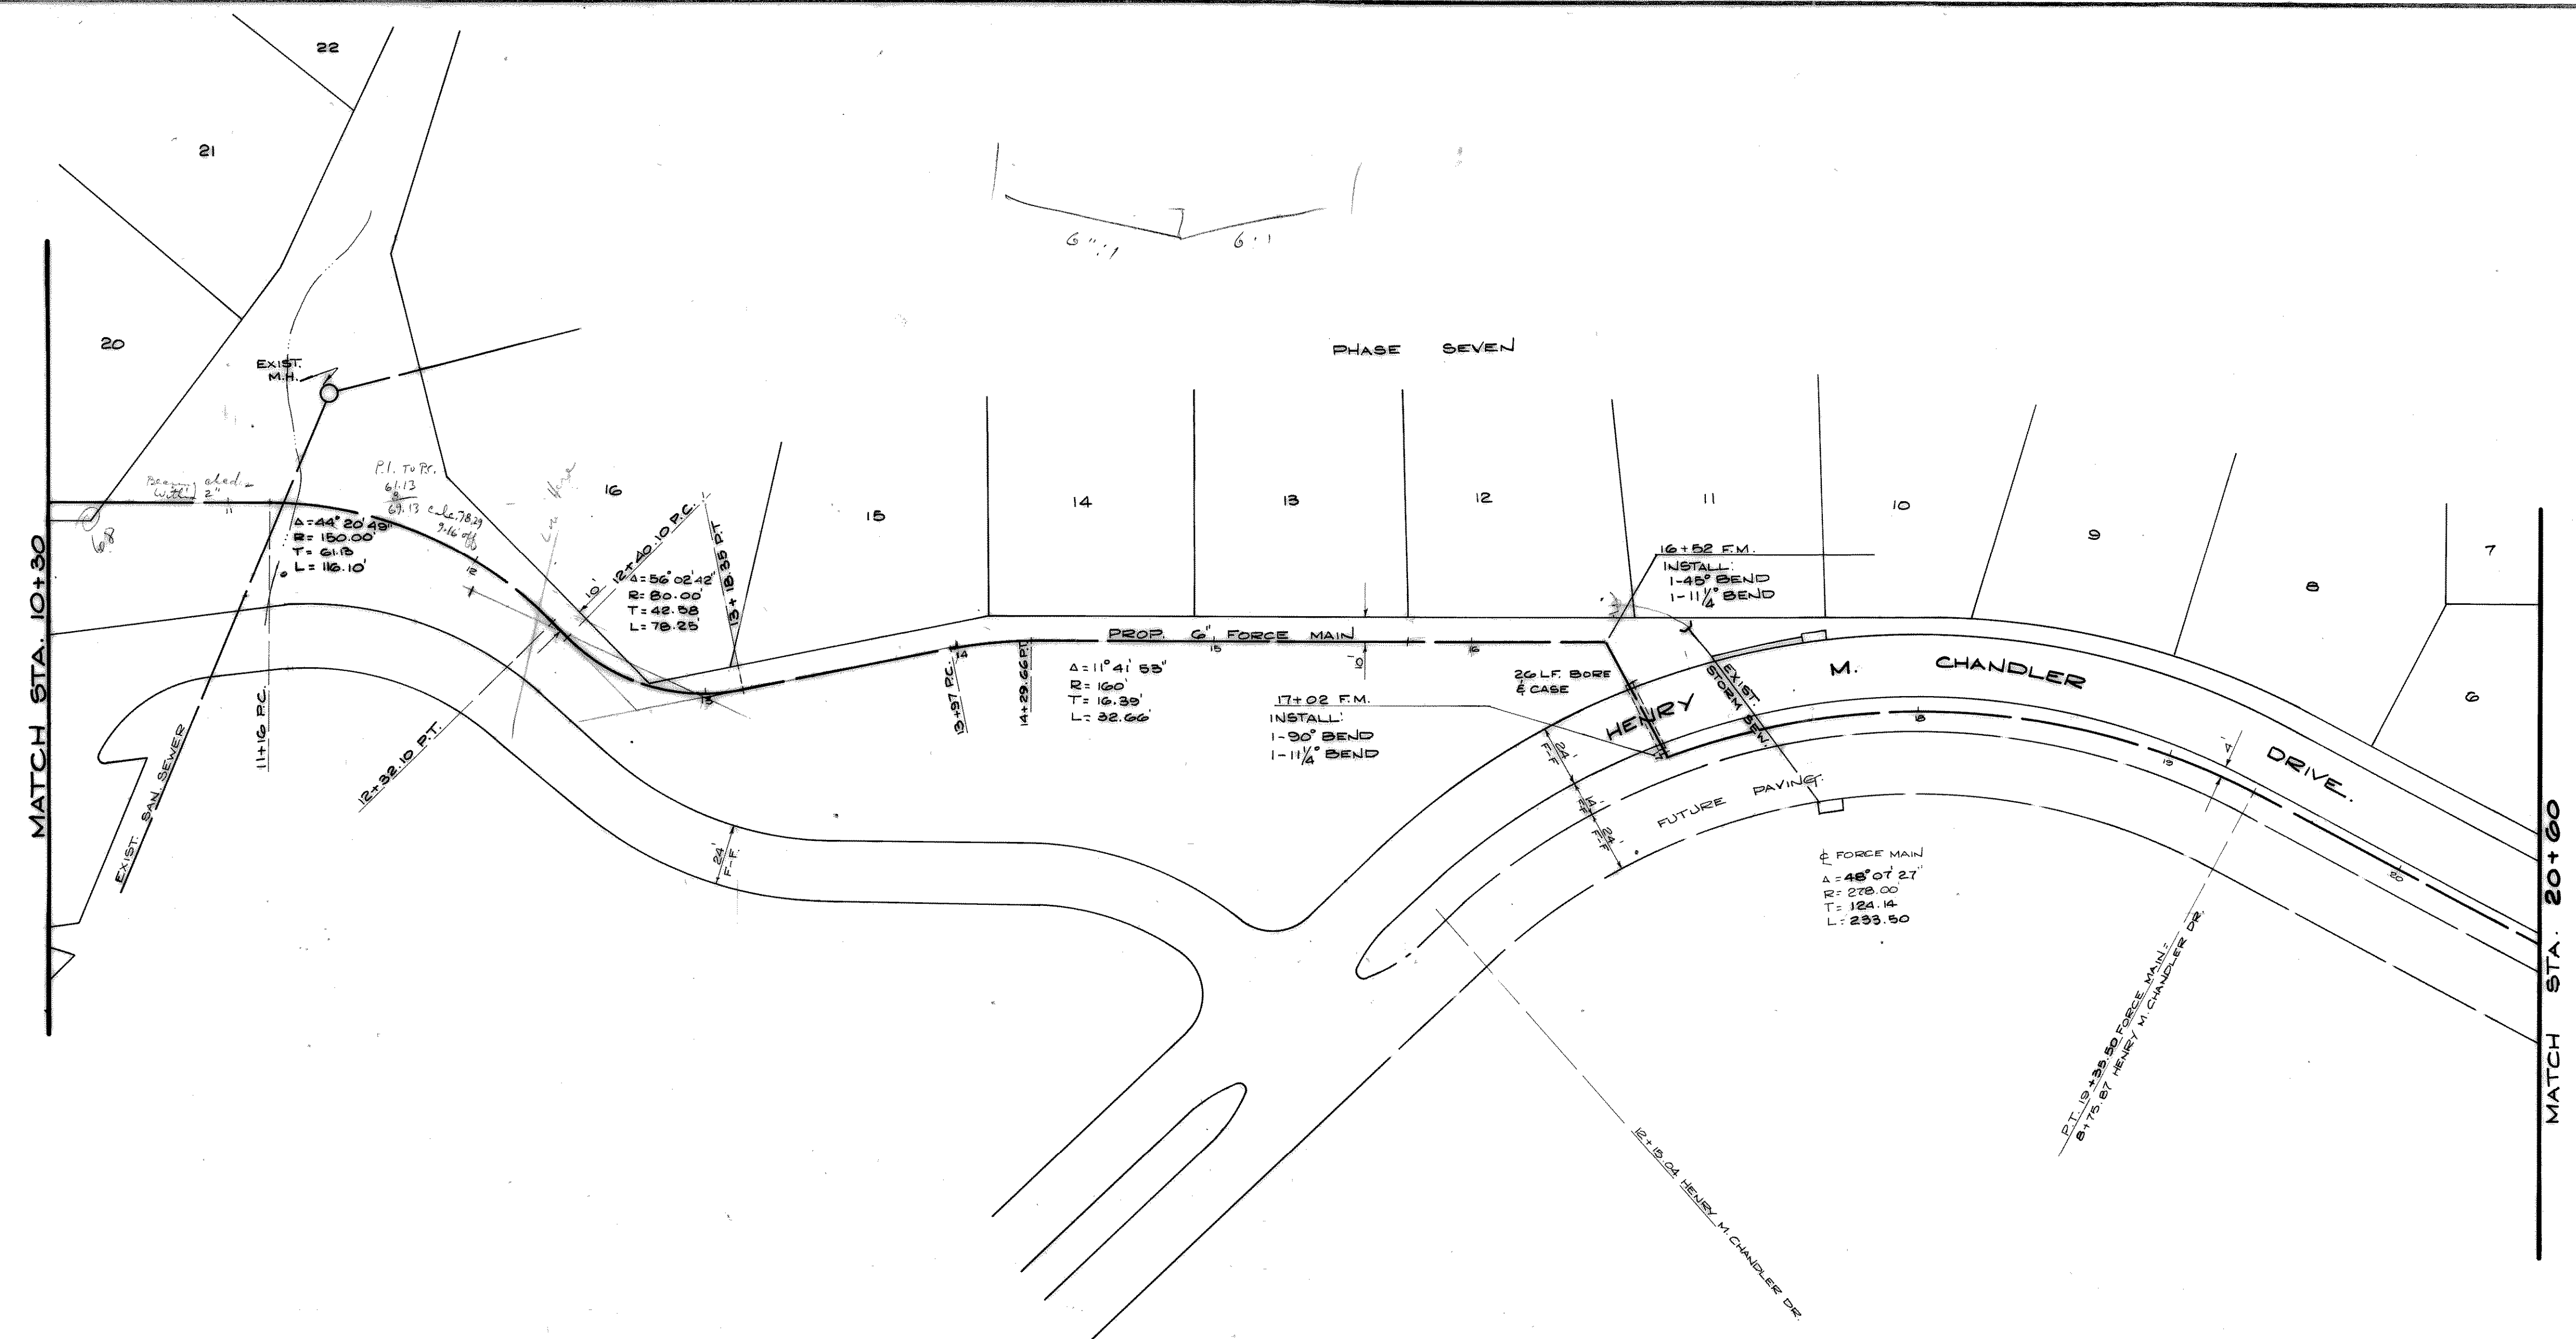

AS BUILT

CHANDLERS LANDING						
PROPOSED FORCE MAIN						
PHASE NINE, SECTION 2 & 3						
ROCKWALL COUNTY, TEXAS						
HAROLD L. EVANS & CONSULTING ENGINEER						
DESIGN	DRAWN	DATE	SCALE	NOTES	FILE	NO.
J.T.S.	H. Ray M. D. Mat 784	7-18-78	1"=40' H 1"=12' V.			72122