
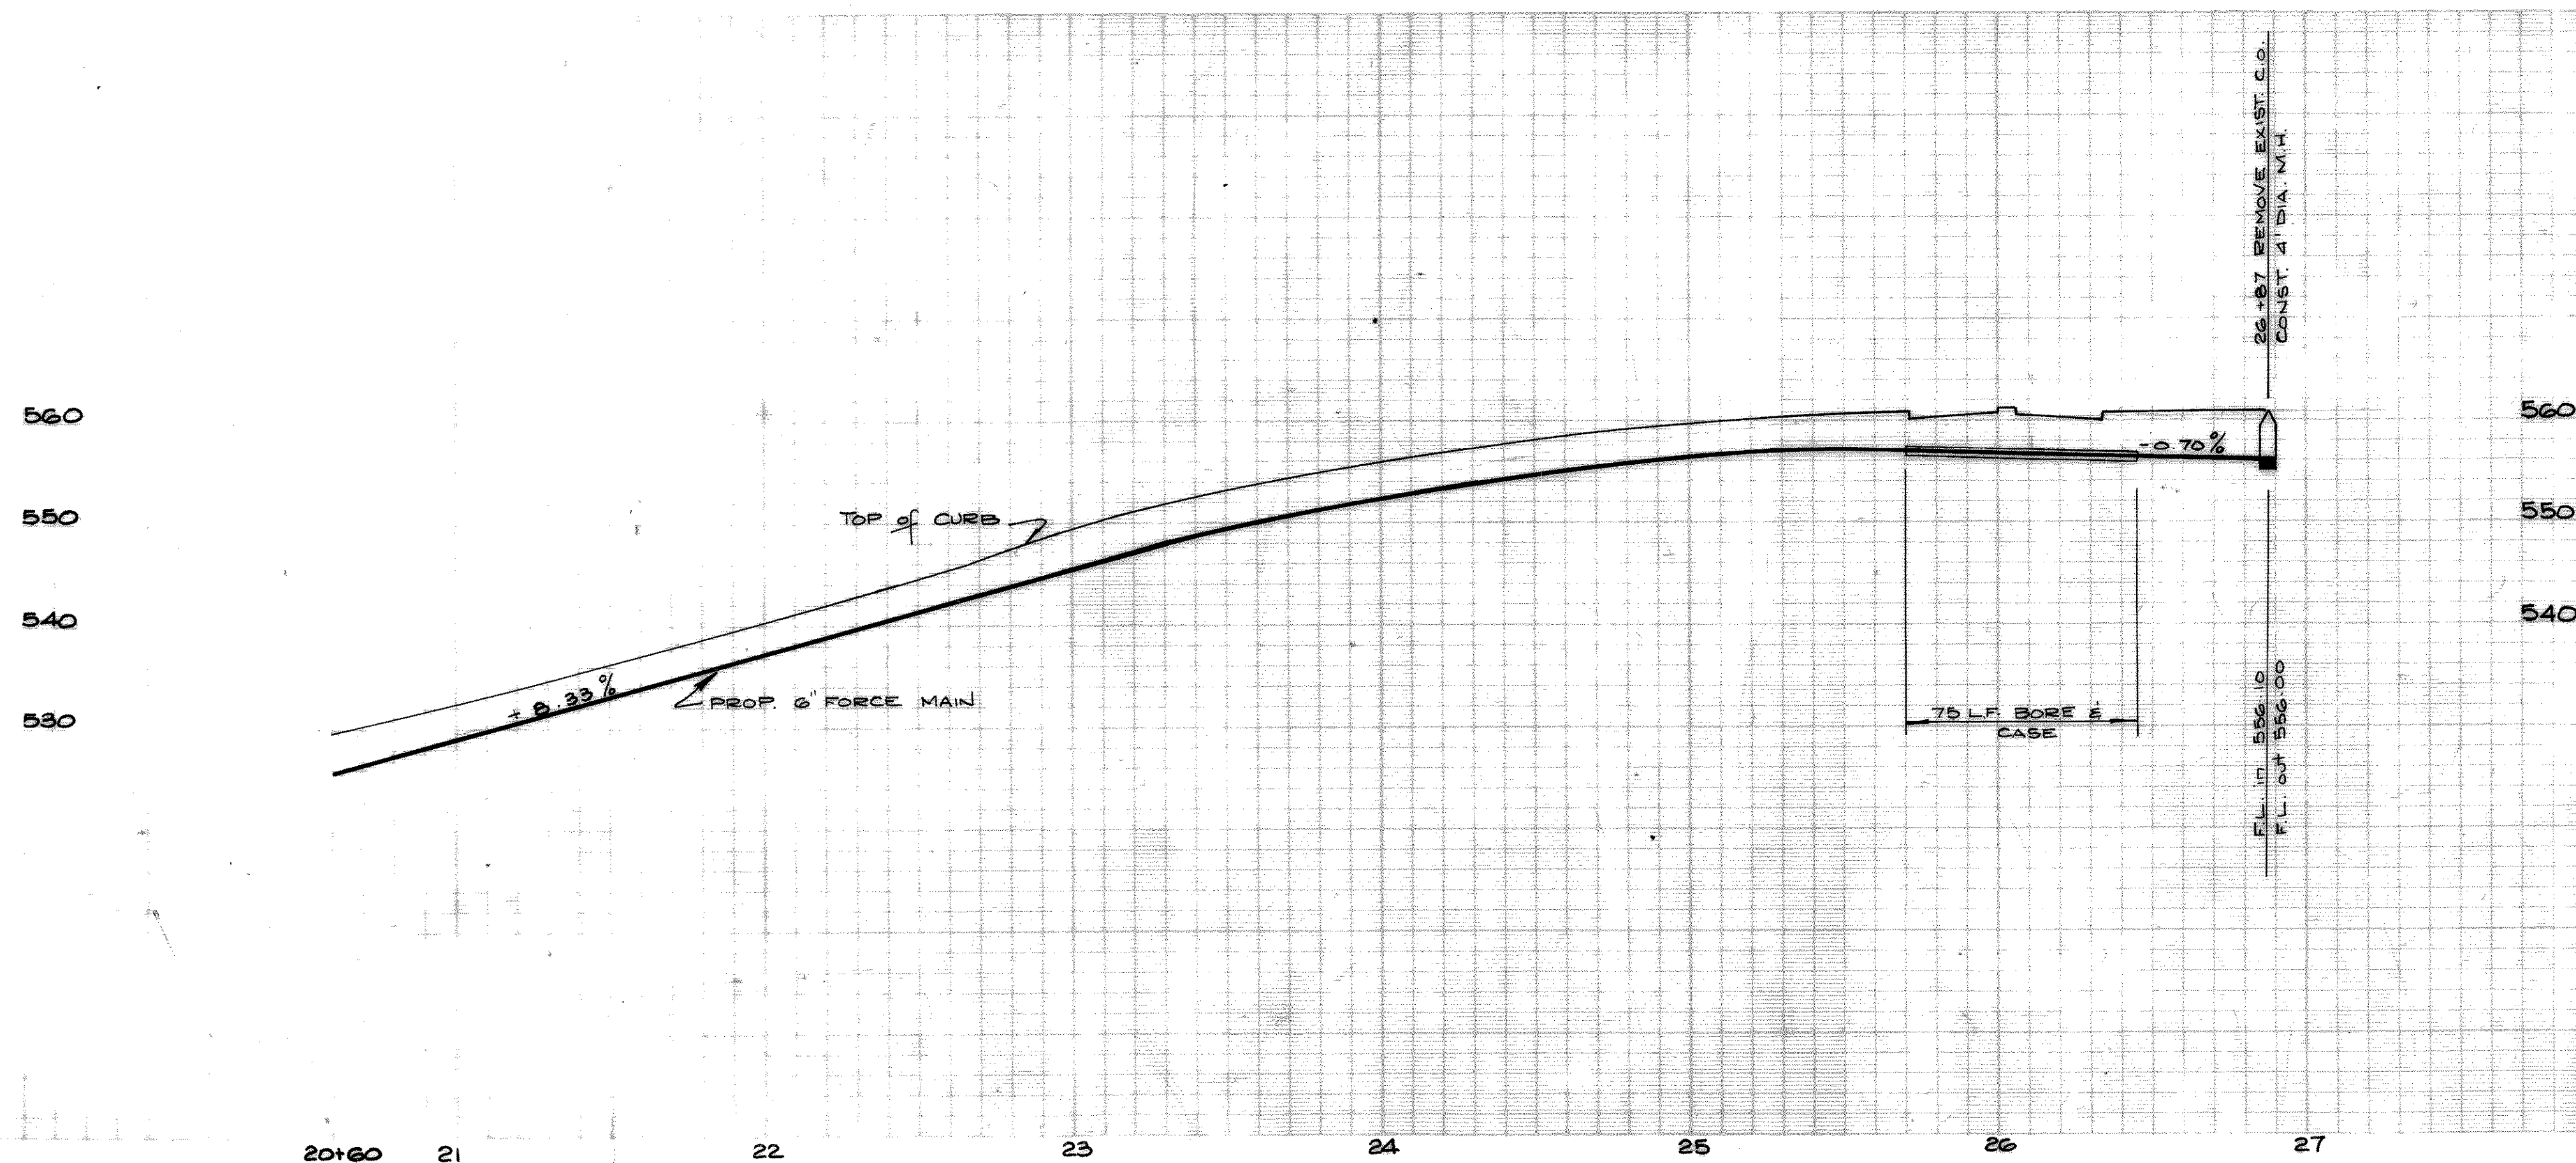


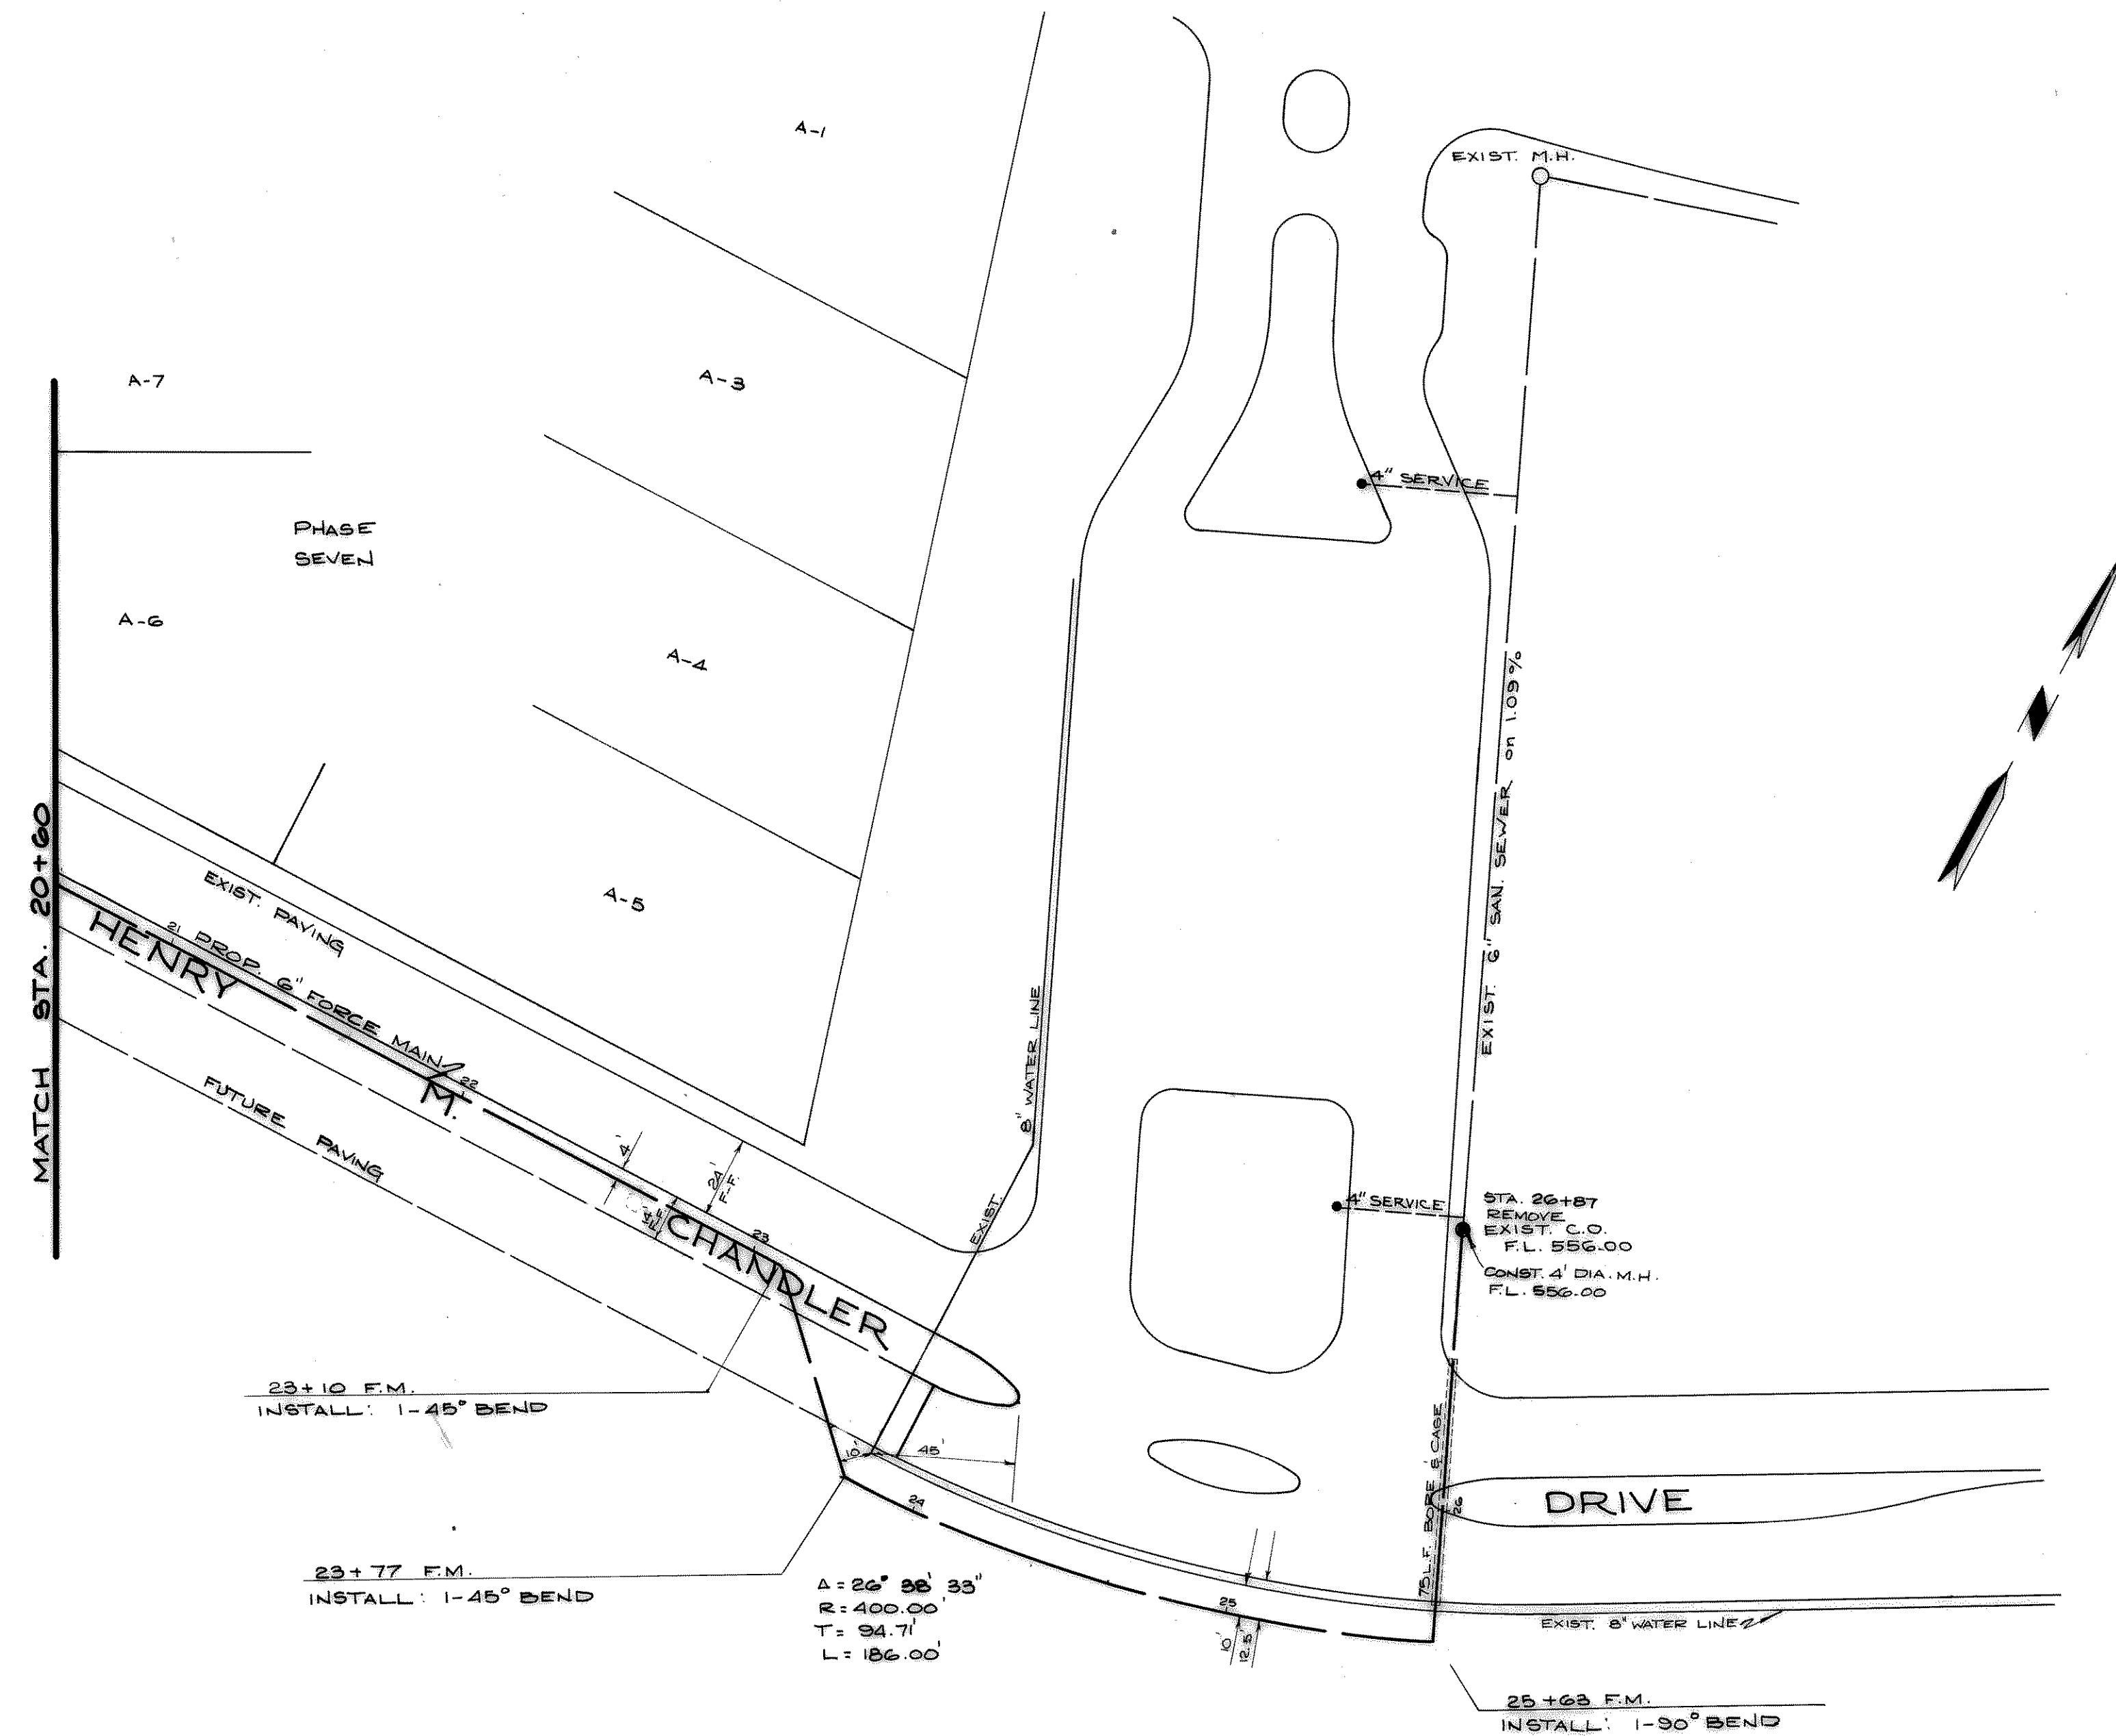

AS BUILT

CHANDLERS LANDING						
PROPOSED FORCE MAIN						
PHASE NINE, SECTION 2 & 3						
ROCKWALL COUNTY, TEXAS						
HAROLD L. EVANS & CONSULTING ENGINEER						
DESIGN	DRAWN	DATE	SCALE	NOTES	FILE	NO.
J.T.G.	H. R. M. D. M. 7/24	7-18-78	1"=40' H 1"=12' V			72122