
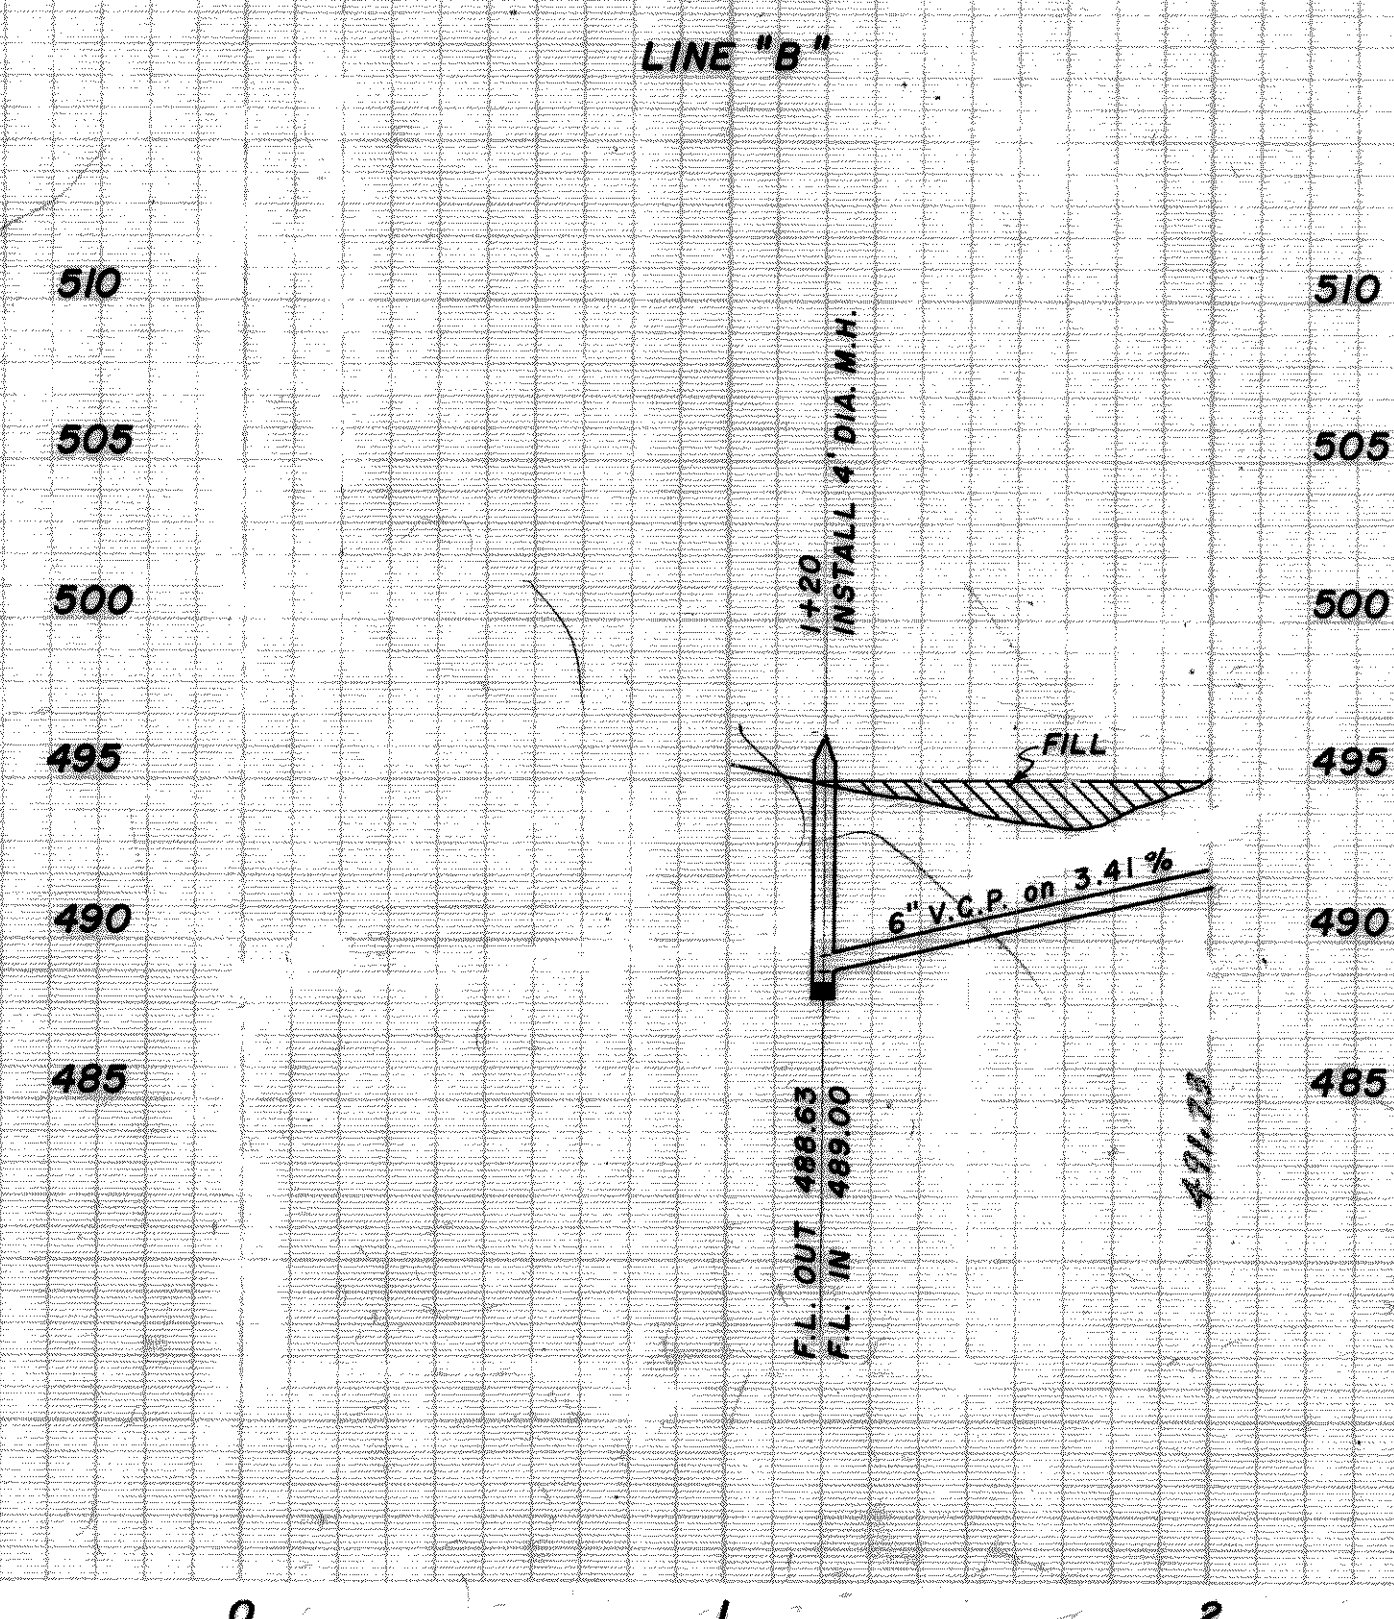
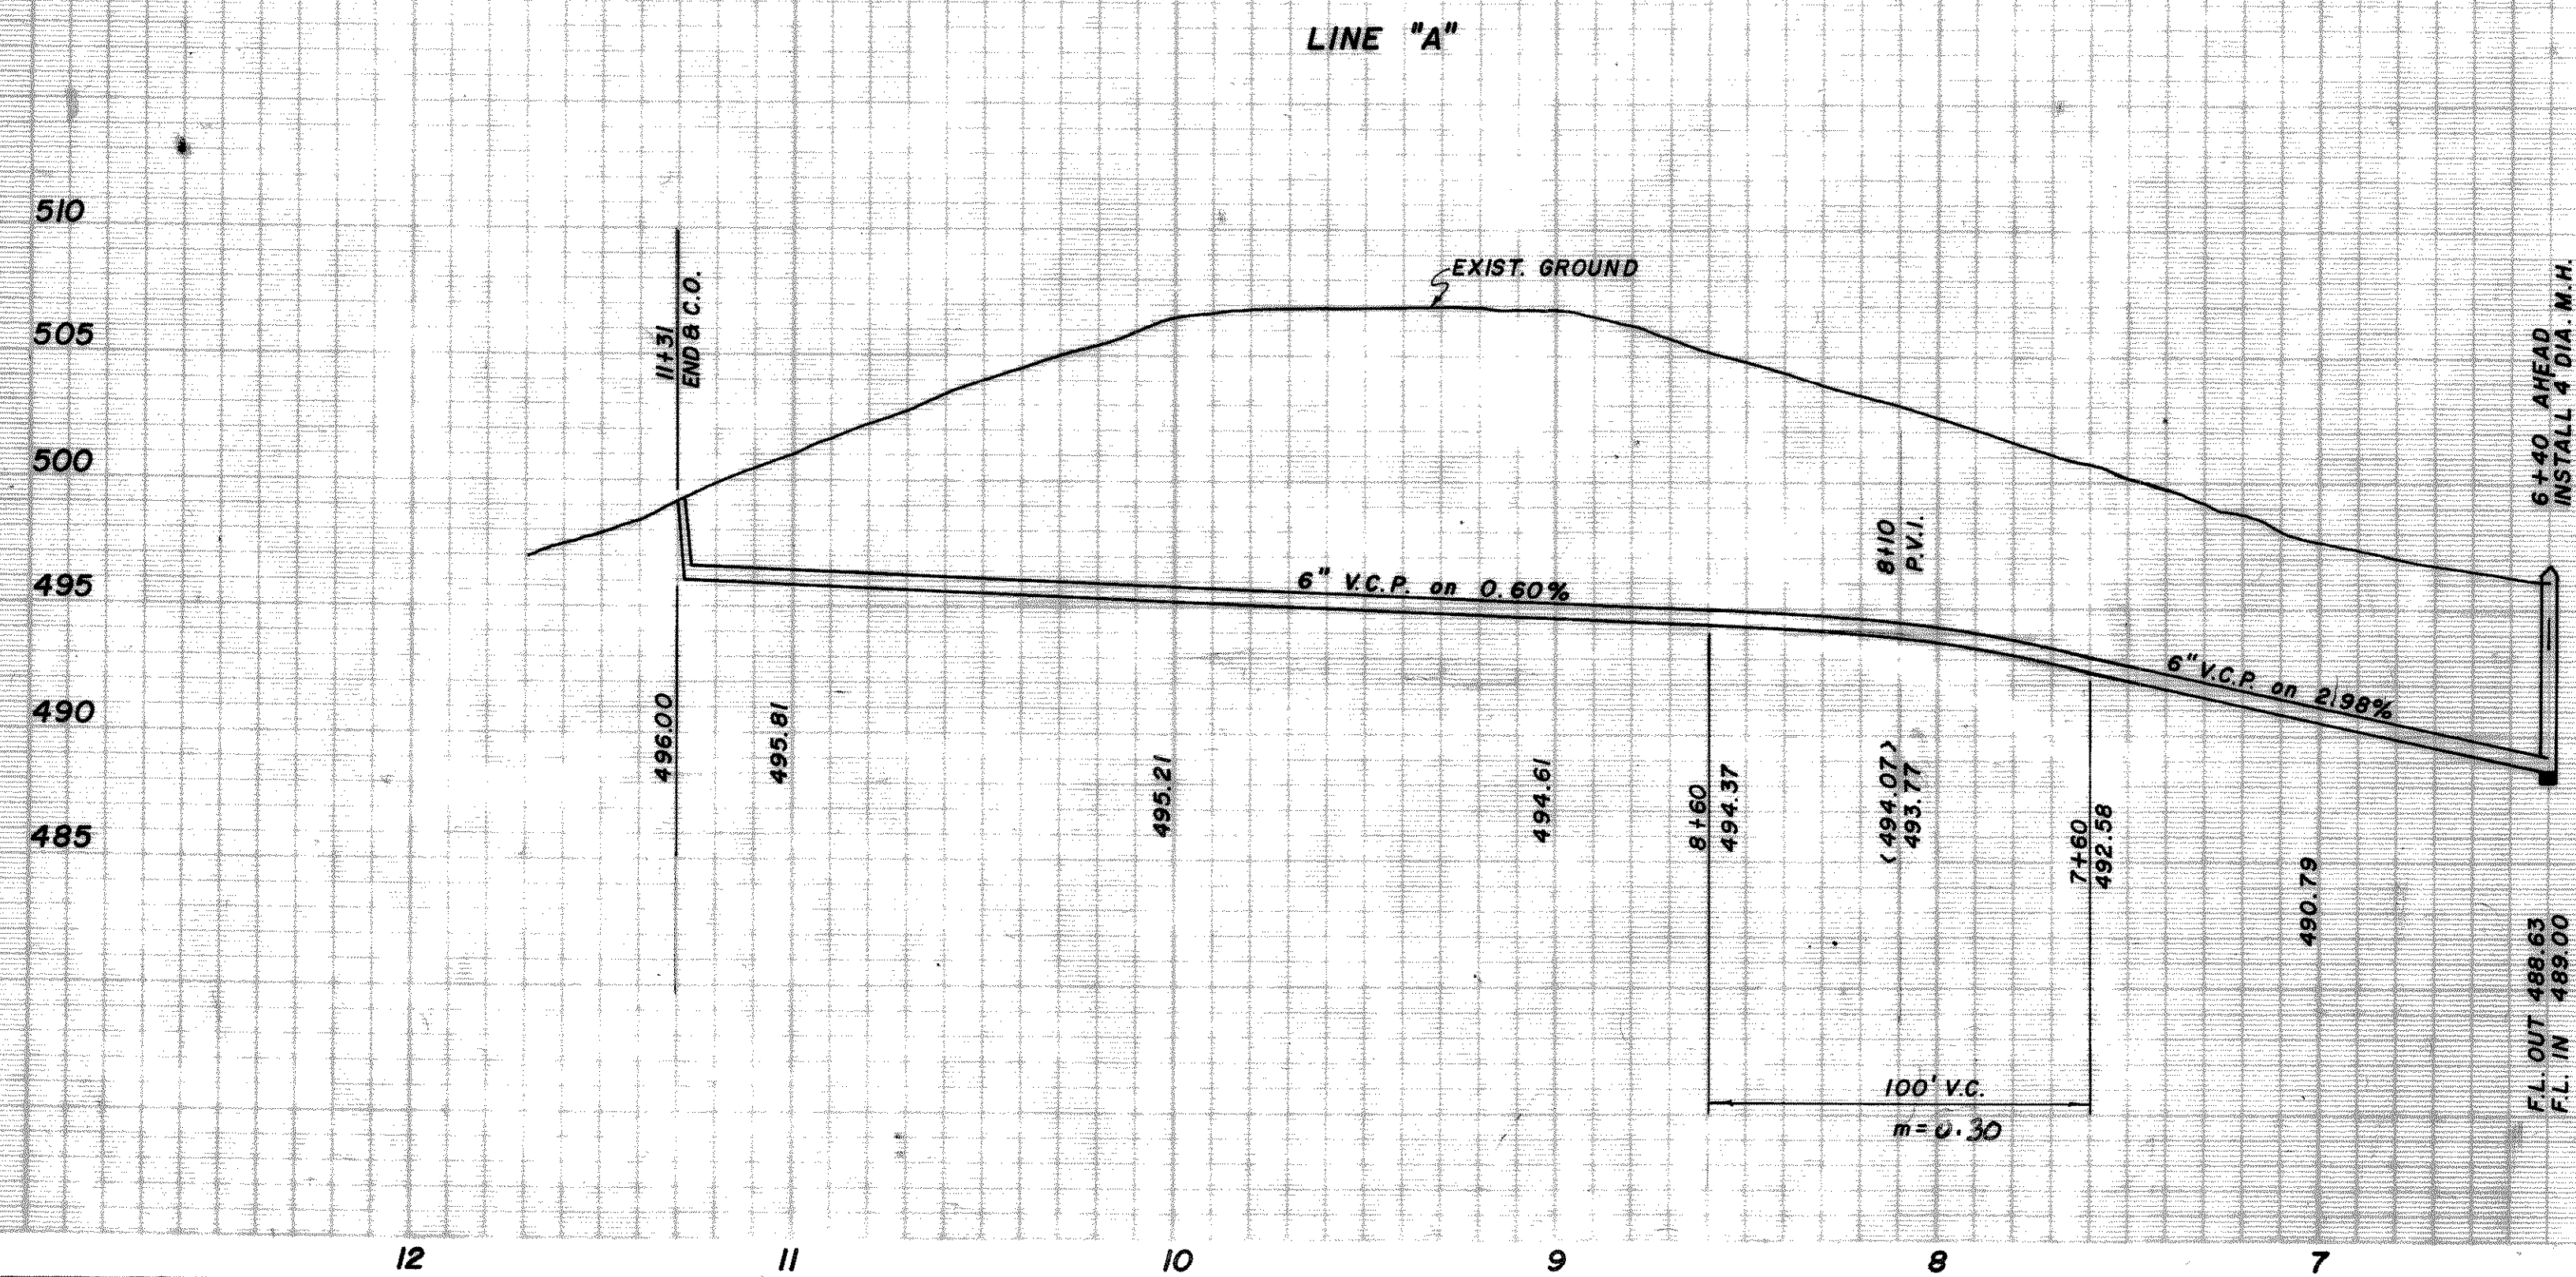


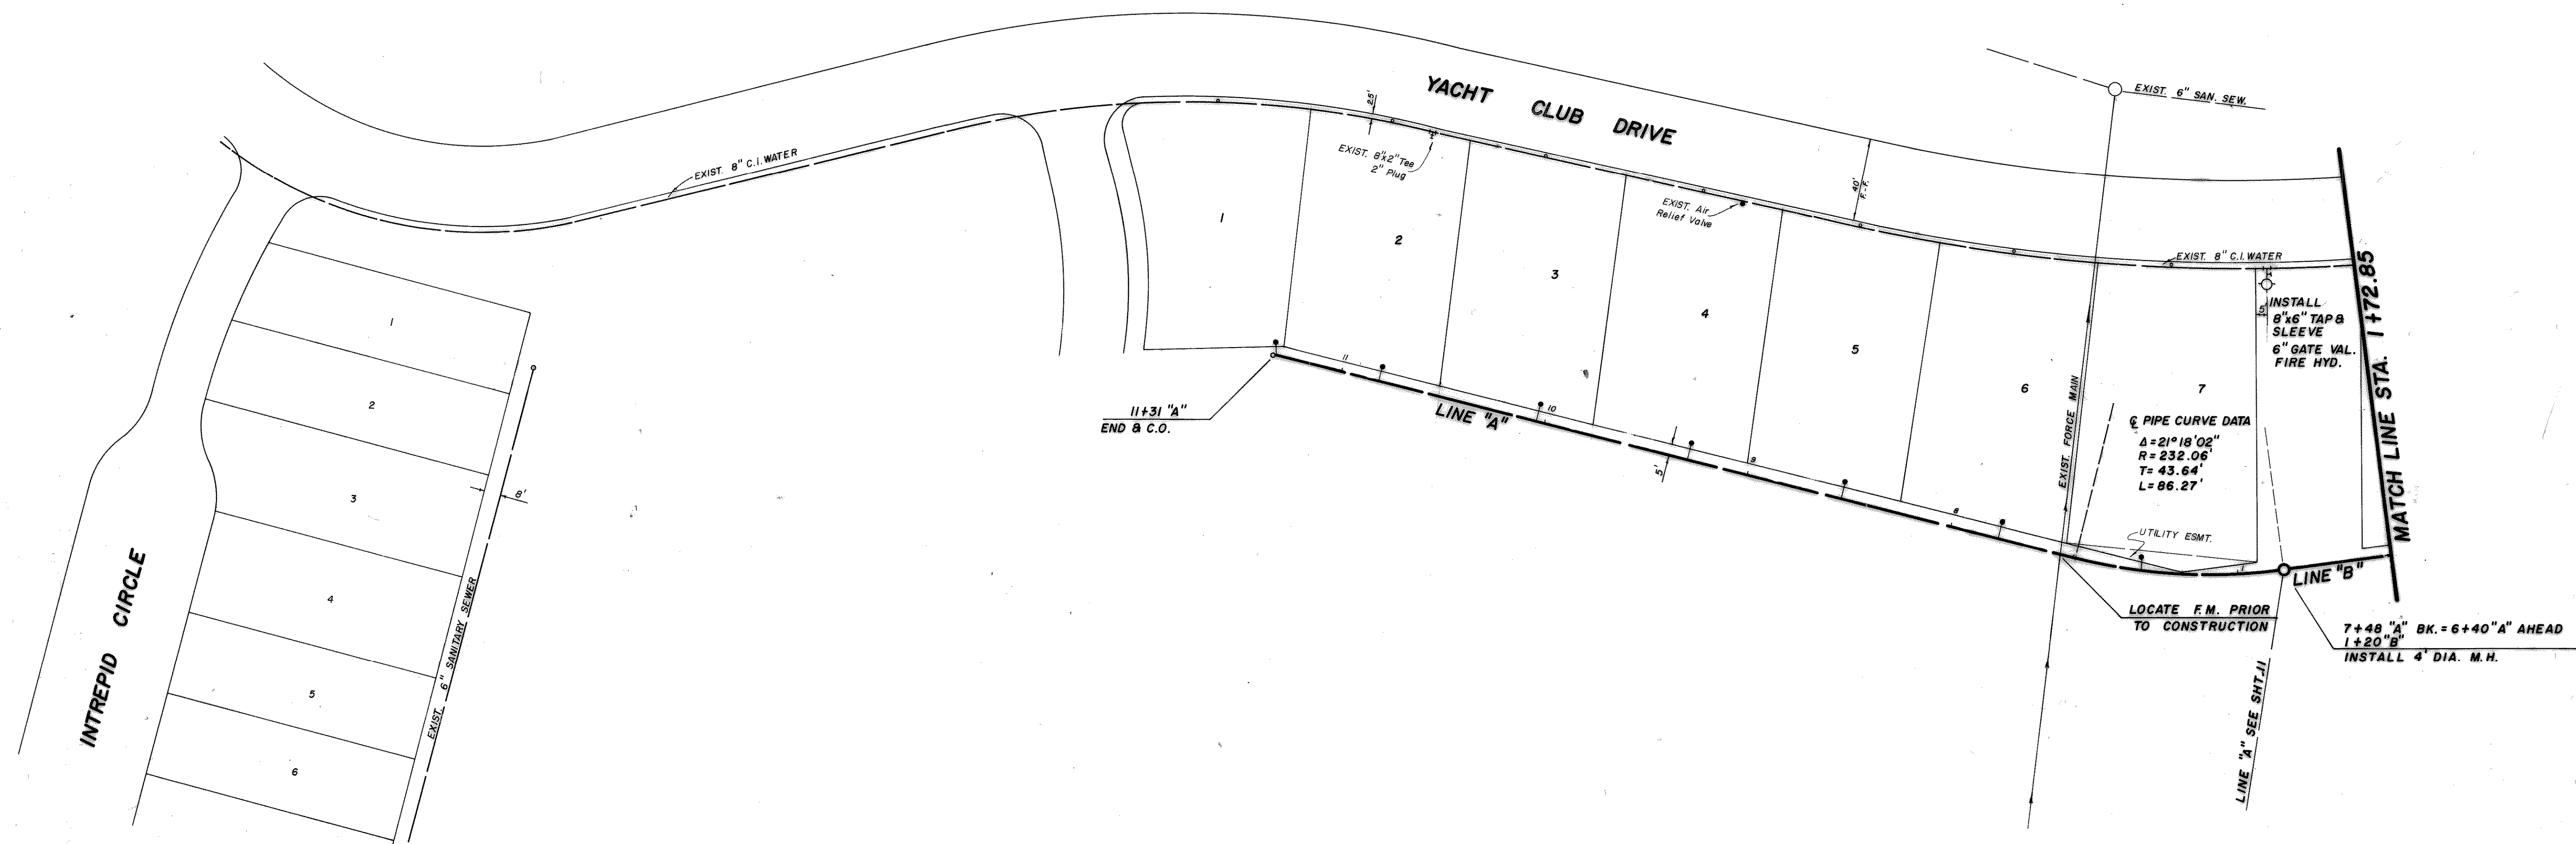

AS BUILT

CHANDLERS LANDING PHASE NINE						
PROPOSED SANITARY SEWER						
LINE "A" "B"						
ROCKWALL, TEXAS						
HAROLD L. EVANS, CONSULTING ENGINEER						
DESIGN	DRAWN	DATE	SCALE	NOTES	FILE	NO.
J.T.S.	Danny O.	4-16-75	1"=40' H. 1"=6' V.			72/22