



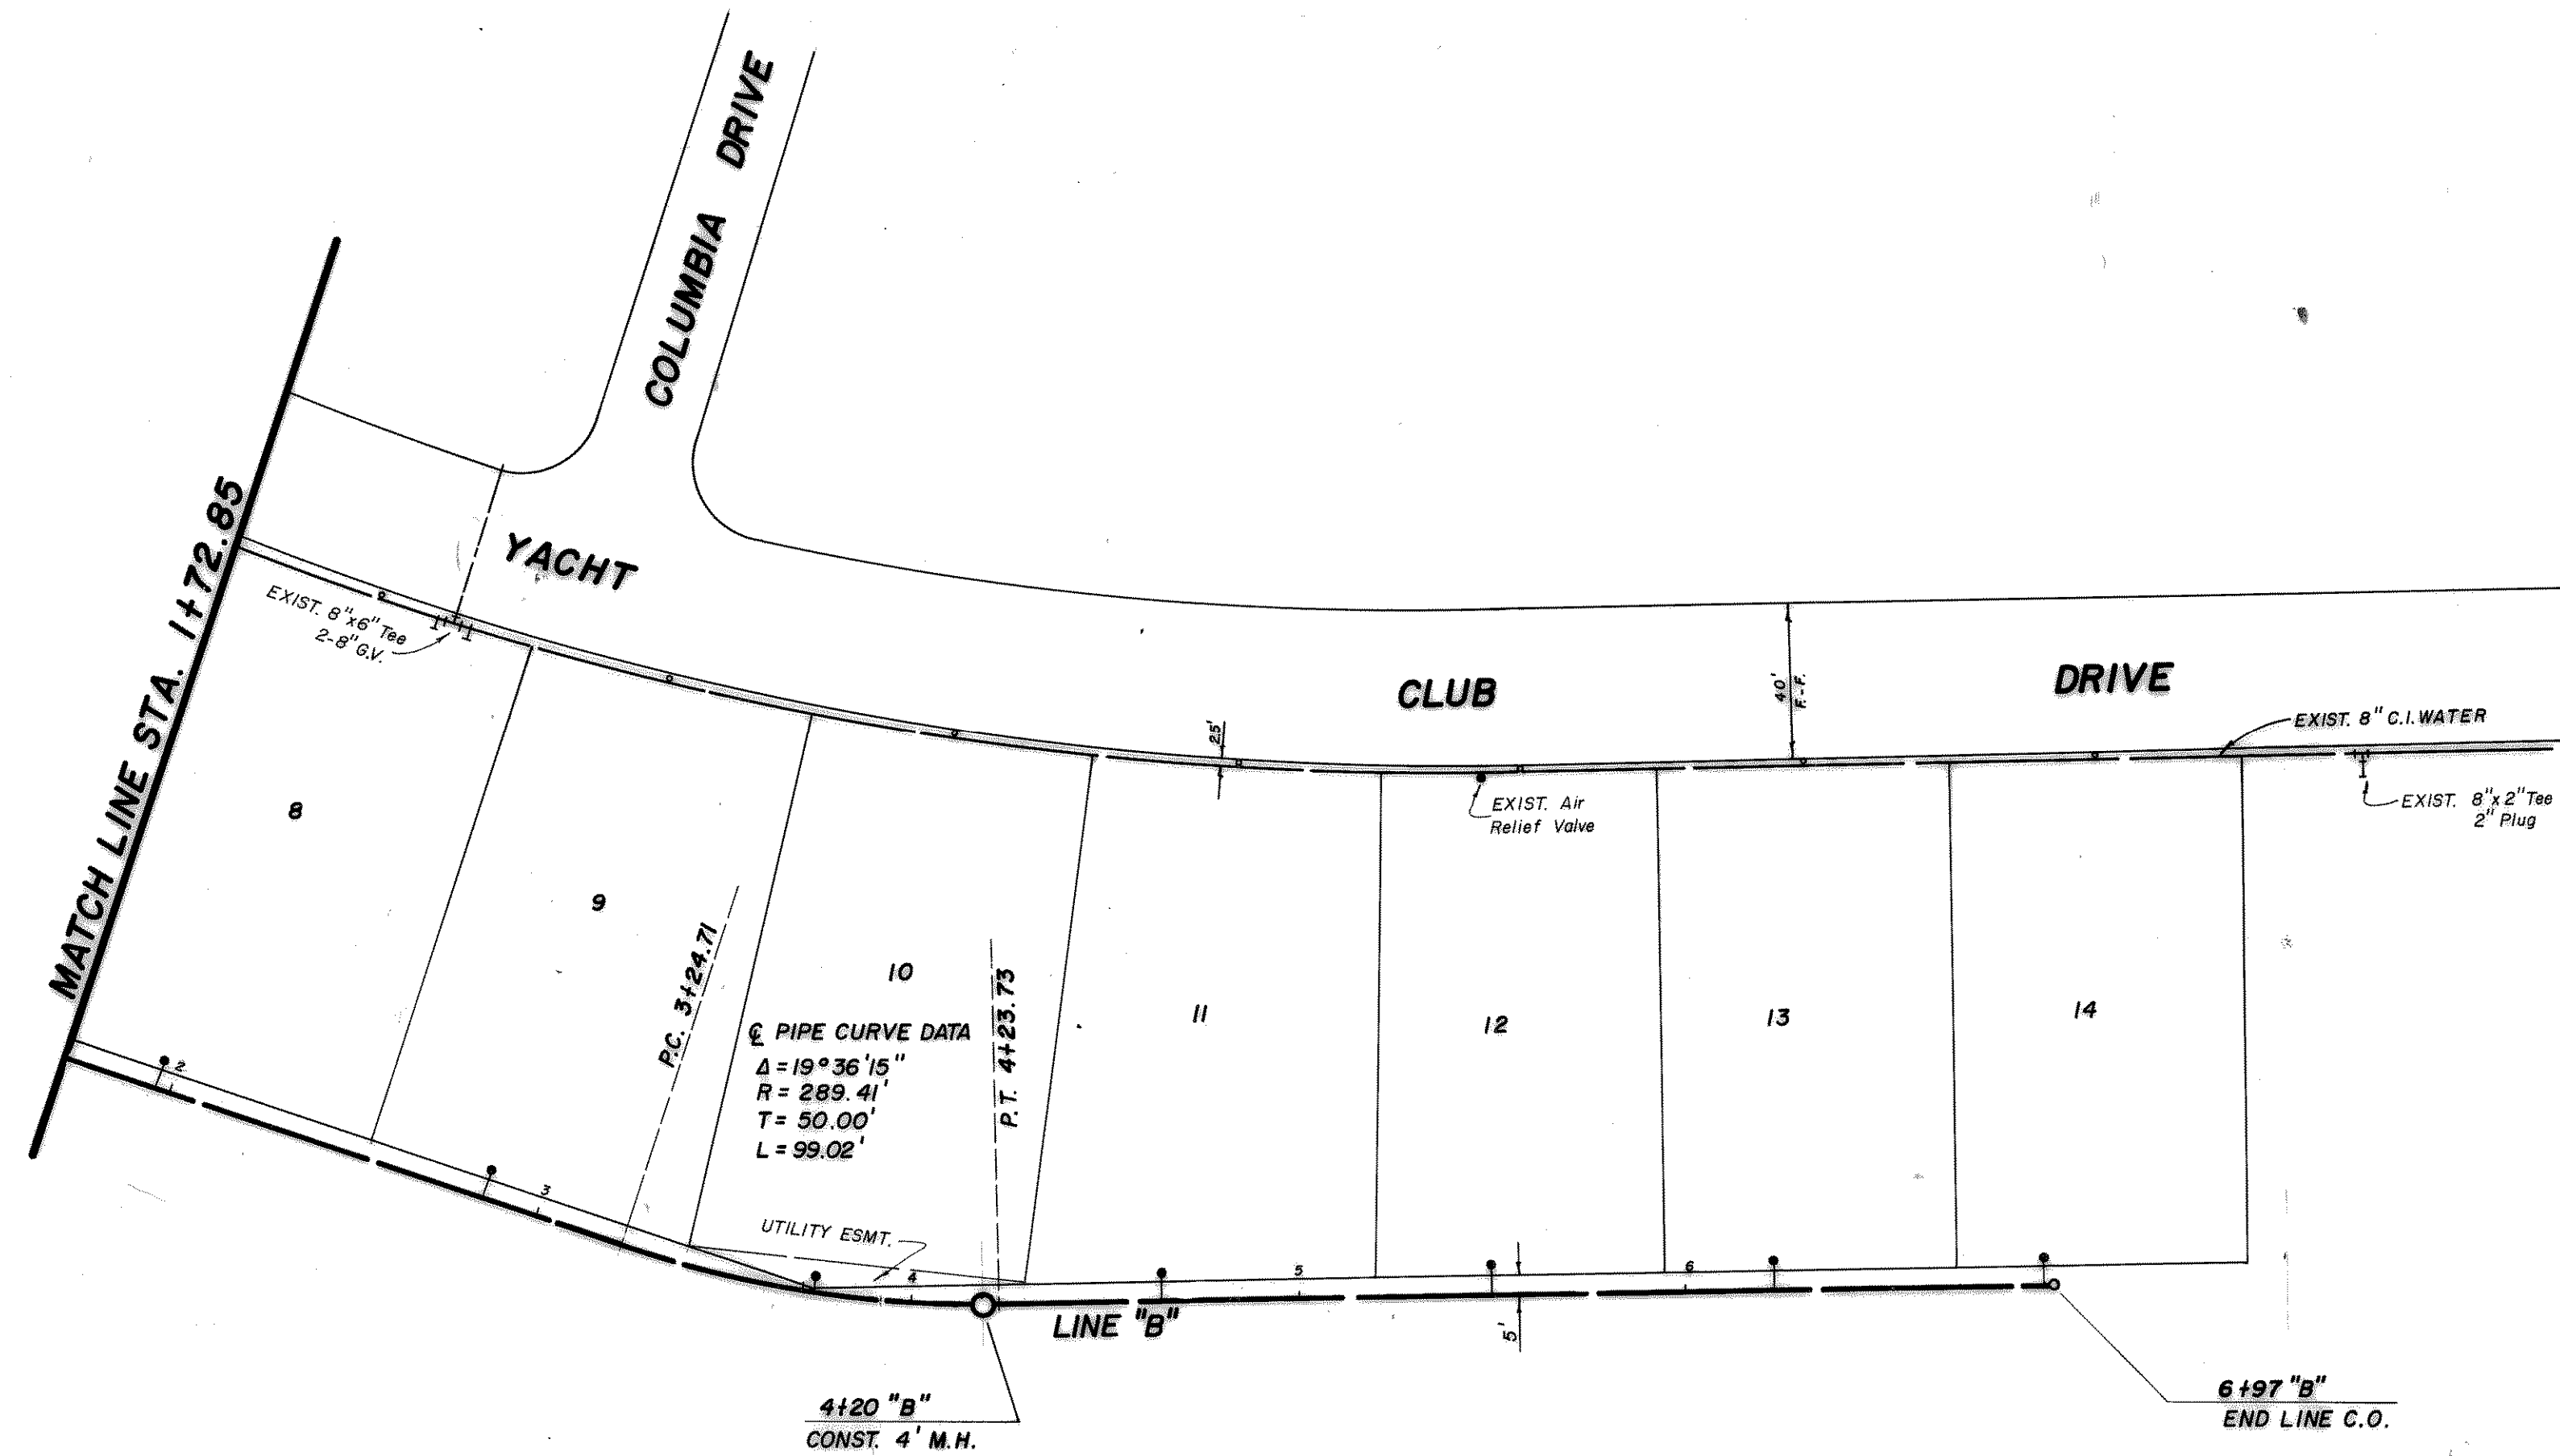

LEGEND:

- GATE VALVE
- WATER METER
- FIRE HYDRANT
- AIR RELIEF VALVE
- FLUSH VALVE
- SAN. SEW. M.H.
- SAN. SEW. C.O.
- SAN. SEW. SERVICE

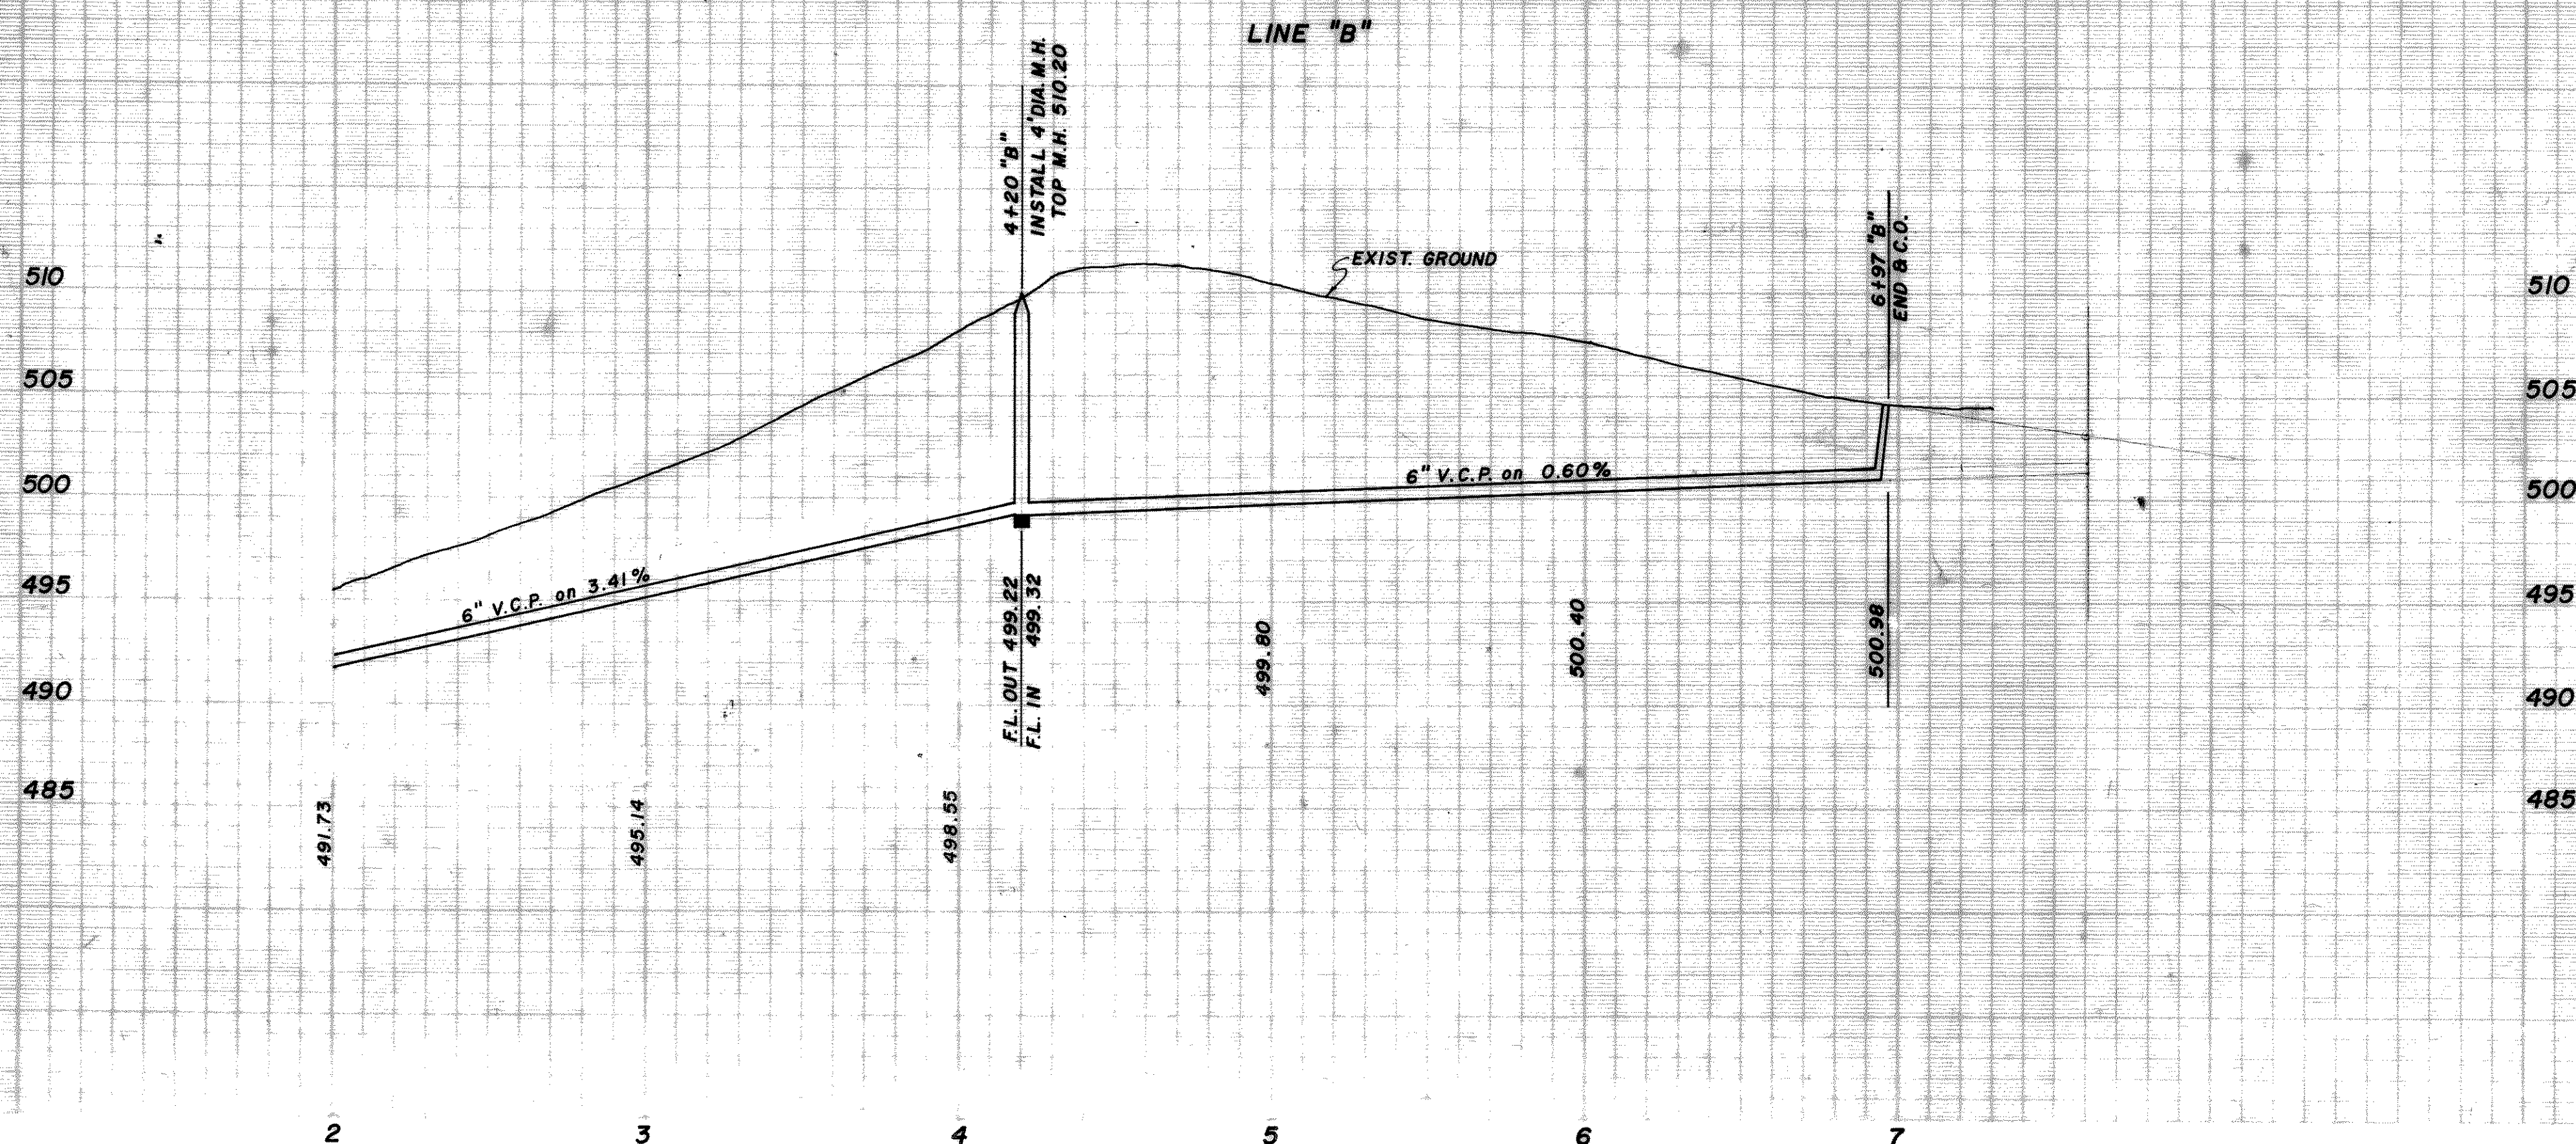

AS BUILT

CHANDLERS LANDING PHASE NINE						
PROPOSED SANITARY SEWER						
LINE "B"						
ROCKWALL, TEXAS						
HAROLD L. EVANS & CONSULTING ENGINEER						
DESIGN	DRAWN	DATE	SCALE	NOTES	FILE	NO.
J.T.S.	Danny O.	4-16-75	1"=40' H. 1"=6' V.			72122