


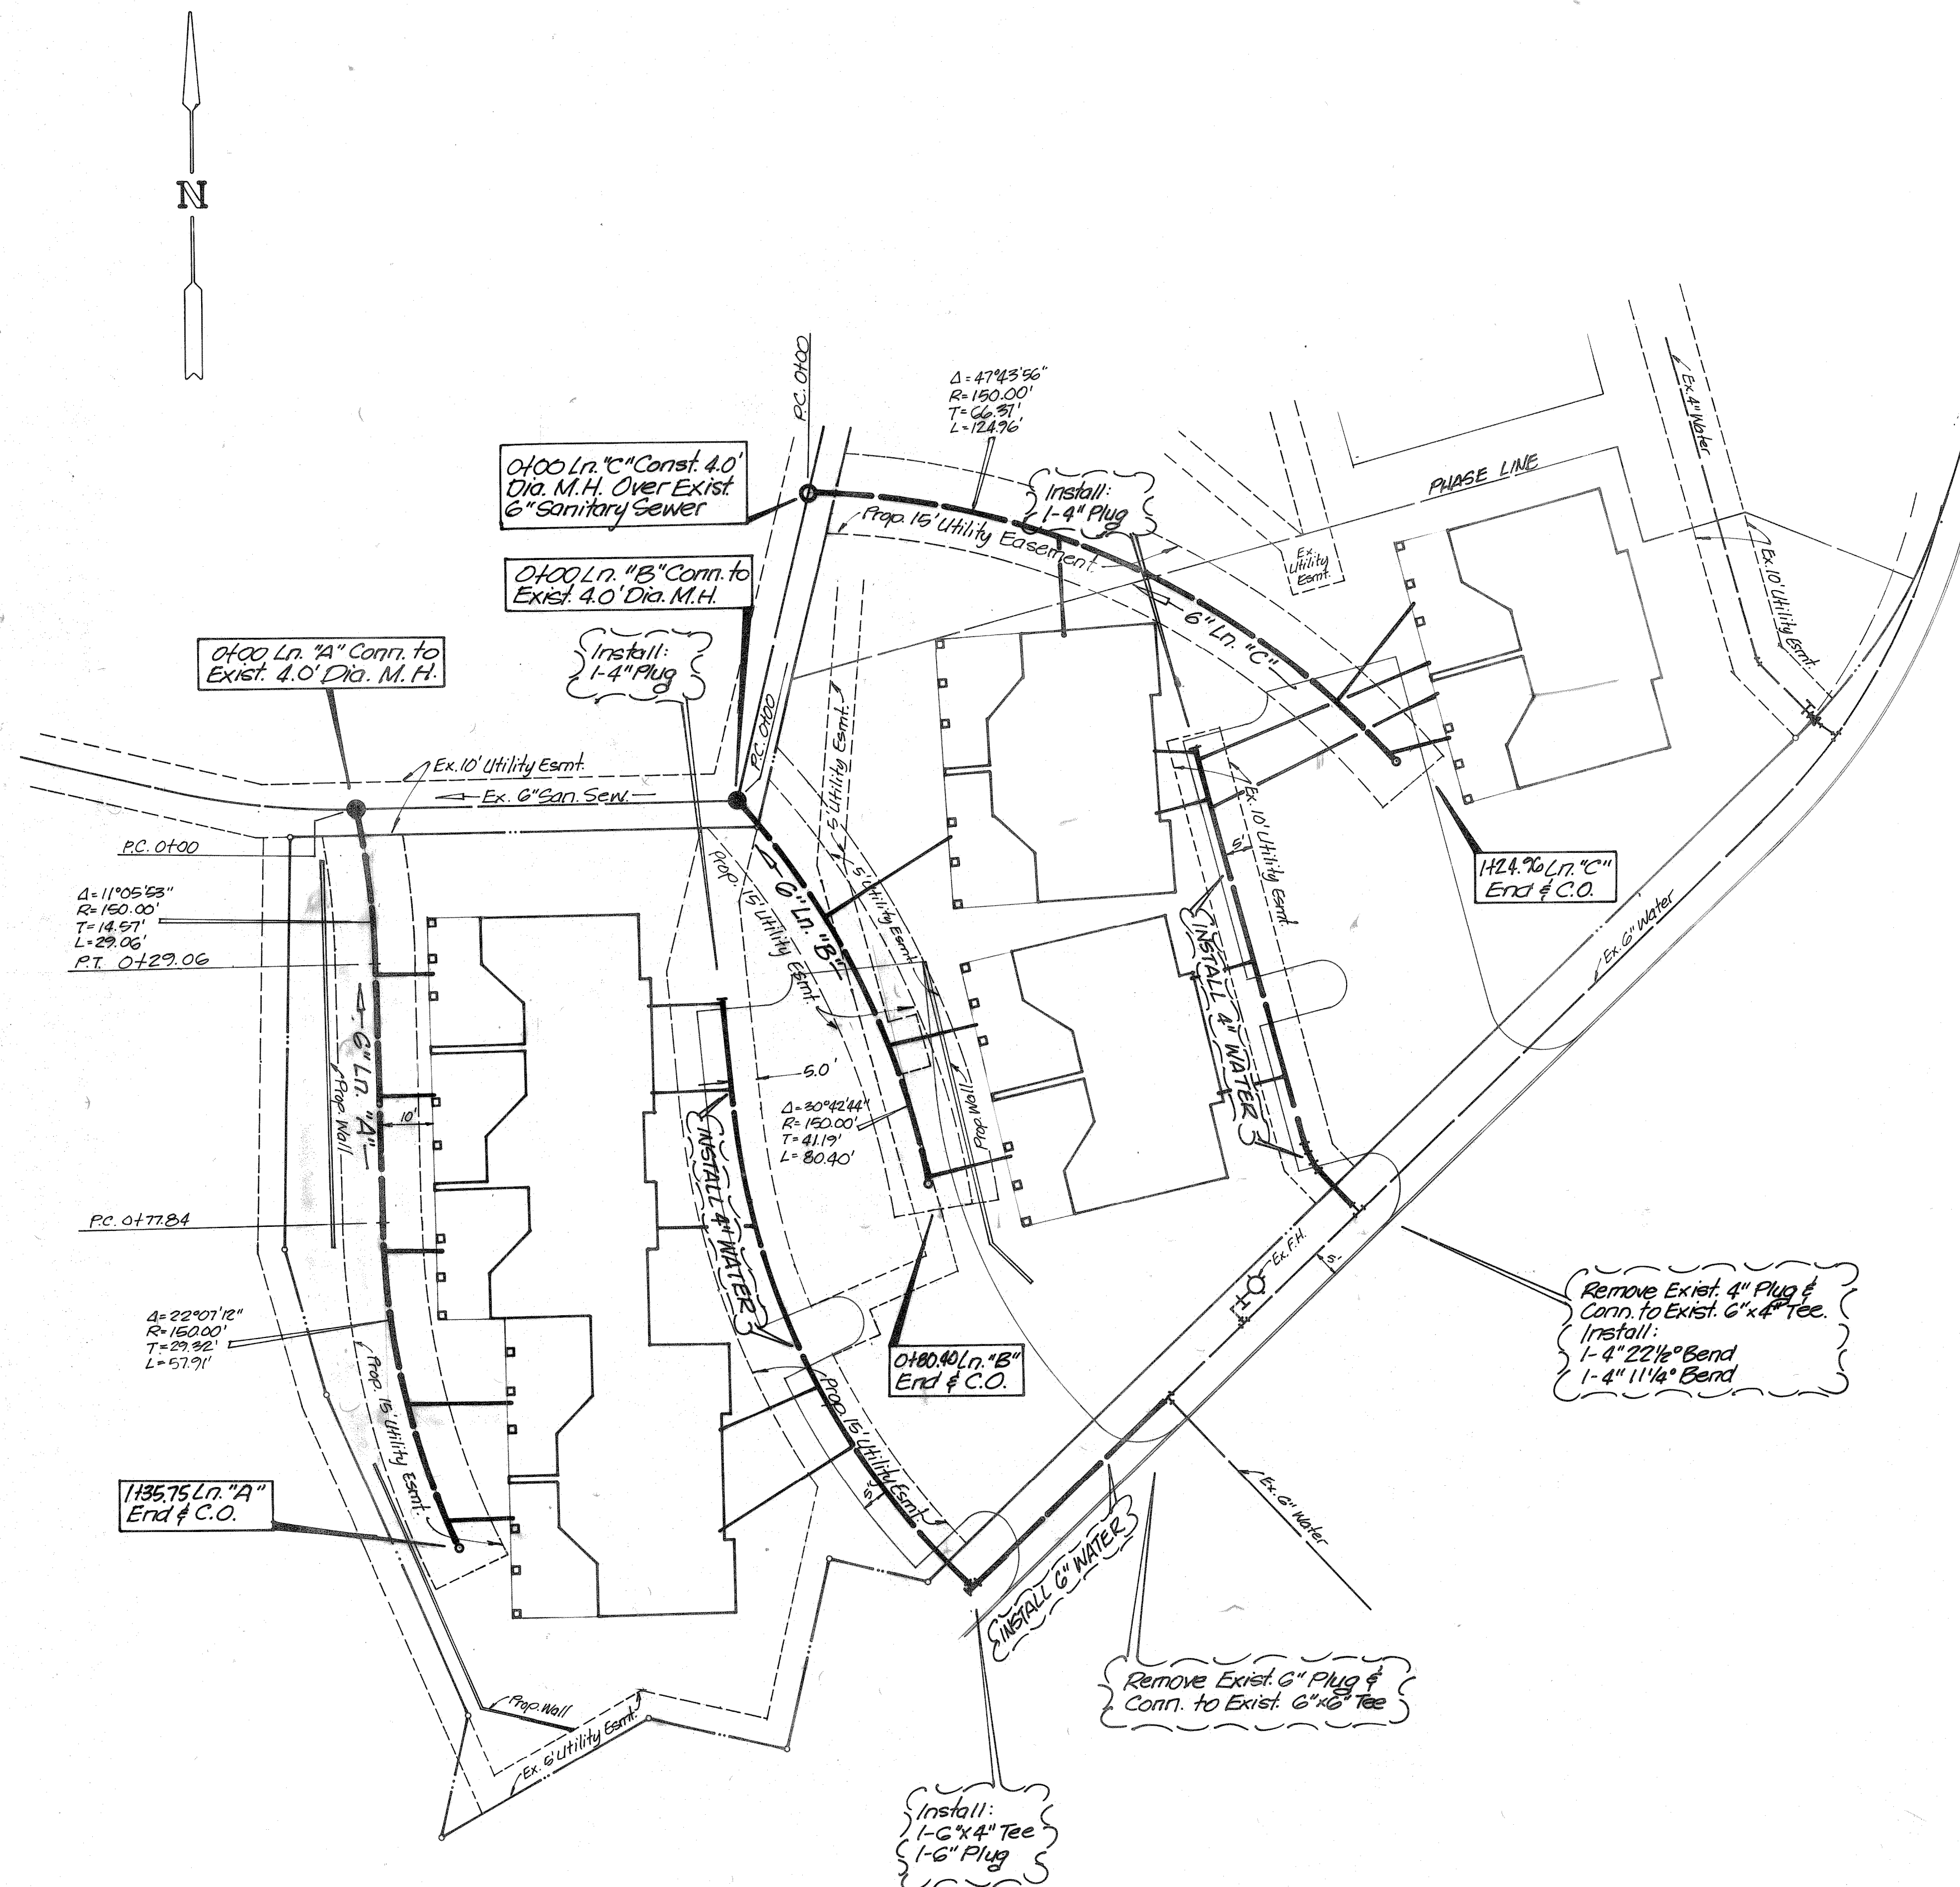

SANITARY SEWER SYSTEM SUMMARY							
MANHOLE		RESIDENTIAL FLOW			Commercial or Industrial Point Source Flow		Total Design Flow Maximum Wet-Weather Day (gpm)
FROM	TO	CUMULATIVE POPULATION	AVERAGE DRY-DAY FLOW (gpm)	MAXIMUM DRY-DAY FLOW (gpm)	Units*	Average Flow (gpm)	
Ln. 'A' 0400	1135.75	18	1.6	4.0			4.16
Ln. 'B' 0400	0480.40	11	1.0	2.5			2.59
Ln. 'C' 0400	1424.96	7	0.6	1.58			1.72

AS BUILT

HAROLD L. EVANS CONSULTING ENGINEER 2331 GUS THOMASSON RD. SUITE 102 DALLAS, TEXAS 75228 PHONE (214) 328-8133			WATER & SANITARY SEWER PLAN THE CABANAS AT CHANDLERS LANDING PHASE TWO ROCKWALL COUNTY, TEXAS	
SCALE	DATE	JOB NO.		
1"=20'	10-23-84	84245		

Revised: 1-10-89 Move Sewers to Provide 1st Earth
 7-14-86 Add 5' Utility Easmt. ~ Move 2 Water Services