




LINE "C"

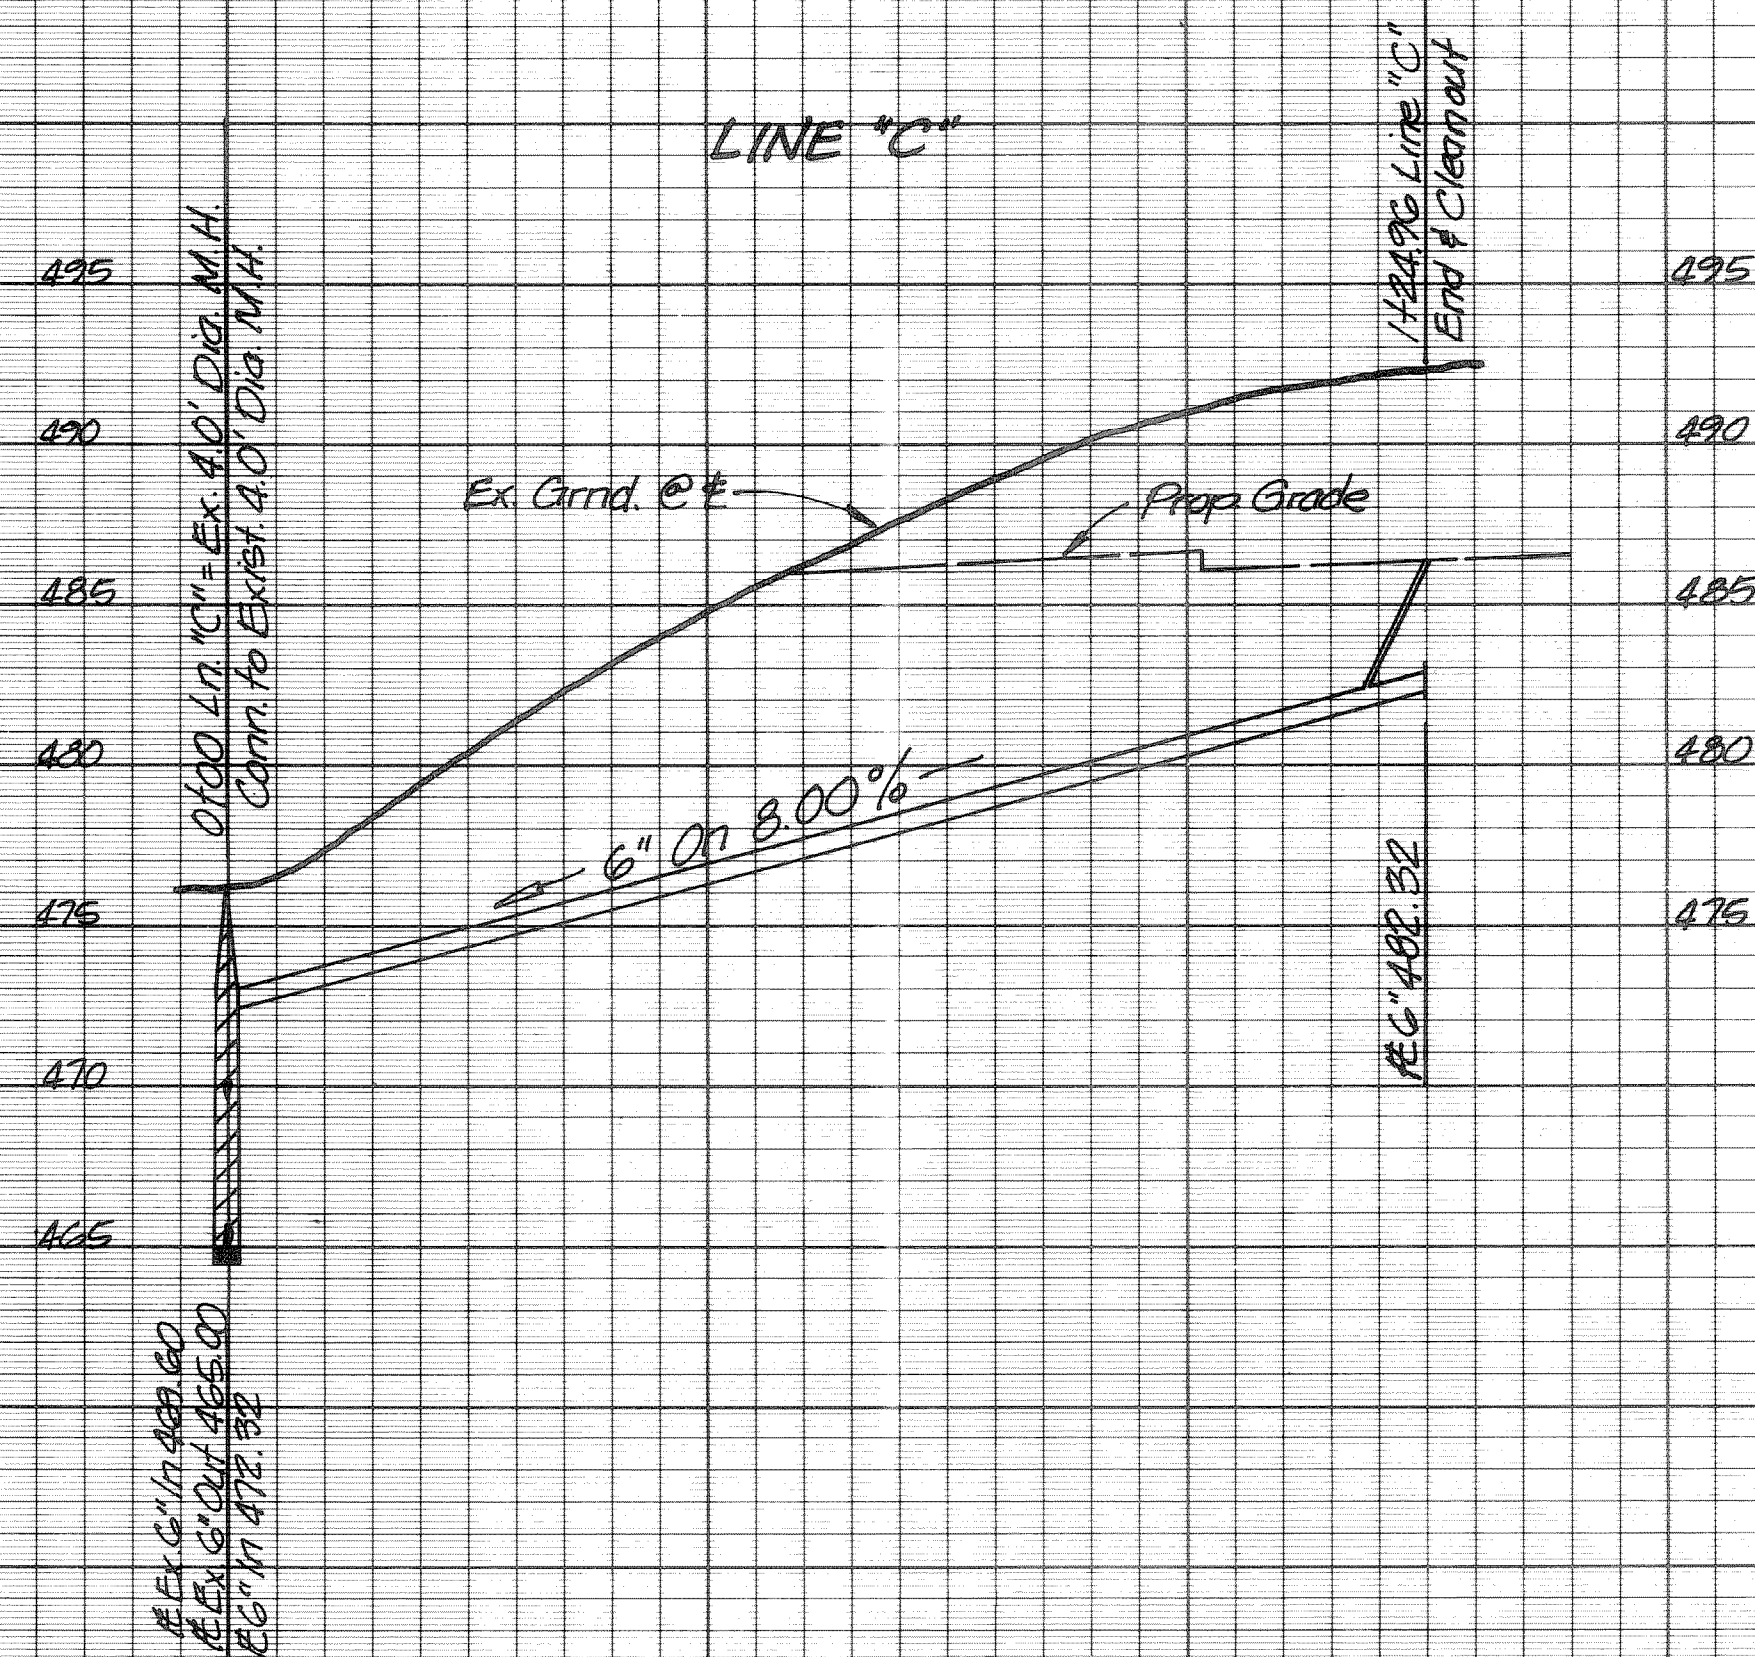

LINE "B"

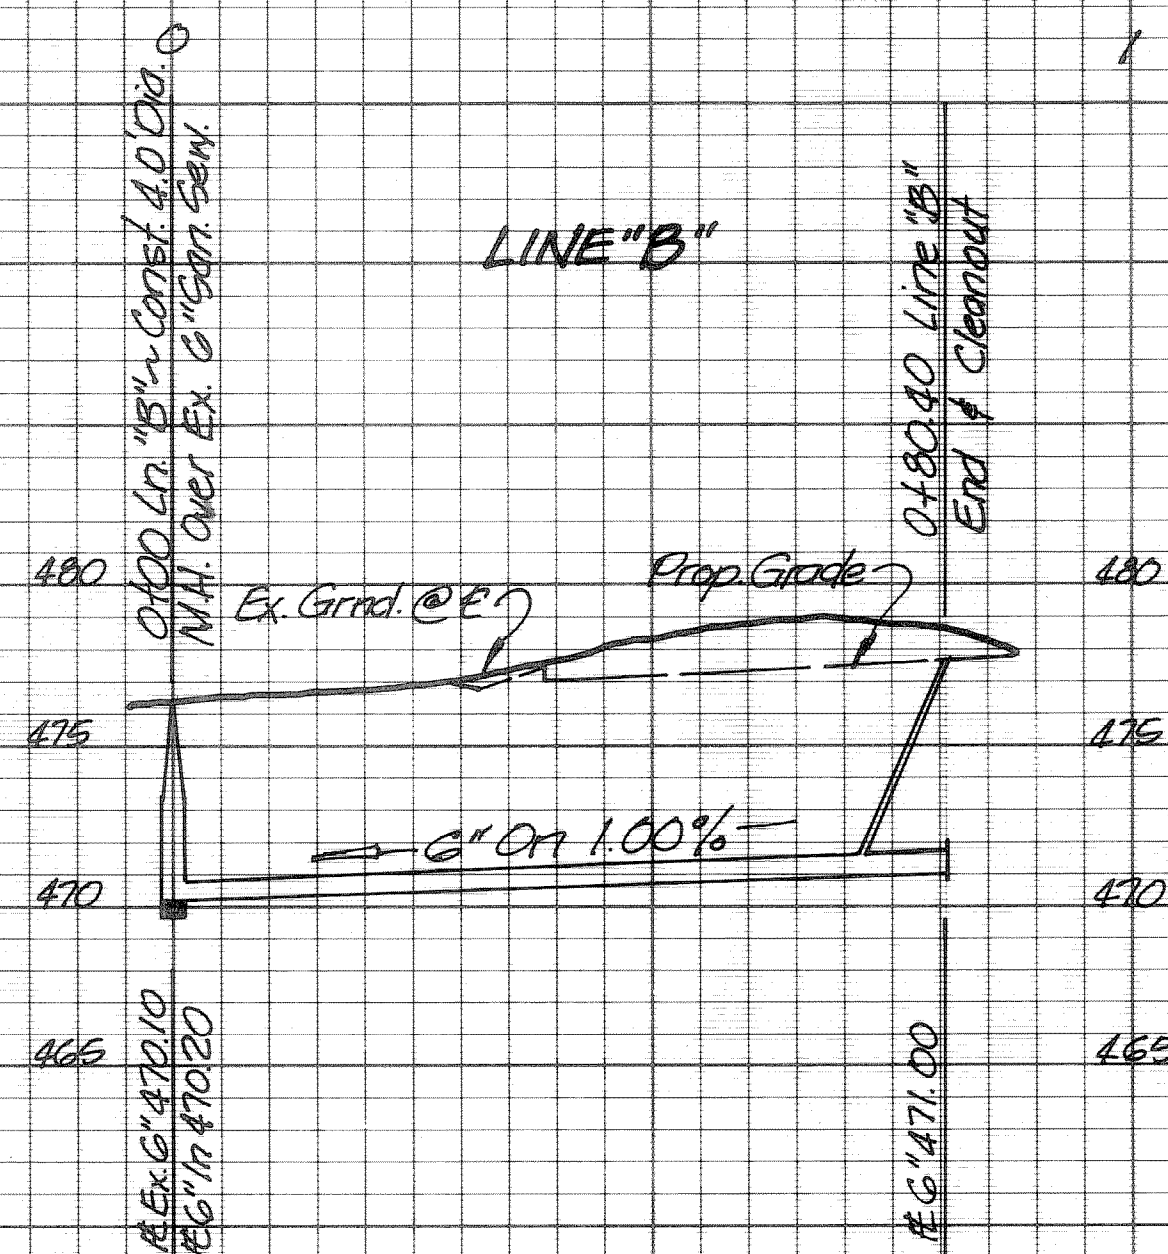

LINE "A"

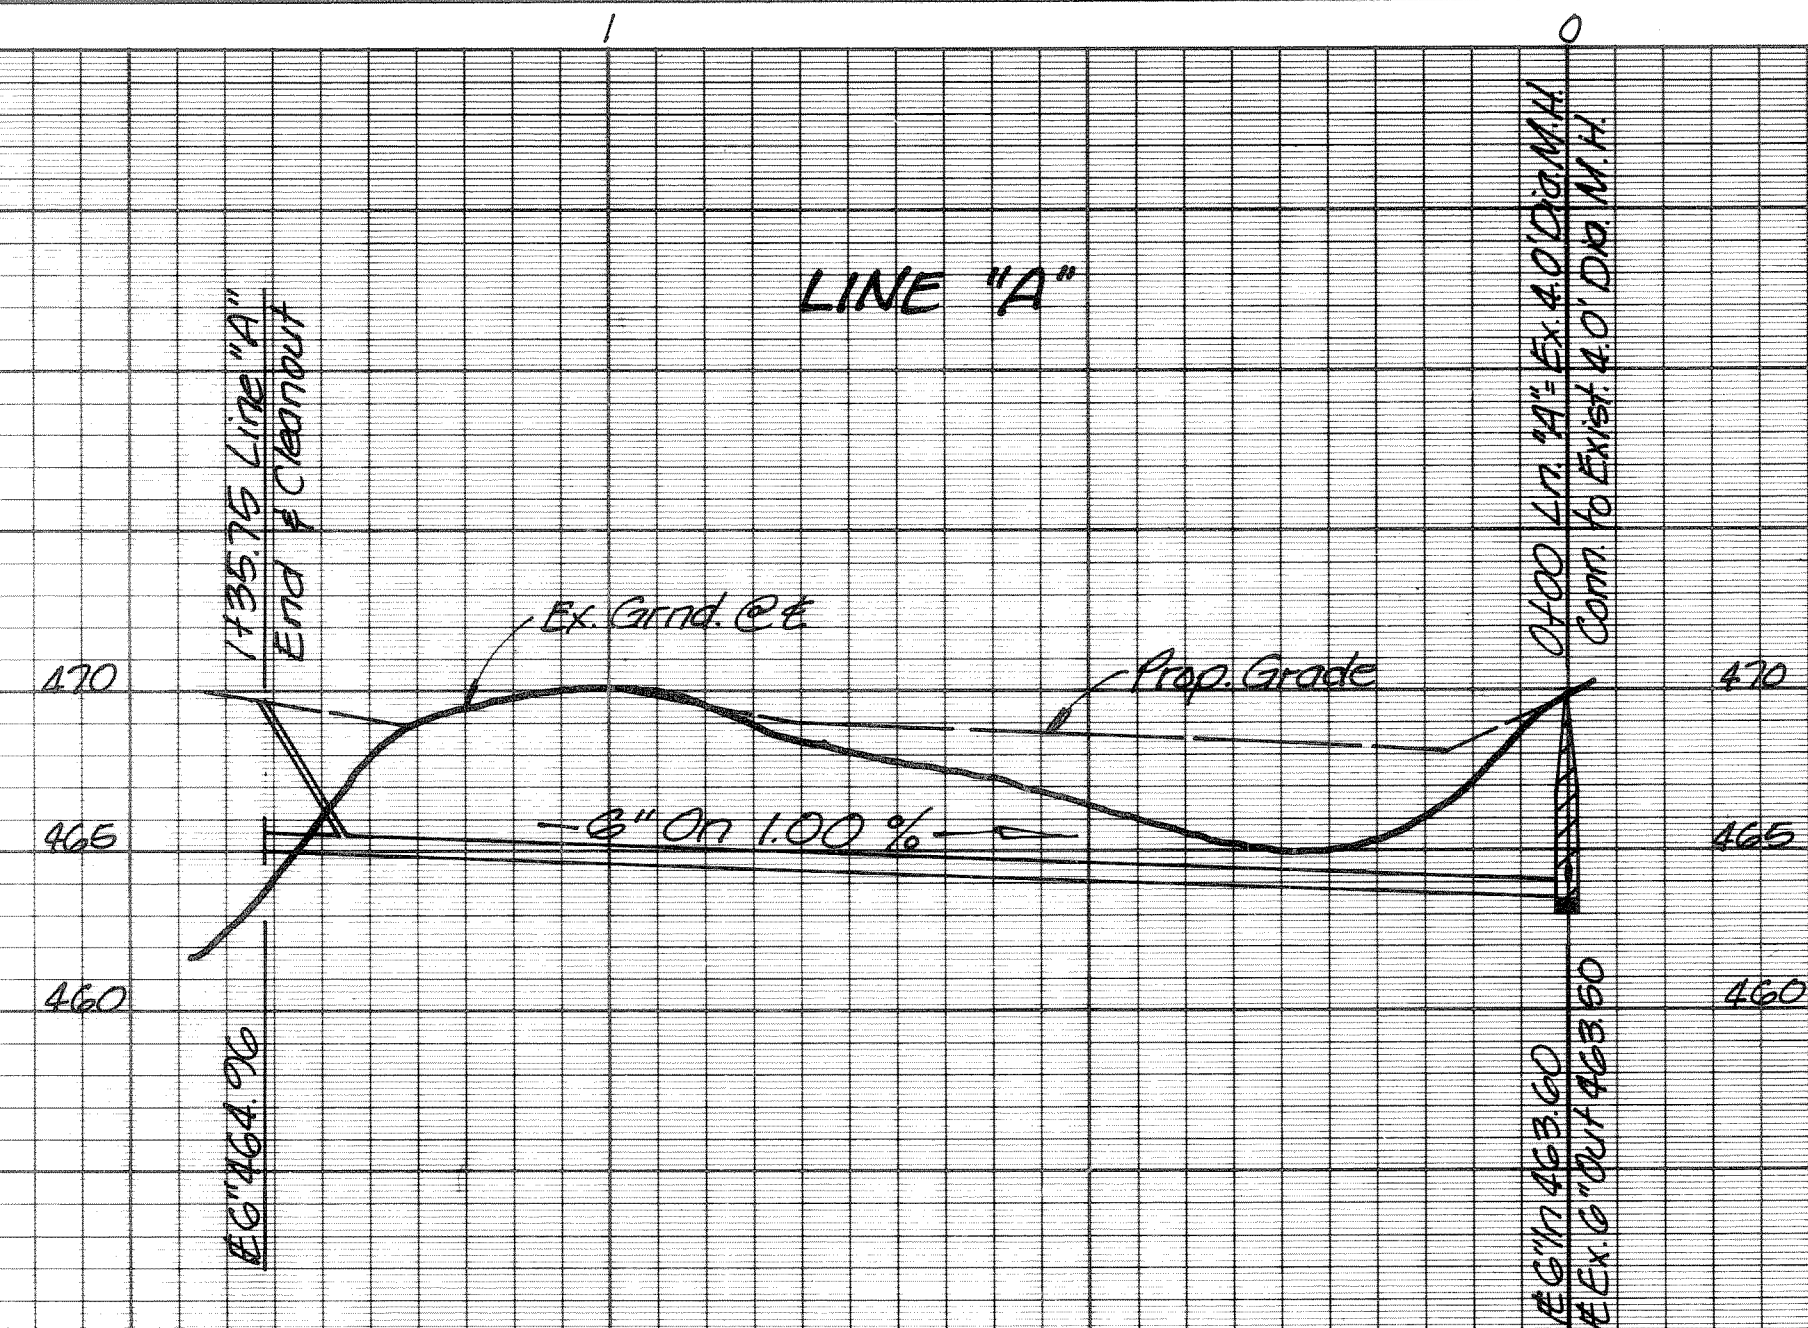

AS BUILT

|                                                                                                                           |          |         |
|---------------------------------------------------------------------------------------------------------------------------|----------|---------|
| HAROLD L. EVANS<br>CONSULTING ENGINEER<br>2331 GUS THOMASSON RD. SUITE 102<br>DALLAS, TEXAS 75228<br>PHONE (214) 328-8133 |          |         |
| SCALE                                                                                                                     | DATE     | JOB NO. |
| 1"=20'H. 1"=6'                                                                                                            | 10-24-84 | 84245   |

SANITARY SEWER PROFILES  
 THE CABANAS AT CHANDLERS LANDING  
 PHASE TWO  
 ROCKWALL COUNTY, TEXAS

Revised: 1-16-85 ~ Shorten Lns. "A", "B" & "C"